


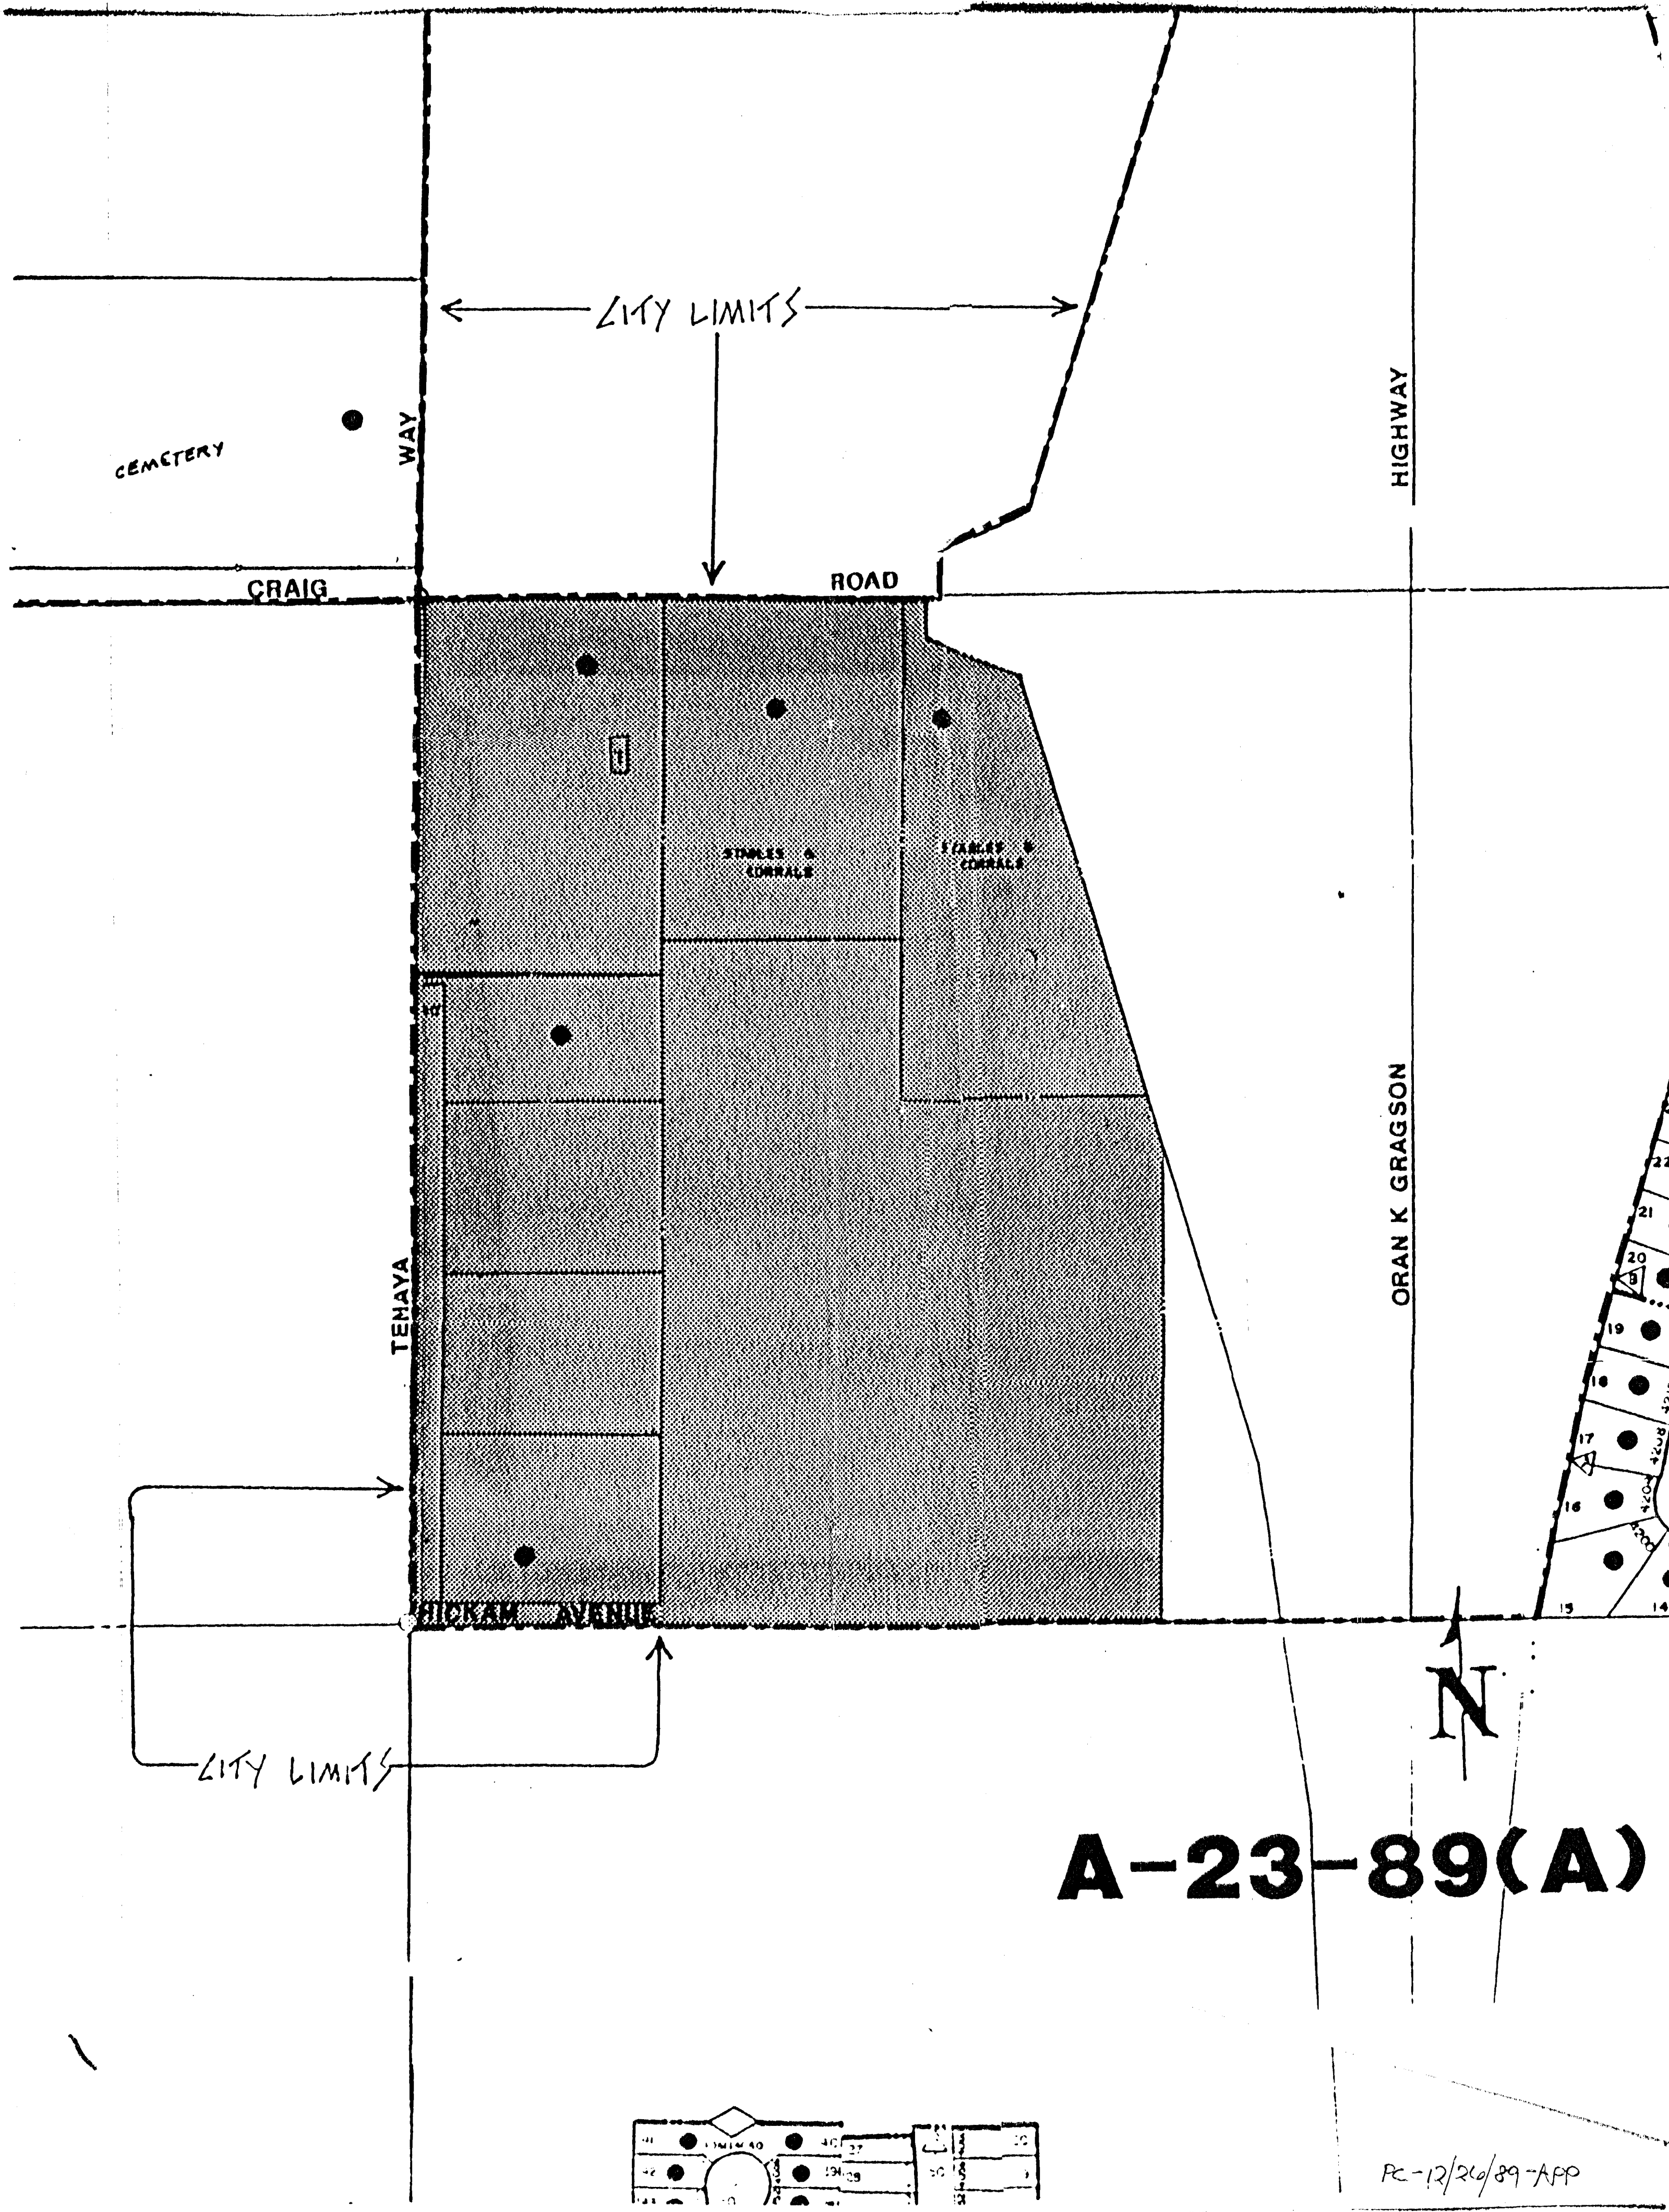

A-23-89(A)

PC-12/26/89-APP