


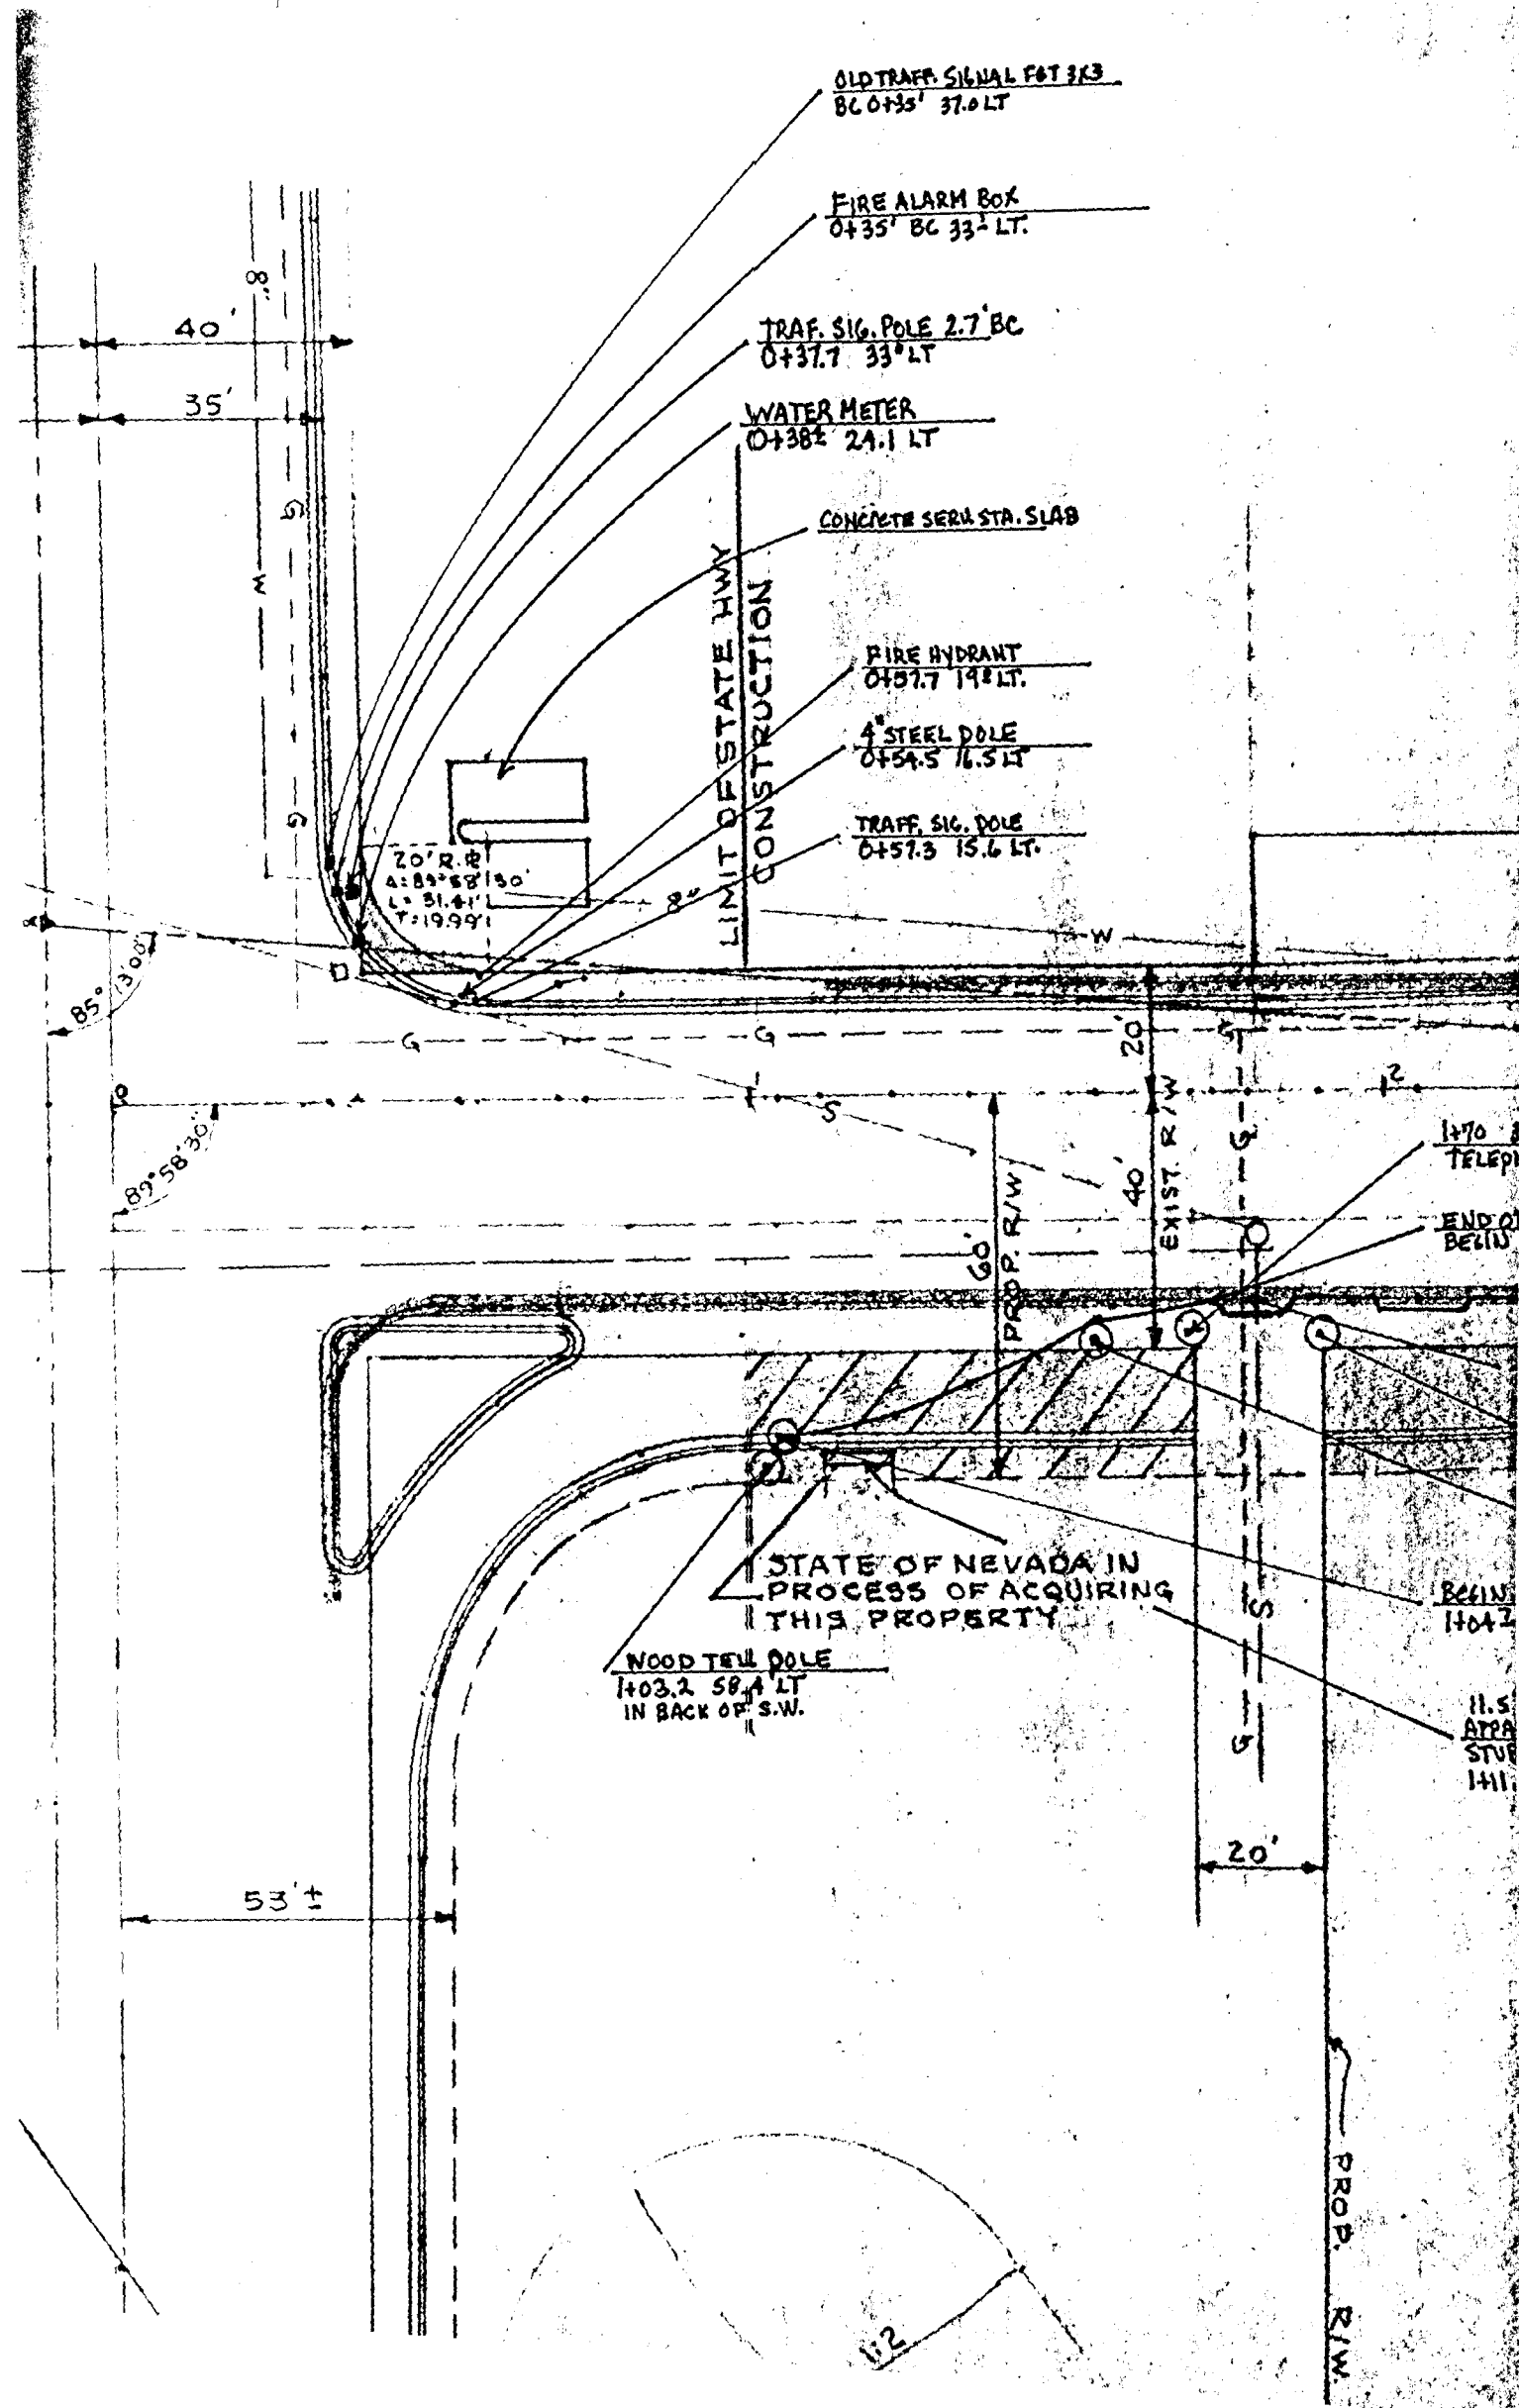

CURVE DATA

1760'
6°00'00"
92.24'
184.31'

