


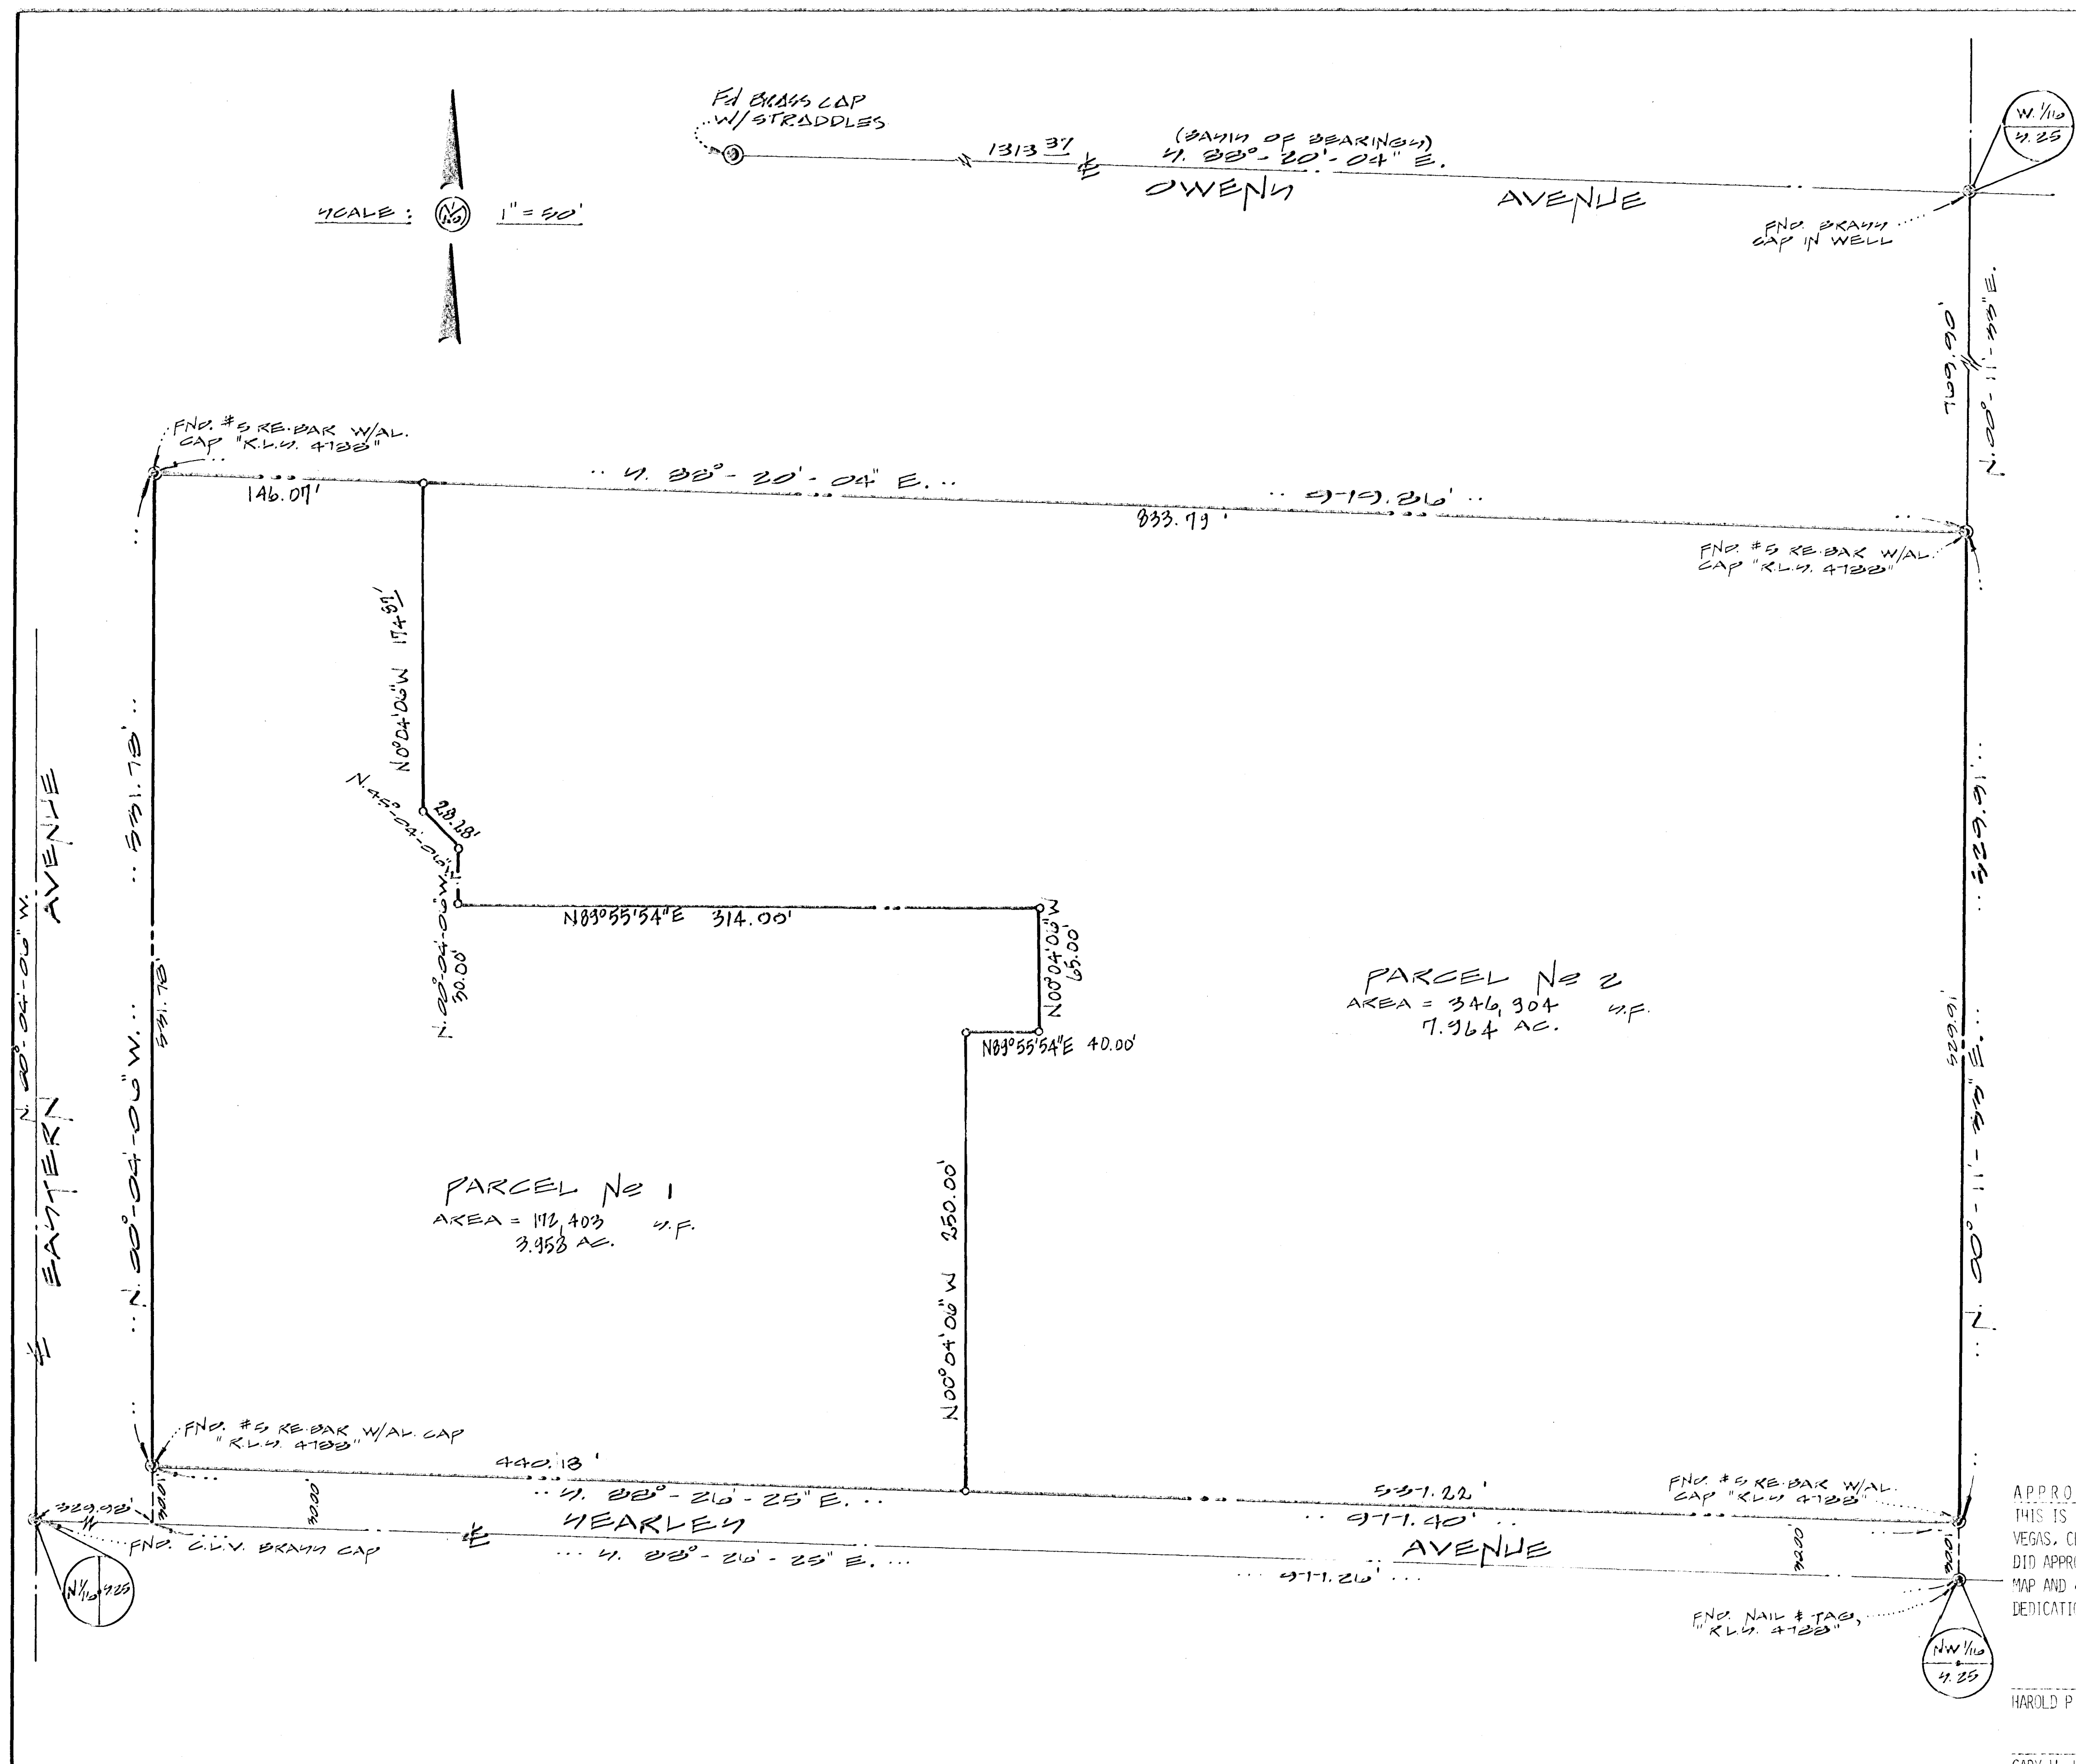

OWNER'S CERTIFICATE & DEDICATION
ARTHUR D. SARTINI, SECRETARY & EXECUTIVE DIRECTOR, HOUSING AUTHORITY OF THE CITY OF LAS VEGAS, DOES HEREBY CERTIFY THAT BEING THE OWNERS OF THE LANDS SUBDIVIDED WITHIN THE BOUNDARY SHOWN HEREON CONSENT TO THE PREPARATION AND RECORDATION OF THIS PARCEL MAP; HAVE CAUSED THE LAND TO BE SURVEYED AND PLATTED INTO PARCELS AND STREETS AS SHOWN HEREON; WE DO HEREBY OFFER AND DEDICATE TO THE CITY OF LAS VEGAS, ITS SUCCESSOR'S AND ASSIGNS ANY PUBLIC STREETS OR ALLEYS, EXCEPT PRIVATE STREETS, AS MAY BE SHOWN HEREON FOR THE USE OF THE PUBLIC, AND DO HEREBY DEDICATE EASEMENTS FOR CONSTRUCTION AND MAINTENANCE OF SUBTERRANEAN PUBLIC UTILITIES, AND SUCH STREET IMPROVEMENT AND DRAINAGE AS REQUIRED PER NRS 278.010 THROUGH 278.630.

DATE 11/7/79
ARTHUR D. SARTINI,
SECRETARY & EXECUTIVE DIRECTOR
HOUSING AUTHORITY, CITY OF LAS VEGAS
ACKNOWLEDGEMENT

STATE OF NEVADA) SS
COUNTY OF CLARK
ON THIS 7th DAY OF Nov., 1979, THE ABOVE MENTIONED ARTHUR D. SARTINI, PERSONALLY APPEARED BEFORE ME, A NOTARY PUBLIC, AND ACKNOWLEDGED THAT THEY EXECUTED THE ABOVE INSTRUMENT.

Sarah Lambert
SARAH LAMBERT
NOTARY PUBLIC IN AND FOR SAID COUNTY AND STATE
MY COMMISSION EXPIRES: 3 AUG 1981

SURVEYOR'S CERTIFICATE
I, BORIS NARIZNY, A DULY REGISTERED LAND SURVEYOR IN THE STATE OF NEVADA, DO HEREBY CERTIFY THAT THIS PLAT ACCURATELY DELINEATES A SURVEY PERFORMED BY ME OR UNDER MY DIRECT SUPERVISION AT THE INSTANCE OF THE HOUSING AUTHORITY OF THE CITY OF LAS VEGAS, THAT THIS SURVEY CONFORMS WITH THE PROVISIONS OF NRS 278.010 TO 278.630, AND THAT THE POINTS FOUND OR SET ARE AS SHOWN HEREON AND SAID POINTS ARE SUFFICIENT FOR THIS SURVEY TO BE RETRACED. THIS SURVEY WAS COMPLETED ON 30 OCT 1979.
Boris Narizny
BORIS NARIZNY
REGISTERED LAND SURVEYOR
NEVADA CERTIFICATE NO. 4788

APPROVAL
THIS IS TO CERTIFY THAT THE DEPARTMENT OF COMMUNITY PLANNING & DEVELOPMENT, CITY OF LAS VEGAS, CLARK COUNTY, NEVADA, THIS DAY OF , 1979, DID APPROVE FOR PURPOSES OF LAND DIVISION AND ACCEPT, ON BEHALF OF THE PUBLIC, THIS MAP AND ANY PARCEL OF LAND OFFERED FOR DEDICATION IN CONFORMITY WITH THE OFFER OF DEDICATION, PER NRS 278.010 THROUGH 278.630.

HAROLD P. FOSTER, DIRECTOR
GARY W. HOLLER, R.L.S., 1920, CITY ENGINEER

LEGEND
③ - FOUND POINT AS DESIGNATED
○ - SET 5/8" RE-BAR, W/ALUM CAP "K.L.W. 4122"

BEARING OF BEARING:
THE NORTH SECTION LINE OF THE WEST HALF OF SECTION 25, BEING 4.22°-20'-04" E. AS SHOWN ON FILE 14, PAGE 12 & FILE 34, PAGE 11 OF SURVEY RECORDS, OFFICE OF THE COUNTY RECORDER, CLARK COUNTY, NEVADA.


NOTE: THIS PARCEL MAP AMENDS THE INTERIOR DIVISION LINE OF PARCEL MAP FILE 29 PAGE 41 as recorded at the Clark County, Nev. Recorder's office.

REFERENCE
RECORD OF SURVEY, FILE 34, PAGE 11
PARCEL MAP, FILE 29 PAGE 41
Boris Narizny
BORIS NARIZNY
R.L.S. 4122
14 JAN 1980

AMENDED PARCEL MAP for the CITY OF LAS VEGAS HOUSING AUTHORITY A PORTION OF THE NW 1/4 OF THE NW 1/4 OF SECTION 25, T.20N., R.10E., M.2M., CITY OF LAS VEGAS, CLARK COUNTY, NEVADA NEPTUNE SURVEYOR 3000 MIAMI AVENUE SUITE 1 LAS VEGAS, NEVADA 89102 (702) 812-8126		NO. <u> </u> FILED AT THE REQUEST OF CITY OF LAS VEGAS HOUSING AUTHORITY DATE <u> </u> AT <u> </u> FILE <u> </u> PAGE <u> </u> OF PARCEL MAPS OFFICIAL RECORDS BOOK NO. <u> </u> CLARK COUNTY, NEVADA RECORDS JOAN L. SWIFT, RECORDER FEE <u> </u> DEPUTY
--	--	--

FILE , PAGE

PM-88-79
REVISED
Note: Signed BY

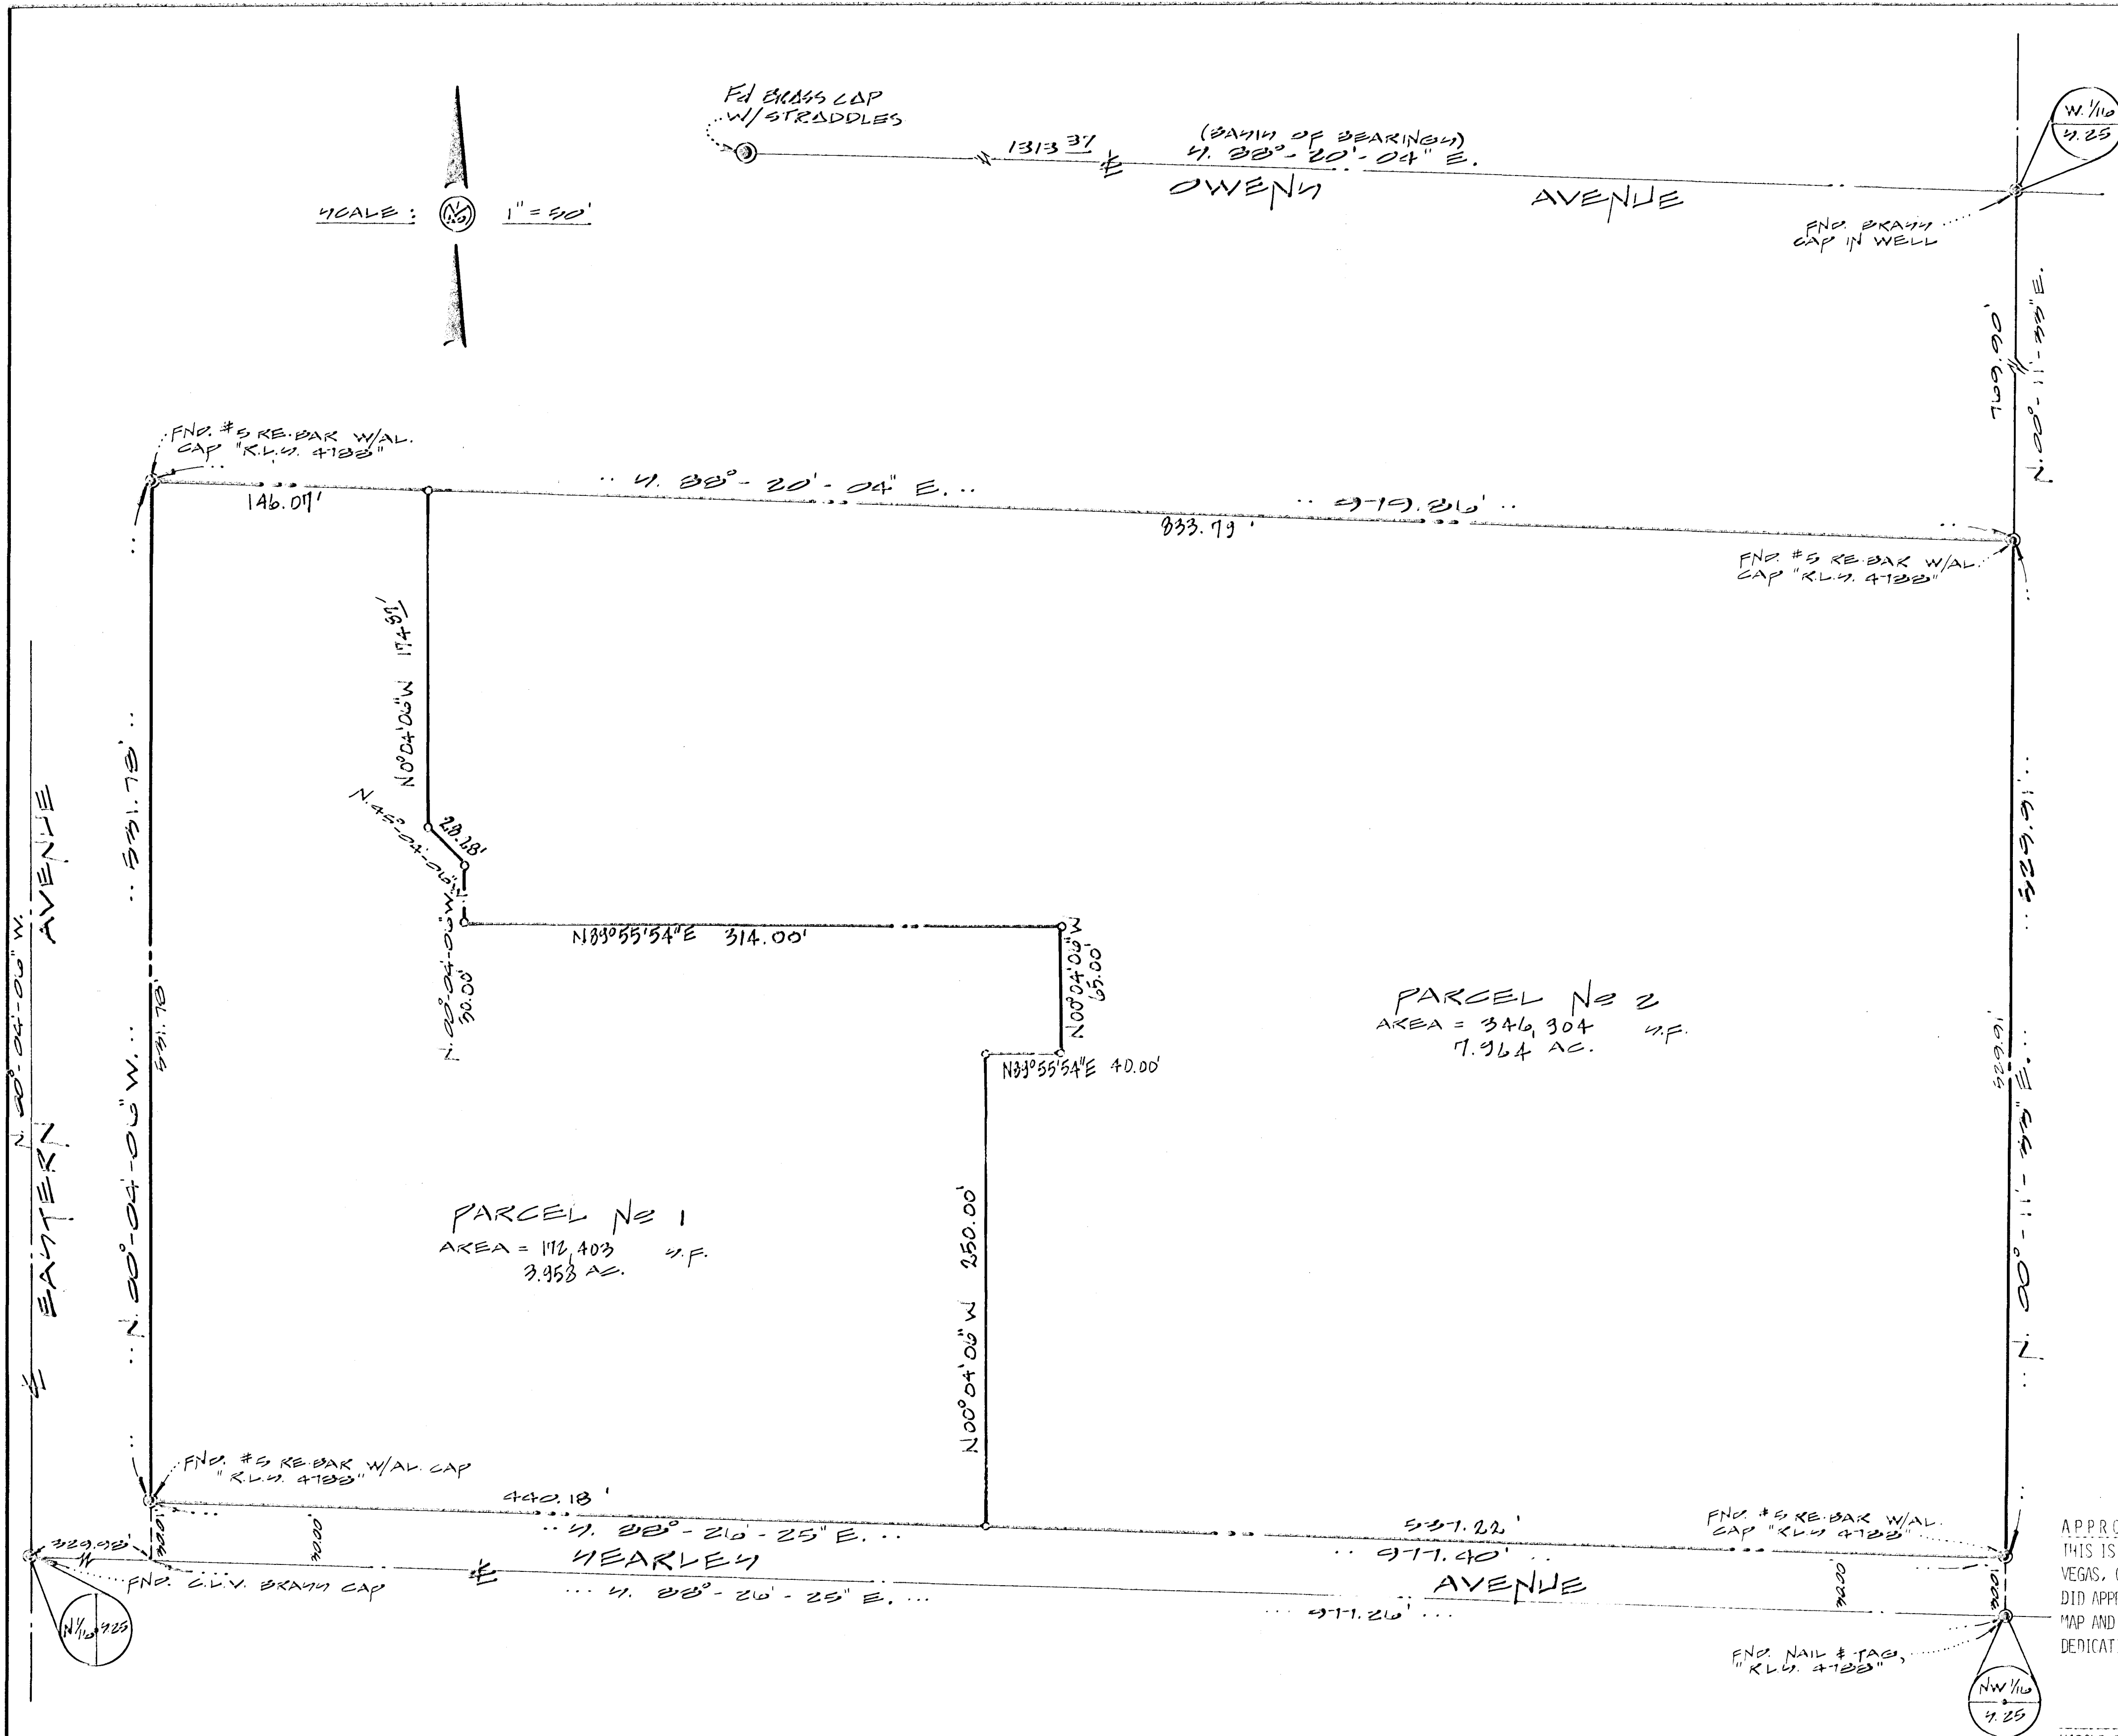

OWNER'S CERTIFICATE & DEDICATION
ARTHUR D. SARTINI, SECRETARY & EXECUTIVE DIRECTOR, HOUSING AUTHORITY OF THE CITY OF LAS VEGAS, DOES HEREBY CERTIFY THAT BEING THE OWNERS OF THE LANDS SUBDIVIDED WITHIN THE BOUNDARY SHOWN HEREON CONSENT TO THE PREPARATION AND RECORDATION OF THIS PARCEL MAP; HAVE CAUSED THE LAND TO BE SURVEYED AND PLATTED INTO PARCELS AND STREETS AS SHOWN HEREON; HE DO HEREBY OFFER AND DEDICATE TO THE CITY OF LAS VEGAS, ITS SUCCESSOR'S AND ASSIGNS ANY PUBLIC STREETS OR ALLEYS, EXCEPT PRIVATE STREETS, AS MAY BE SHOWN HEREON FOR THE USE OF THE PUBLIC, AND DO HEREBY DEDICATE EASEMENTS FOR CONSTRUCTION AND MAINTENANCE OF SUBTERRANEAN PUBLIC UTILITIES, AND SUCH STREET IMPROVEMENT AND DRAINAGE AS REQUIRED PER NRS 278,010 THROUGH 278,630.

DATE 11/7/79
ARTHUR D. SARTINI, SECRETARY & EXECUTIVE DIRECTOR, HOUSING AUTHORITY, CITY OF LAS VEGAS
ACKNOWLEDGEMENT

STATE OF NEVADA) SS
COUNTY OF CLARK
ON THIS 14 DAY OF Nov., 1979, THE ABOVE MENTIONED ARTHUR D. SARTINI, PERSONALLY APPEARED BEFORE ME, A NOTARY PUBLIC, AND ACKNOWLEDGED THAT THEY EXECUTED THE ABOVE INSTRUMENT.

SARAH LAMBERT
NOTARY PUBLIC IN AND FOR SAID COUNTY AND STATE
MY COMMISSION EXPIRES: 3 AUG 1981

SURVEYOR'S CERTIFICATE
I, BORIS NARIZNY, A DULY REGISTERED LAND SURVEYOR IN THE STATE OF NEVADA, DO HEREBY CERTIFY THAT THIS PLAT ACCURATELY DELINEATES A SURVEY PERFORMED BY ME OR UNDER MY DIRECT SUPERVISION AT THE INSTANCE OF THE HOUSING AUTHORITY OF THE CITY OF LAS VEGAS, THAT THIS SURVEY CONFORMS WITH THE PROVISIONS OF NRS 278,010 TO 278,630, AND THAT THE POINTS FOUND OR SET ARE AS SHOWN HEREON AND SAID POINTS ARE SUFFICIENT FOR THIS SURVEY TO BE RETRACED. THIS SURVEY WAS COMPLETED ON 30 OCT 1979.
BORIS NARIZNY
REGISTERED LAND SURVEYOR
NEVADA CERTIFICATE NO. 4738

APPROVAL
THIS IS TO CERTIFY THAT THE DEPARTMENT OF COMMUNITY PLANNING & DEVELOPMENT, CITY OF LAS VEGAS, CLARK COUNTY, NEVADA, THIS DAY OF , 1979, DID APPROVE FOR PURPOSES OF LAND DIVISION AND ACCEPT, ON BEHALF OF THE PUBLIC, THIS MAP AND ANY PARCEL OF LAND OFFERED FOR DEDICATION IN CONFORMITY WITH THE OFFER OF DEDICATION, PER NRS 278,010 THROUGH 278,630.

HAROLD P. FOSTER, DIRECTOR
GARY N. HOLLER, R.L.S., 1920, CITY ENGINEER

LEGEND
① - FOUND POINT AS DESIGNATED
② - SET 5/8" RE. BAK, W/ALUM CAP "K.L.W. 4788"

BEARING OF BEARING:
THE NORTH SECTION LINE OF THE WEST HALF OF SECTION 25, BEING 4.28°-20'-04"E. AS SHOWN ON FILE 14, PAGE 78 & FILE 34, PAGE 11 OF SURVEY RECORD, OFFICE OF THE COUNTY RECORDER, CLARK COUNTY, NEVADA.

NOTE: THIS PARCEL MAP AMENDS THE INTERIOR DIVISION LINE OF PARCEL MAP FILE 29 PAGE 41 as recorded at the Clark County, Nev. Recorder's office.


REFERENCE
RECORD OF SURVEY; FILE 34, PAGE 11
PARCEL MAP FILE 29 PAGE 41

PM-88-72
REVISED
AMENDED PARCEL MAP for the
CITY OF LAS VEGAS HOUSING AUTHORITY
A PORTION OF THE NW 1/4 OF THE NW 1/4 OF SECTION 25, T20N, R10E, M22M, CITY OF LAS VEGAS, CLARK COUNTY, NEVADA
NEPTUNE SURVEYOR
3000 WIKIWA AVENUE
SUITE 7
LAS VEGAS, NEVADA 89102
(702) 875-2120
BORIS NARIZNY
14 JAN 1980
BORIS NARIZNY
R.L.S. 4738

FILED
JAN 17 1980

NO.
FILED AT THE REQUEST OF
CITY OF LAS VEGAS
HOUSING AUTHORITY
DATE AT
FILE PAGE OF
PARCEL MAPS OFFICIAL RECORDS
BOOK NO. CLARK COUNTY,
NEVADA RECORDS
JOAN L. SWIFT, RECORDER
FEE DEPUTY

FILE , PAGE

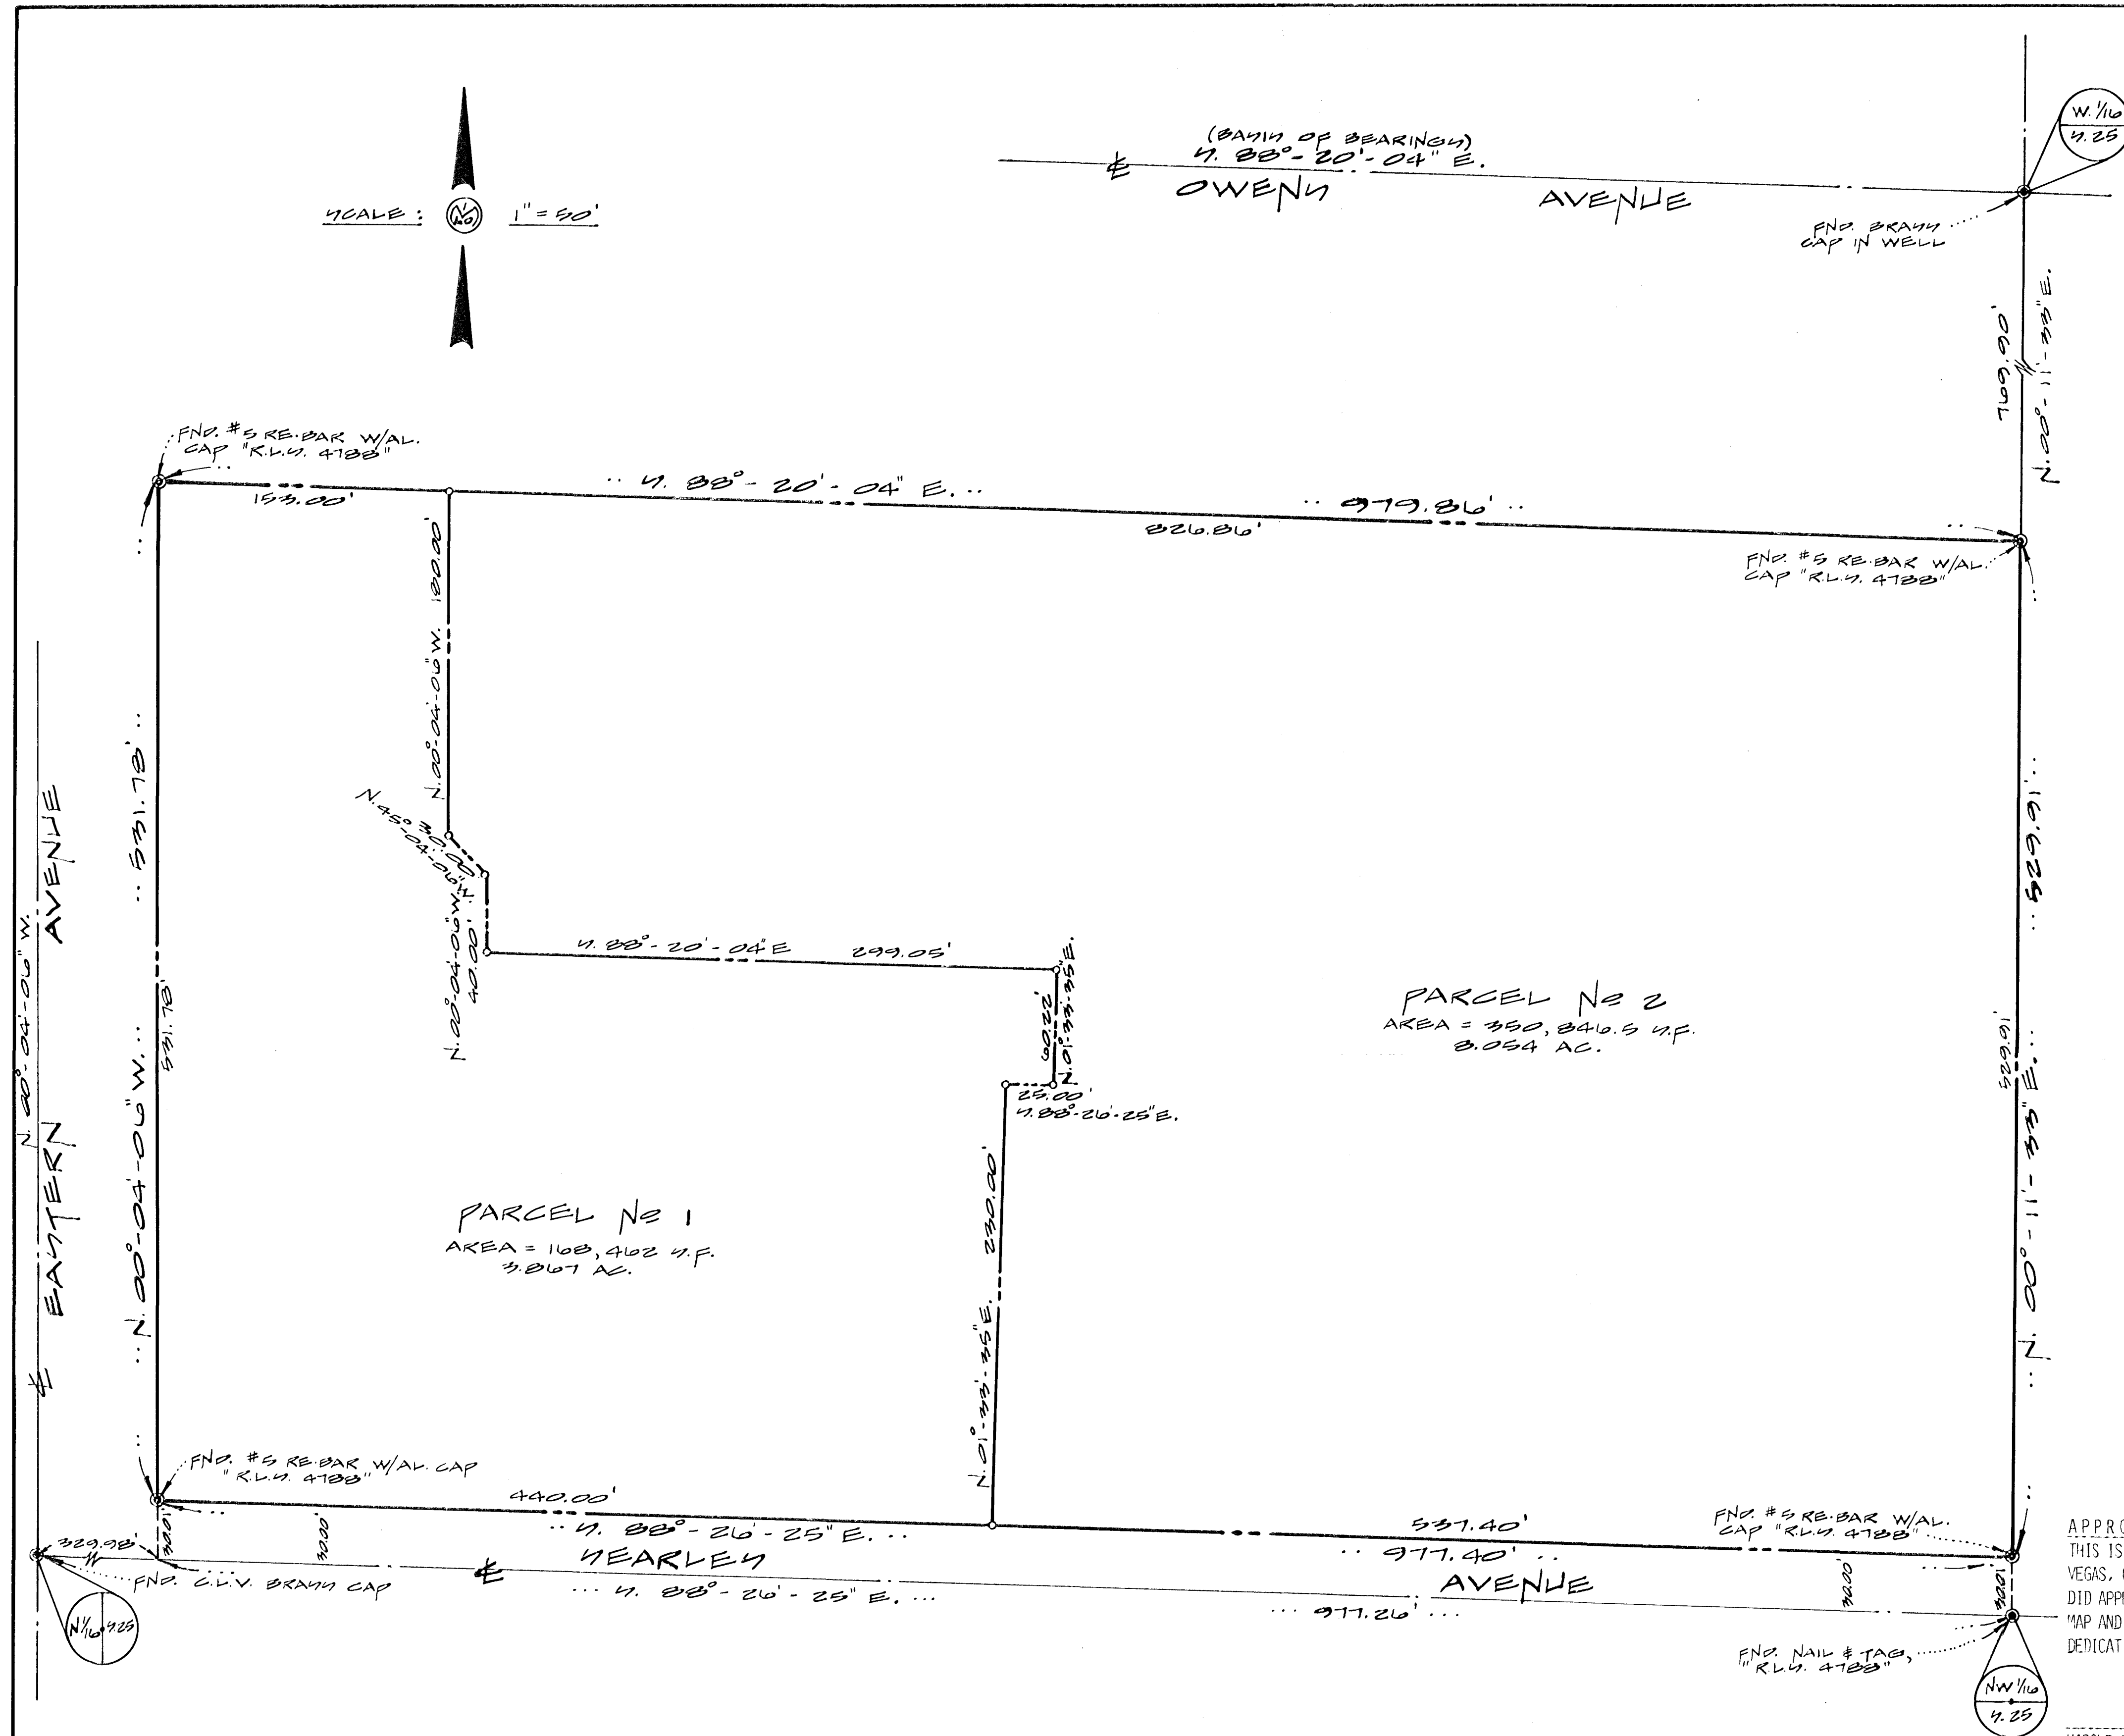

LEGEND

- ① - FOUND POINT AS DESIGNATED
- - SET 5/8" RE. BAR, TAGGED "R.L.M. 4788"

BEARING OF BEARING:

THE NORTH SECTION LINE OF THE WEST HALF OF SECTION 25, BEING 4.88°-20'-04"E. AS SHOWN ON FILE 14, PAGE 78 & FILE 34, PAGE 71 OF SURVEY RECORD, OFFICE OF THE COUNTY RECORDER, CLARK COUNTY, NEVADA.

REFERENCE

RECORD OF SURVEY; FILE 34, PAGE 71

OWNER'S CERTIFICATE & DEDICATION

ARTHUR D. SARTINI, SECRETARY & EXECUTIVE DIRECTOR, HOUSING AUTHORITY OF THE CITY OF LAS VEGAS, DOES HEREBY CERTIFY THAT BEING THE OWNERS OF THE LANDS SUBDIVIDED WITHIN THE BOUNDARY SHOWN HEREON CONSENT TO THE PREPARATION AND RECORDATION OF THIS PARCEL MAP; HAVE CAUSED THE LAND TO BE SURVEYED AND PLATTED INTO PARCELS AND STREETS AS SHOWN HEREON; WE DO HEREBY OFFER AND DEDICATE TO THE CITY OF LAS VEGAS, ITS SUCCESSOR'S AND ASSIGNS ANY PUBLIC STREETS OR ALLEYS, EXCEPT PRIVATE STREETS, AS MAY BE SHOWN HEREON FOR THE USE OF THE PUBLIC, AND DO HEREBY DEDICATE EASEMENTS FOR CONSTRUCTION AND MAINTENANCE OF SUBTERRANEAN PUBLIC UTILITIES, AND SUCH STREET IMPROVEMENT AND DRAINAGE AS REQUIRED PER NRS 278.010 THROUGH 278.630.

ARTHUR D. SARTINI, SECRETARY & EXECUTIVE DIRECTOR
DATE 11/17/79

ACKNOWLEDGEMENT

STATE OF NEVADA) SS
COUNTY OF CLARK

ON THIS 21 DAY OF 11, 1979, THE ABOVE MENTIONED ARTHUR D. SARTINI, PERSONALLY APPEARED BEFORE ME, A NOTARY PUBLIC, AND ACKNOWLEDGED THAT THEY EXECUTED THE ABOVE INSTRUMENT.

SARAH LAMBERT

NOTARY PUBLIC IN AND FOR SAID COUNTY AND STATE
MY COMMISSION EXPIRES: 3 AUG 1981

SURVEYOR'S CERTIFICATE

I, BORIS NARIZNY, A DULY REGISTERED LAND SURVEYOR IN THE STATE OF NEVADA, DO HEREBY CERTIFY THAT THIS PLAT ACCURATELY DELINEATES A SURVEY PERFORMED BY ME OR UNDER MY DIRECT SUPERVISION AT THE INSTANCE OF THE HOUSING AUTHORITY OF THE CITY OF LAS VEGAS, THAT THIS SURVEY CONFORMS WITH THE PROVISIONS OF NRS 278.010 TO 278.630, AND THAT THE POINTS FOUND OR SET ARE AS SHOWN HEREON AND SAID POINTS ARE SUFFICIENT FOR THIS SURVEY TO BE RETRACED. THIS SURVEY WAS COMPLETED ON 30 OCT 1979.

Boris Narizny
BORIS NARIZNY
REGISTERED LAND SURVEYOR
NEVADA CERTIFICATE NO. 4738

APPROVAL


THIS IS TO CERTIFY THAT THE DEPARTMENT OF COMMUNITY PLANNING & DEVELOPMENT, CITY OF LAS VEGAS, CLARK COUNTY, NEVADA, THIS 11 DAY OF 11, 1979, DID APPROVE FOR PURPOSES OF LAND DIVISION AND ACCEPT, ON BEHALF OF THE PUBLIC, THIS MAP AND ANY PARCEL OF LAND OFFERED FOR DEDICATION IN CONFORMITY WITH THE OFFER OF DEDICATION, PER NRS 278.010 THROUGH 278.630.

HAROLD P. FOSTER, DIRECTOR

GARY N. HOLLER, R.L.S. 1920, CITY ENGINEER

- PARCEL MAP - - FOR -		NO. _____
CITY OF LAS VEGAS HOUSING AUTHORITY		FILED AT THE REQUEST OF <u>BORIS NARIZNY</u>
A PORTION OF THE NW 1/4 OF THE NW 1/4 OF SECTION 25, T. 20N., R. 10E., M. 11N., CITY OF LAS VEGAS, CLARK COUNTY, NEVADA		DATE _____ AT _____
NEPTUNE SURVEYOR 3300 WILKIN AVENUE SUITE 7 LAS VEGAS, NEVADA 89102 (702) 875-8126		FILE _____ PAGE _____ OF PARCEL MAPS OFFICIAL RECORDS BOOK NO. _____ CLARK COUNTY, NEVADA RECORDS JOAN L. SWIFT, RECORDER FEE _____ DEPUTY

FILE _____, PAGE _____

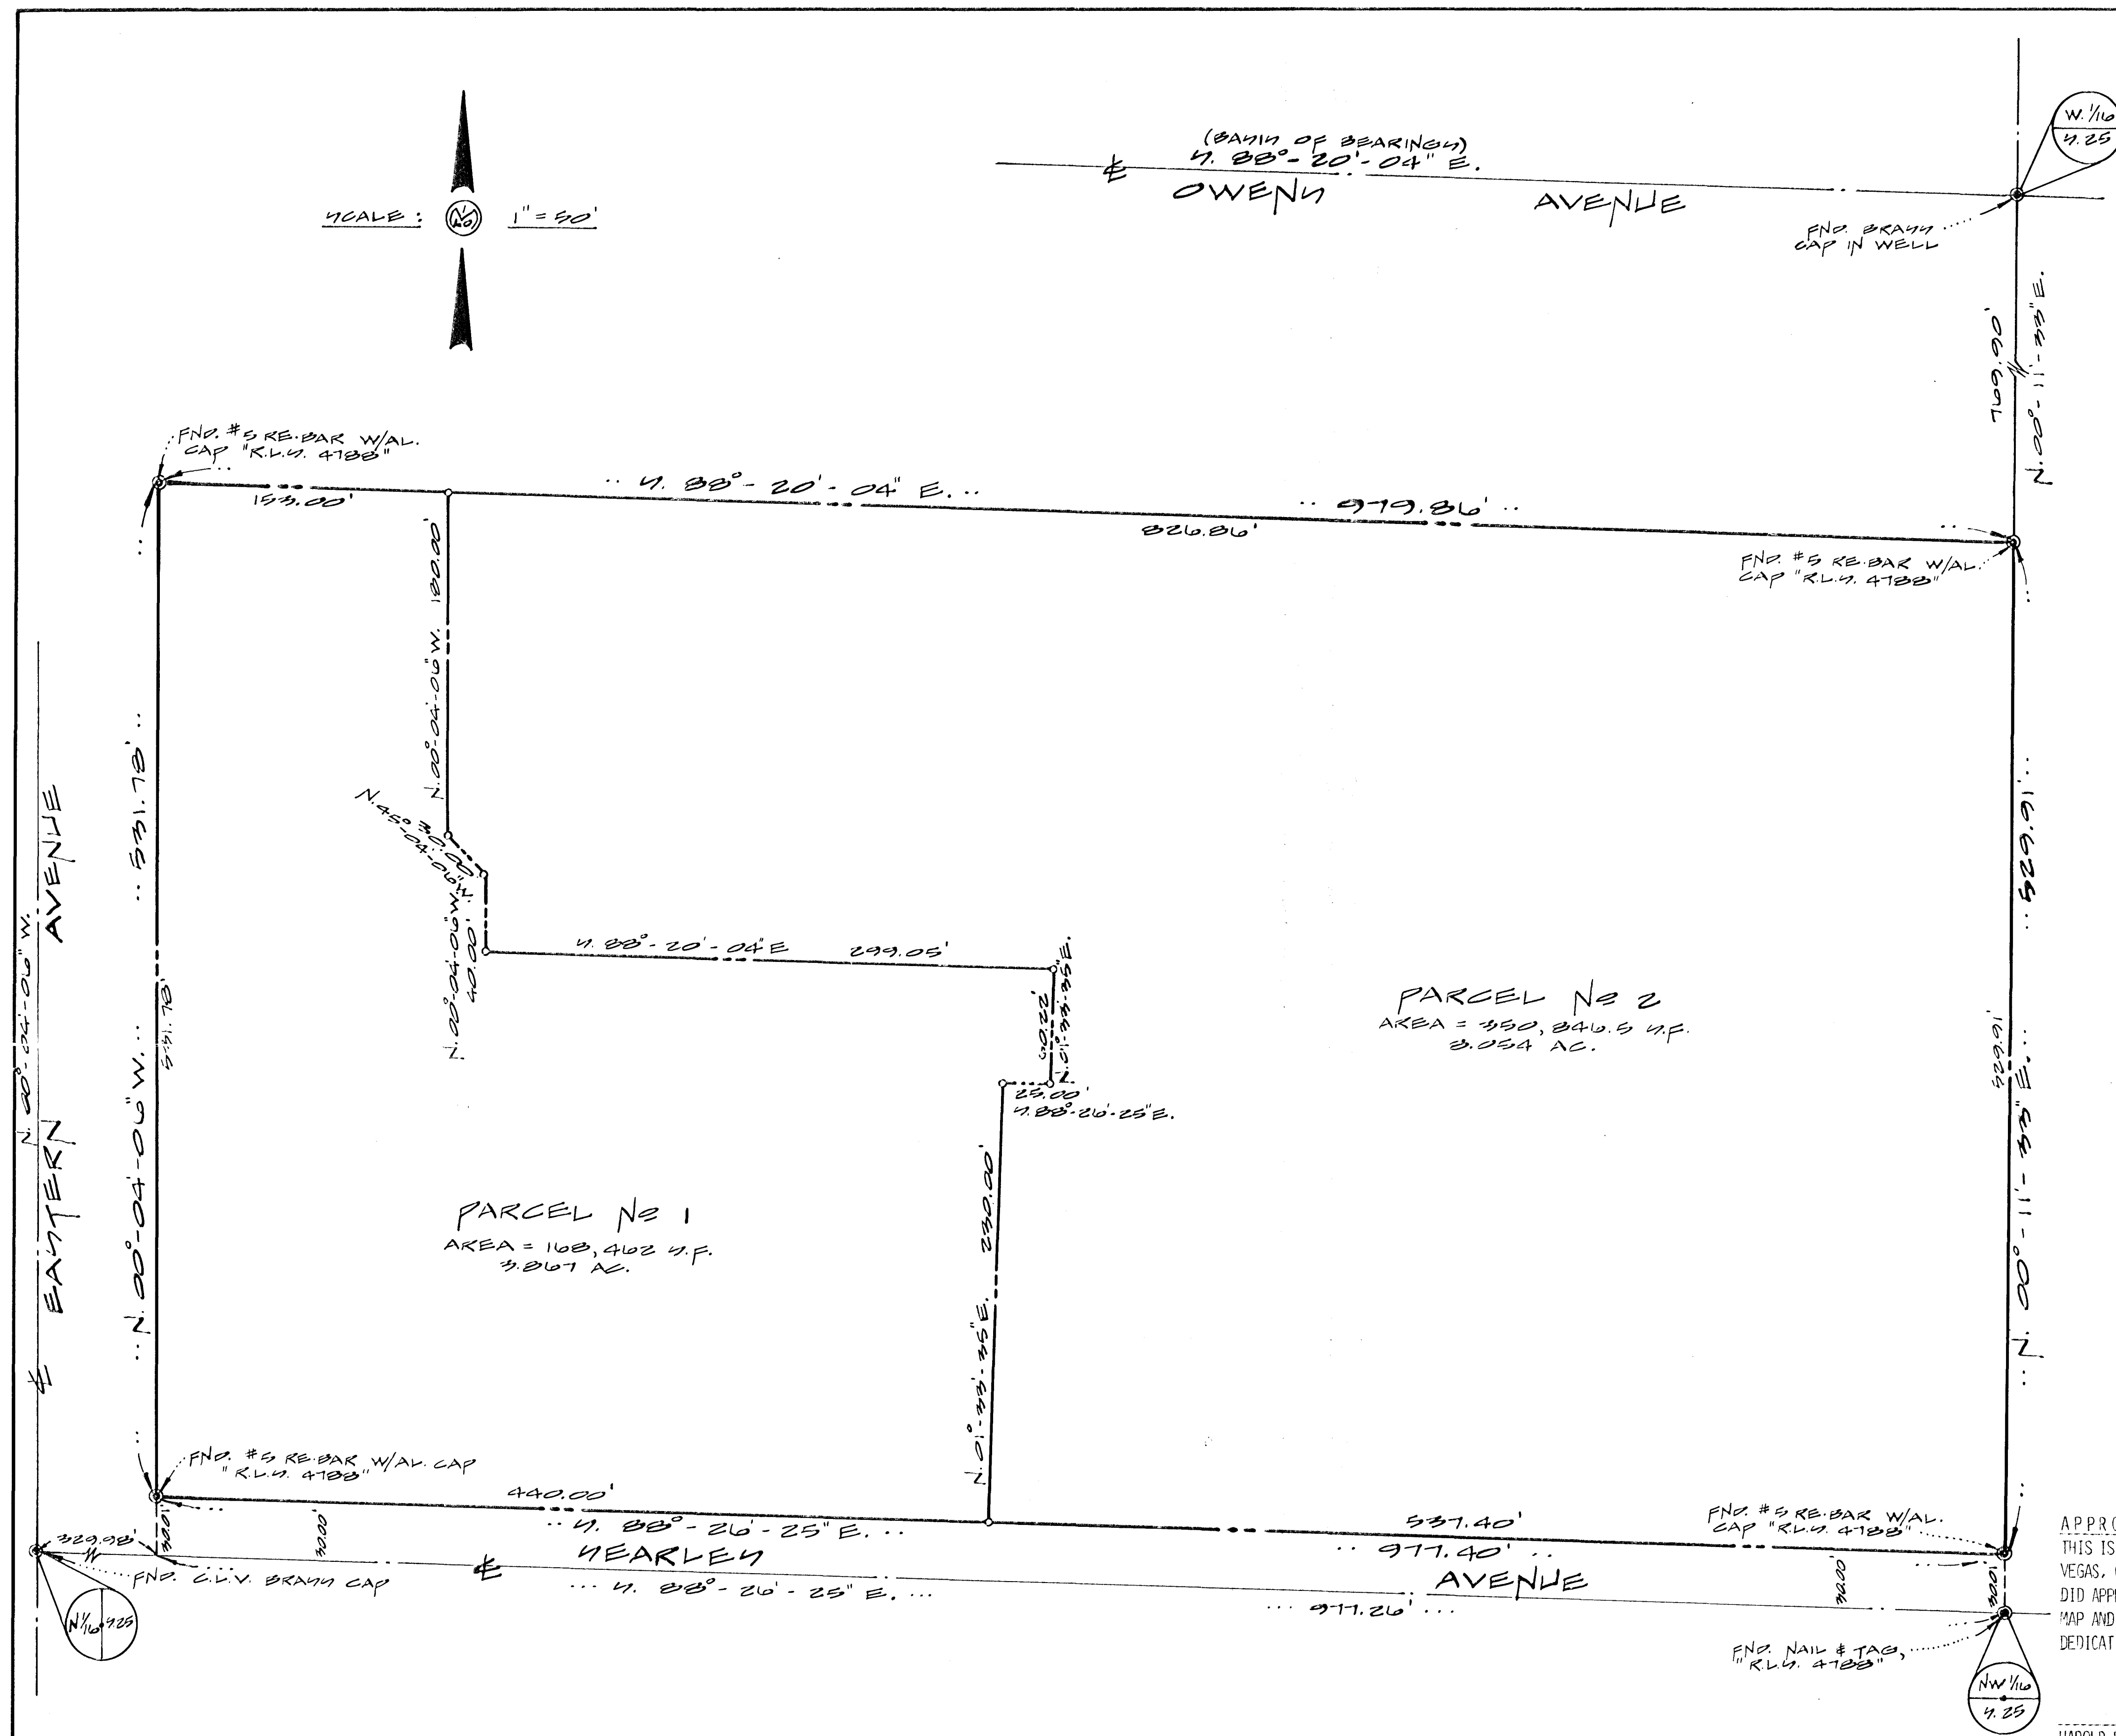

OWNER'S CERTIFICATE & DEDICATION

ARTHUR D. SARTINI, SECRETARY & EXECUTIVE DIRECTOR, HOUSING AUTHORITY OF THE CITY OF LAS VEGAS, DOES HEREBY CERTIFY THAT BEING THE OWNERS OF THE LANDS SUBDIVIDED WITHIN THE BOUNDARY SHOWN HEREON CONSENT TO THE PREPARATION AND RECORD ATION OF THIS PARCEL MAP; HAVE CAUSED THE LAND TO BE SURVEYED AND PLATTED INTO PARCELS AND STREETS AS SHOWN HEREON; WE DO HEREBY OFFER AND DEDICATE TO THE CITY OF LAS VEGAS, IT'S SUCCESSOR'S AND ASSIGNS ANY PUBLIC STREETS OR ALLEYS, EXCEPT PRIVATE STREETS, AS MAY BE SHOWN HEREON FOR THE USE OF THE PUBLIC, AND DO HEREBY DEDICATE EASEMENTS FOR CONSTRUCTION AND MAINTENANCE OF SUBTERRANEAN PUBLIC UTILITIES, AND SUCH STREET IMPROVEMENT AND DRAINAGE AS REQUIRED PER NRS 278.010 THROUGH 278.630.

ARTHUR D. SARTINI, SECRETARY & EXECUTIVE DIRECTOR
DATE 11/17/79

ACKNOWLEDGEMENT

STATE OF NEVADA) SS
COUNTY OF CLARK
ON THIS 24 DAY OF 11, 1979, THE ABOVE MENTIONED ARTHUR D. SARTINI, PERSONALLY APPEARED BEFORE ME, A NOTARY PUBLIC, AND ACKNOWLEDGED THAT THEY EXECUTED THE ABOVE INSTRUMENT.

SARAH LAMBERT
NOTARY PUBLIC IN AND FOR SAID COUNTY AND STATE
MY COMMISSION EXPIRES: 3 AUG 1981

SURVEYOR'S CERTIFICATE

I, BORIS NARIZNY, A DULY REGISTERED LAND SURVEYOR IN THE STATE OF NEVADA, DO HEREBY CERTIFY THAT THIS PLAT ACCURATELY DELINEATES A SURVEY PERFORMED BY ME OR UNDER MY DIRECT SUPERVISION AT THE INSTANCE OF THE HOUSING AUTHORITY OF THE CITY OF LAS VEGAS, THAT THIS SURVEY CONFORMS WITH THE PROVISIONS OF NRS 278.010 TO 278.630, AND THAT THE POINTS FOUND OR SET ARE AS SHOWN HEREON AND SAID POINTS ARE SUFFICIENT FOR THIS SURVEY TO BE RETRACED. THIS SURVEY WAS COMPLETED ON 30 OCT 1979.

BORIS NARIZNY
REGISTERED LAND SURVEYOR
NEVADA CERTIFICATE NO. 4788

APPROVAL
THIS IS TO CERTIFY THAT THE DEPARTMENT OF COMMUNITY PLANNING & DEVELOPMENT, CITY OF LAS VEGAS, CLARK COUNTY, NEVADA, THIS DAY OF 11, 1979, DID APPROVE FOR PURPOSES OF LAND DIVISION AND ACCEPT, ON BEHALF OF THE PUBLIC, THIS MAP AND ANY PARCEL OF LAND OFFERED FOR DEDICATION IN CONFORMITY WITH THE OFFER OF DEDICATION, PER NRS 278.010 THROUGH 278.630.

HAROLD P. FOSTER, DIRECTOR

GARY N. HOLLER, R.L.S., 1920, CITY ENGINEER

FILED
DEC 14 1979

LEGEND

- - FOUND POINT AS DESIGNATED
- - SET 5/8" RE. BAR, TAGGED "K.L.W. 4788"

BAVIN OF BEARING


THE NORTH SECTION LINE OF THE WEST HALF OF SECTION 25, BEING 4. 22°-20'-04" E. AS SHOWN ON FILE 14, PAGE 72 & FILE 34, PAGE 71 OF SURVEY RECORDS, OFFICE OF THE COUNTY RECORDER, CLARK COUNTY, NEVADA.

REFERENCE

RECORD OF SURVEY; FILE 34, PAGE 71

PARCEL MAP FOR CITY OF LAS VEGAS HOUSING AUTHORITY		NO. FILED AT THE REQUEST OF BORIS NARIZNY
A PORTION OF THE NW 1/4 OF THE NW 1/4 OF SECTION 25, T.20N., R.10E., M.2M., CITY OF LAS VEGAS, CLARK COUNTY, NEVADA		DATE AT FILE PAGE OF PARCEL MAPS OFFICIAL RECORDS BOOK NO. CLARK COUNTY, NEVADA RECORDS JOAN L. SWIFT, RECORDER FEE DEPUTY
NEPTUNE SURVEYOR 3300 MIKUNA AVENUE SUITE 7 LAS VEGAS, NEVADA 89102 (702) 273-8120		

FILE , PAGE

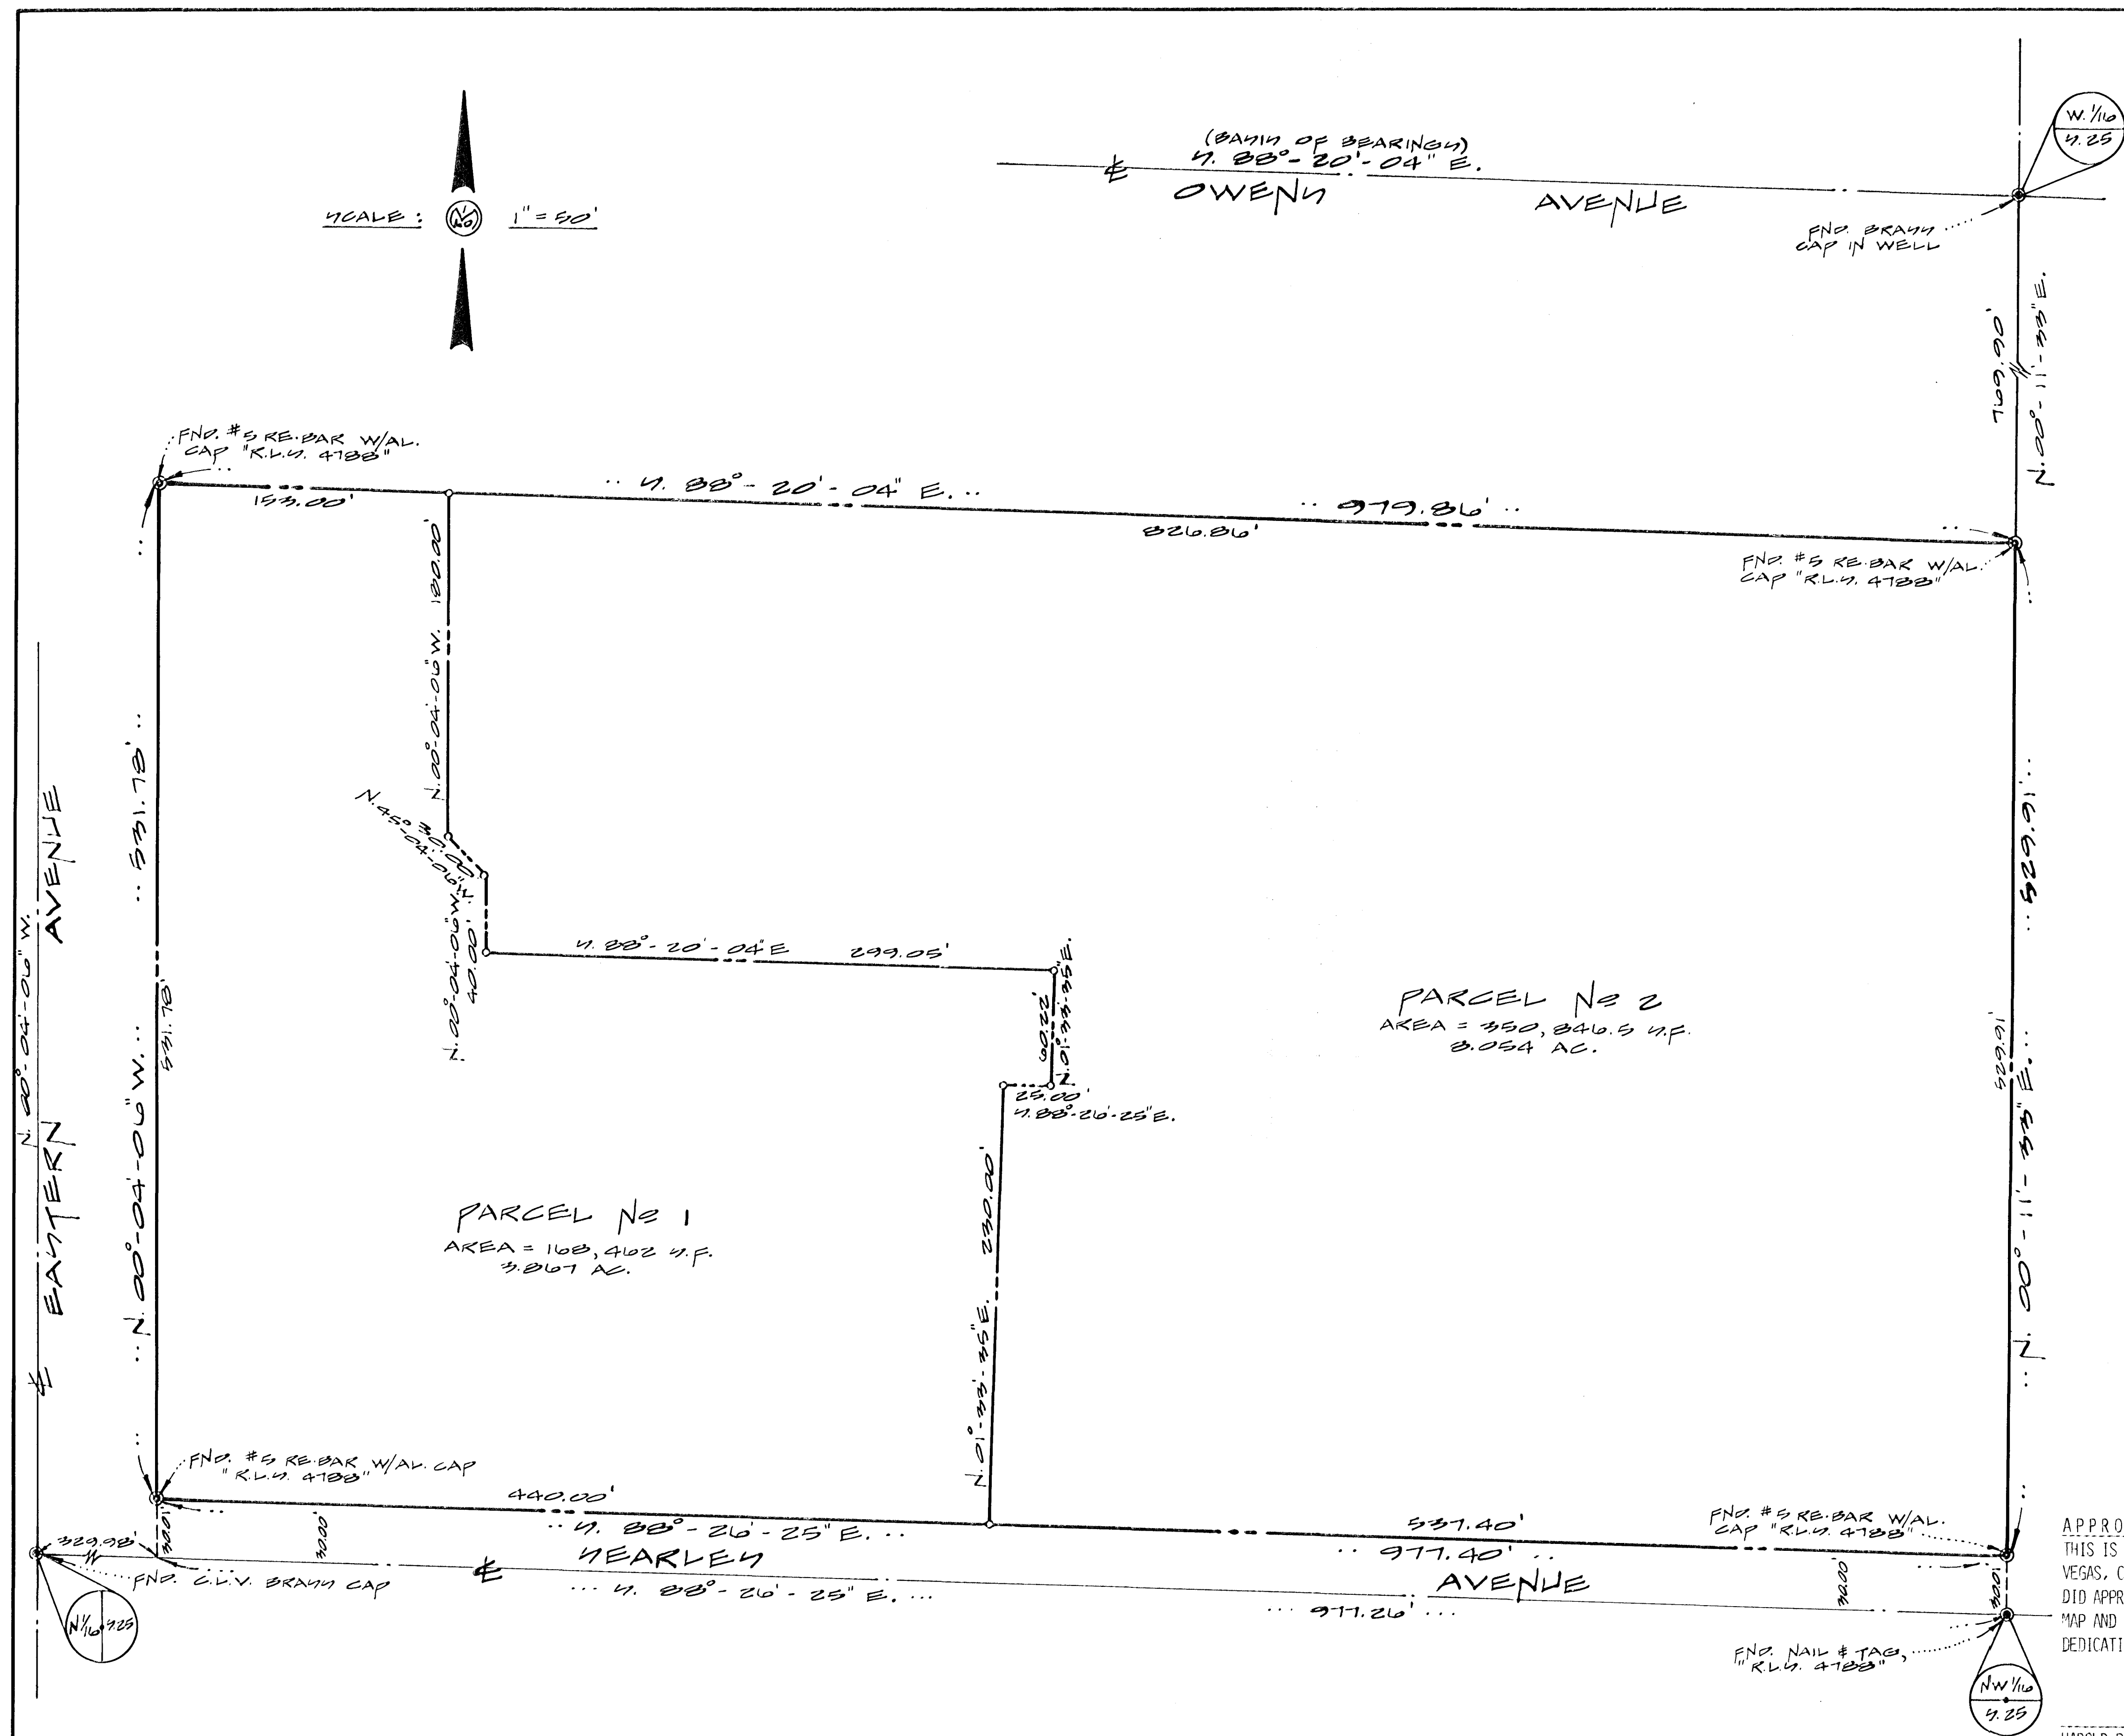

OWNER'S CERTIFICATE & DEDICATION
ARTHUR D. SARTINI, SECRETARY & EXECUTIVE DIRECTOR, HOUSING AUTHORITY OF THE CITY OF LAS VEGAS, DOES HEREBY CERTIFY THAT BEING THE OWNERS OF THE LANDS SUBDIVIDED WITHIN THE BOUNDARY SHOWN HEREON CONSENT TO THE PREPARATION AND RECORDATION OF THIS PARCEL MAP; HAVE CAUSED THE LAND TO BE SURVEYED AND PLATTED INTO PARCELS AND STREETS AS SHOWN HEREON; WE DO HEREBY OFFER AND DEDICATE TO THE CITY OF LAS VEGAS, ITS SUCCESSOR'S AND ASSIGNS ANY PUBLIC STREETS OR ALLEYS, EXCEPT PRIVATE STREETS, AS MAY BE SHOWN HEREON FOR THE USE OF THE PUBLIC, AND DO HEREBY DEDICATE EASEMENTS FOR CONSTRUCTION AND MAINTENANCE OF SUBTERRANEAN PUBLIC UTILITIES, AND SUCH STREET IMPROVEMENT AND DRAINAGE AS REQUIRED PER NRS 278.010 THROUGH 278.630.

ARTHUR D. SARTINI, SECRETARY & EXECUTIVE DIRECTOR
DATE

ACKNOWLEDGEMENT

STATE OF NEVADA) SS
COUNTY OF CLARK
ON THIS 27 DAY OF 1979, THE ABOVE MENTIONED ARTHUR D. SARTINI, PERSONALLY APPEARED BEFORE ME, A NOTARY PUBLIC, AND ACKNOWLEDGED THAT THEY EXECUTED THE ABOVE INSTRUMENT.

SARAH LAMBERT
NOTARY PUBLIC IN AND FOR SAID COUNTY AND STATE
MY COMMISSION EXPIRES: 3 AUG 1981

SURVEYOR'S CERTIFICATE

I, BORIS NARIZNY, A DULY REGISTERED LAND SURVEYOR IN THE STATE OF NEVADA, DO HEREBY CERTIFY THAT THIS PLAT ACCURATELY DELINEATES A SURVEY PERFORMED BY ME OR UNDER MY DIRECT SUPERVISION AT THE INSTANCE OF THE HOUSING AUTHORITY OF THE CITY OF LAS VEGAS, THAT THIS SURVEY CONFORMS WITH THE PROVISIONS OF NRS 278.010 TO 278.630, AND THAT THE POINTS FOUND OR SET ARE AS SHOWN HEREON AND SAID POINTS ARE SUFFICIENT FOR THIS SURVEY TO BE RETRACED. THIS SURVEY WAS COMPLETED ON 30 OCT 1979

Boris Narizny
BORIS NARIZNY
REGISTERED LAND SURVEYOR
NEVADA CERTIFICATE NO. 4788

APPROVAL
THIS IS TO CERTIFY THAT THE DEPARTMENT OF COMMUNITY PLANNING & DEVELOPMENT, CITY OF LAS VEGAS, CLARK COUNTY, NEVADA, THIS DAY OF 1979, DID APPROVE FOR PURPOSES OF LAND DIVISION AND ACCEPT, ON BEHALF OF THE PUBLIC, THIS MAP AND ANY PARCEL OF LAND OFFERED FOR DEDICATION IN CONFORMITY WITH THE OFFER OF DEDICATION, PER NRS 278.010 THROUGH 278.630.

HAROLD P. FOSTER, DIRECTOR

GARY W. HOLLER, R.L.S., 1920, CITY ENGINEER

STAFF COPY
FILED
DEC 11 1979

- LEGEND
- - FOUND POINT AS DESIGNATED
 - - SET 5/8" RE-BAR, TAGGED "K.L.V. 4188"

BAYIN OF BEARING:
THE NORTH SECTION LINE OF THE WEST HALF OF SECTION 25, BEING 4.88°-20'-04"E. AS SHOWN ON FILE 14, PAGE 78 & FILE 34, PAGE 71 OF SURVEY RECORDS, OFFICE OF THE COUNTY RECORDER, CLARK COUNTY, NEVADA.

REFERENCE
RECORD OF SURVEY; FILE 34, PAGE 71

-PARCEL MAP-	
-FOR-	
CITY OF LAS VEGAS HOUSING AUTHORITY	
A PORTION OF THE NW 1/4 OF THE NW 1/4 OF SECTION 25, T.20N., R.10E., M.2M., CITY OF LAS VEGAS, CLARK COUNTY, NEVADA	
NEPTUNE SURVEYORS 3300 WILLOW AVENUE SUITE 7 LAS VEGAS, NEVADA 89102 (702) 513-8120	
NO. _____	FILED AT THE REQUEST OF _____
DATE _____ AT _____	FILE _____ PAGE _____
PARCEL MAPS OFFICIAL RECORDS	
BOOK NO. _____ CLARK COUNTY,	NEVADA RECORDS
JOAN L. SWIFT, RECORDER	FEE _____ DEPUTY _____

FILE _____, PAGE _____