


COMMON ABBREVIATIONS

AB	ANCHOR BOLT	GLU-LAM	GLUE LAMINATED	W/ MIT	WITH MIT
AC	ACCOMMODATION (ING)	GP	GRADE	W/	WITH OUT
ADJ	ADJUTANT	HC	HOLLOW CORE	W/	W/
ALT	ALTERNATE	HT	HEIGHT	X BRG	CRIST BRIDGING
AP	APERTURE PANEL	HG	HEATING		
ED	EDGE	INCL	INSULATION		
BLDG	BUILDING	LY	LAYERS		
EM	BEAM	MC	MEDICINE CABINET		
EINT	BASEMENT	MECH	MECHANICAL		
BU	BUILT UP	NIC	NOT IN CONTRACT		
CR	CERAMIC	NZ	NUMBER		
CS	CASE WORK	OC	ON CENTER		
CLB	CEILING	OPR	OPENING		
COMB	COMBINATION	OSA	OUTSIDE AIR		
COMP	COMPOSITION	PART	PARTITION		
CONC	CONCRETE	PG	PAINT GRADE		
CONC BLK	CONCRETE BLOCK	PL	PLATE(S)		
CONT	CONTINUOUS	PLYMD	PLYWOOD		
CRTR	CONTRACTOR	R	RULER, RADIAL		
DE	DEWALL TOP	RECEPT	RECEPTICAL		
DRWG	DRAWING	RM	ROOM		
ELEV	ELEVATION	SE	SEED GREE		
ELECT	ELECTRICAL	SH	SHEET		
EQUIP	EQUIPMENT	SPEC	SPECIFICATION		
EXIST'G	EXISTING	T&B	TIE BE BEAM		
EXT	EXTERIOR	TOL	TIE BE LAMINATE		
FIN	FINISH(ES)	TOP	TOP OF PLATE		
FLR	FLOOR	TTS	TOP OF STEEL		
GA	GAGE	TYP	TYPICAL		
GALV	GALVANIZED	WAIN	WAINSET		
GI	GALVANIZED IRON	W/L	WATER FLOET		

LEGAL DESCRIPTION

LOT 1 & 2
 BLOCK 22
 SUBDIVISION H F 10 & 10 ADDITION
 PAGE BOOK OF PLATS CLARK COUNTY, NEVADA

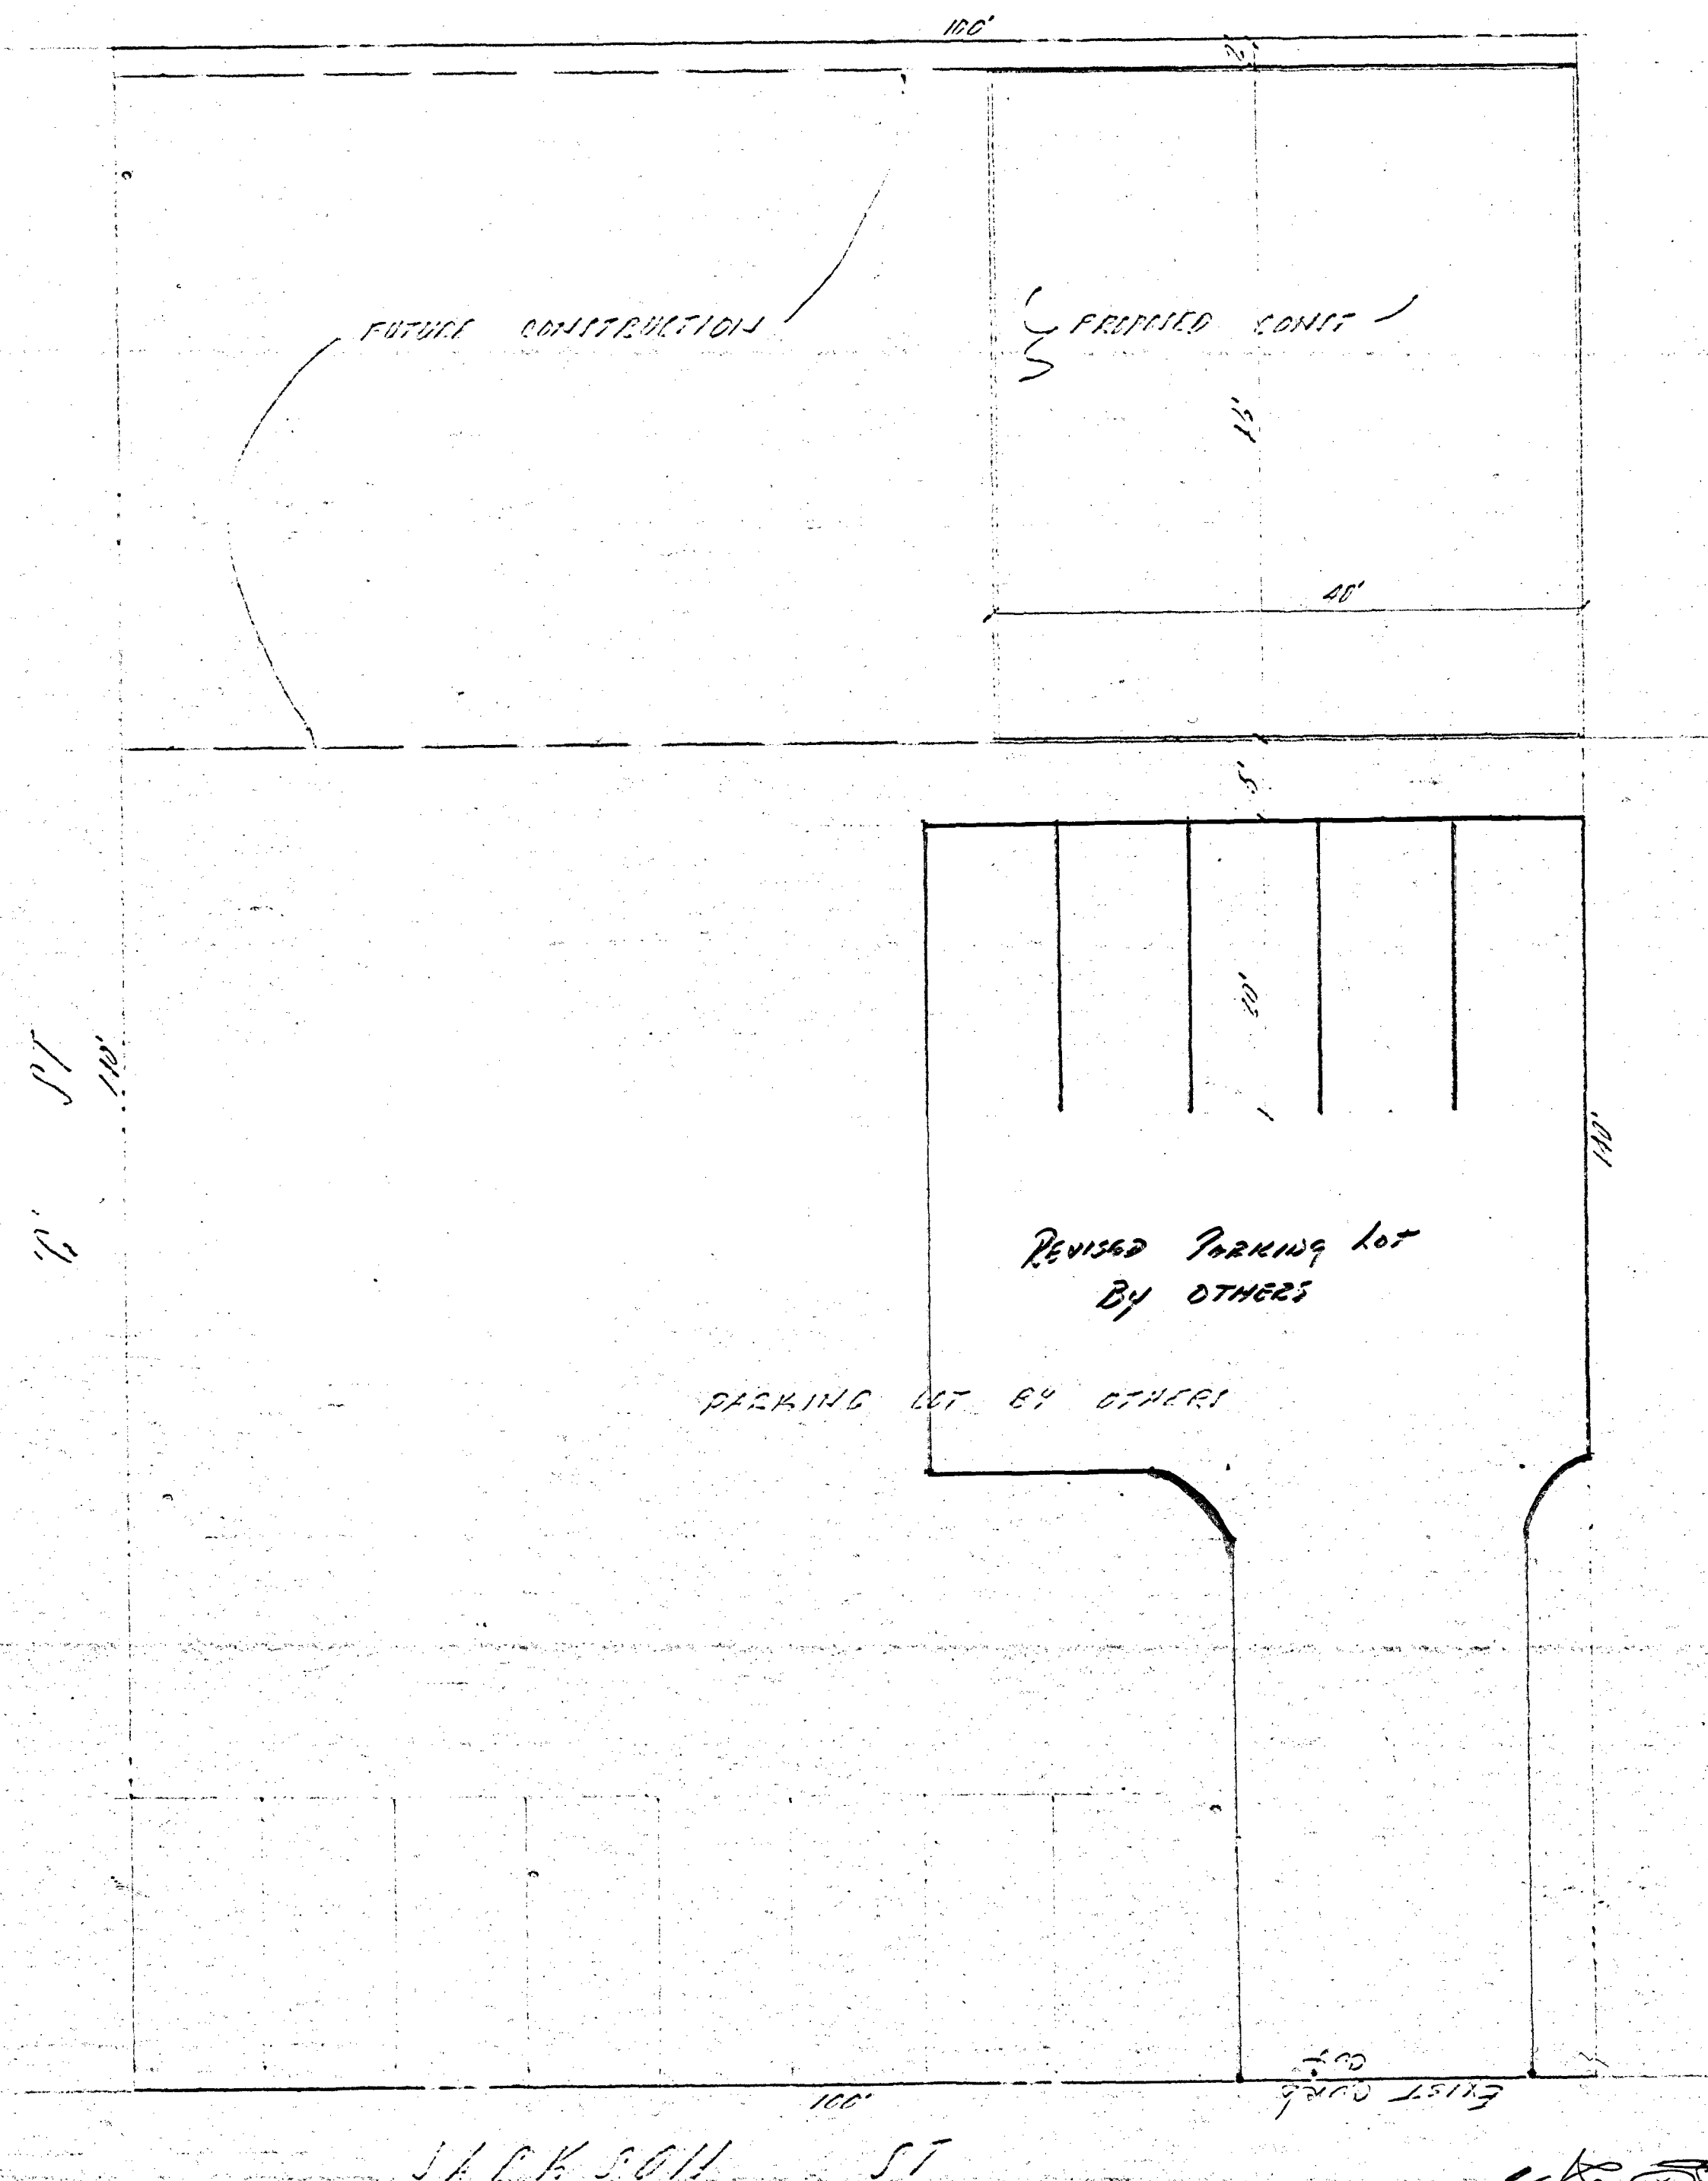

PLOT PLAN

SCALE: 1" = 70'

Rep: Low Power 1.4 Don Wainwright

Commercial Building
 for MR DAVE SIMONS

General Contractor
 [Security]
 HOUSING CORPORATION
 3612 South Highland Las Vegas, Nevada Phone 870-3114

Drawn
 1/11/76
 1

GENERAL INFORMATION

1. NAME OF PROJECT

2. ADDRESS

3. CITY AND STATE

4. COUNTY

5. ZONING

6. LOT AREA

7. TOTAL AREA

8. PERCENTAGE COVERED

9. NUMBER OF UNITS

10. TYPE OF CONSTRUCTION

11. DATE OF COMPLETION

12. NAME OF ARCHITECT

13. NAME OF ENGINEER

14. NAME OF CONTRACTOR

15. NAME OF OWNER

16. NAME OF LENDER

17. NAME OF INSURER

18. NAME OF ATTORNEY













































































































































































































































































COMMON ABBREVIATIONS


AB	ANCHOR BOLT	GLD LAM	GLUE LAMINATED	W/ MIT	WITH MIT

LEGAL DESCRIPTION

LOT 1 & 2
BLOCK 22
SUBDIVISION H F 10 & 10 ADDITION
PAGE BOOK OF PLATS CLARK COUNTY, NEVADA

Z-53-66

53

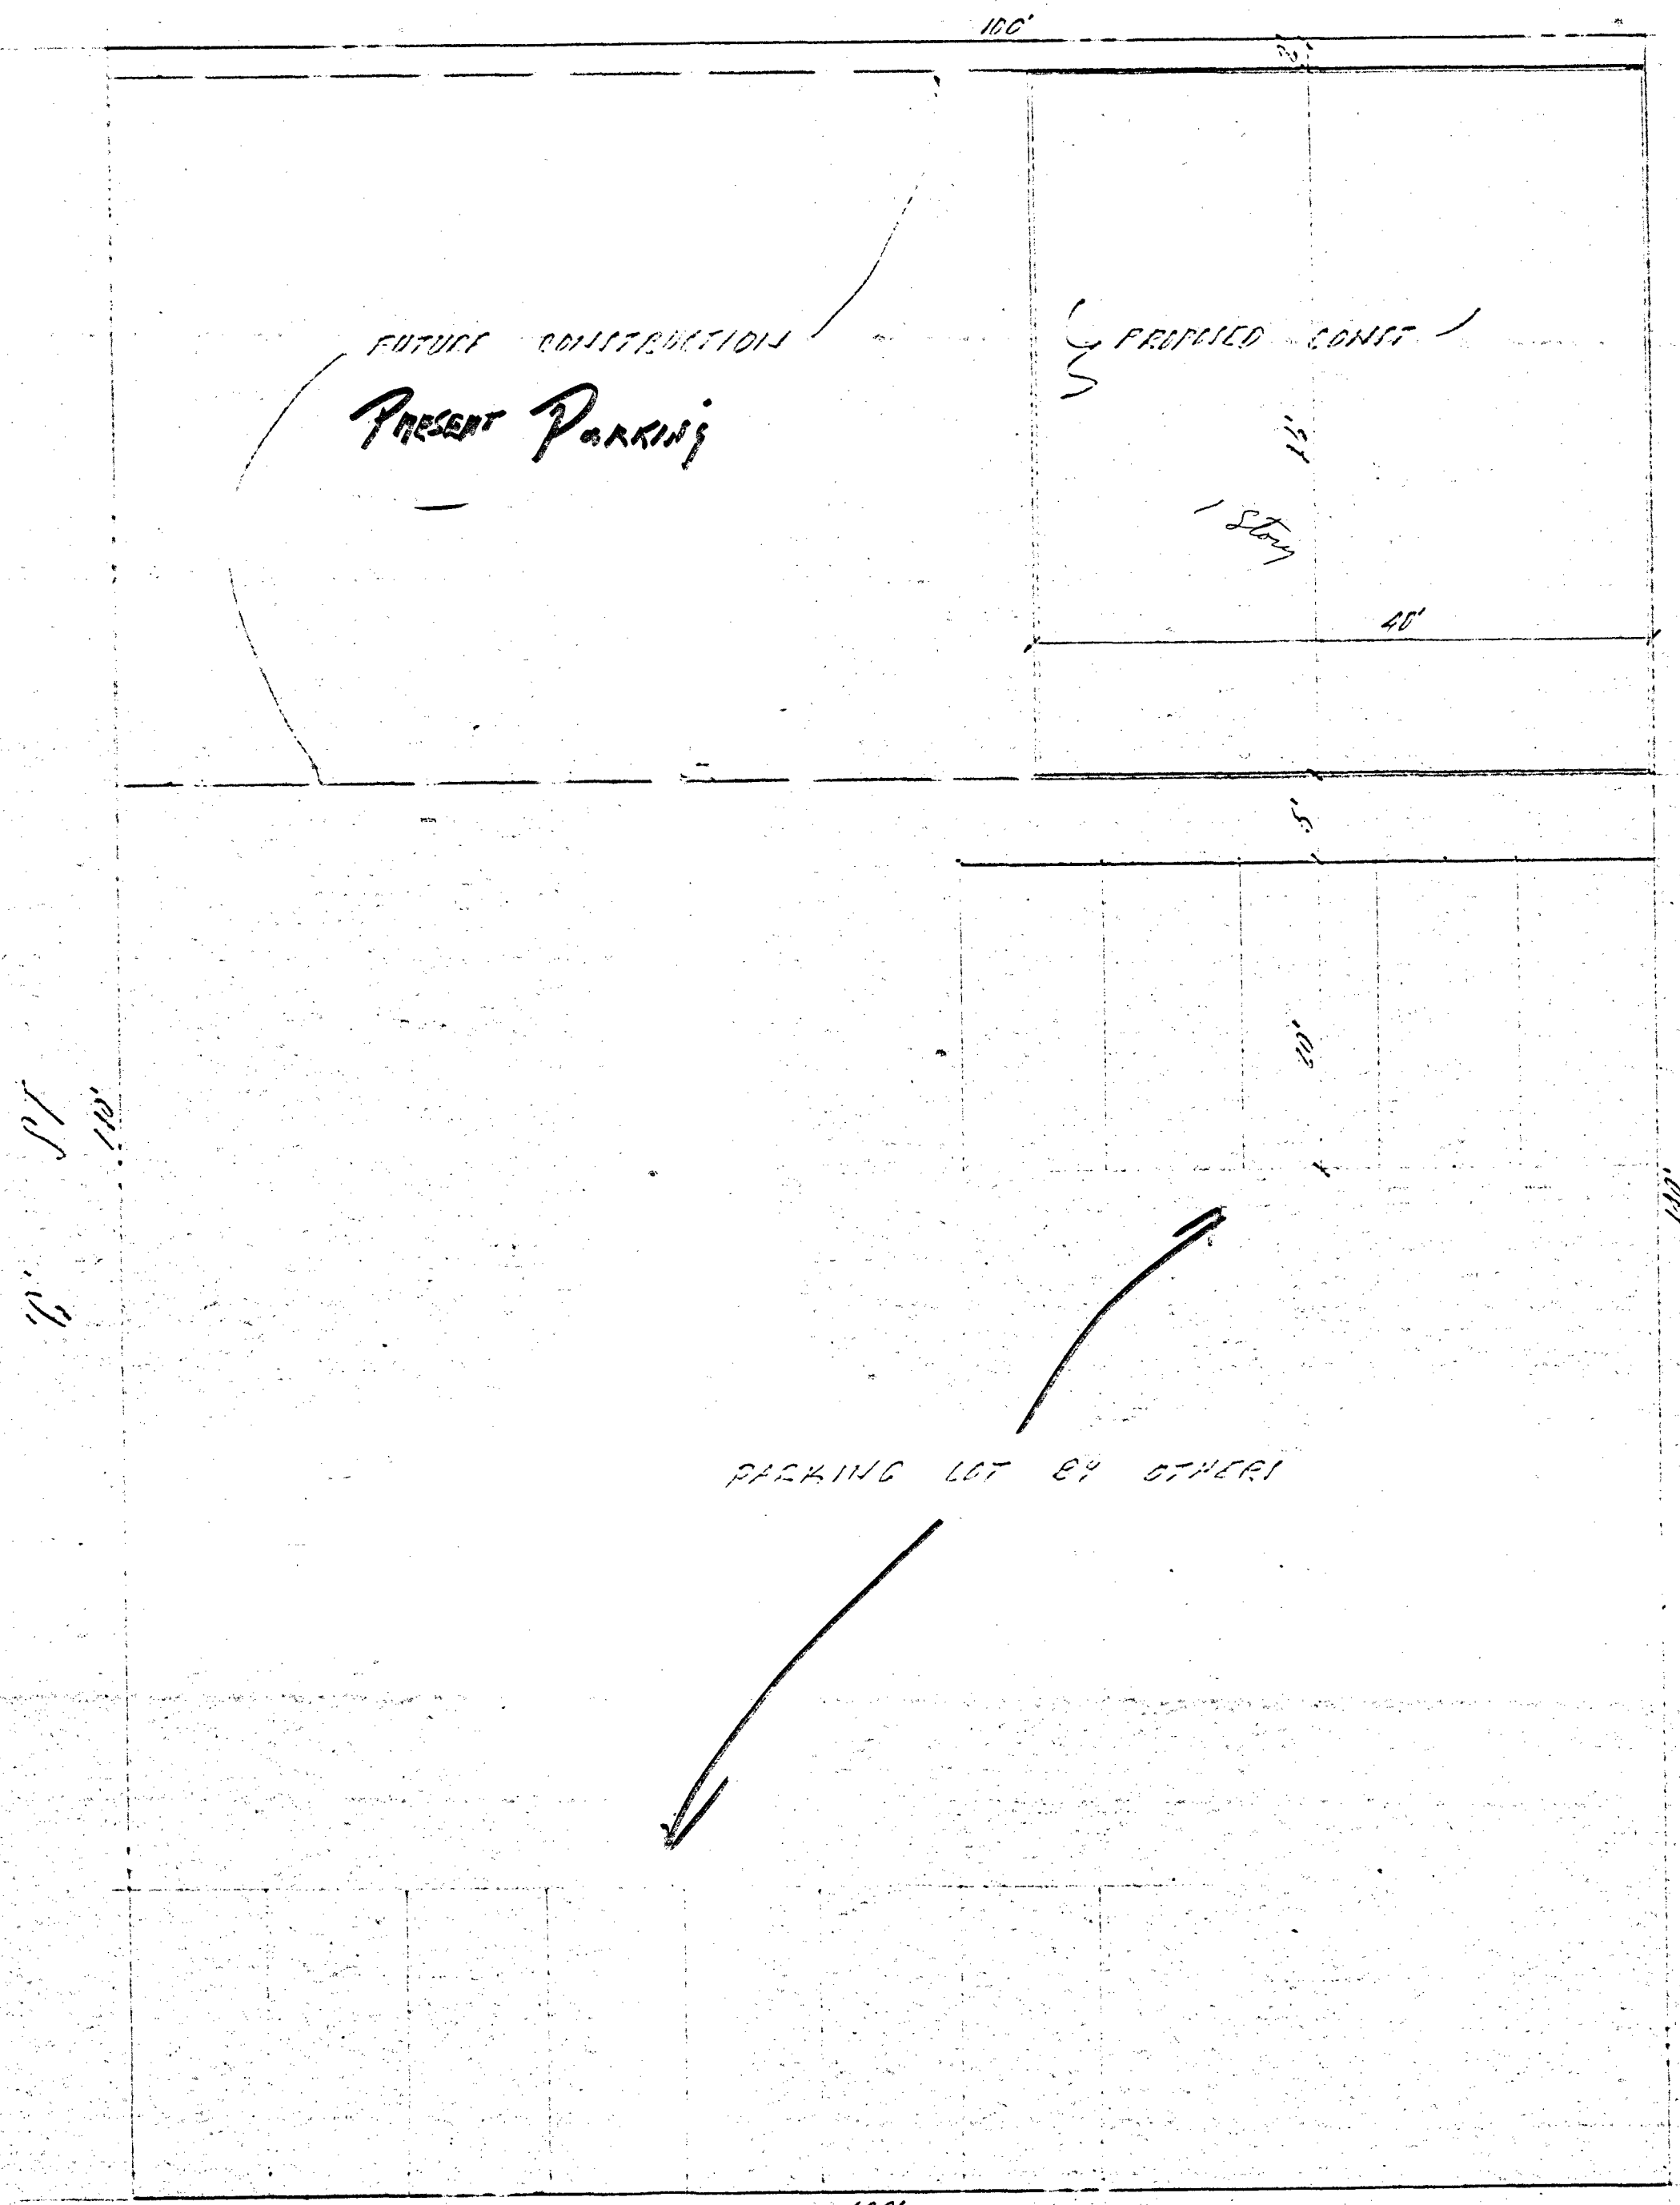

PLOT PLAN

SCALE: 1" = 10'

Prepared by Dave Simons

Commercial Building
for MR DAVE SIMONS

General Contractor
Security HOUSING CORPORATION
2672 South Highland Las Vegas, Nevada Phone 870-1414

PLAN BY
1