


COMMON ABBREVIATIONS

AB	ANCHOR BOLT	GLU-LAM	GLUE LAMINATED	W/ MIT	WITH MIT

LEGAL DESCRIPTION

LOT 1 & 2
BLOCK 22
SUBDIVISION H F 10 & 10 ADDITION
PAGE BOOK OF PLATS CLARK COUNTY, NEVADA

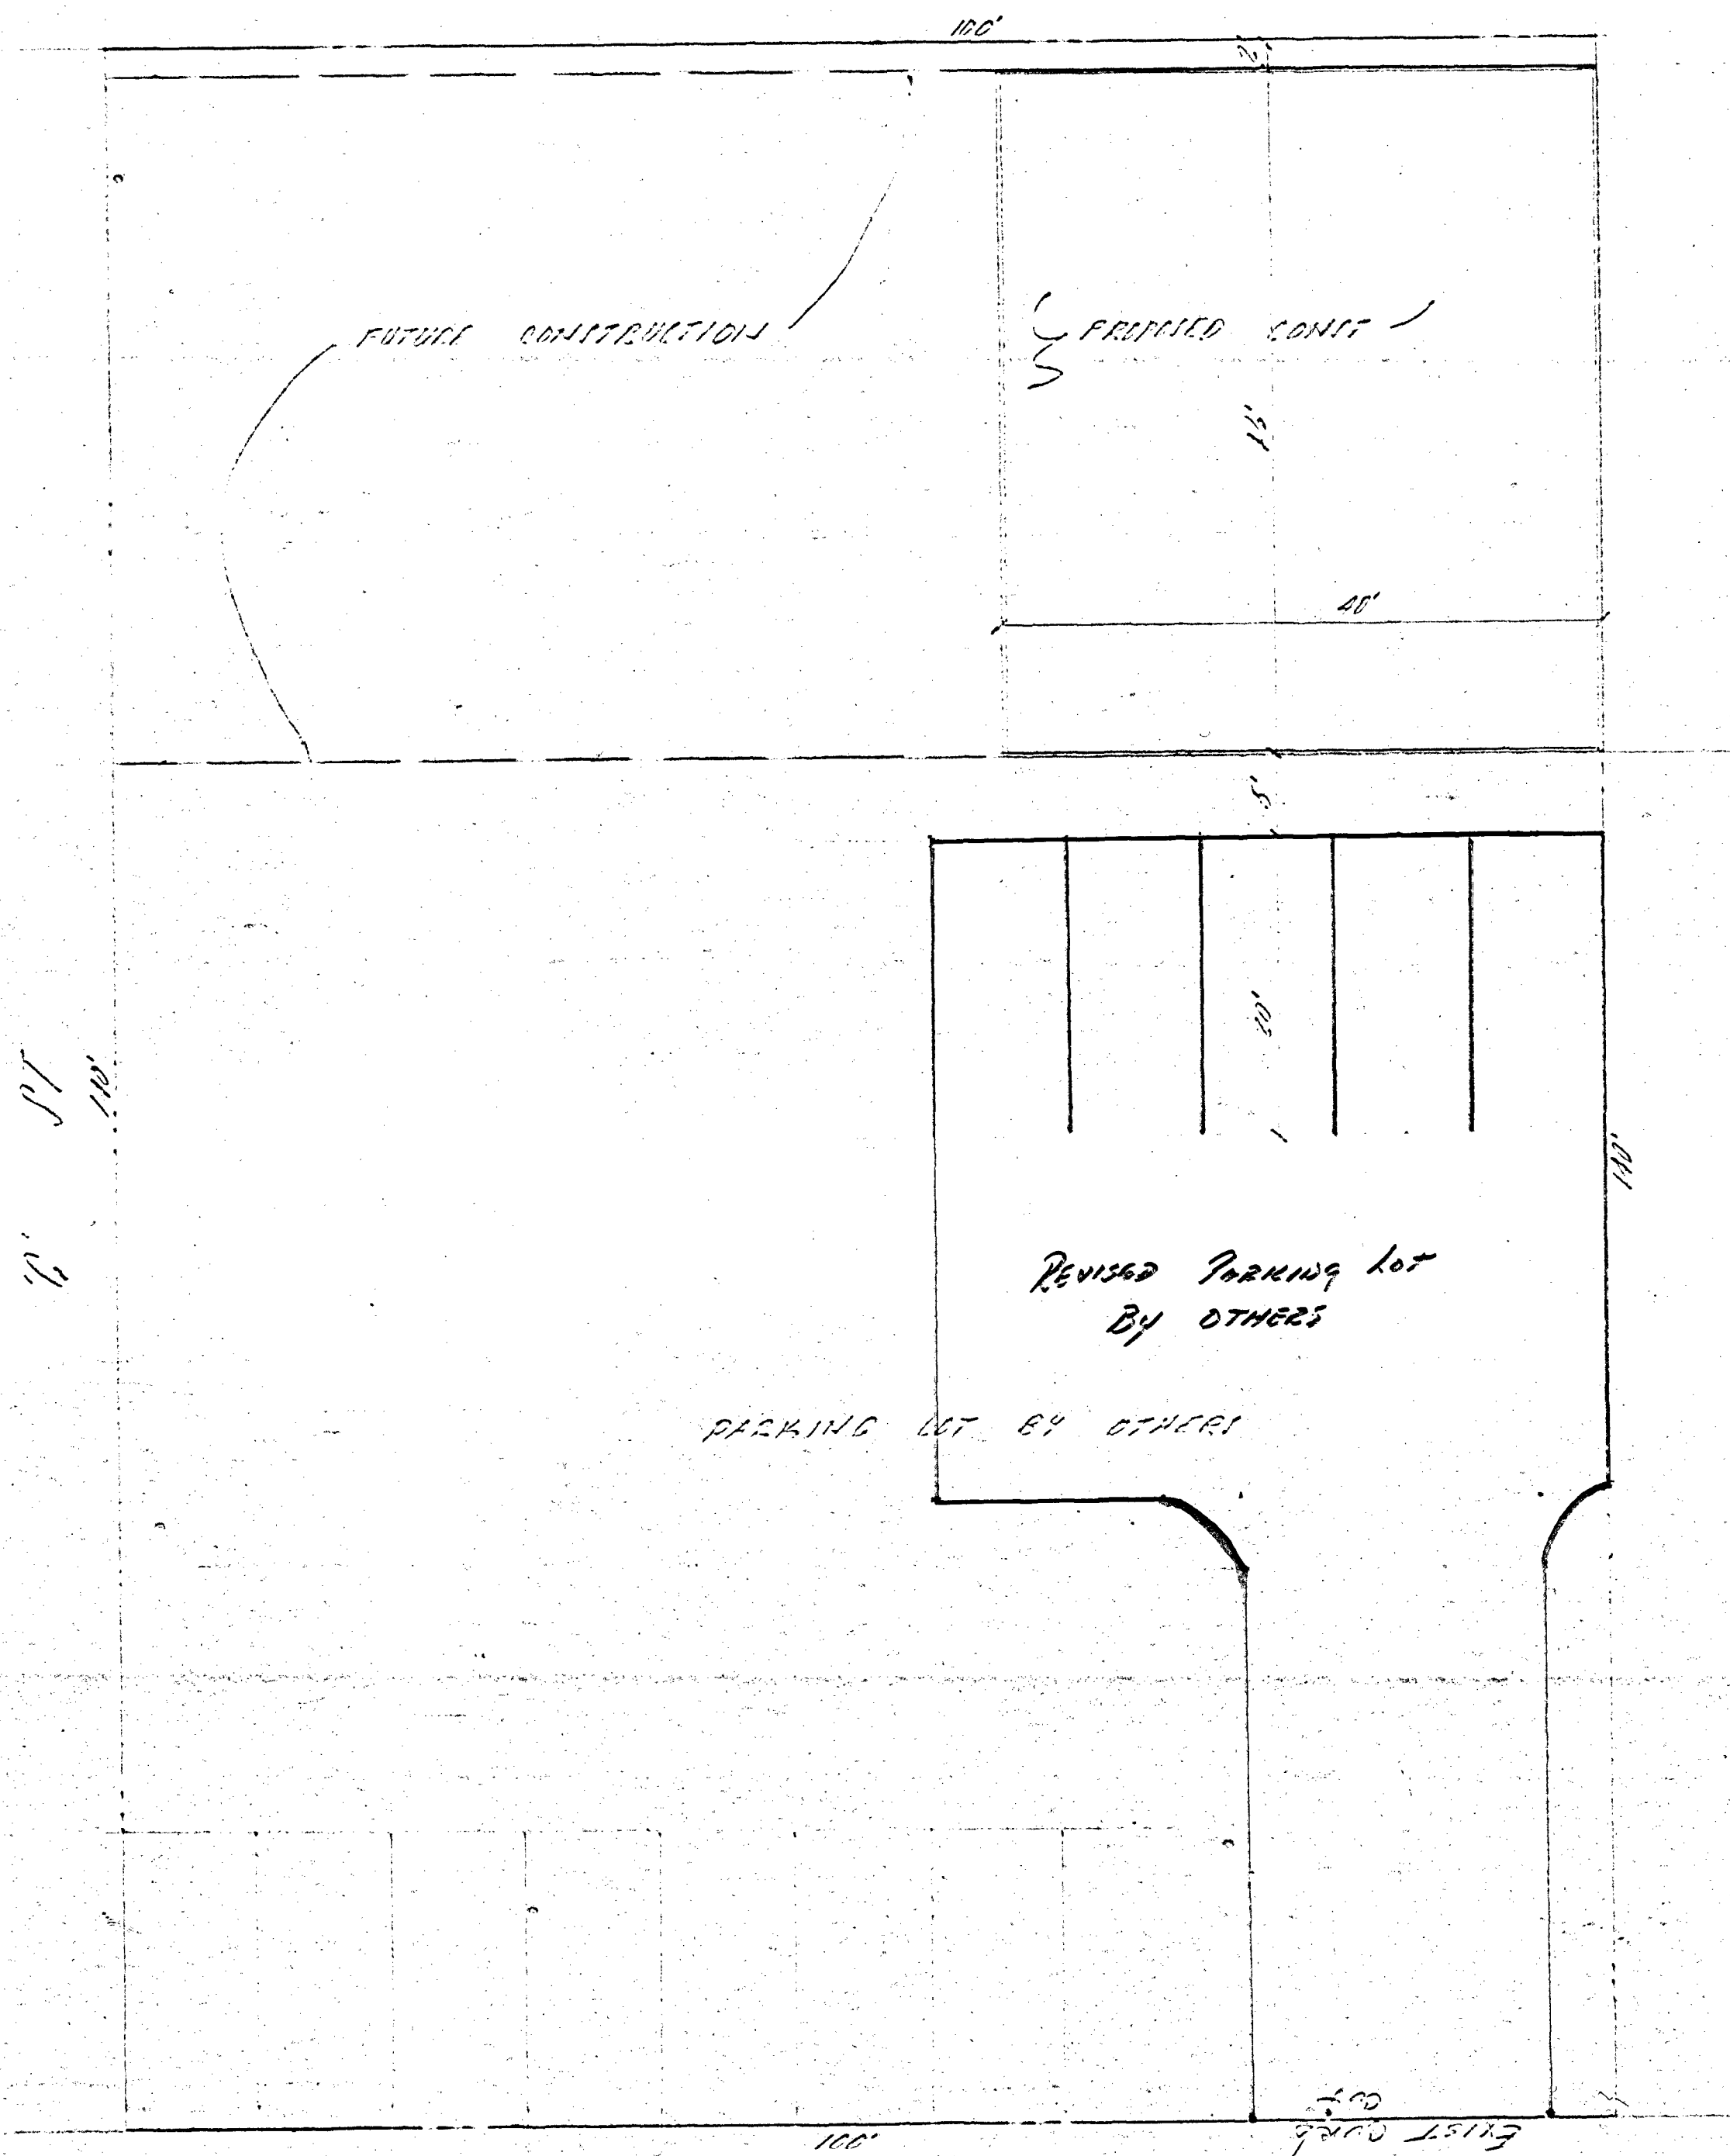

PLOT PLAN

SCALE: 1" = 70'

1/12/67 P.C. MTE
For Review on
1/12/67 P.C. MTE
For Review on

Commercial Building
for MR DAVE SIMONS

General Contractor
Security
HOUSING CORPORATION
3612 South Highland Las Vegas, Nevada Phone 870-3114

Drawn
1/12/67


































LEGAL DESCRIPTION

LOT 1 & 2
BLOCK 22
SECTION 4 F 10 & 10 ADDITION
PLAT OF PLATS CLARK COUNTY, NEVADA



53


General Contractor

Security


HOUSING CORPORATION

PLANS BY

for MR DAVE SIMONS

Commercial Building

2672 South Highland Las Vegas, Nevada Phone 870-1414

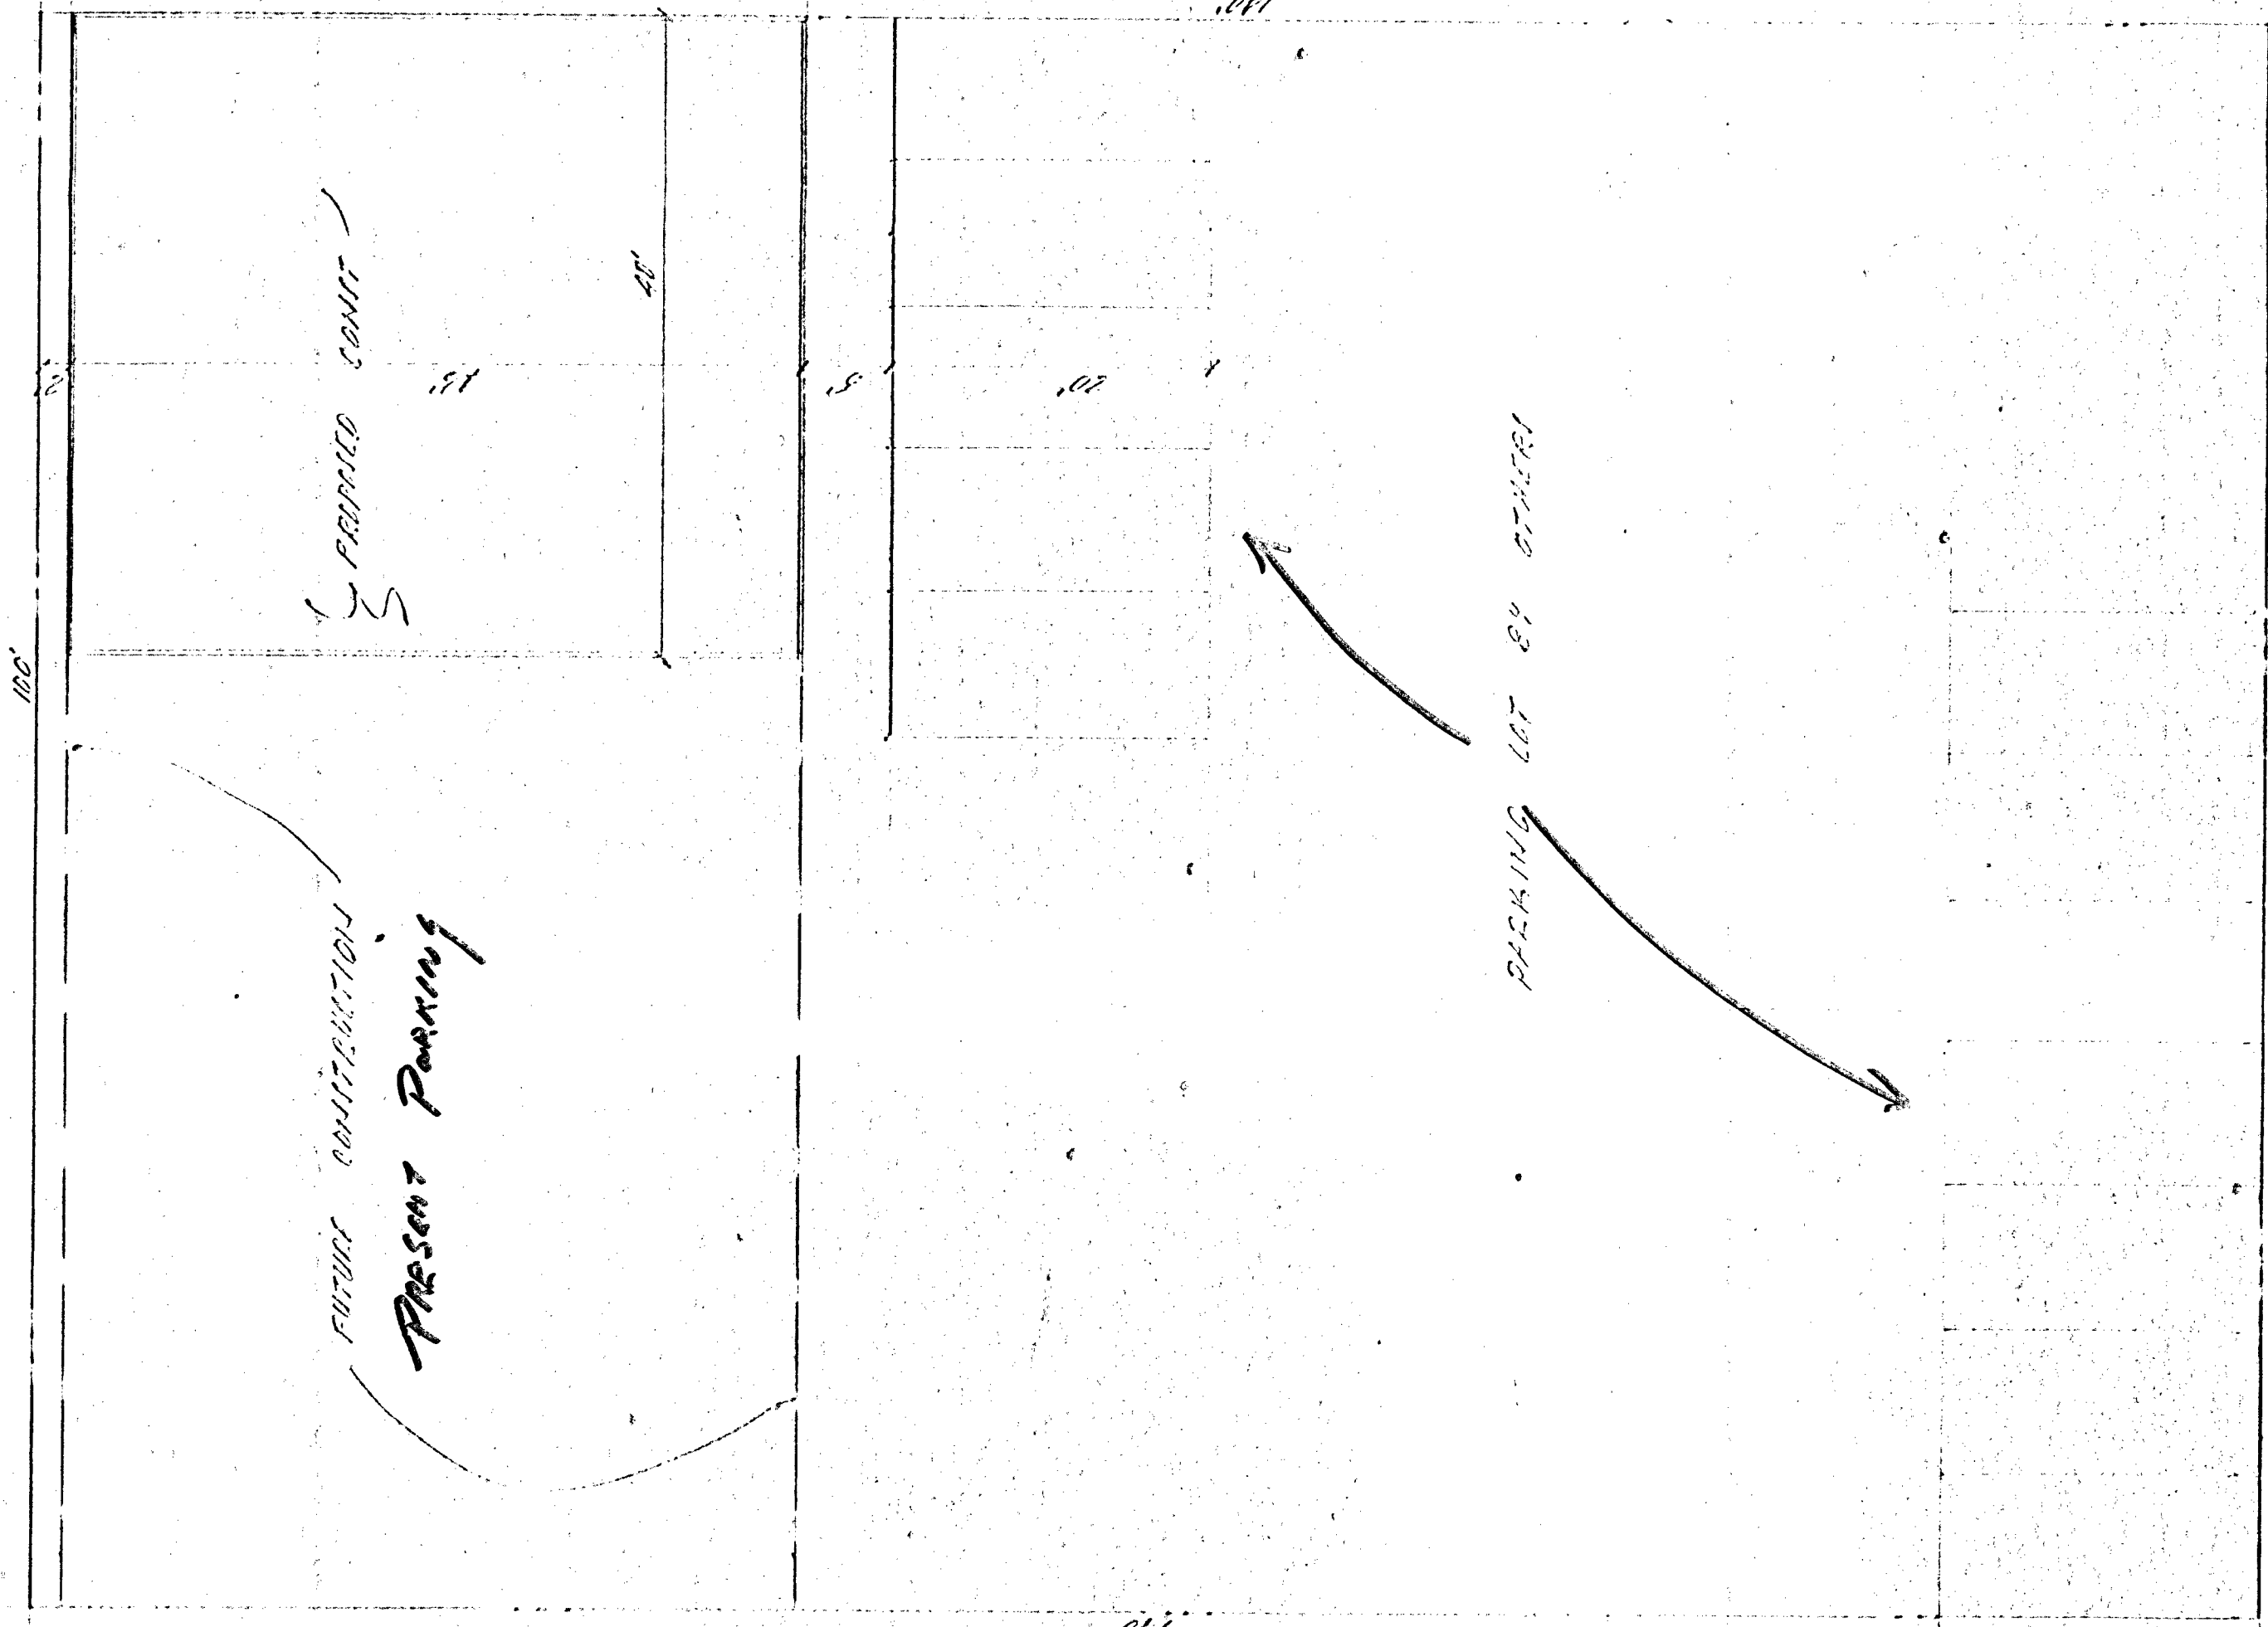

150' 100'

JACKSON ST

PLOT PLAN

SCALE 1/4" = 10'

By: Dan Davis 1-2-80

COMMON ABBREVIATIONS


AB	ANCHOR BOLT	GLD LAM	GLUE LAMINATED	W/ MIT	WITH
AL	ALUMINUM (ING)	GR	GRADE	W/ MIT	WITH MIT
ADJ	ADJUSTABLE	HE	HOLLOW CORE	W/ MIT	WITH MIT
ALT	ALTERNATE	HT	HEIGHT	Y BRG	Y BRG BRACING
AP	ACCESS PANEL	HTG	HEATING		
BD	BOARD	INSUL	INSULATION		
BDOB	BUILDING	LAV	LAVATORY		
BM	BEAM	MED	MEDICINE CABINET		
BMT	BATHMENT	MCH	MECHANICAL		
BU	BUILT UP	NIC	NOT IN CONTACT		
CEP	CERAMIC	N°	NUMBER		
CS	CERT. 100% H	OC	ON CENTER		
CLE	CEILING	OPR	OPENING		
CONC	CONCRETE	ORA	OUTSIDE AIR		
COMP	COMPOSITION	PART	PARTITION		
CONC	CONCRETE	PG	PAINT GRADE		
CONC BCK	CONCRETE BLOCK	PL	PLASTER		

LEGAL DESCRIPTION

LOT 1 & 2
BLOCK 22
SUBDIVISION H F 10 & 10 ADDITION
PAGE BOOK OF PLATS CLARK COUNTY, NEVADA

Z-53-66

53

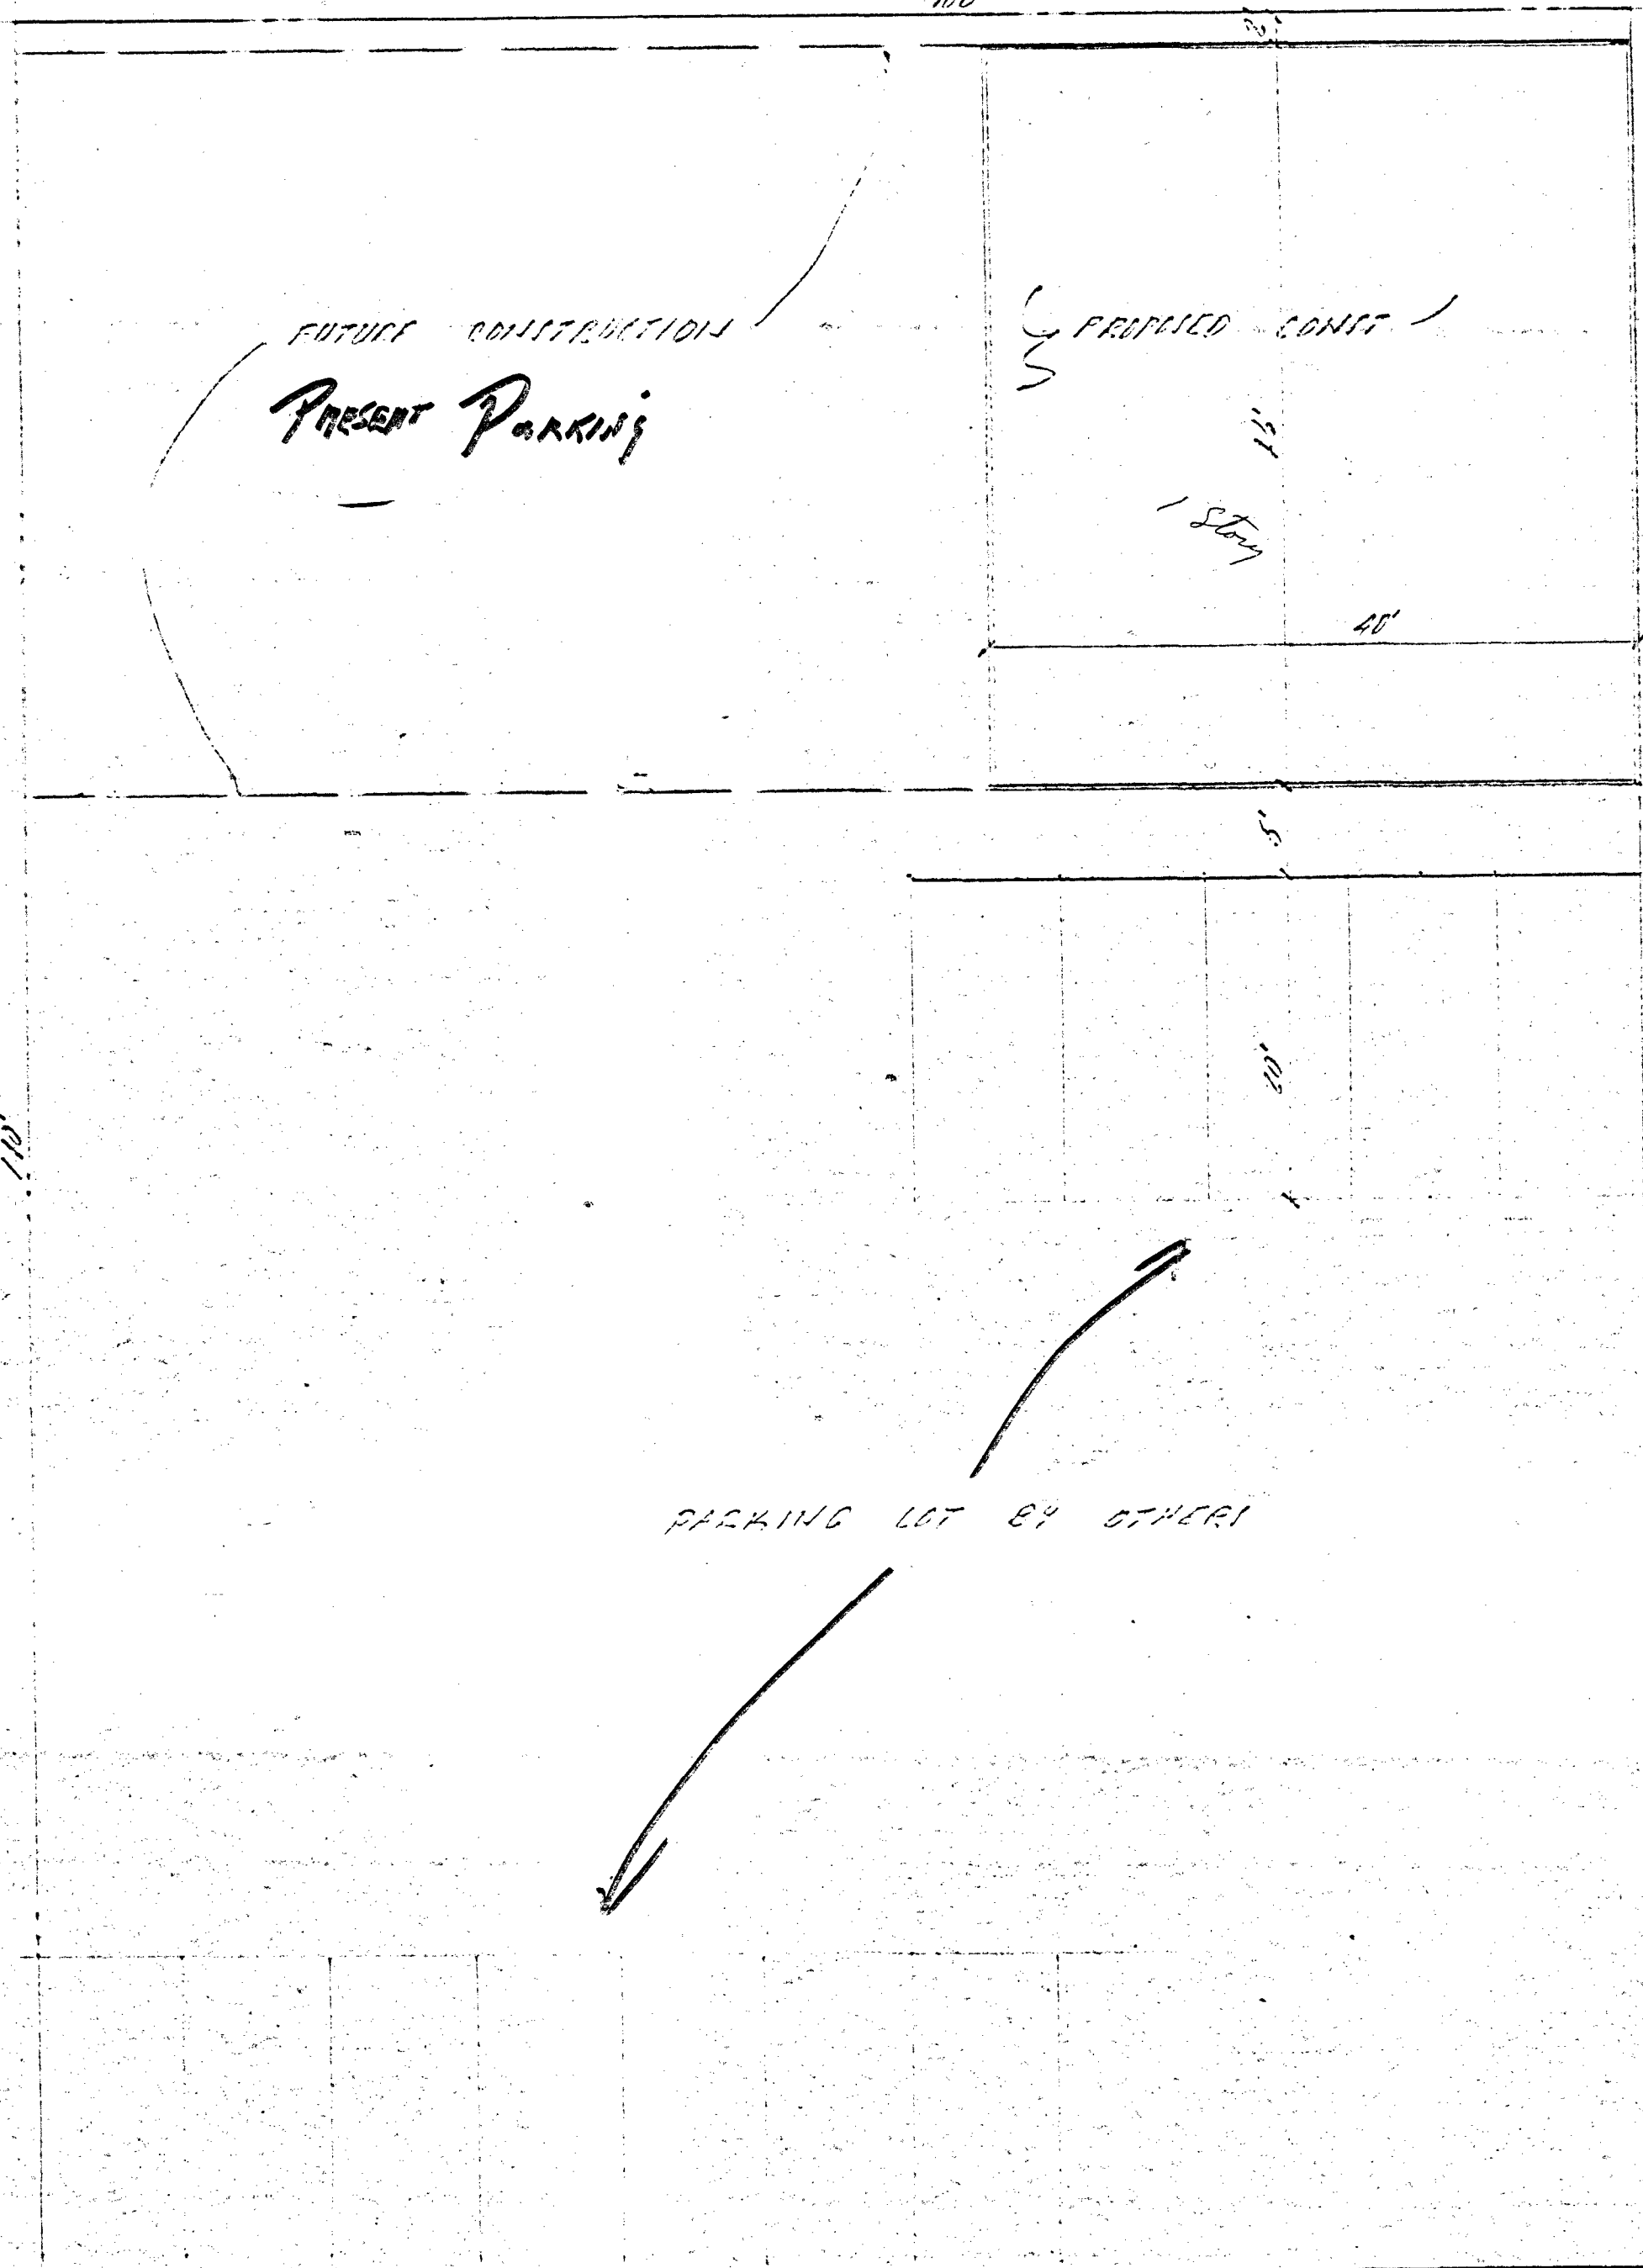

PLOT PLAN

SCALE: 1" = 10'

Prepared by Dave Simons

**Commercial Building
for MR DAVE SIMONS**

General Contractor
Security
HOUSING CORPORATION
2672 South Highland Las Vegas, Nevada Phone 870-1414

PLAN BY
PAGE 1