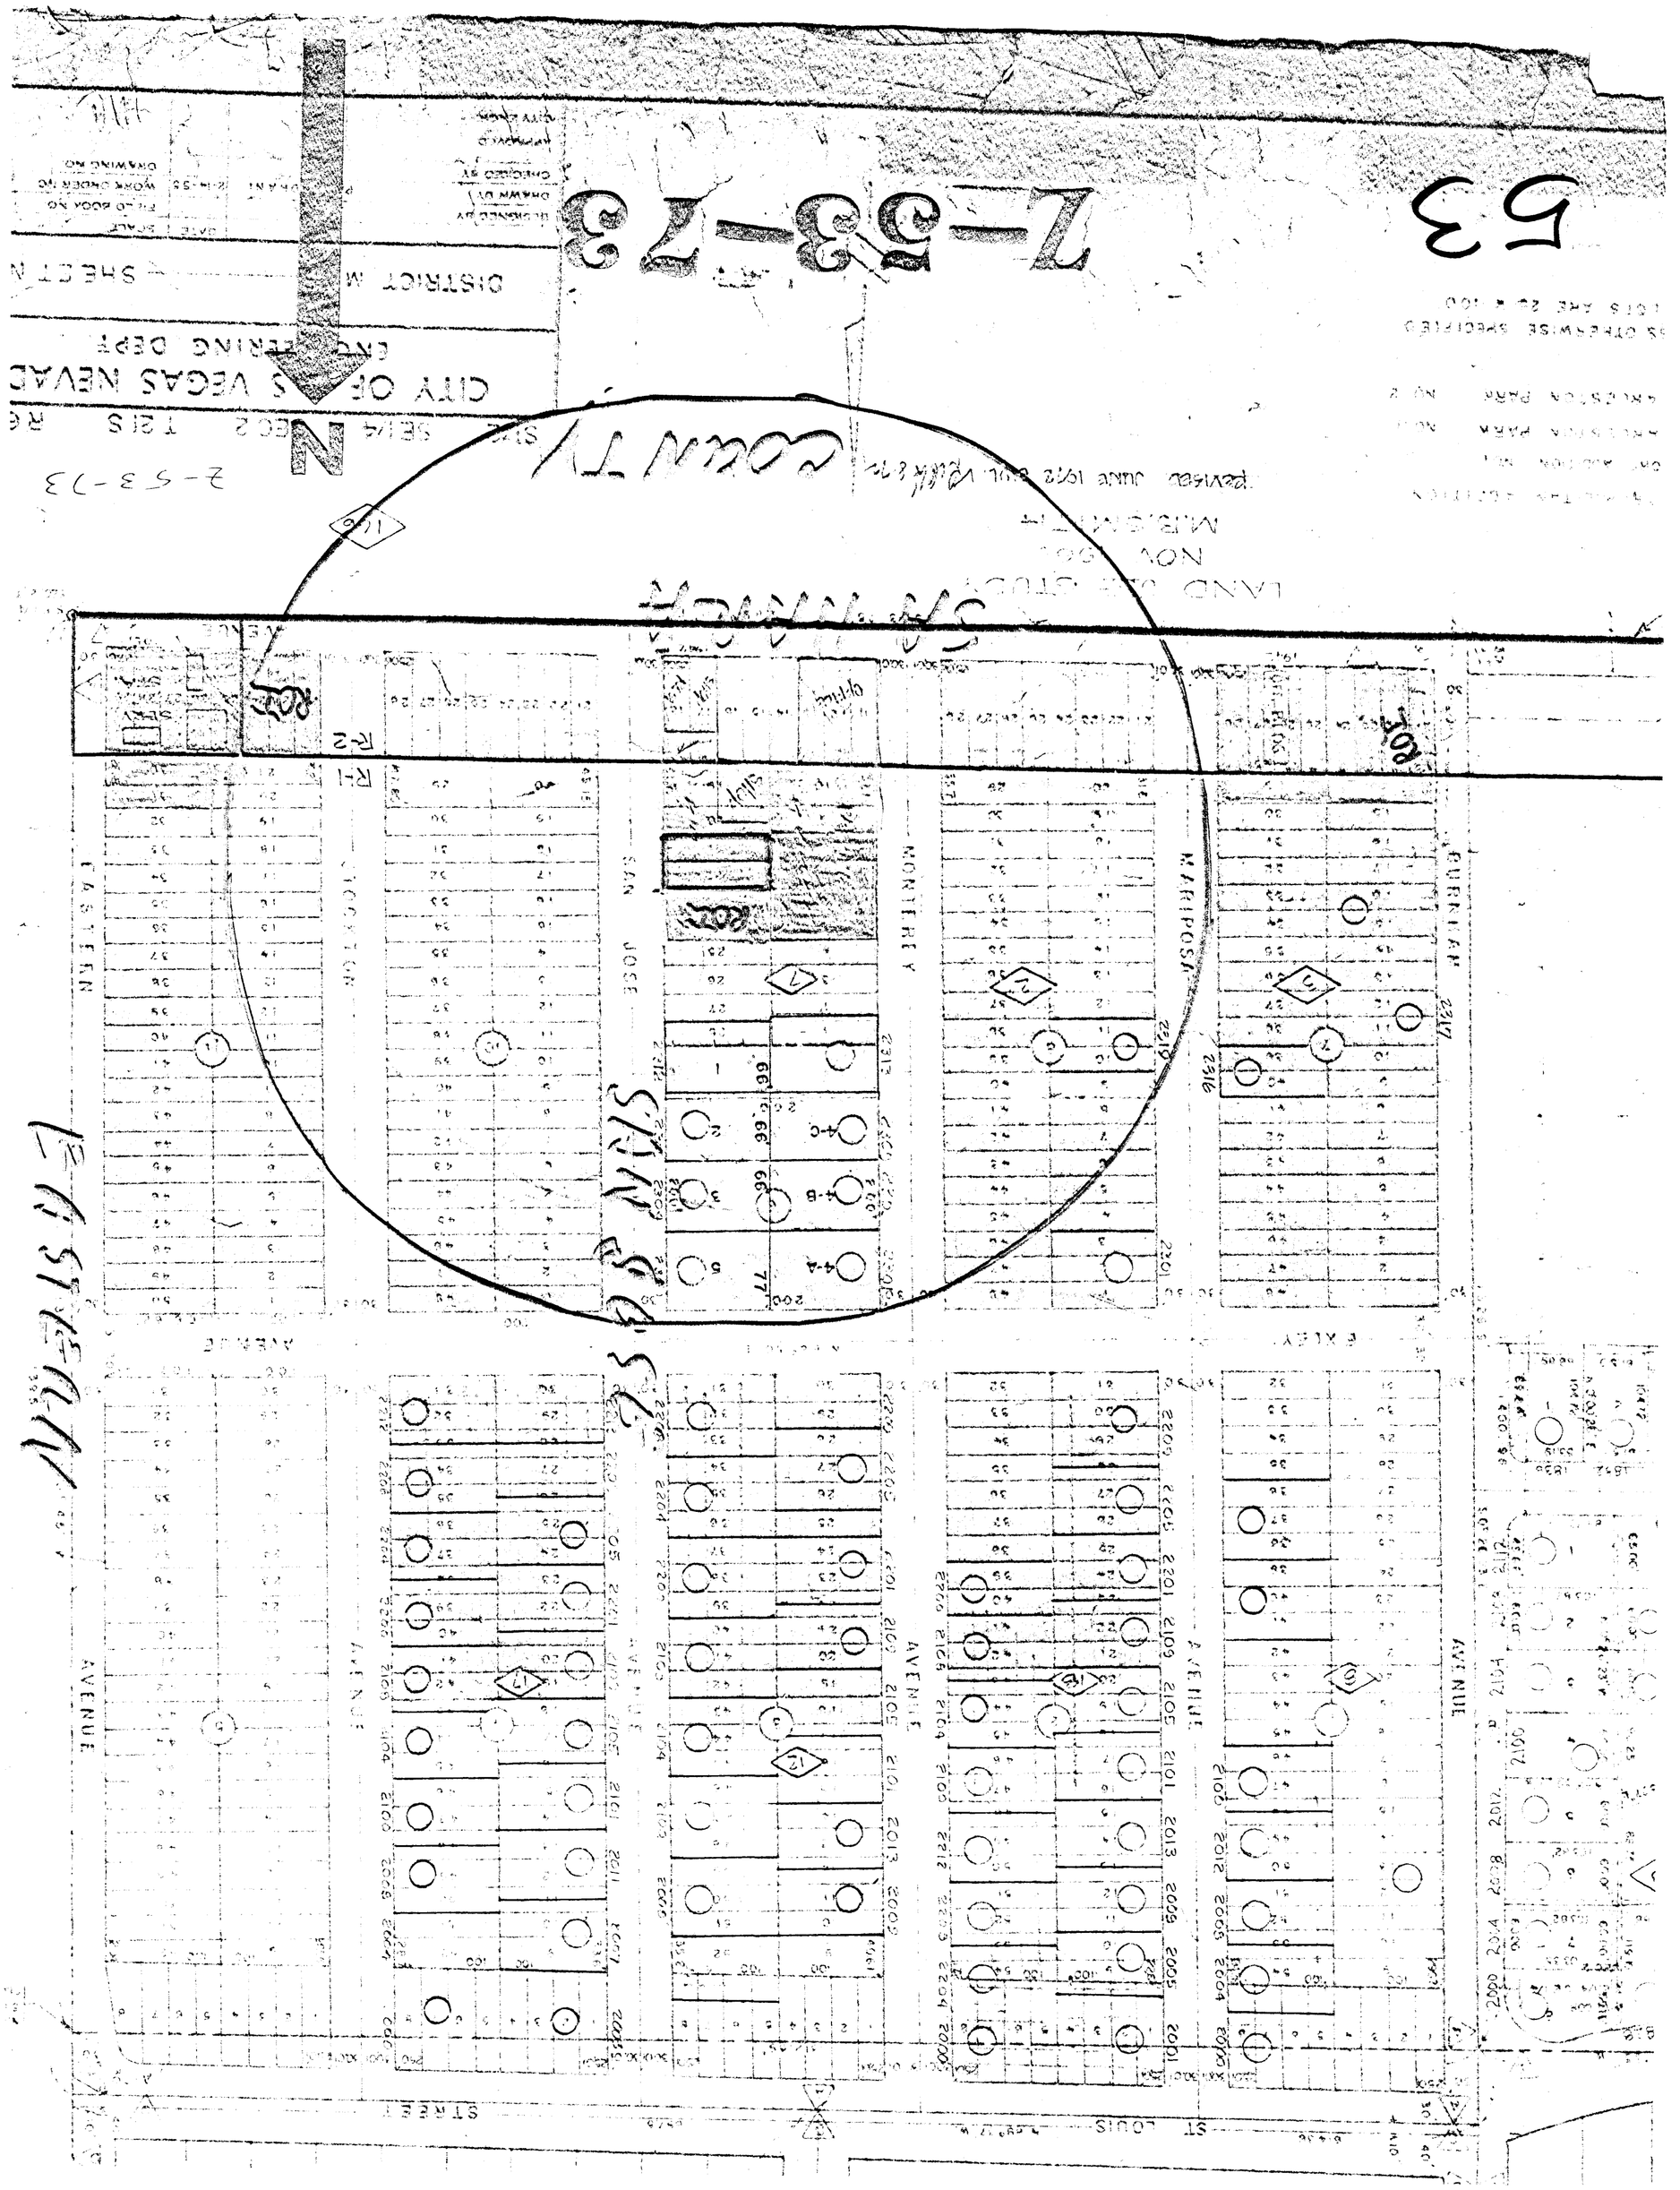
Z-53-73
53
CITY OF LAS VEGAS NEVADA
ENGINEERING DEPT
DISTRICT MAP
SHEET N
COUNTY
N
SEC 2 T 21 S R
SE 1/4 SE 1/4
LAND USE STUDY
NOV 1961
MAPPED JUNE 1972
R-1
R-2
MONTEREY
MARIPOSA
AVENUE
STREET
ST LOUIS
AVE MILL
EXLEY
2316
2312
2301
2101
2105
2109
2113
2201
2205
2209
2213
2001
2005
2009
2013