

7 - ELEVEN BUILDING MR. JESSE UNGAR

FOR


BRANDIS AND BORNS
ARCHITECTS

AIA

829 SOUTH 6th STREET

LAS VEGAS NEVADA

334 - 3135

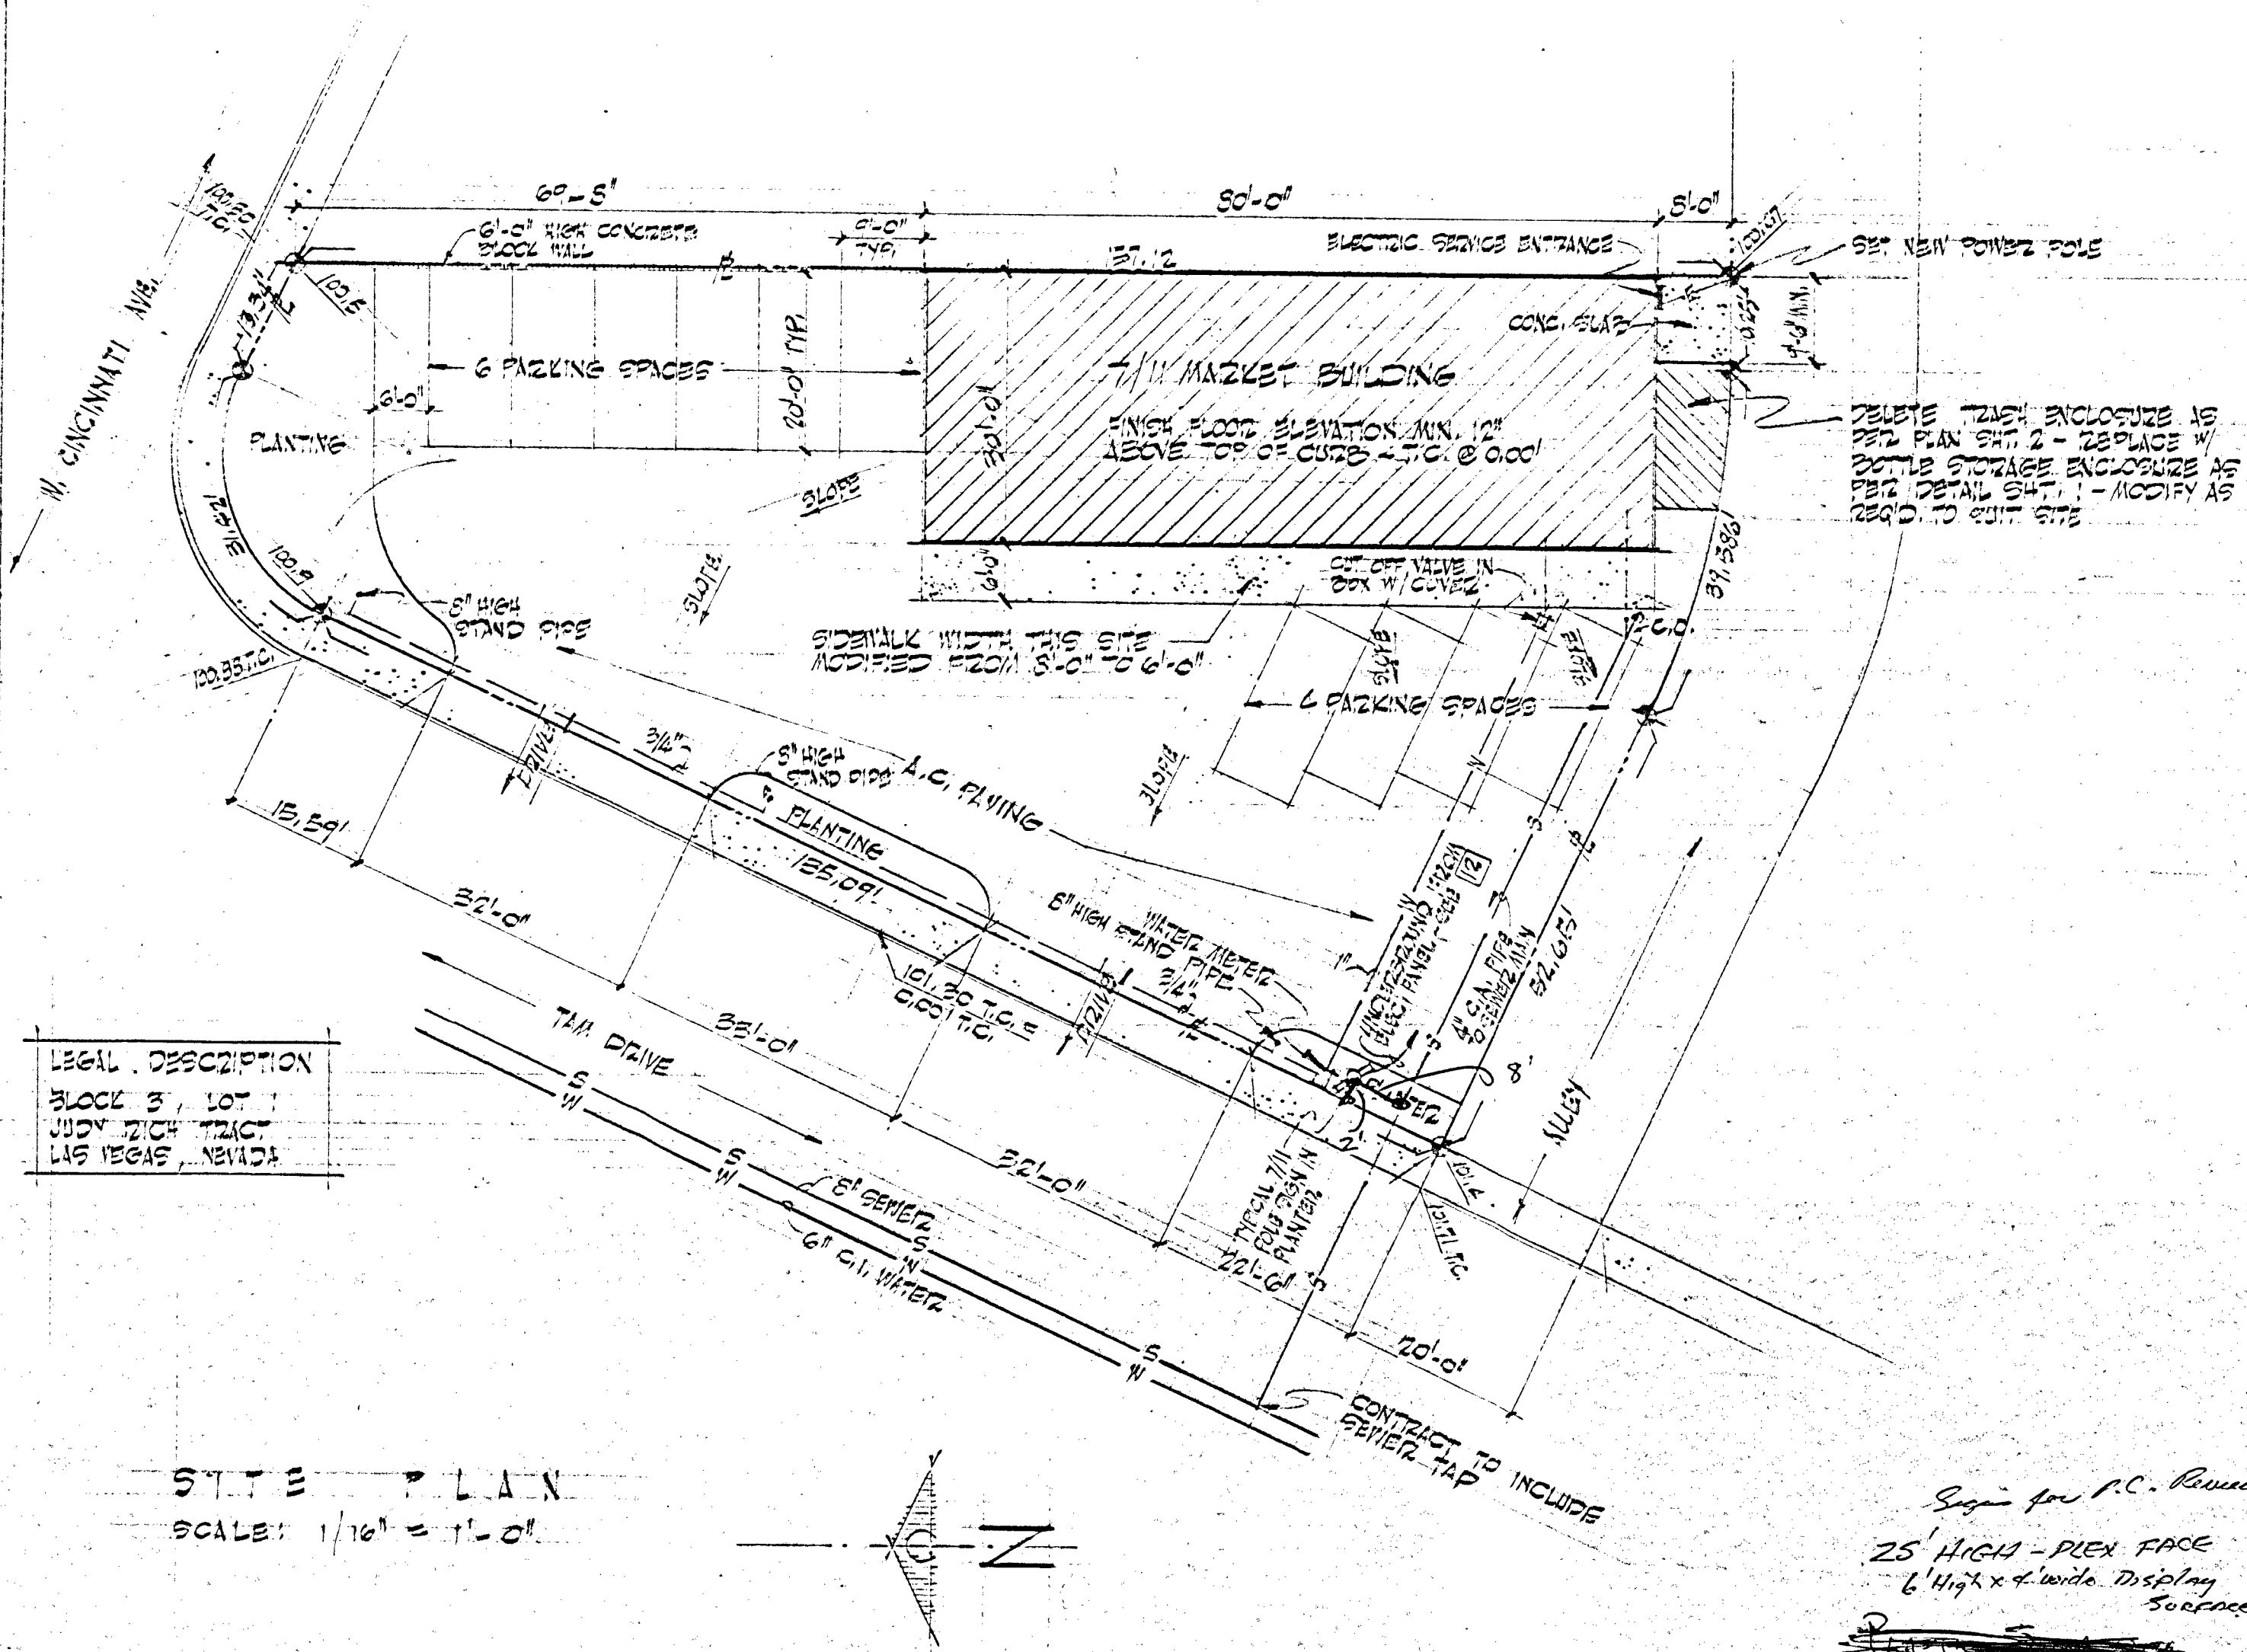

54


2-5466

FOR

A I A

LAS VEGAS NEVADA

384 - 3185

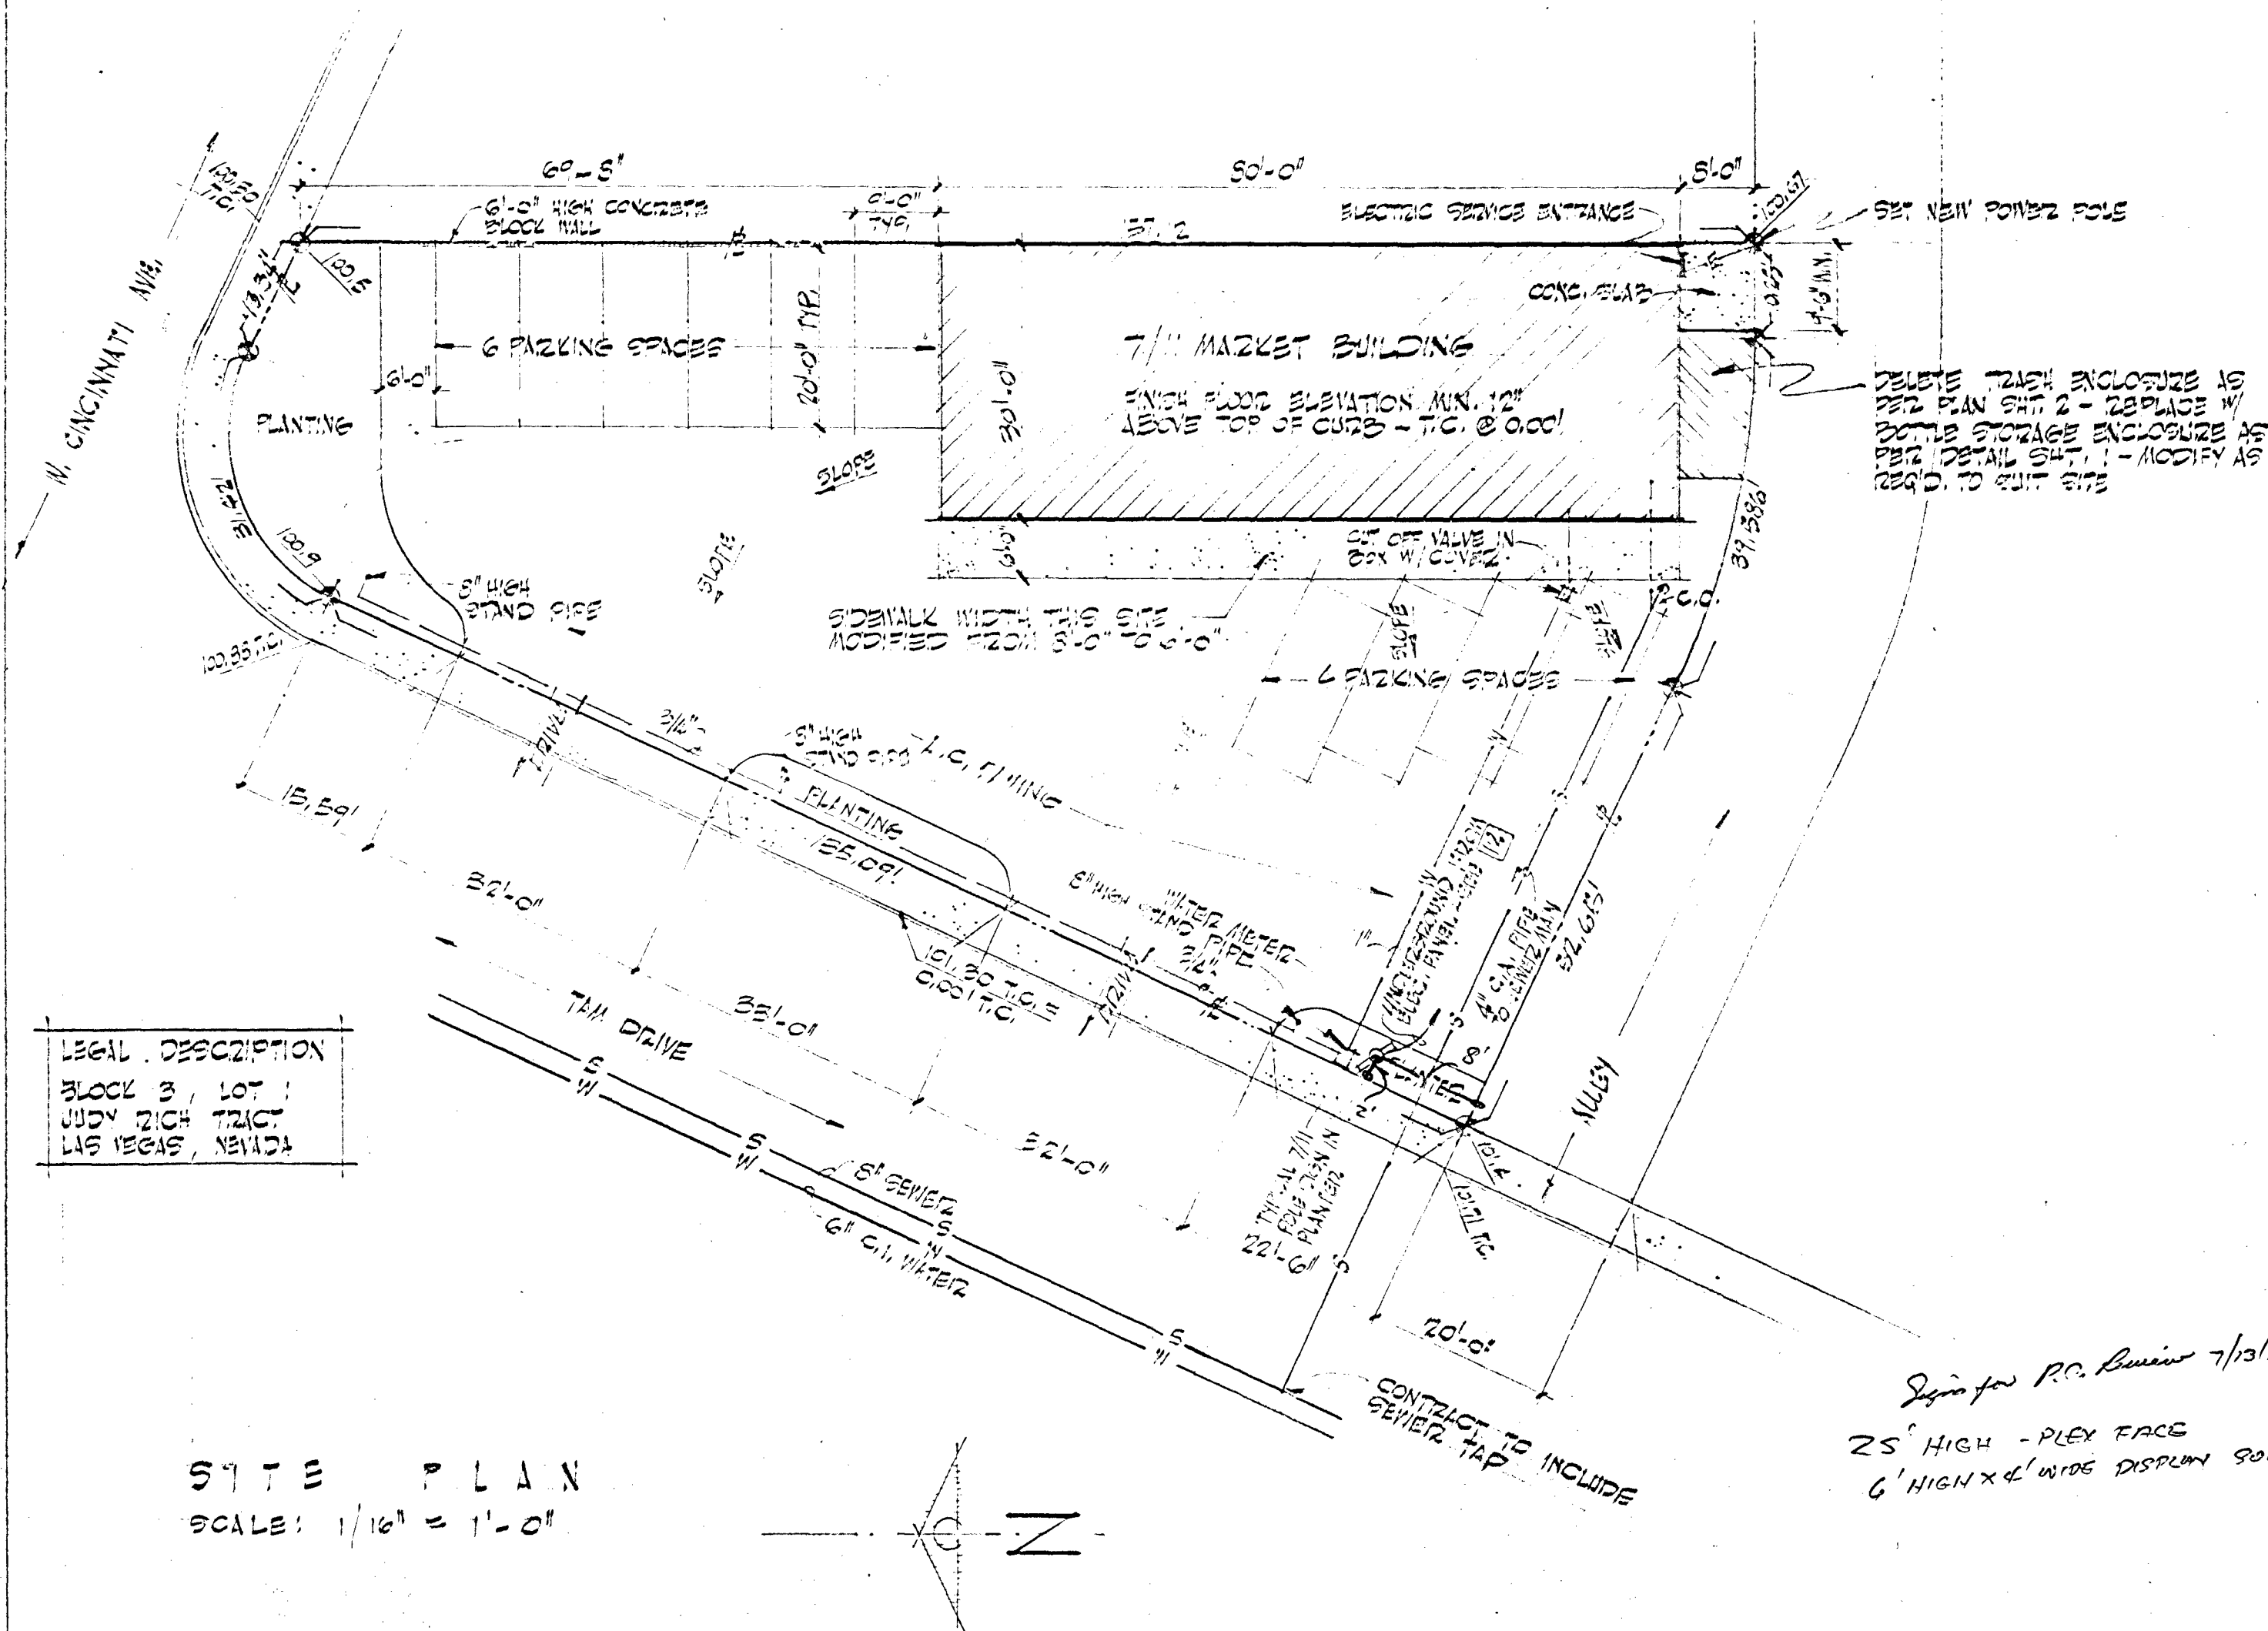

25' HIGH - PLAY FACE
6' HIGH X 4' WIDE DISPLAY SURFACE