
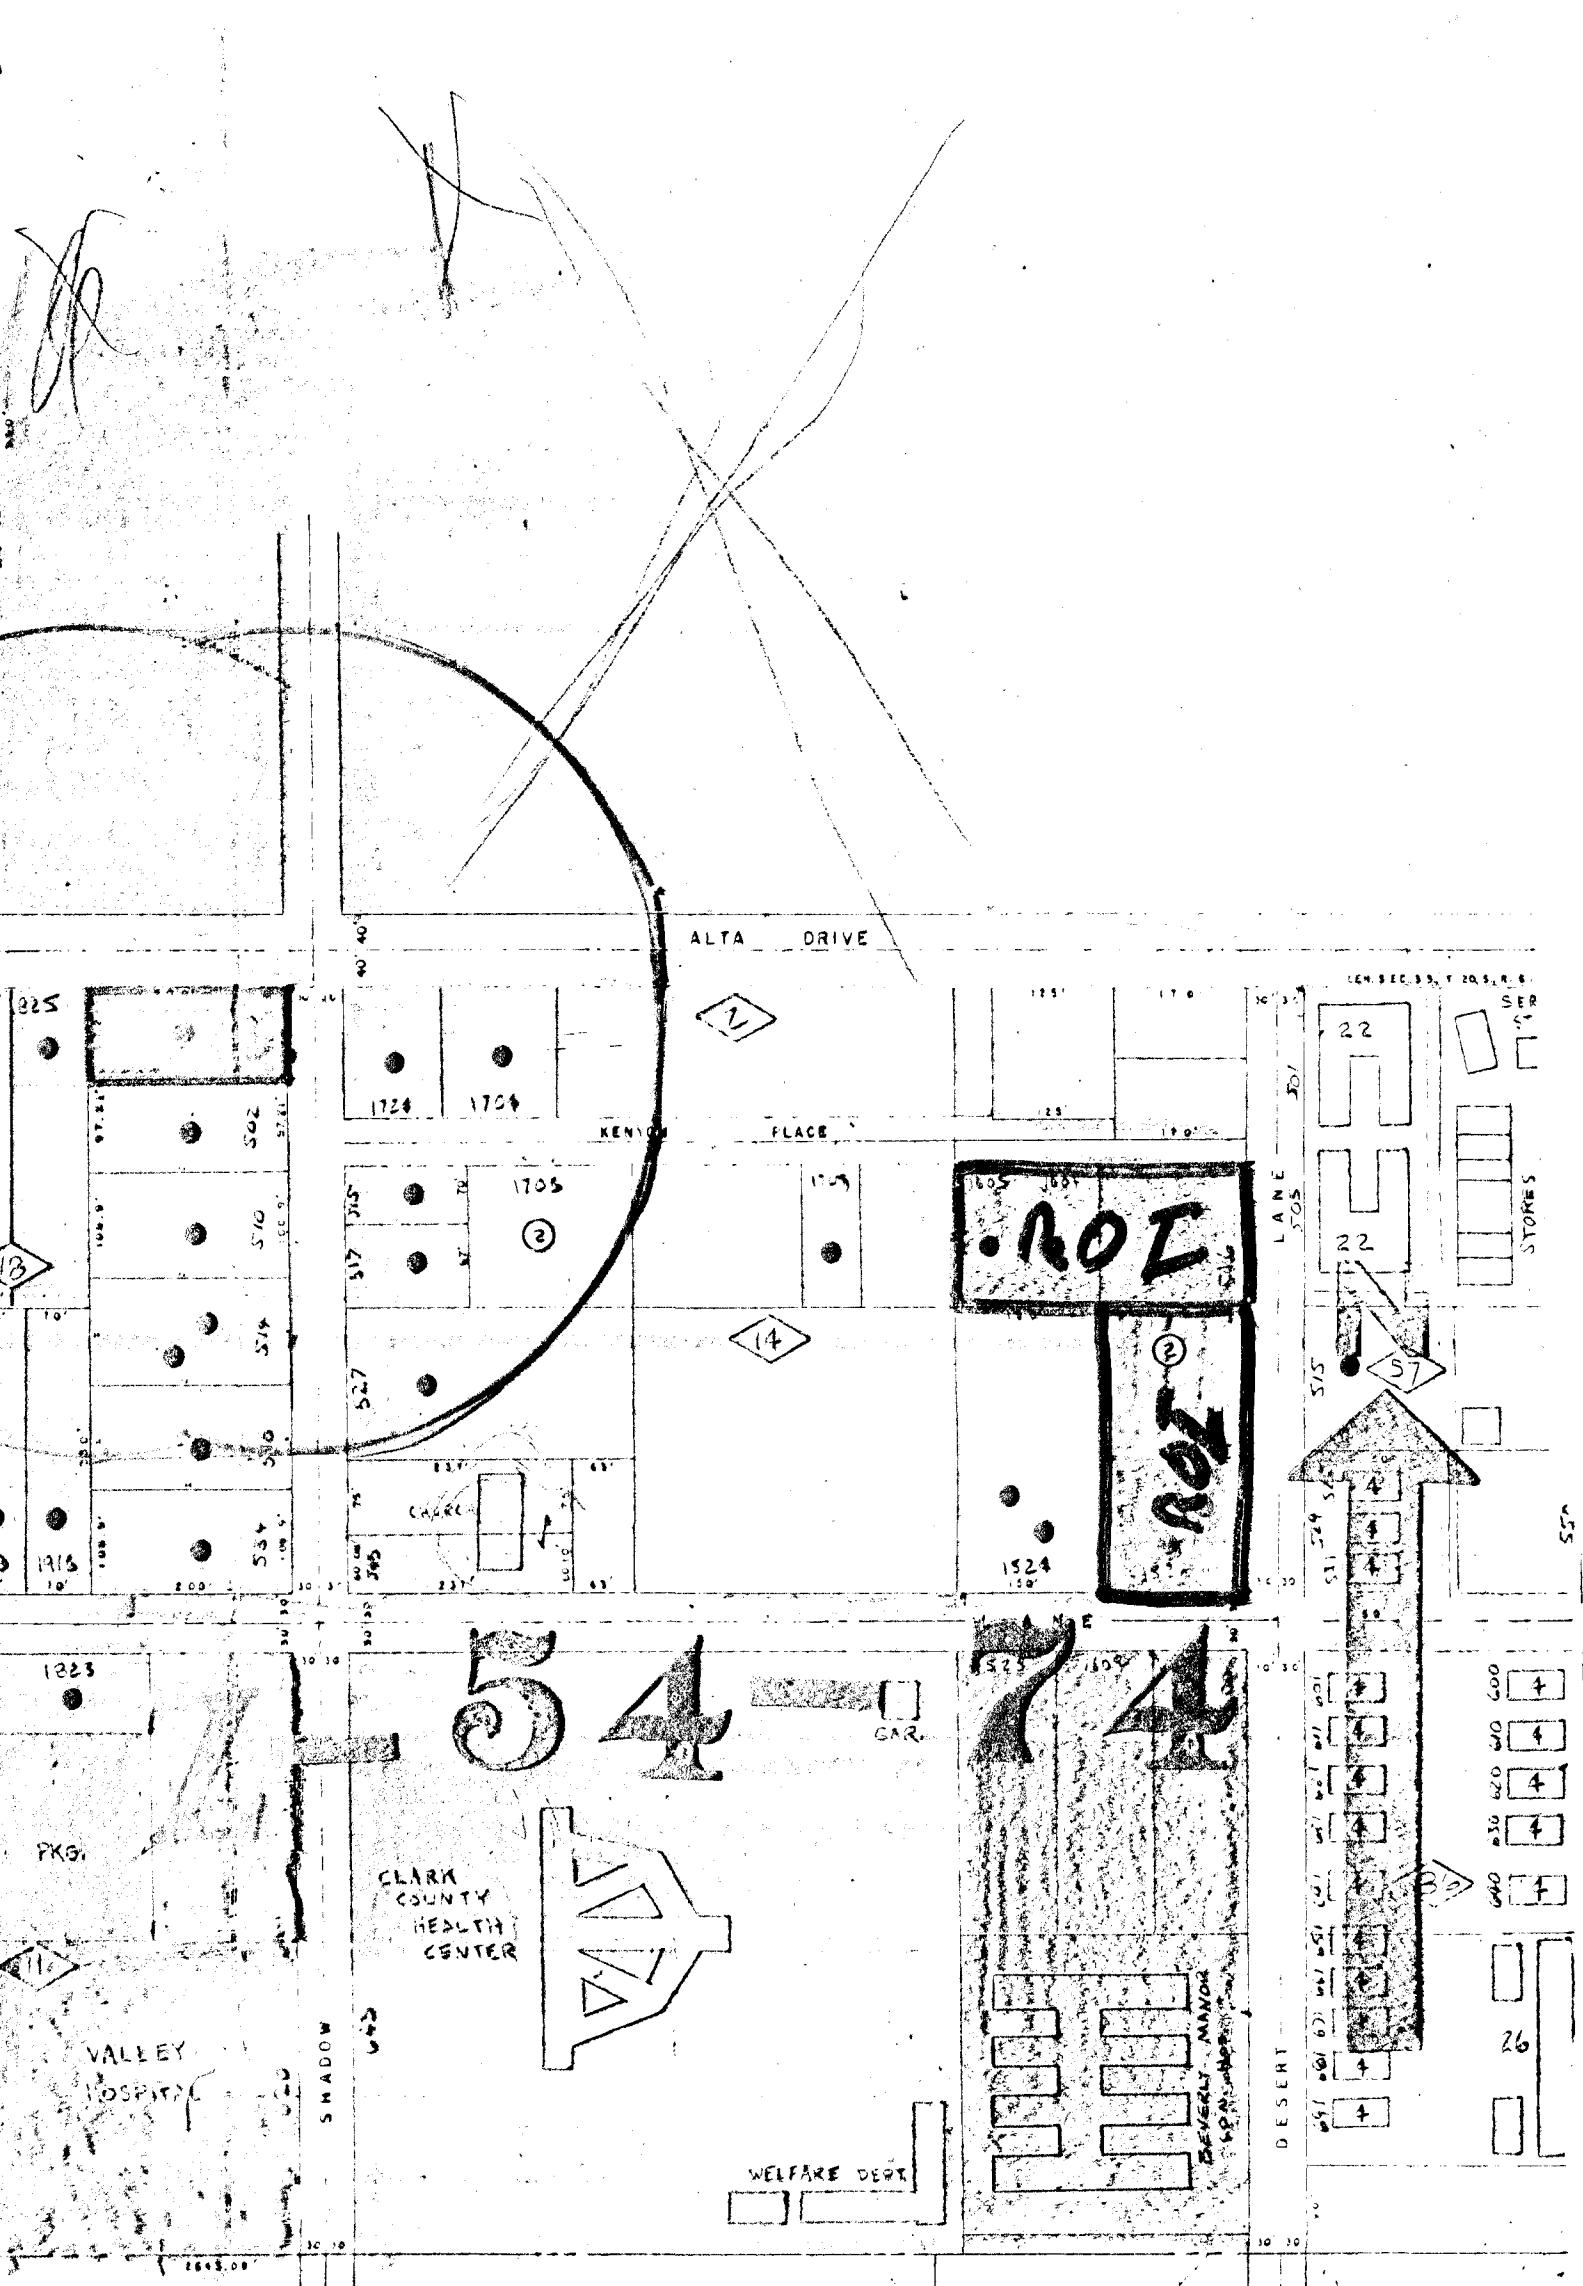
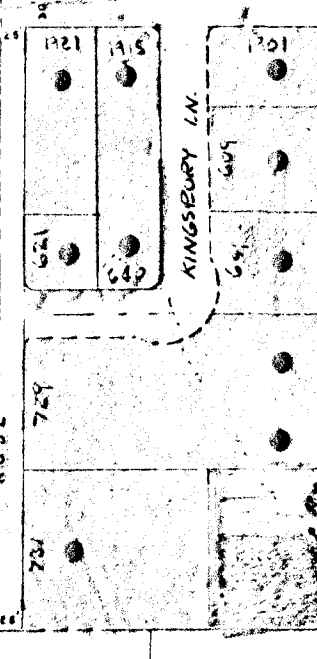
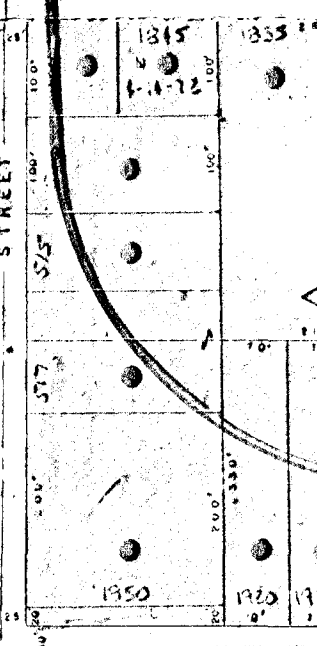
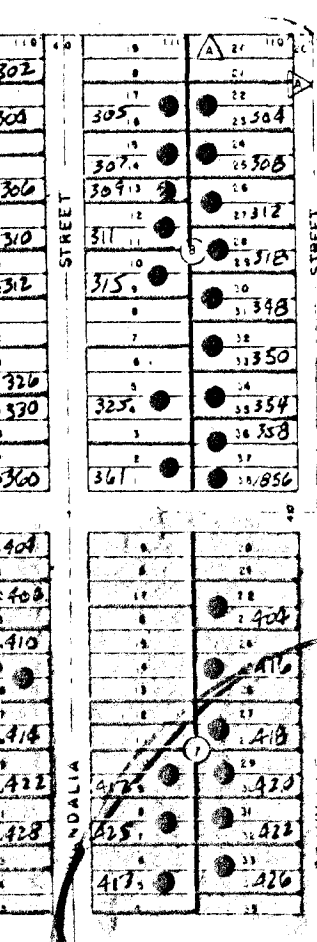
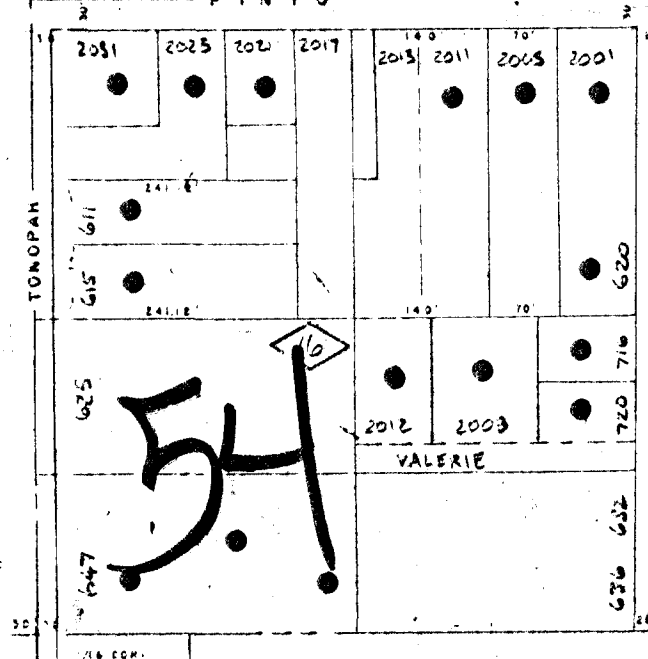
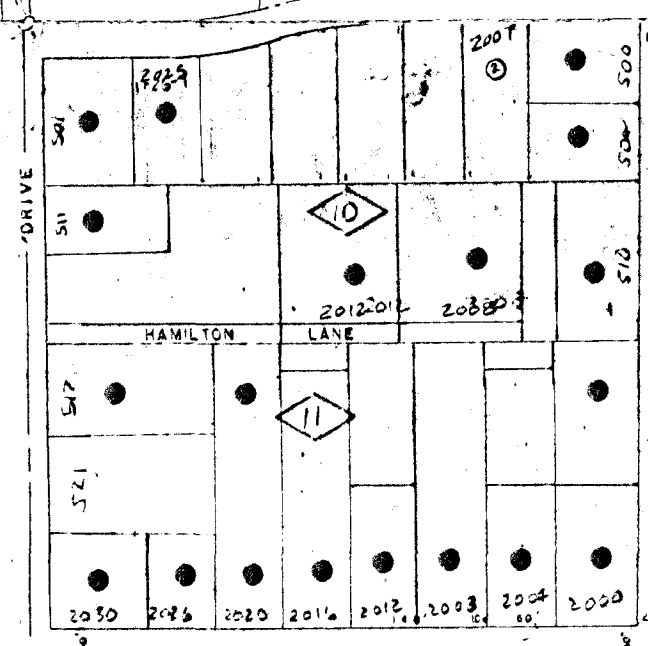


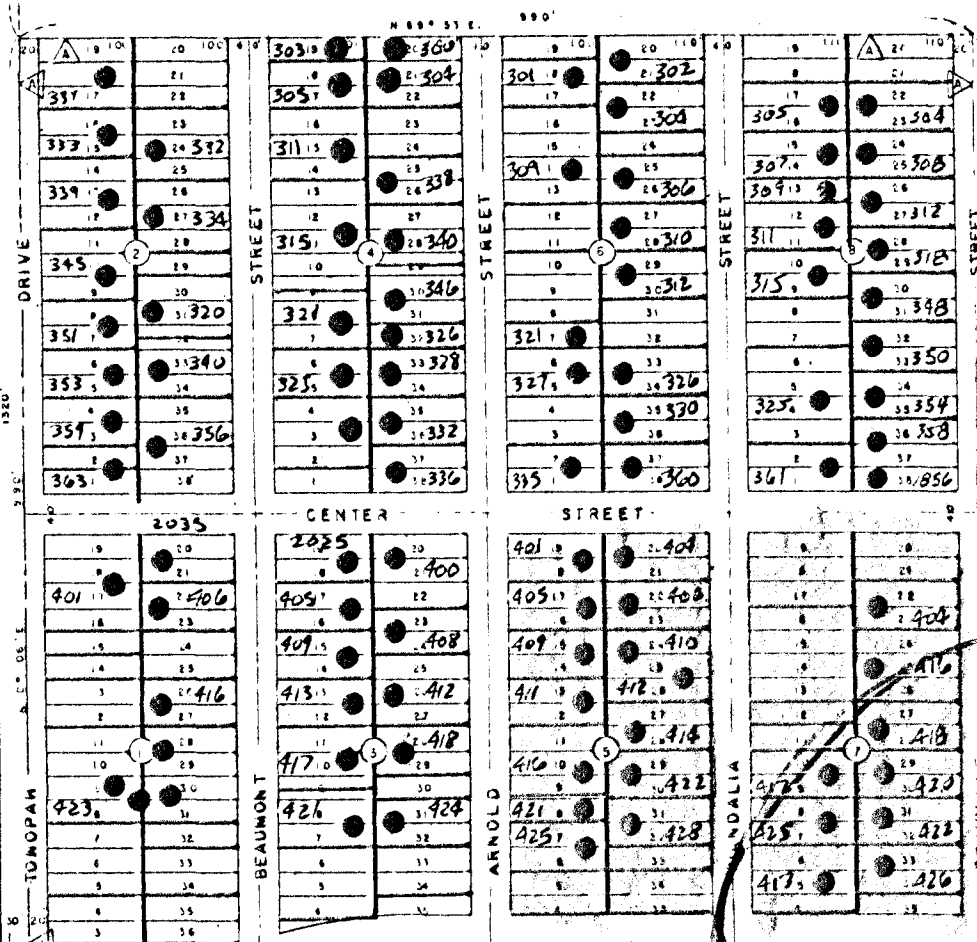

— A L T A — **ALTA** — E T —

20' EXIST DRIVE CUTOUT

(EXIST) CURB LINE

200.0'

12,000# PARKING AREA

100'-6"
25'6" YARD

25'-6"
RESIDENCE

54'-0"
FRONT SETBACK

COUC DRIVE TO STREET

DOWN

APPROX NORTH

200.00'
97.91'

500 SHADOW LANE N

500

P L O T P L A N

(EXISTING RES.)

GRANT PARRY - OWNER

500 SHADOW LANE - LAS VEGAS, NEV.

E.C.C. 11/19/72

54


WITH GRASSY AREA

5 GAL JUNGLES
4' ON CENTER

20' EXIST DRIVE CUTOUT

(EXIST) CURB LINE

APPROVED LANDSCAPING PLAN
1-4-76
Department of Community Development

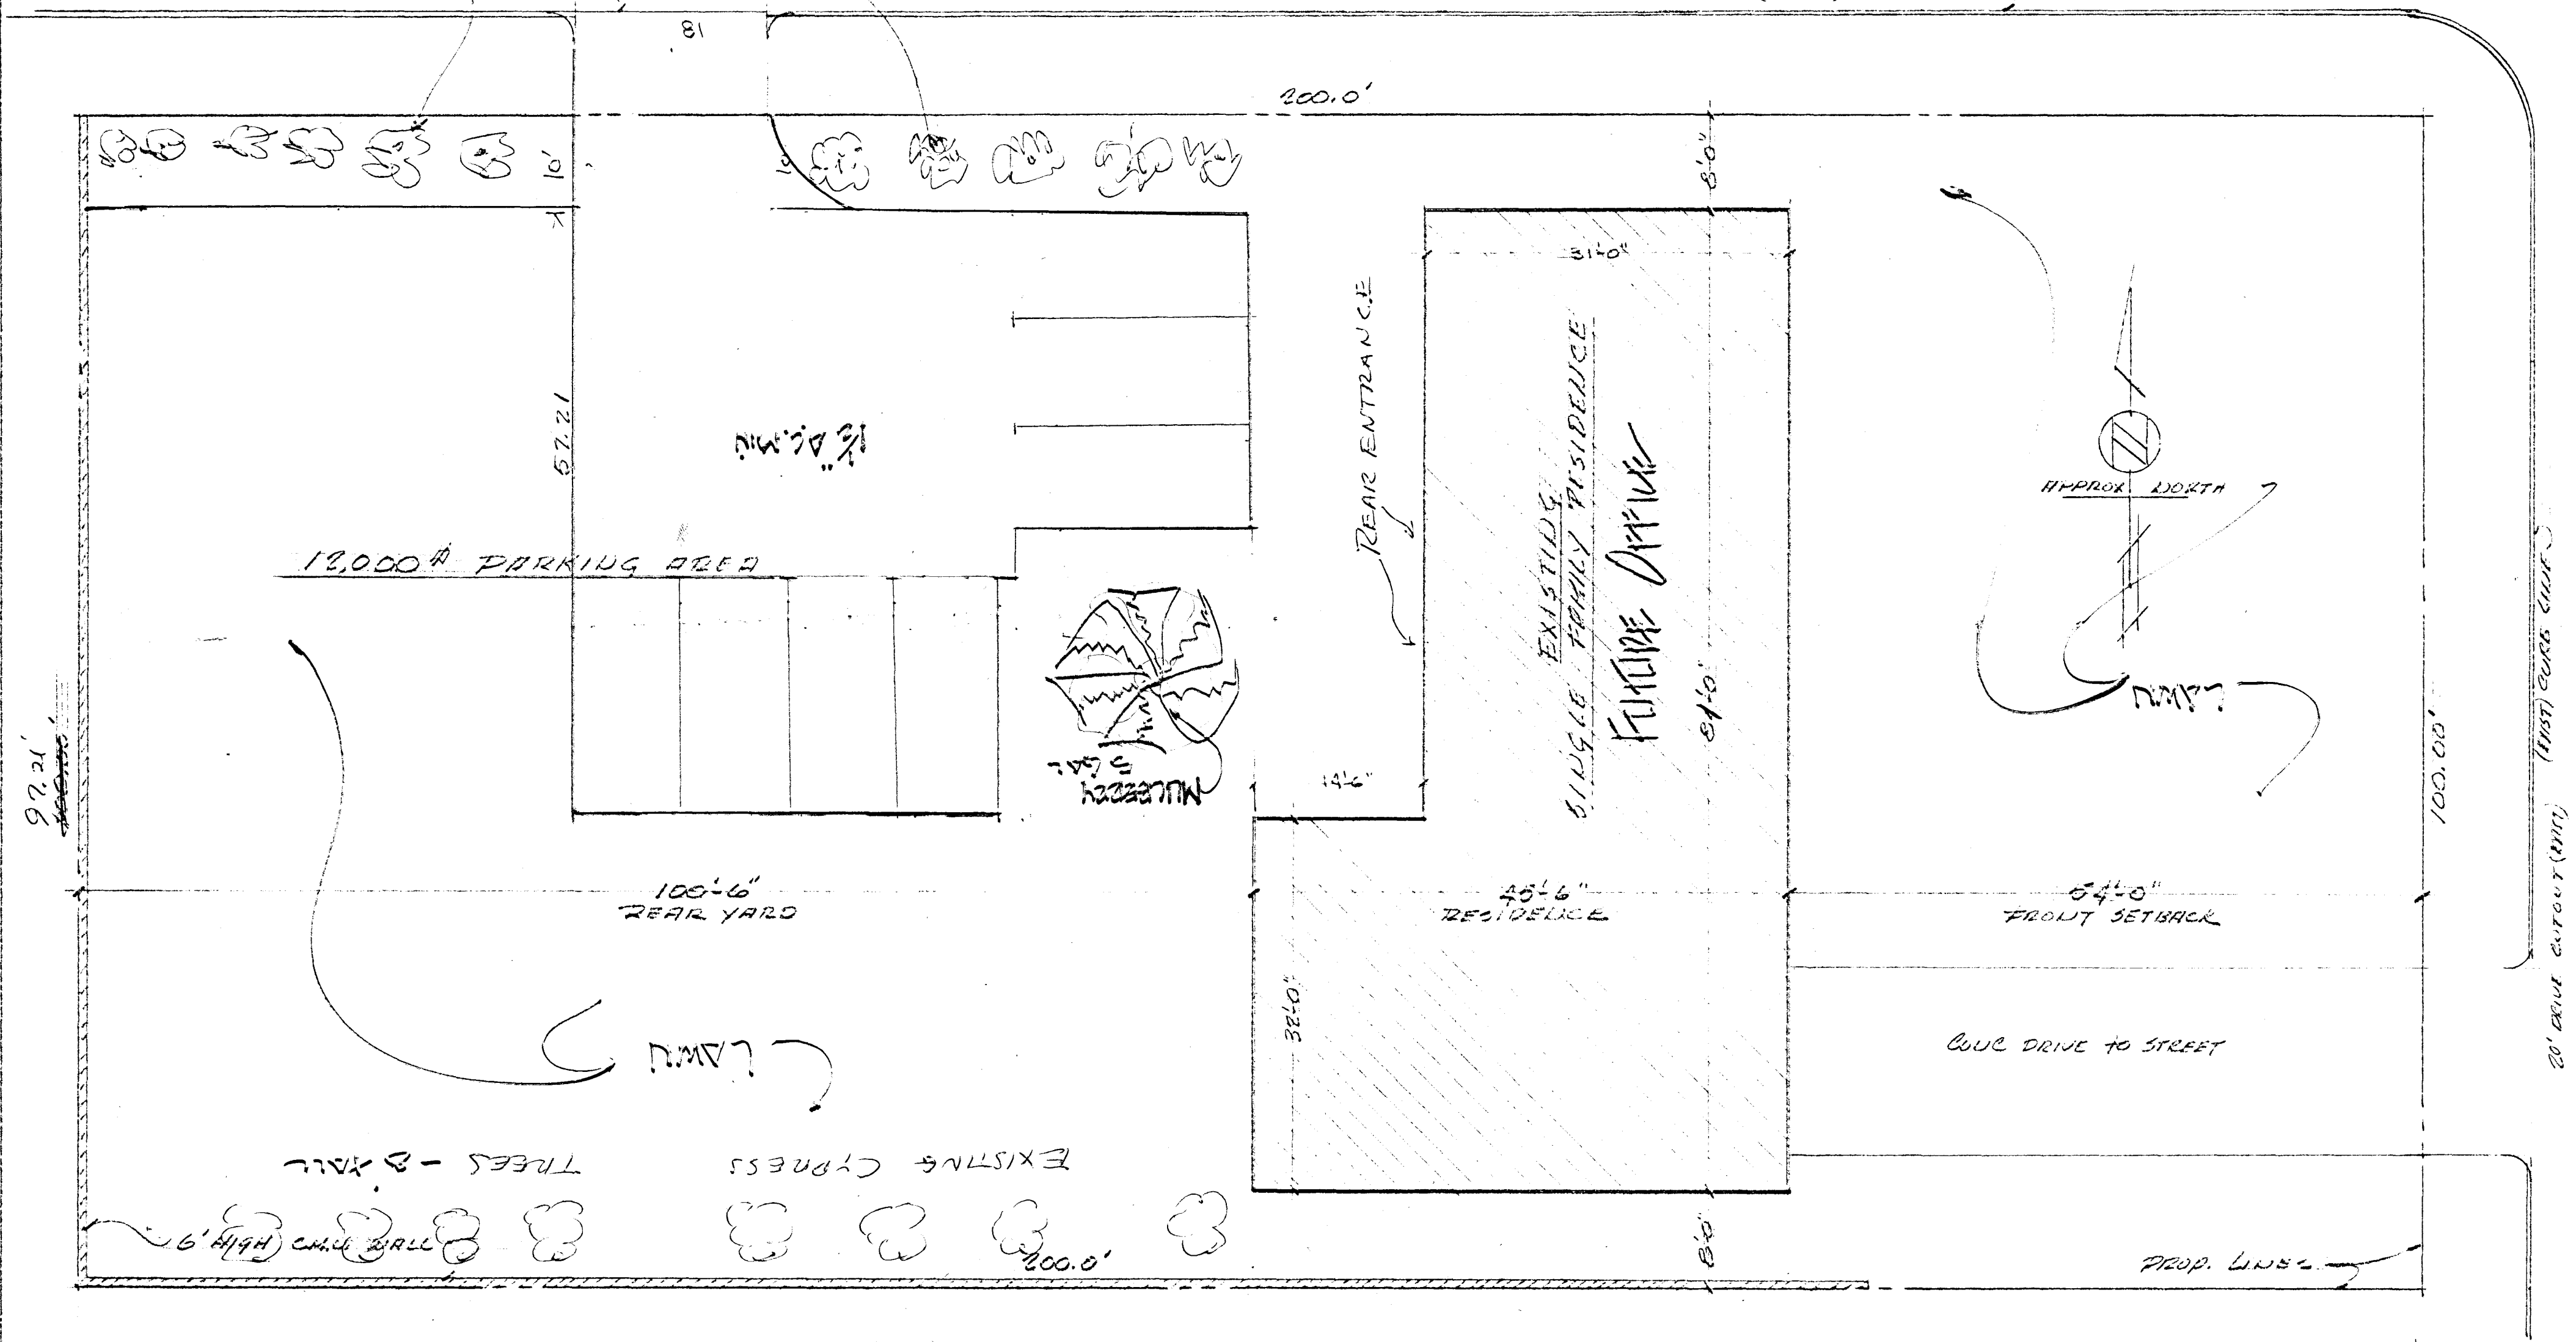

500 SHADOW LAKE

20' DRIVE CUTOUT (MIN) (EXIST) DRIVE CUTOUT

PROP. LINE

PLOT PLAN
(EXISTING RES.)
GRANT PARRY - OWNER
500 SHADOW LAKE - LAS VEGAS, NEV.

Z.C.C. 11/19/74

54