

COUNTY

N.L.V.

NOTE:
ALL MEASUREMENTS
FACING TO THE
SOUTH SIDE OF ROAD
SMALL BE 100' PROXIMATE


2000E

2000E

2200E

2300E

2400E

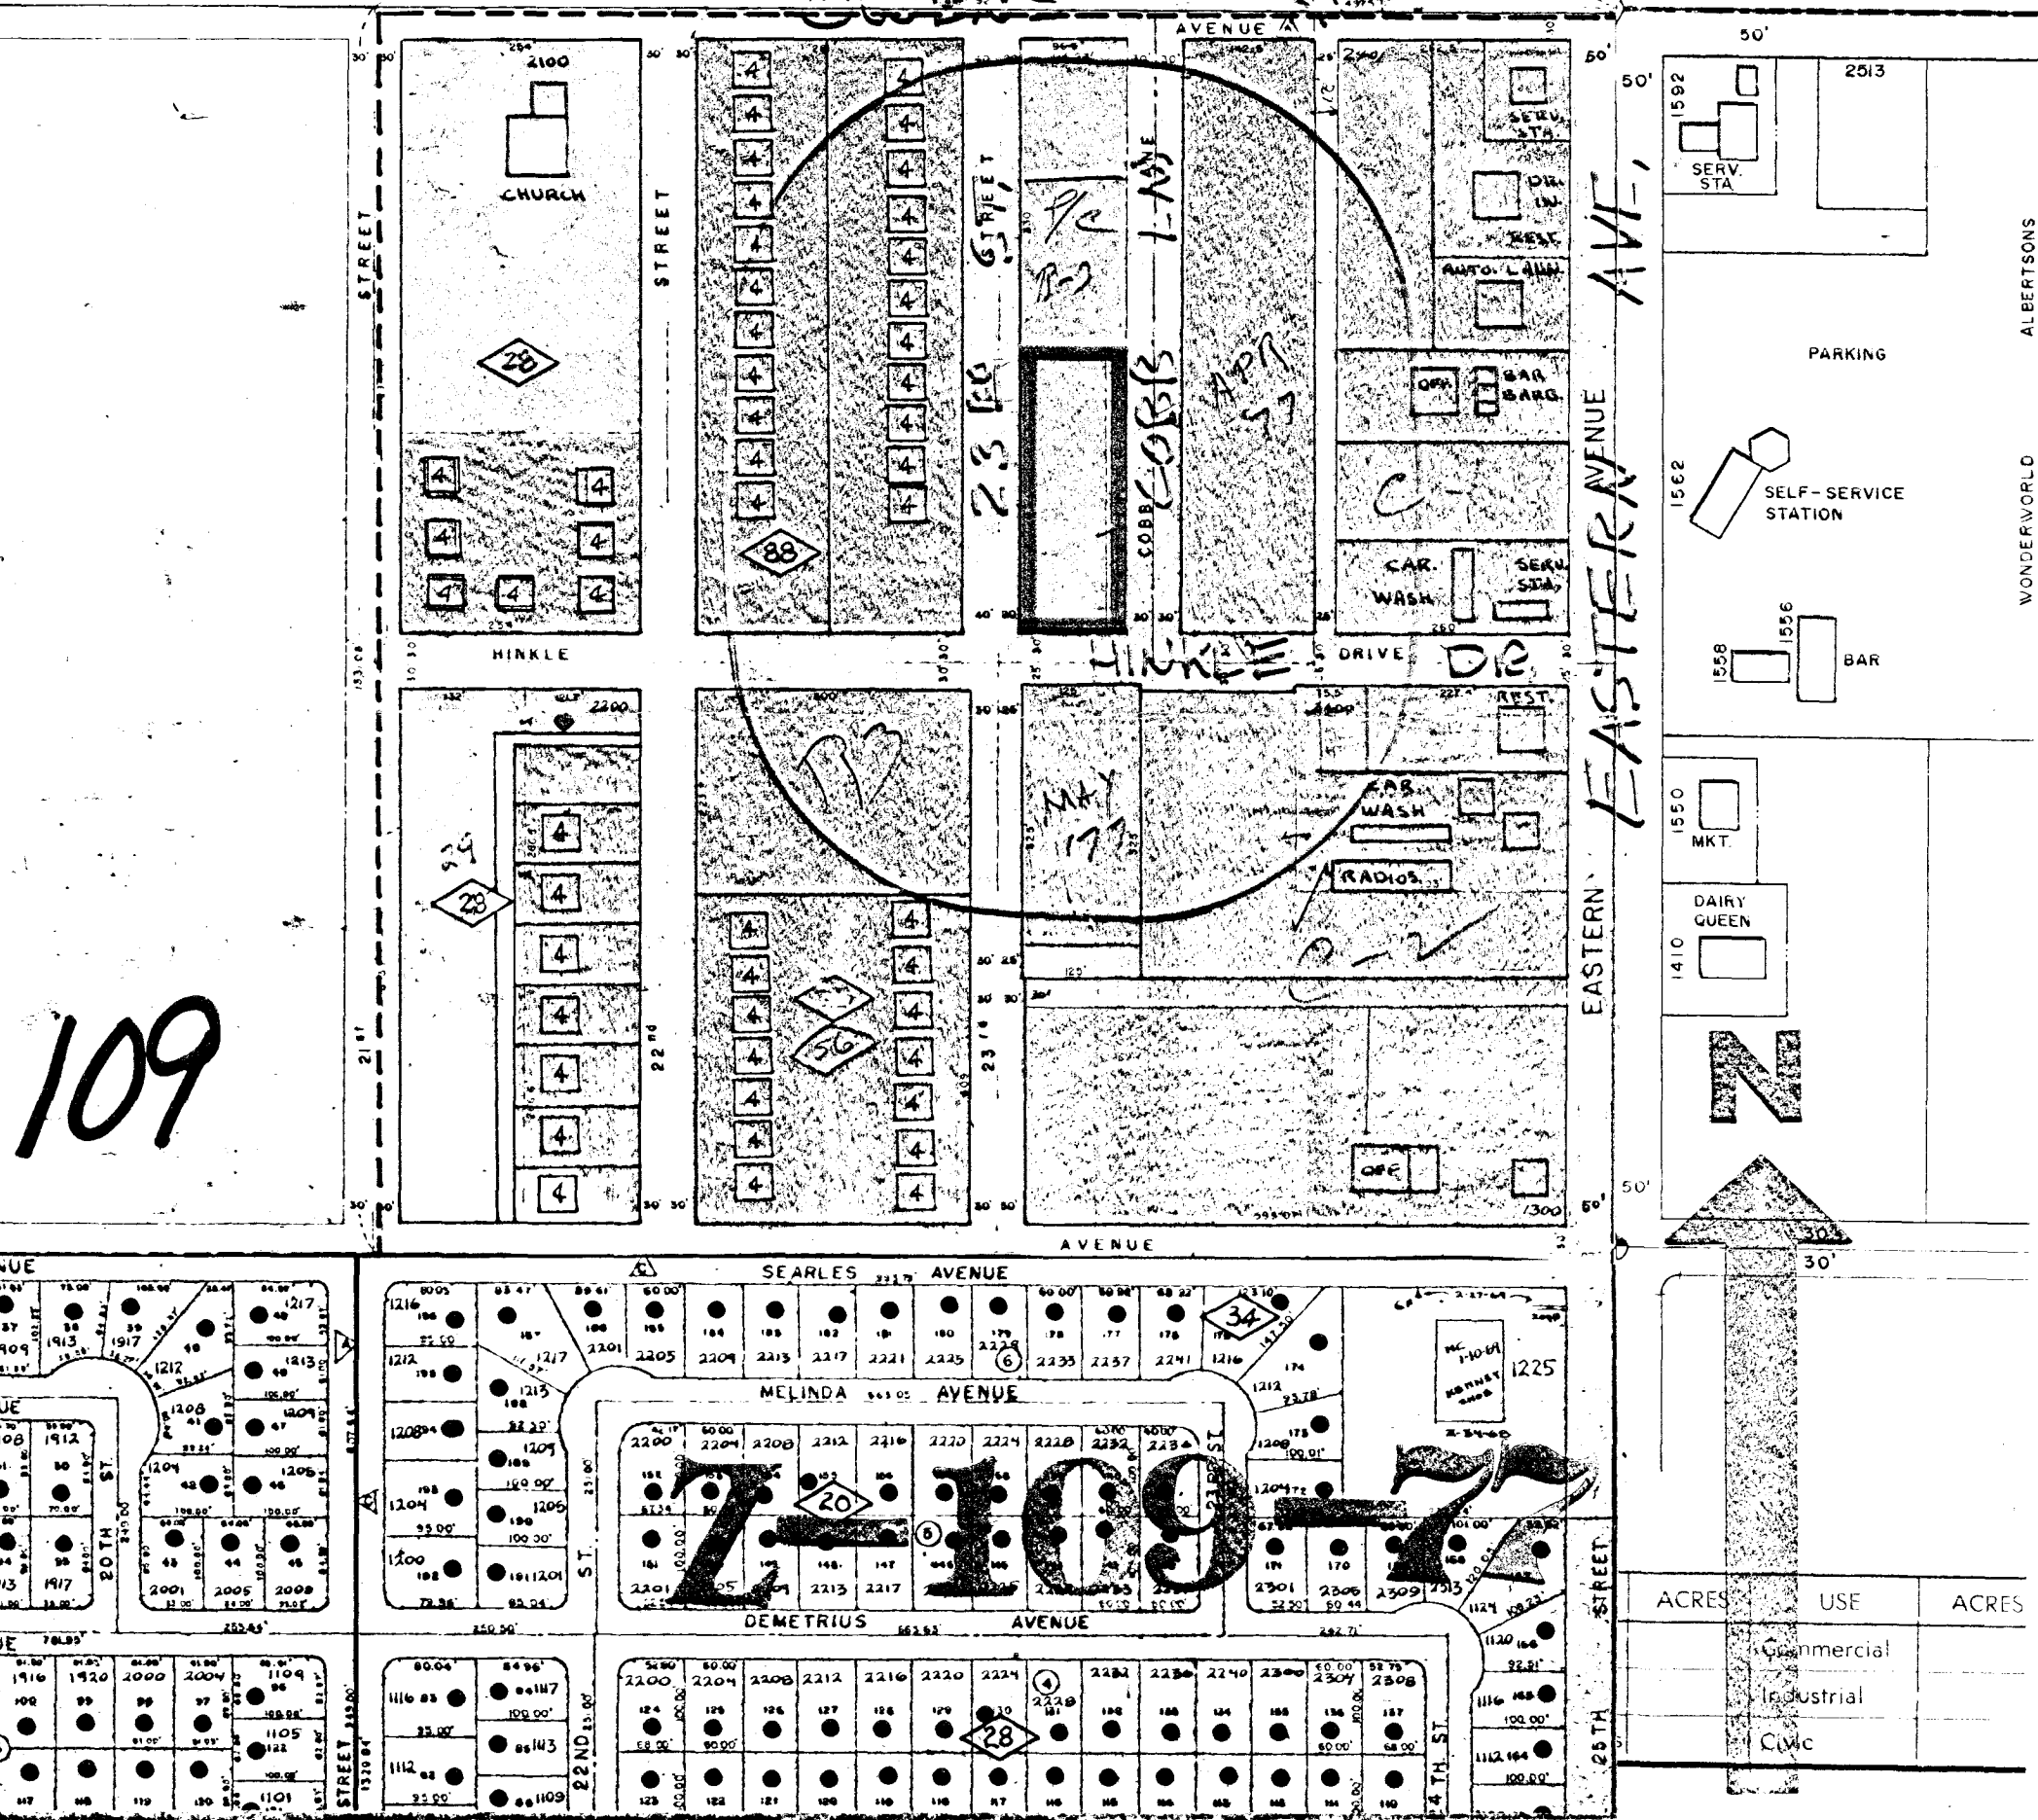

109

Z-109

N

ACRES	USE	ACRES
	Commercial	
	Industrial	
	Civic	

