


RAMSEY ST.
RAMSEY

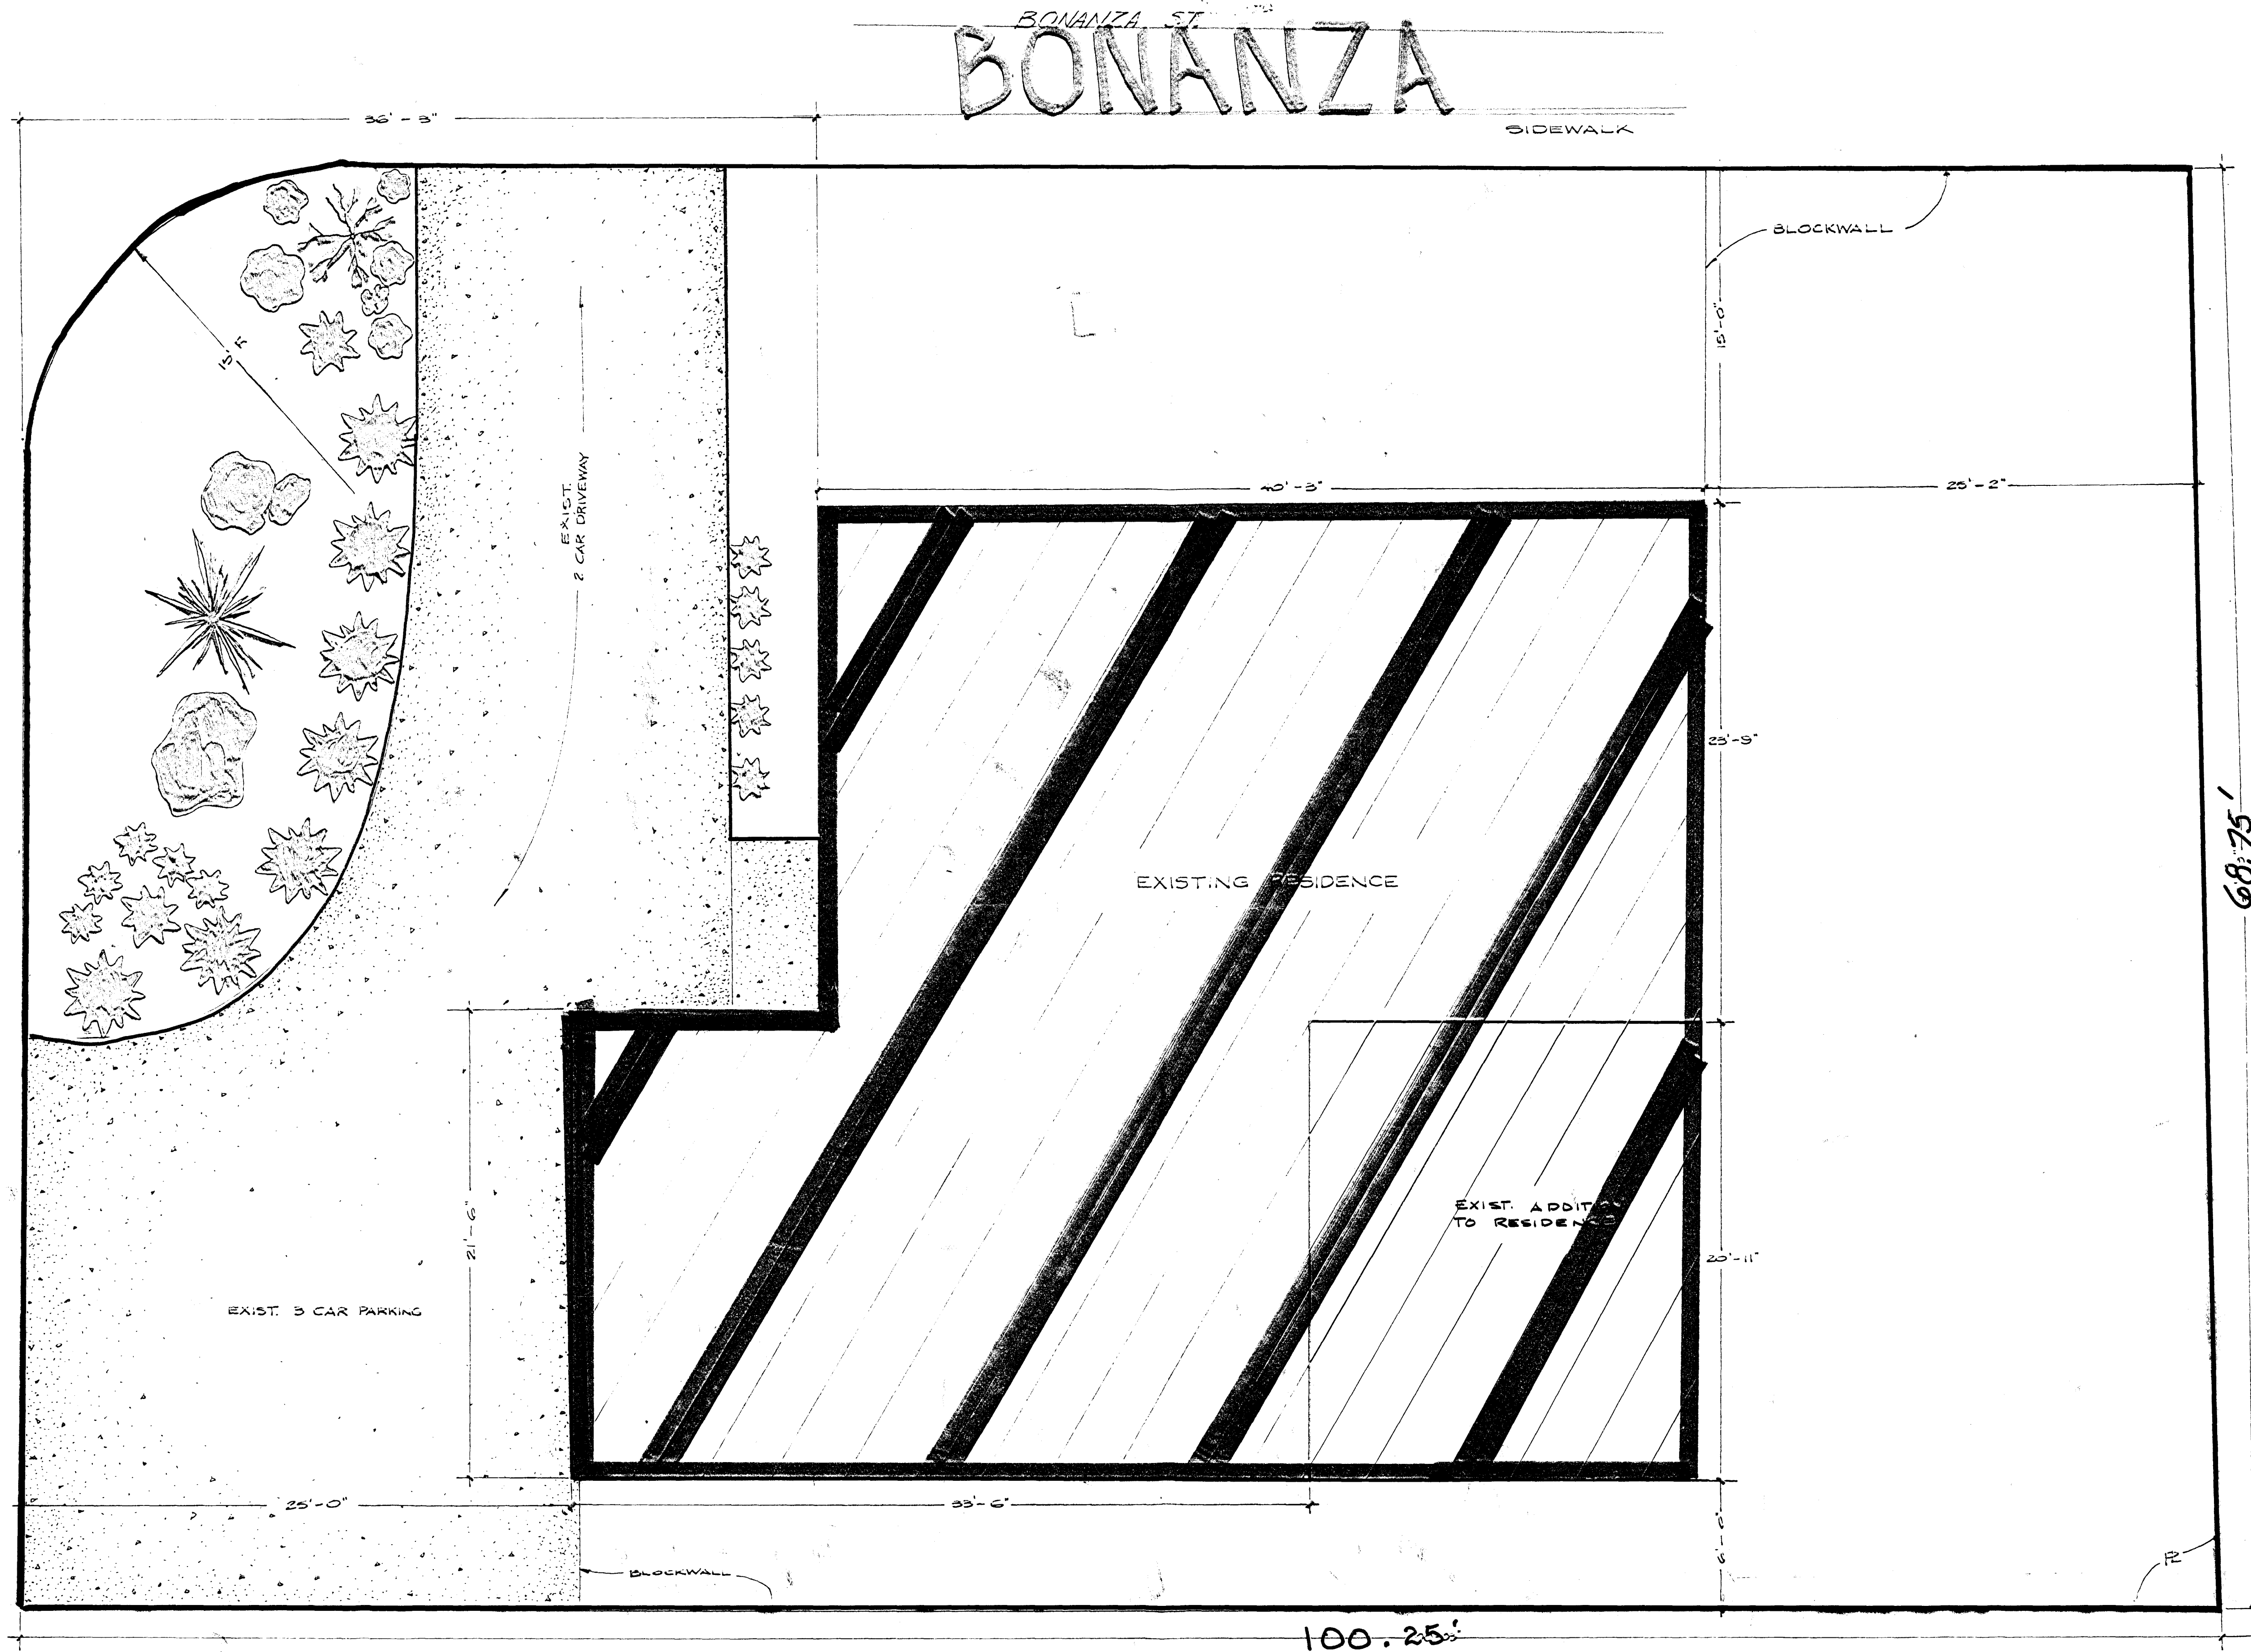

Z-109-79



TITLE: RESIDENCE: RICHARD KING		CO.	
LOC: 404 RAMSEY, LAS VEGAS, NV		ENG.	DIST. ENG.
ISSUE DATE: 10-5-79	SCALE: 1/4" = 1'-0"	DRAWN BY: J. REZA	DWG. NO.
Sht. OF		SIZE	W.O. NO.

CC 12/5/79

Z-109-79


BONANZA ST.

RAMSEY ST.

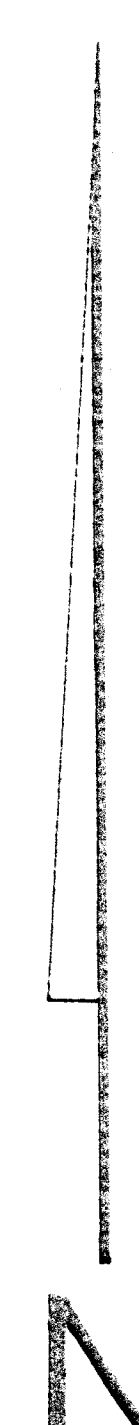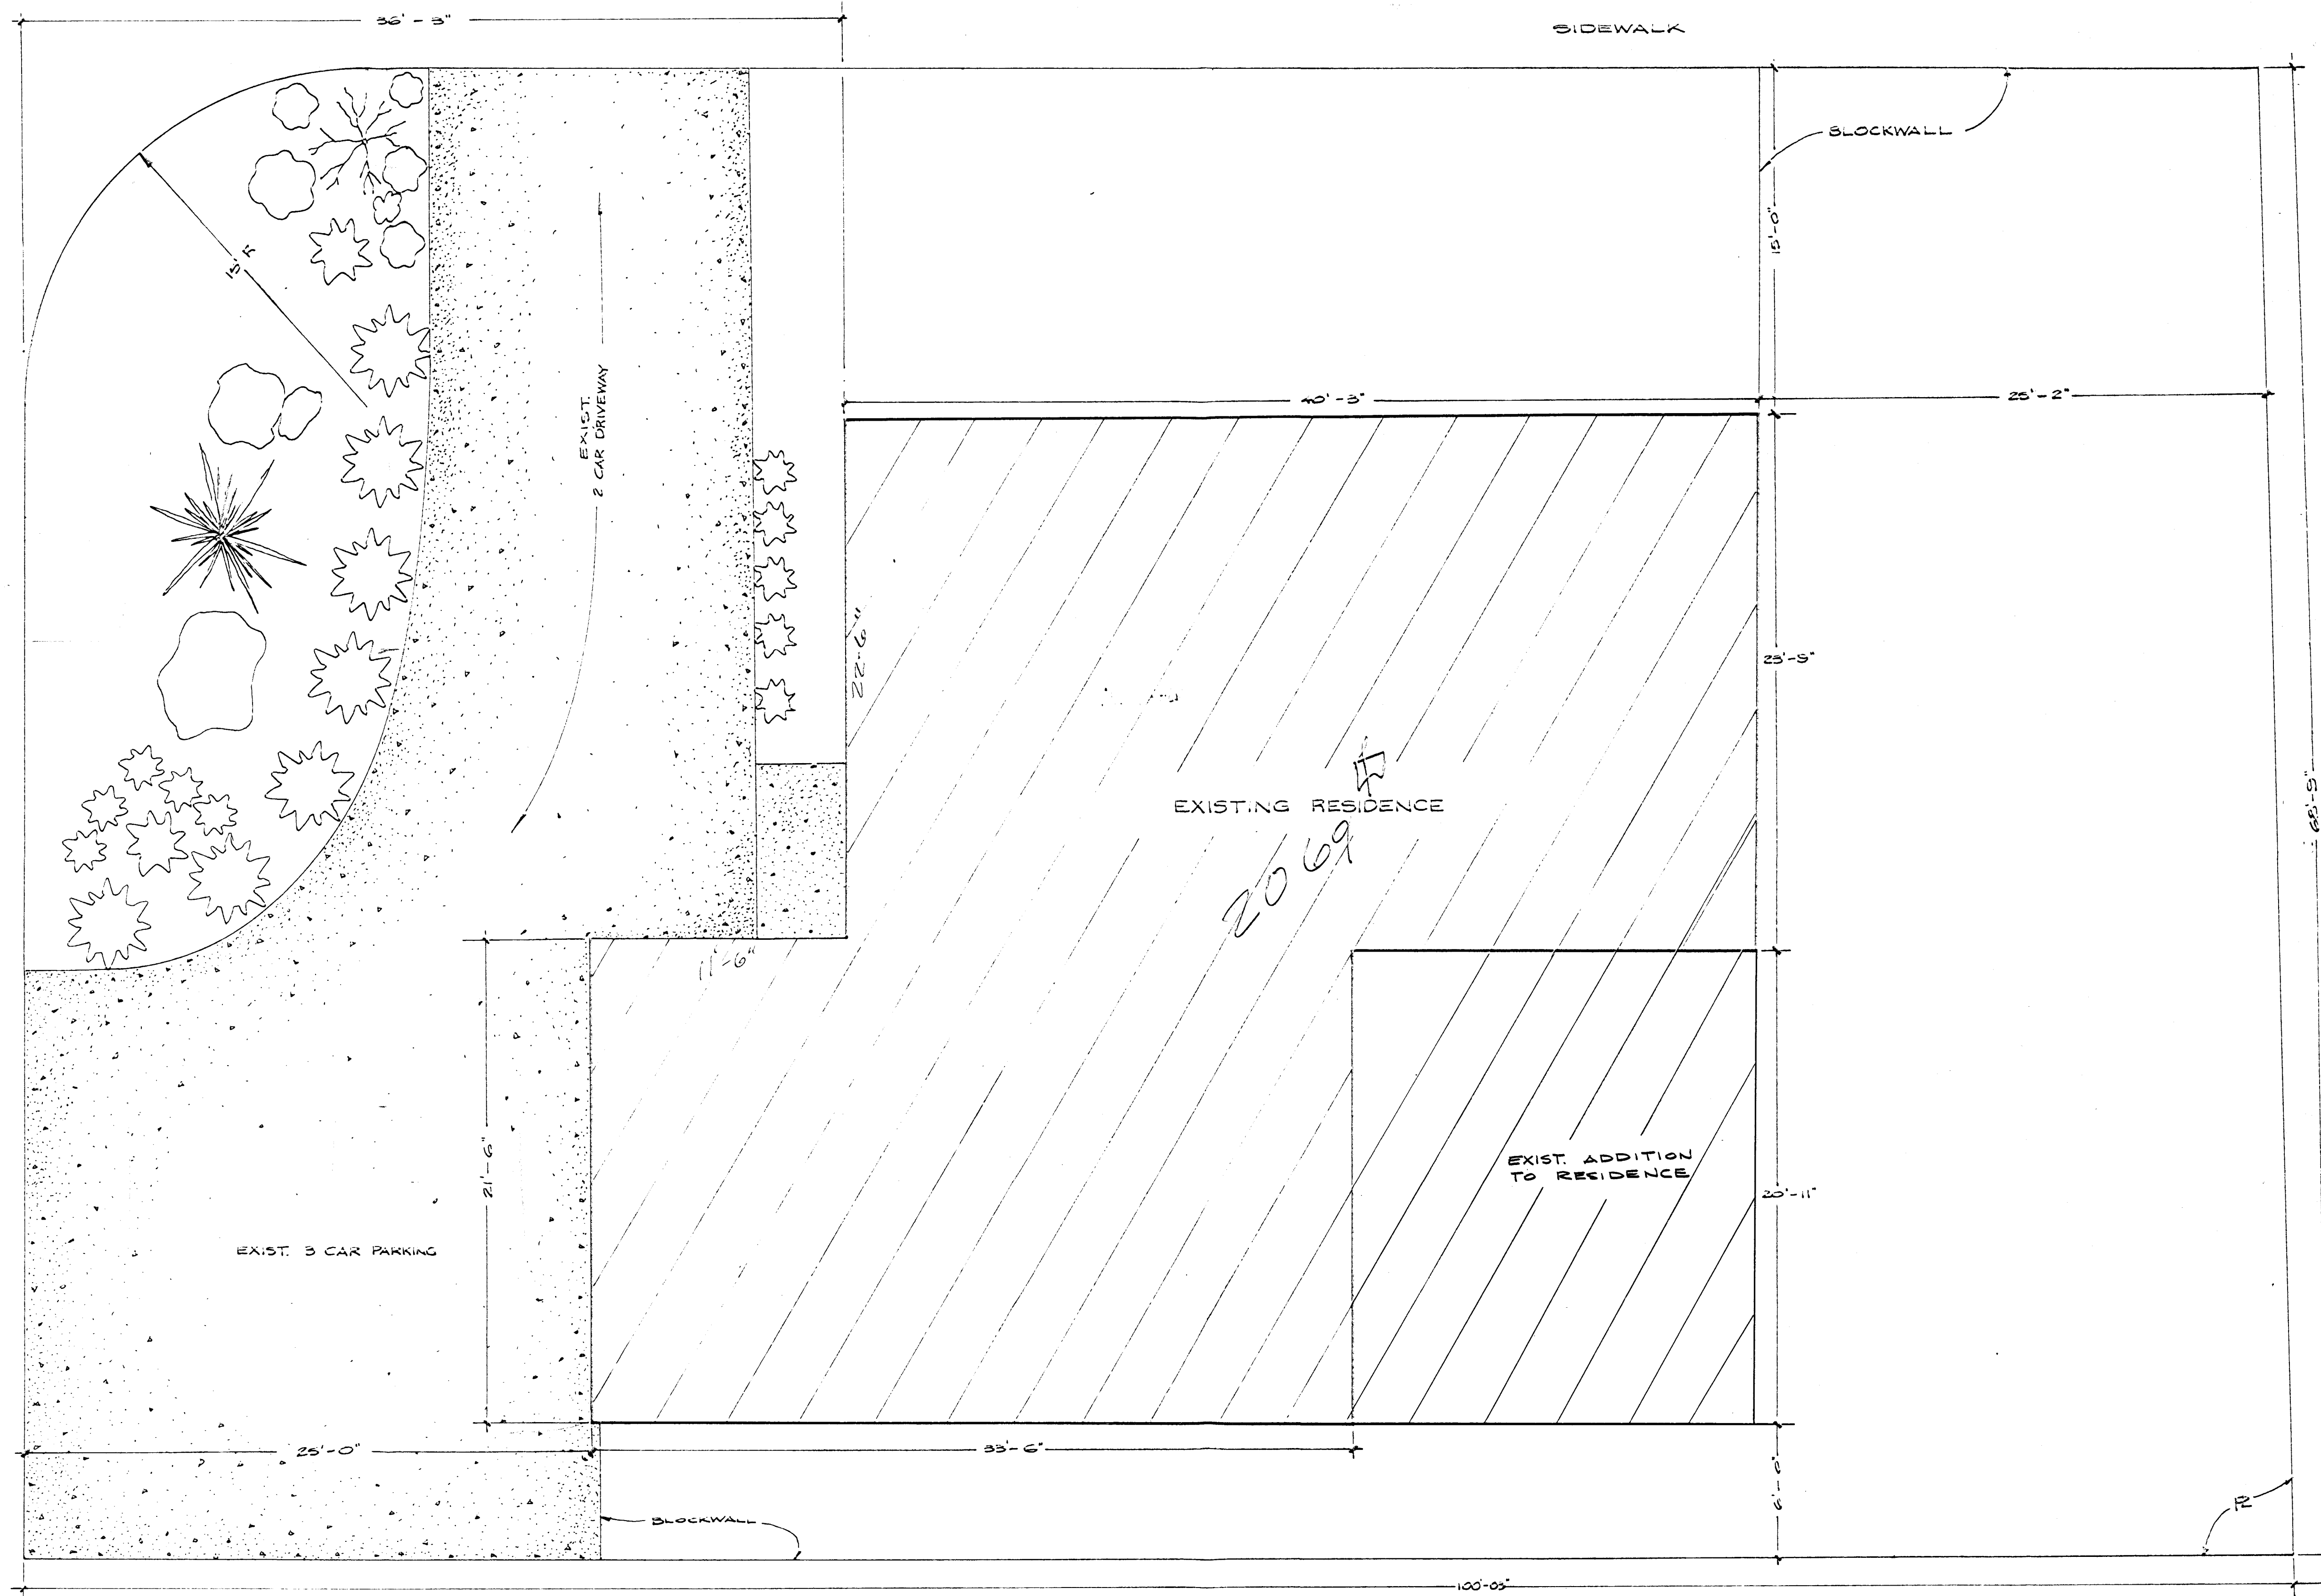

5 Parking spaces Required

29 28
2 58
GPR COMPANY FILE

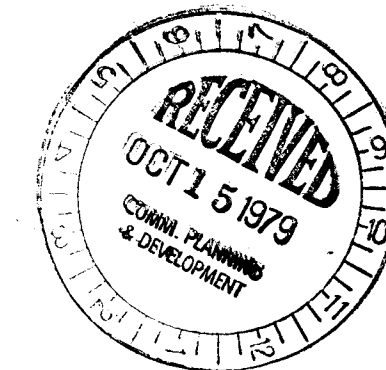

TITLE RESIDENCE: RICHARD KING							
LOC: 404 RAMSEY, LAS VEGAS, NV							
ISSUE DATE		SCALE		DRAWN BY		DWG NO.	
10-5-79		1/4" = 1'-0"		J. REZA		SIZE	
						SHT. OF	

Z-109-79