



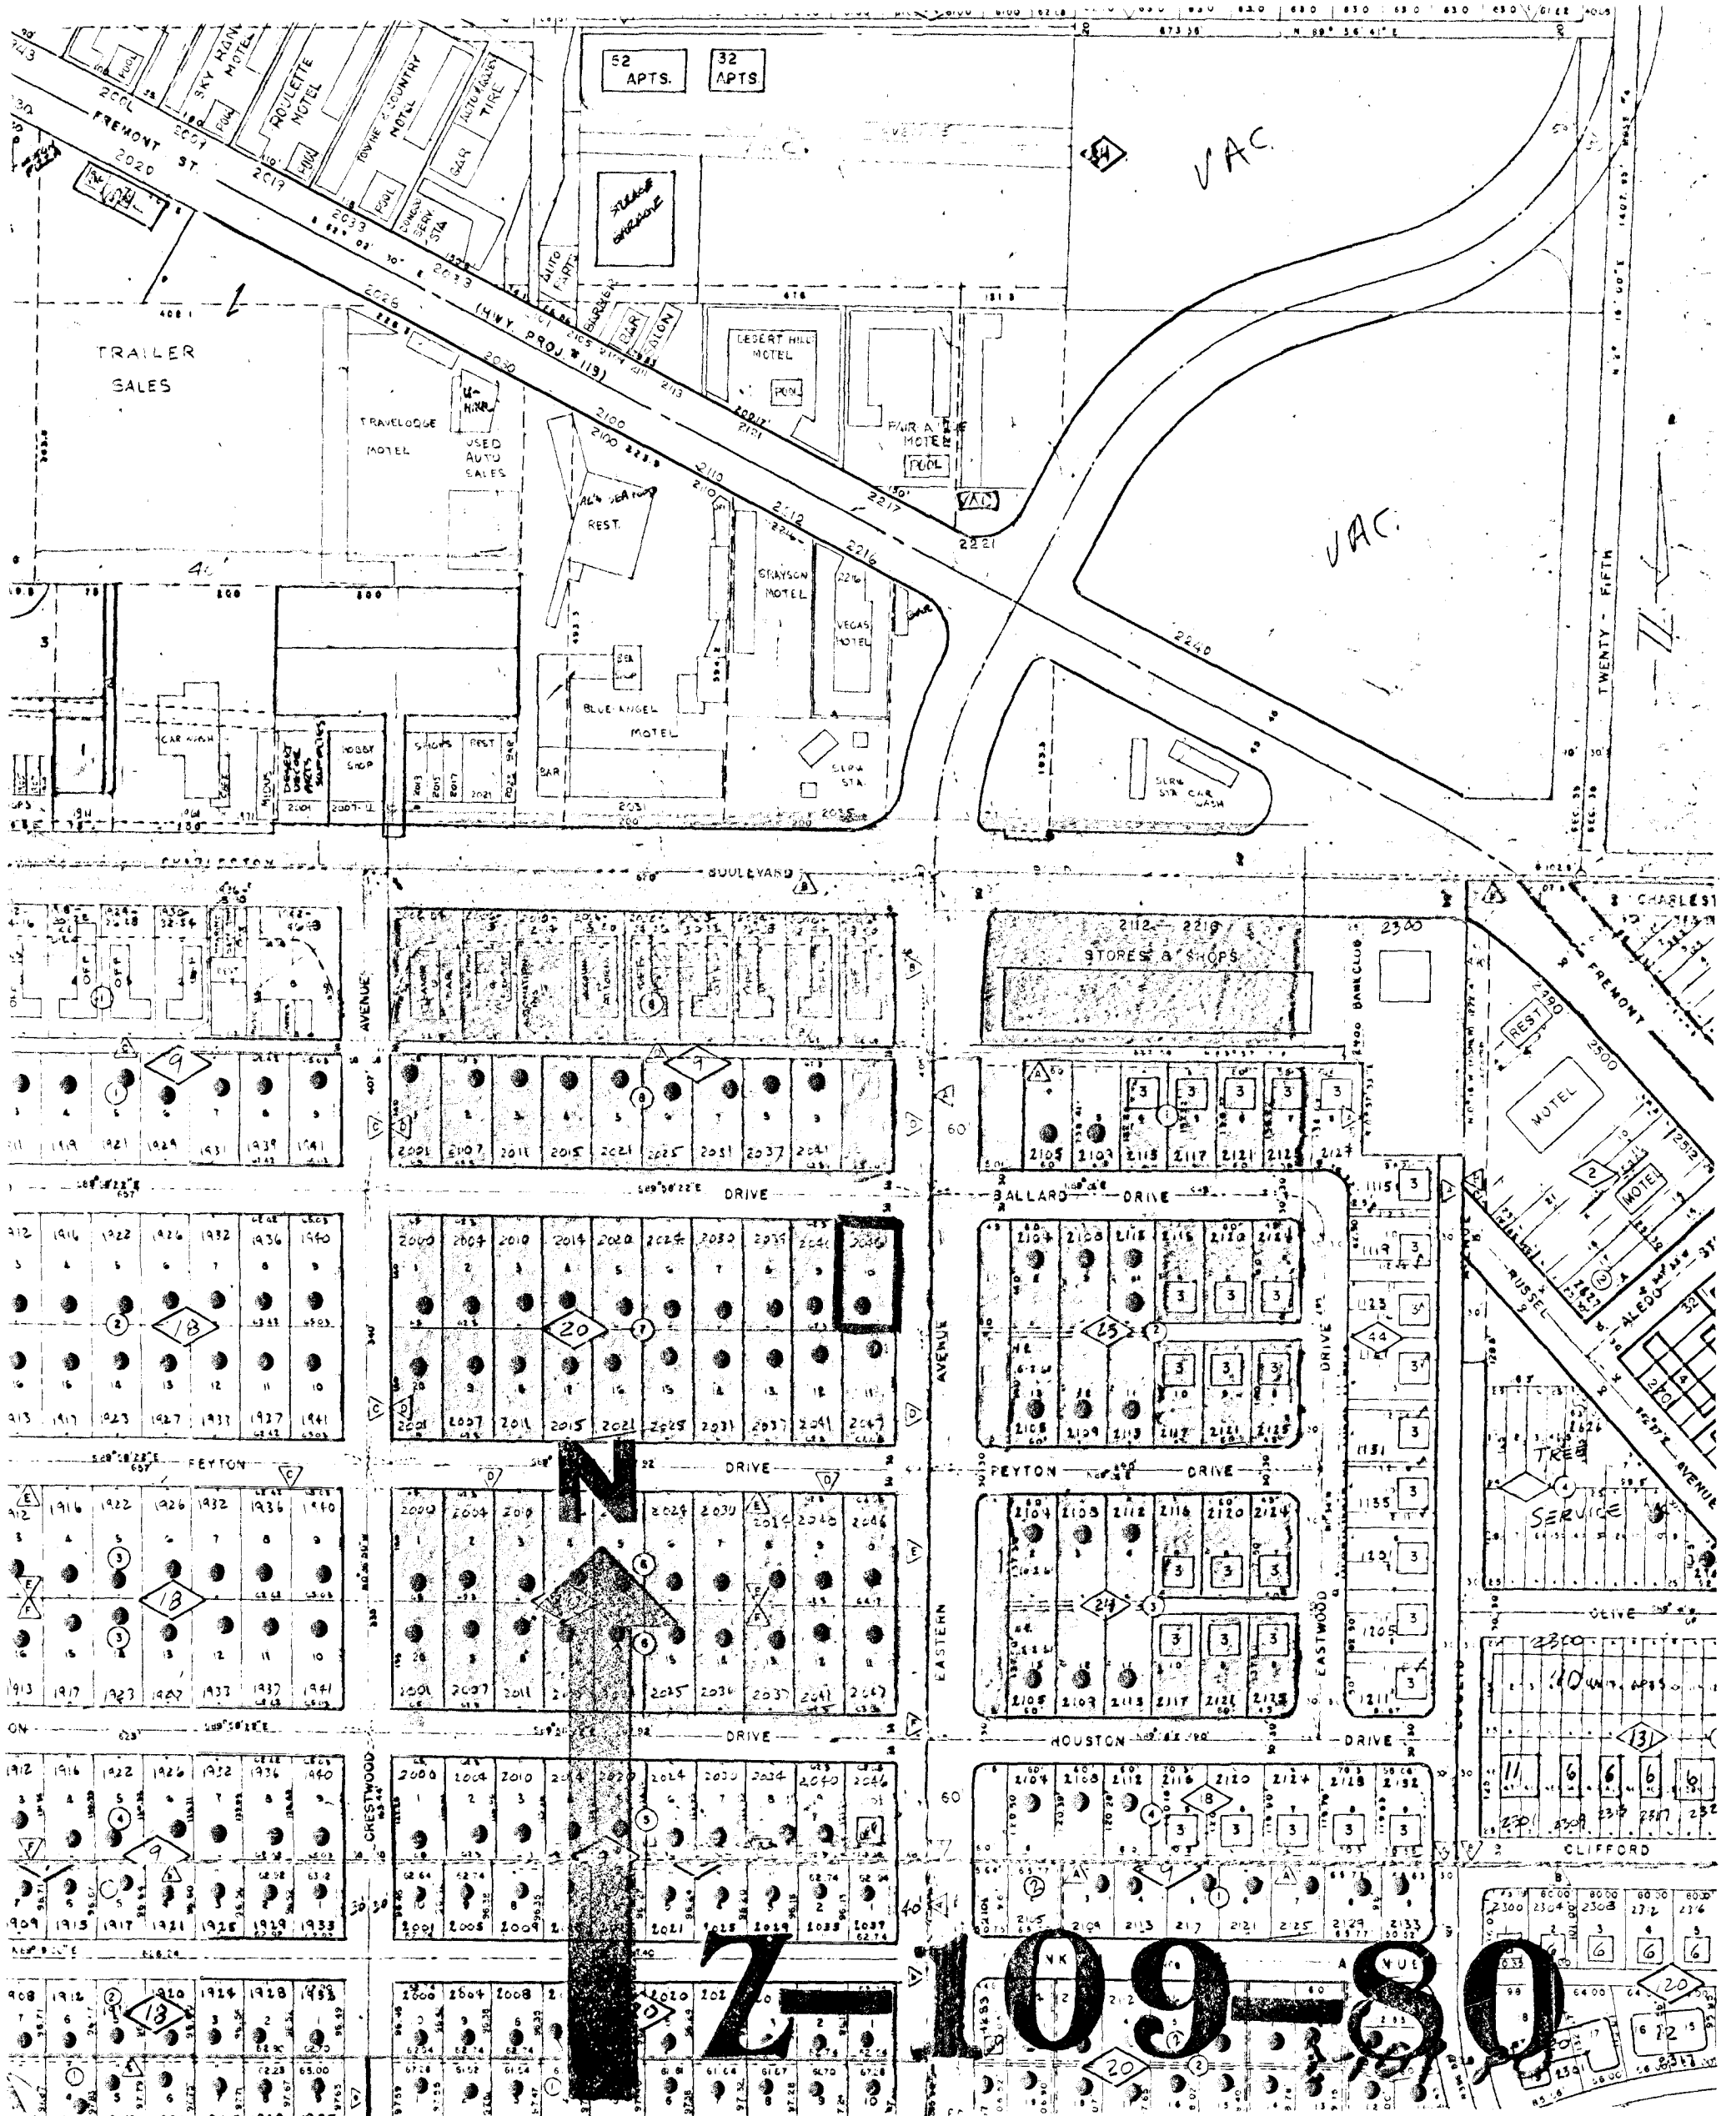

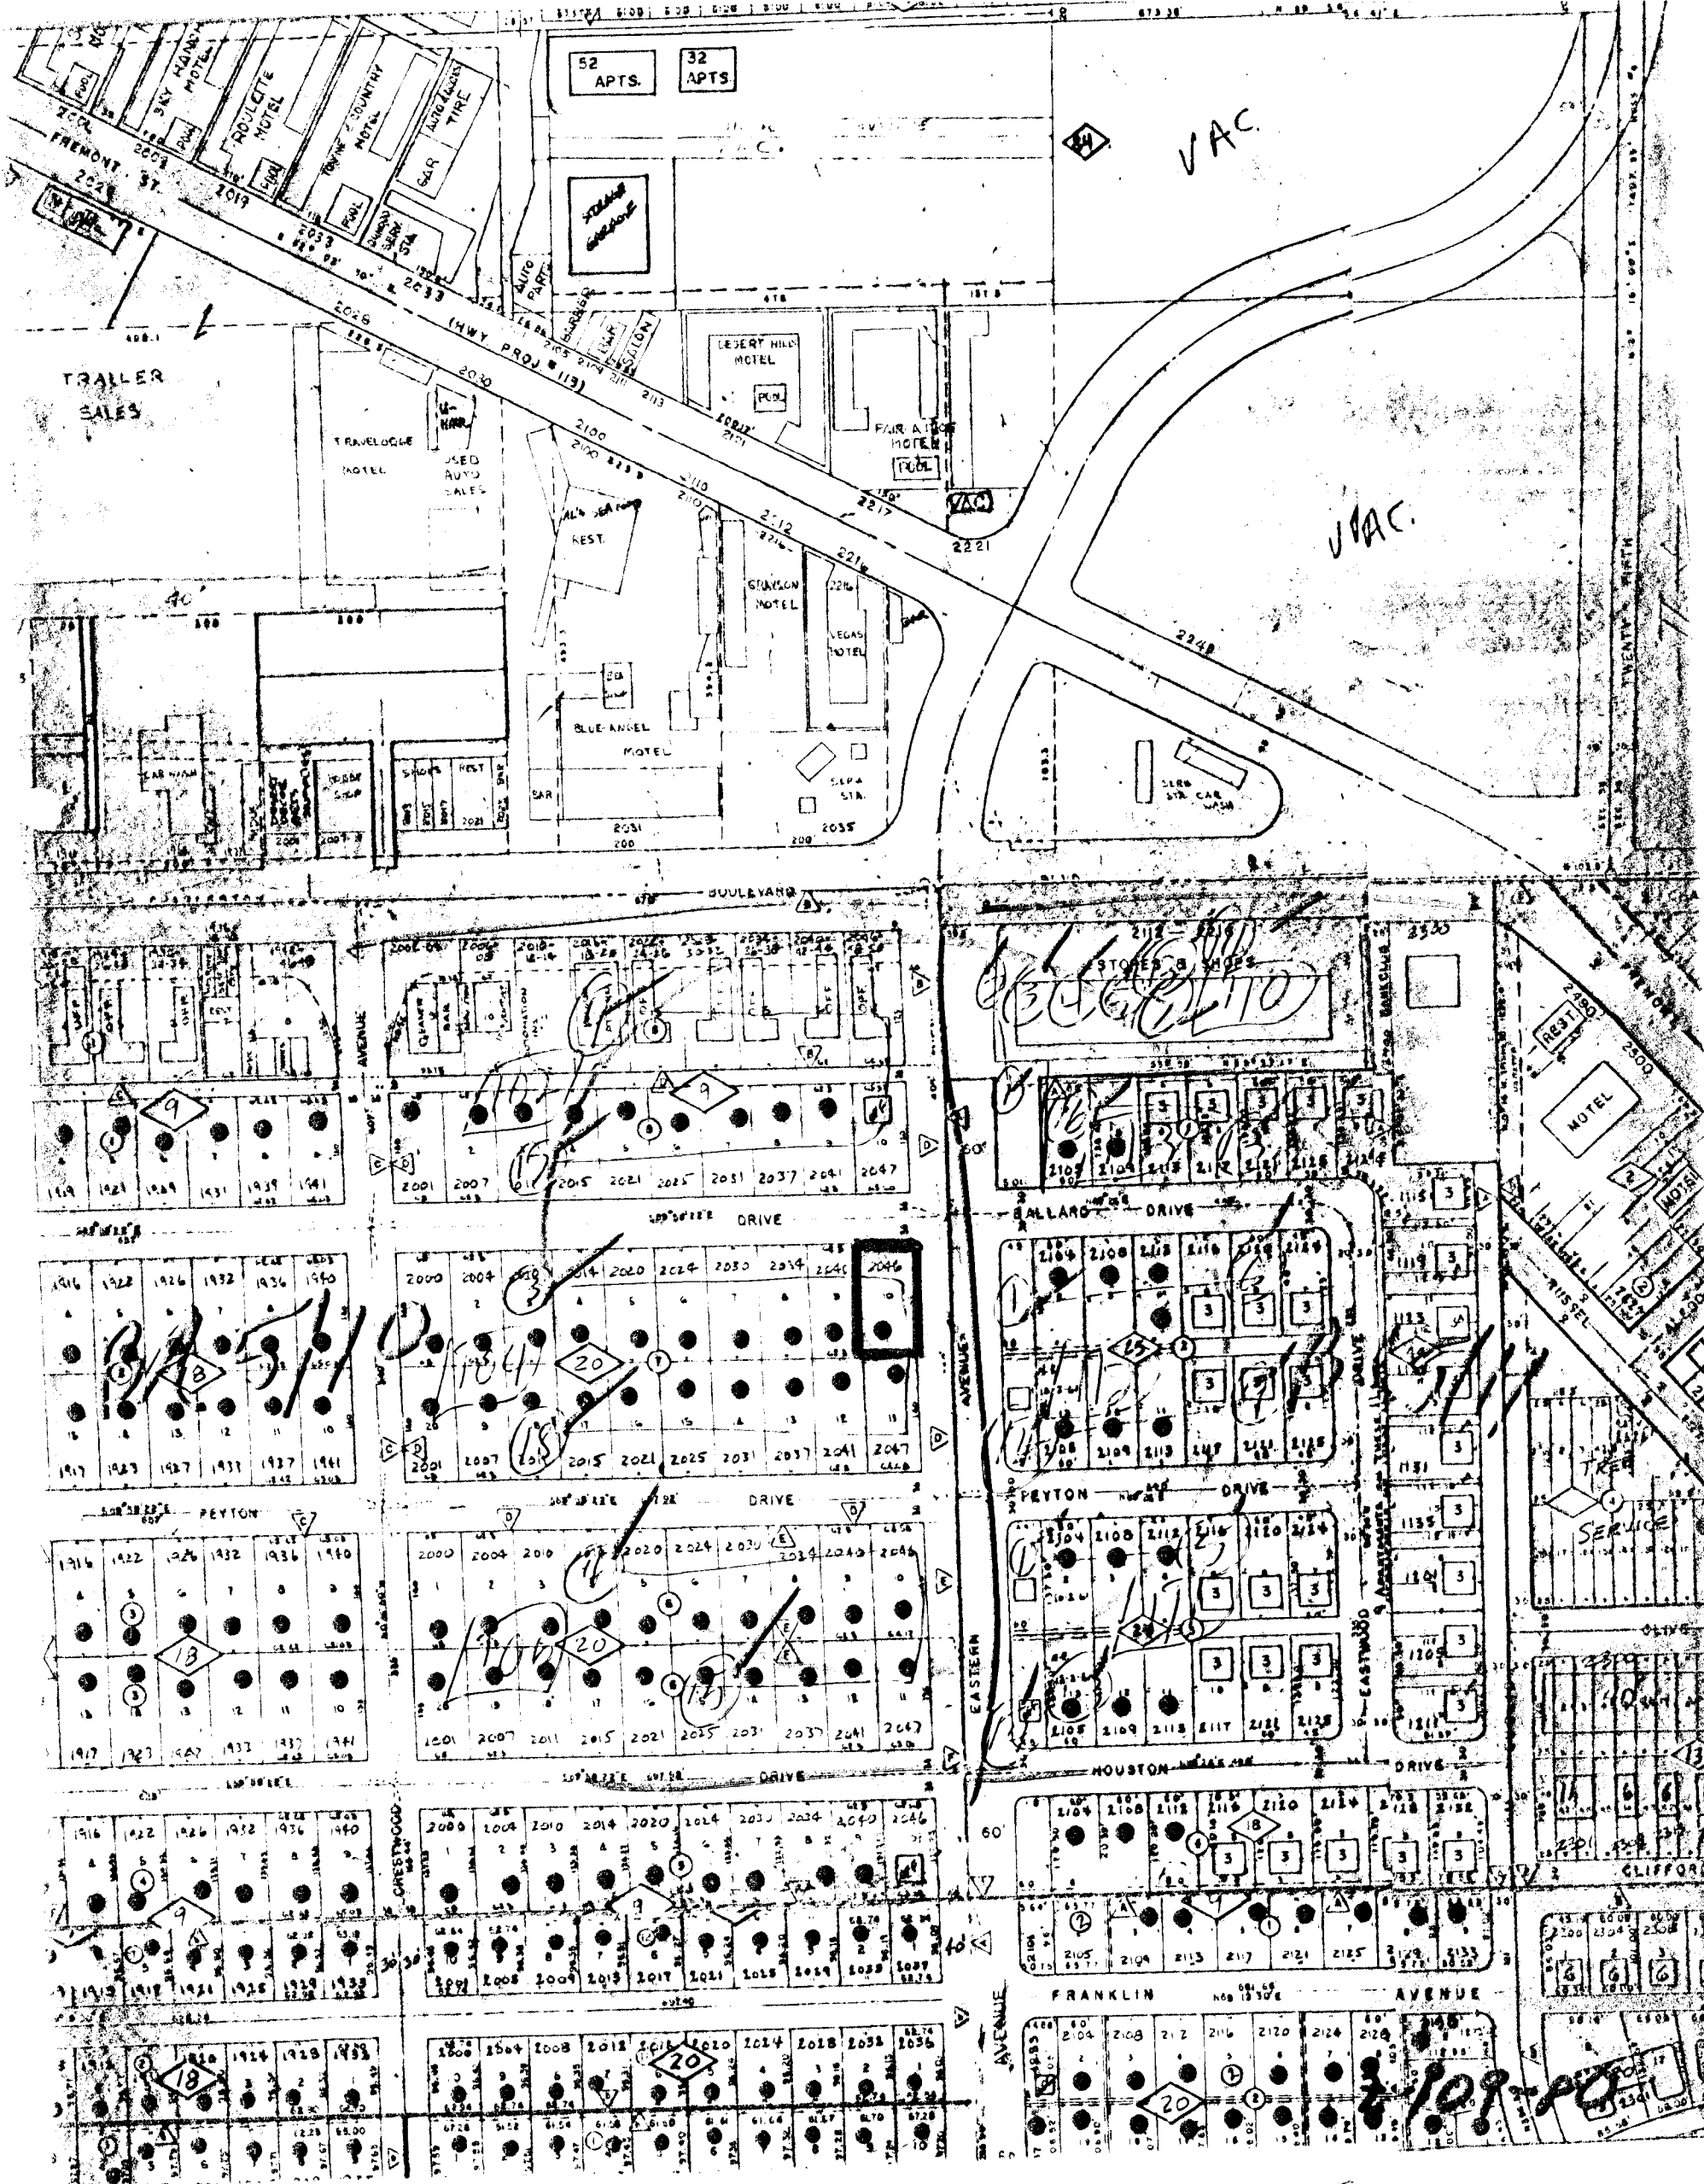

52 APTS. 32 APTS.

VAC.

VAC.

TRAILER SALES

TRAVELLOGE MOTEL

USED AUTO SALES

DESERT HILLS MOTEL

FAIR APTS. MOTEL

STANSON MOTEL

VEGAS MOTEL

BLUE ANGEL MOTEL

SLR CAR WASH

STOPS & SHOPS

MOTEL

SERVICE

CLIFFORD

FRANKLIN

AVENUE

109-PO