


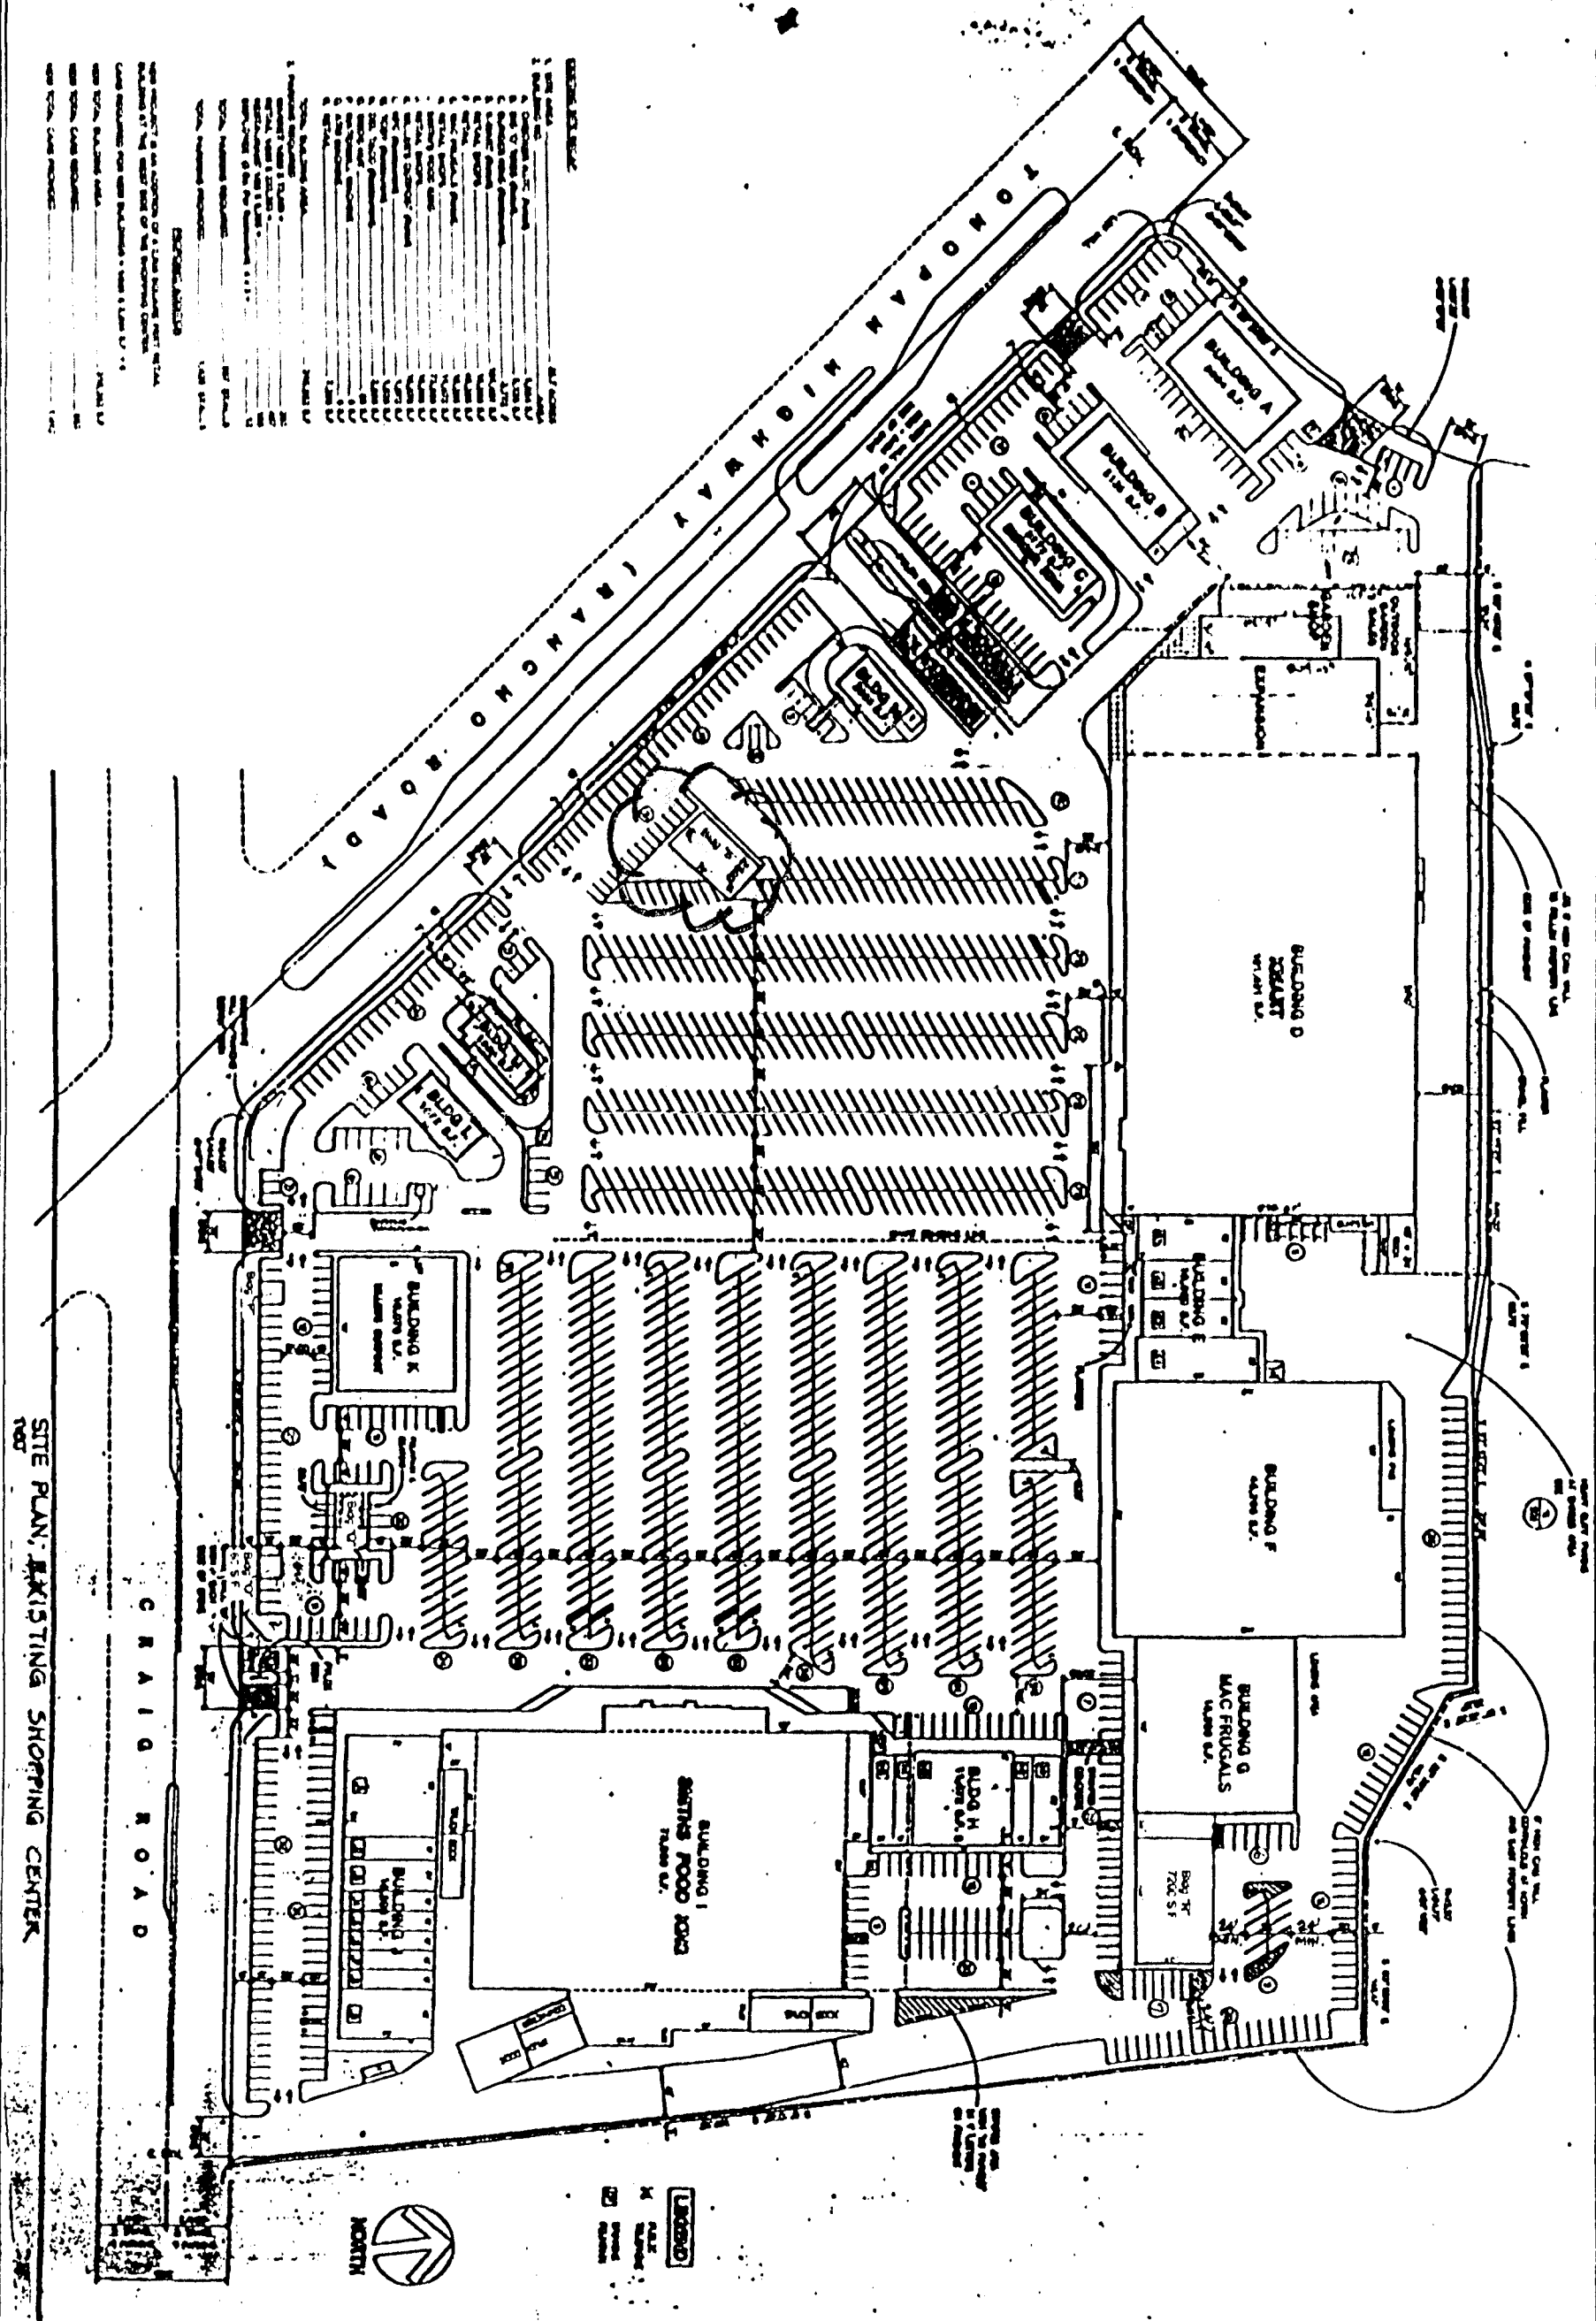

SITE PLAN, EXISTING SHOPPING CENTER

Z-109-88(2)
2-25-99 PC

STAFF

Project Title: RANCHO SIERRA CENTER EXPANSION	Sheet No. A-1	ABRAMS CONSTRUCTION COMPANY 16661 VENTURA BLVD. SUITE 408 ENCINO CA. 91436 TELEPHONE: 818. 986. 1455	NO.	DATE	REVISION
Project Title: SITE PLAN			DATE	JOB. NO.	PHASE
			1-31-91		
			OK. BY.		