


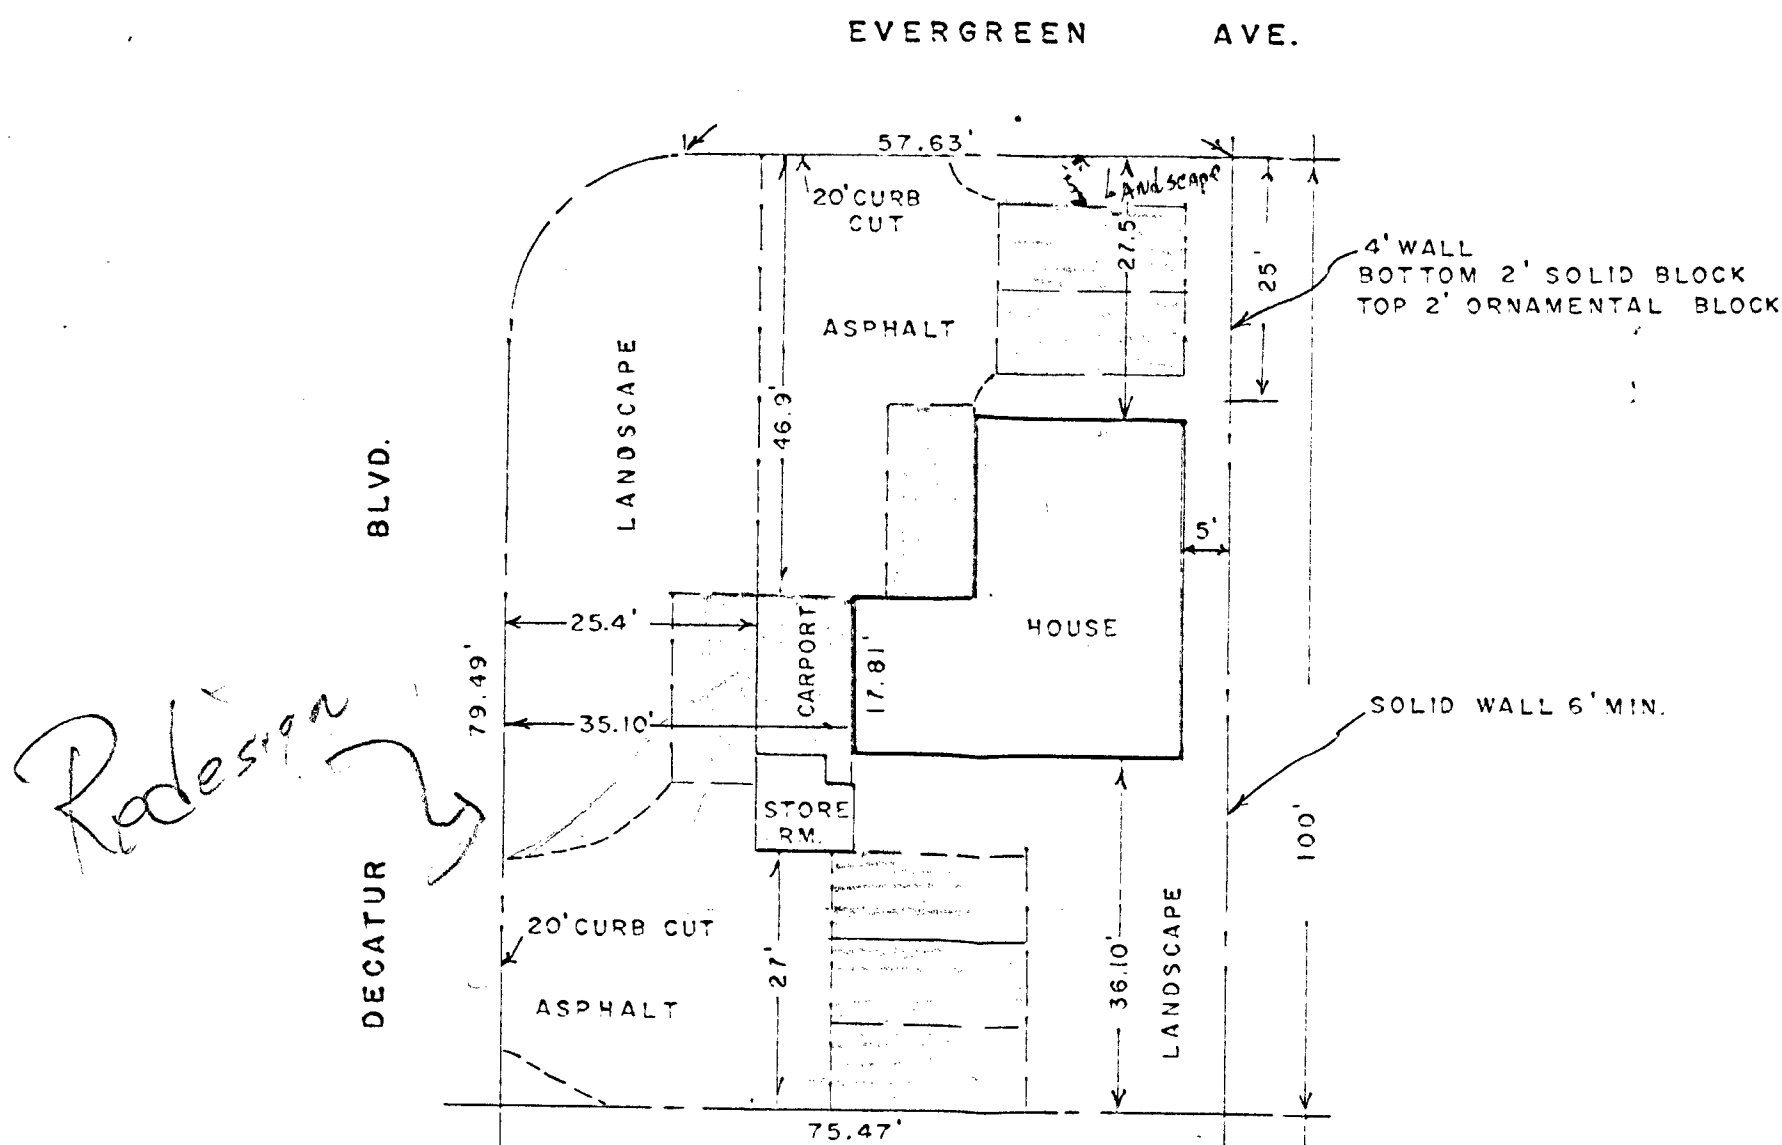


SCALE: 1" = 20'


DESCRIPTION:

LOT NO. 510 IN BLOCK 21 OF HYDE PARK SUBDIVISION NO.3, AS SHOWN BY MAP THEREOF ON FILE IN BOOK 3 OF PLATS PAGE 99 IN THE OFFICE OF THE CO. RECORDER OF CLARK CO., NEVADA.

LEGEND:

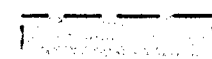 9' X 20' PARKING SPACE

PROPERTY LOCATED AT
4721 EVERGREEN PLACE, LAS VEGAS
NEVADA
ACCOMPANIED BY THE APPLICATION OF
CHARLES R. ANDERSON

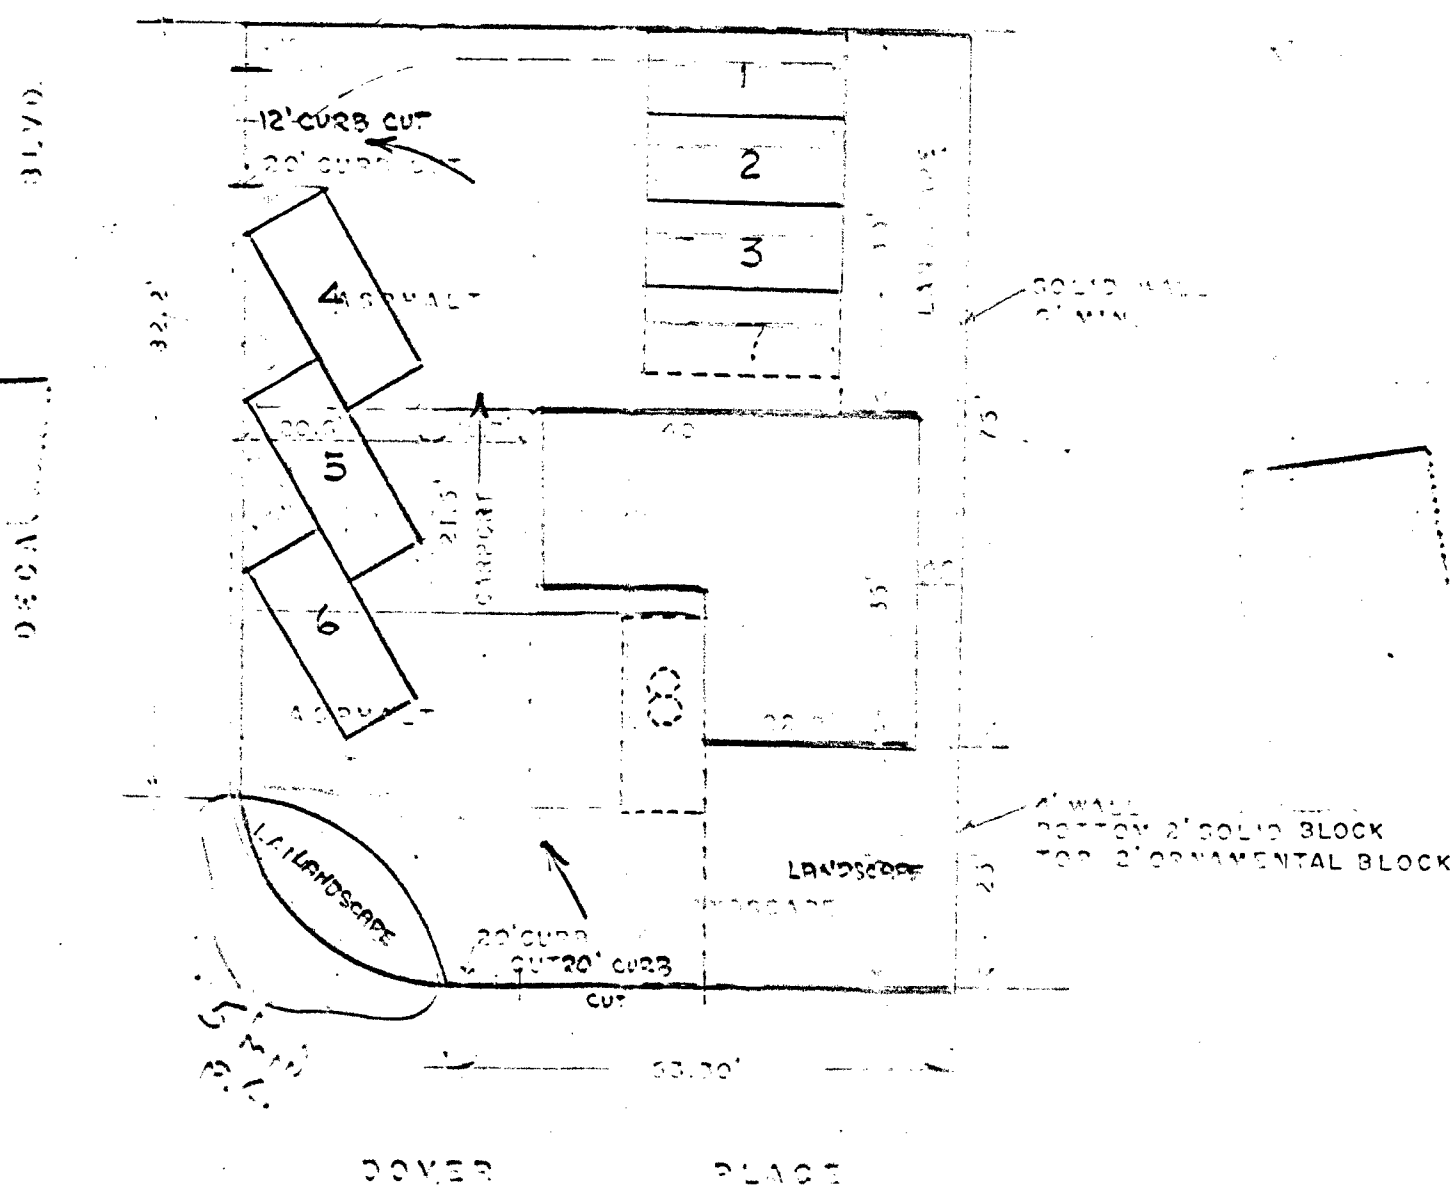

SCALE: 1" = 20'

DESCRIPTION:

LOT NO. 475 IN BLOCK 21 OF HYDE PARK SUBDIVISION NO.3, AS SHOWN BY MAP THEREOF ON FILE IN BOOK 3 OF PLATS PAGE 99 IN THE OFFICE OF THE CO. RECORDER OF CLARK CO., NEVADA.

LEGEND:

 9' X 20' PARKING SPACE

PROPERTY LOCATED AT
4724 DOVER PLACE, LAS VEGAS
NEVADA
ACCOMPANIED BY THE APPLICATION OF
JEANNE SCOTT