


BLVD.
DECATUR

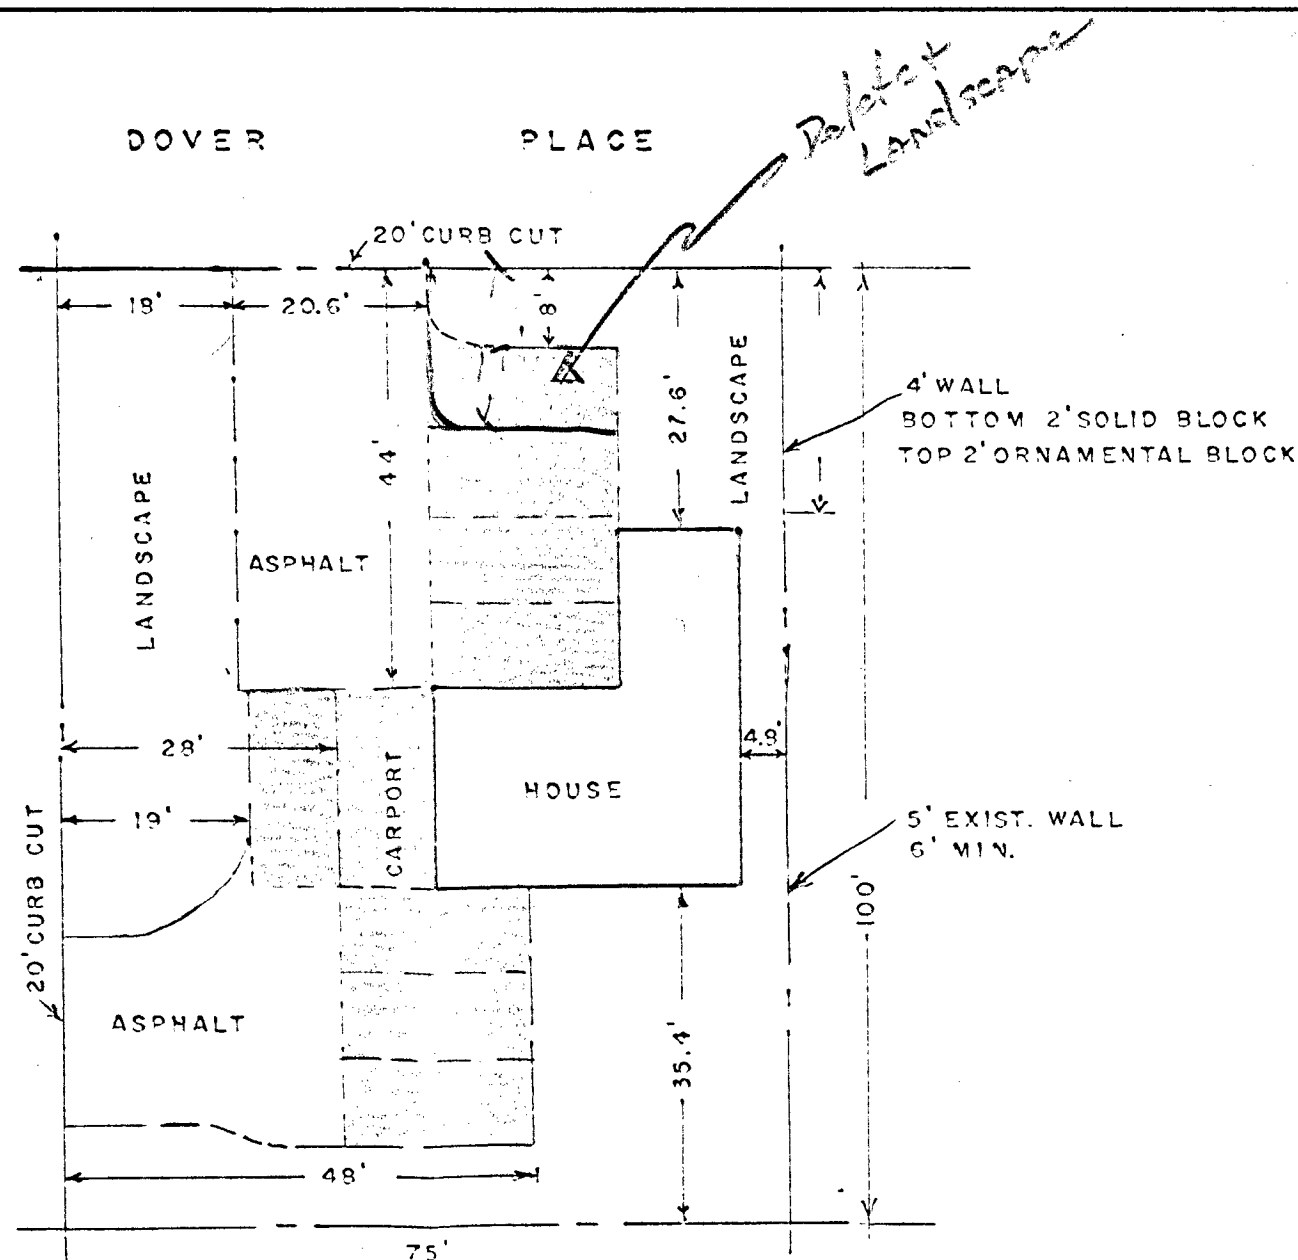


SCALE: 1" = 20'

DESCRIPTION:


LOT NO. 474 IN BLOCK 20 OF HYDE PARK SUBDIVISION NO. 3, AS SHOWN BY MAP THEREOF ON FILE IN BOOK 3 OF PLATS PAGE 99 IN THE OFFICE OF THE CO. RECORDER OF CLARK CO., NEVADA.

LEGEND:

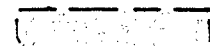 9' X 20' PARKING SPACE

PROPERTY LOCATED AT
4721 DOVER PLACE, LAS VEGAS
NEVADA
ACCOMPANIED BY THE APPLICATION OF
JAMES & HELEN WATTS

DECATUR
BLVD.

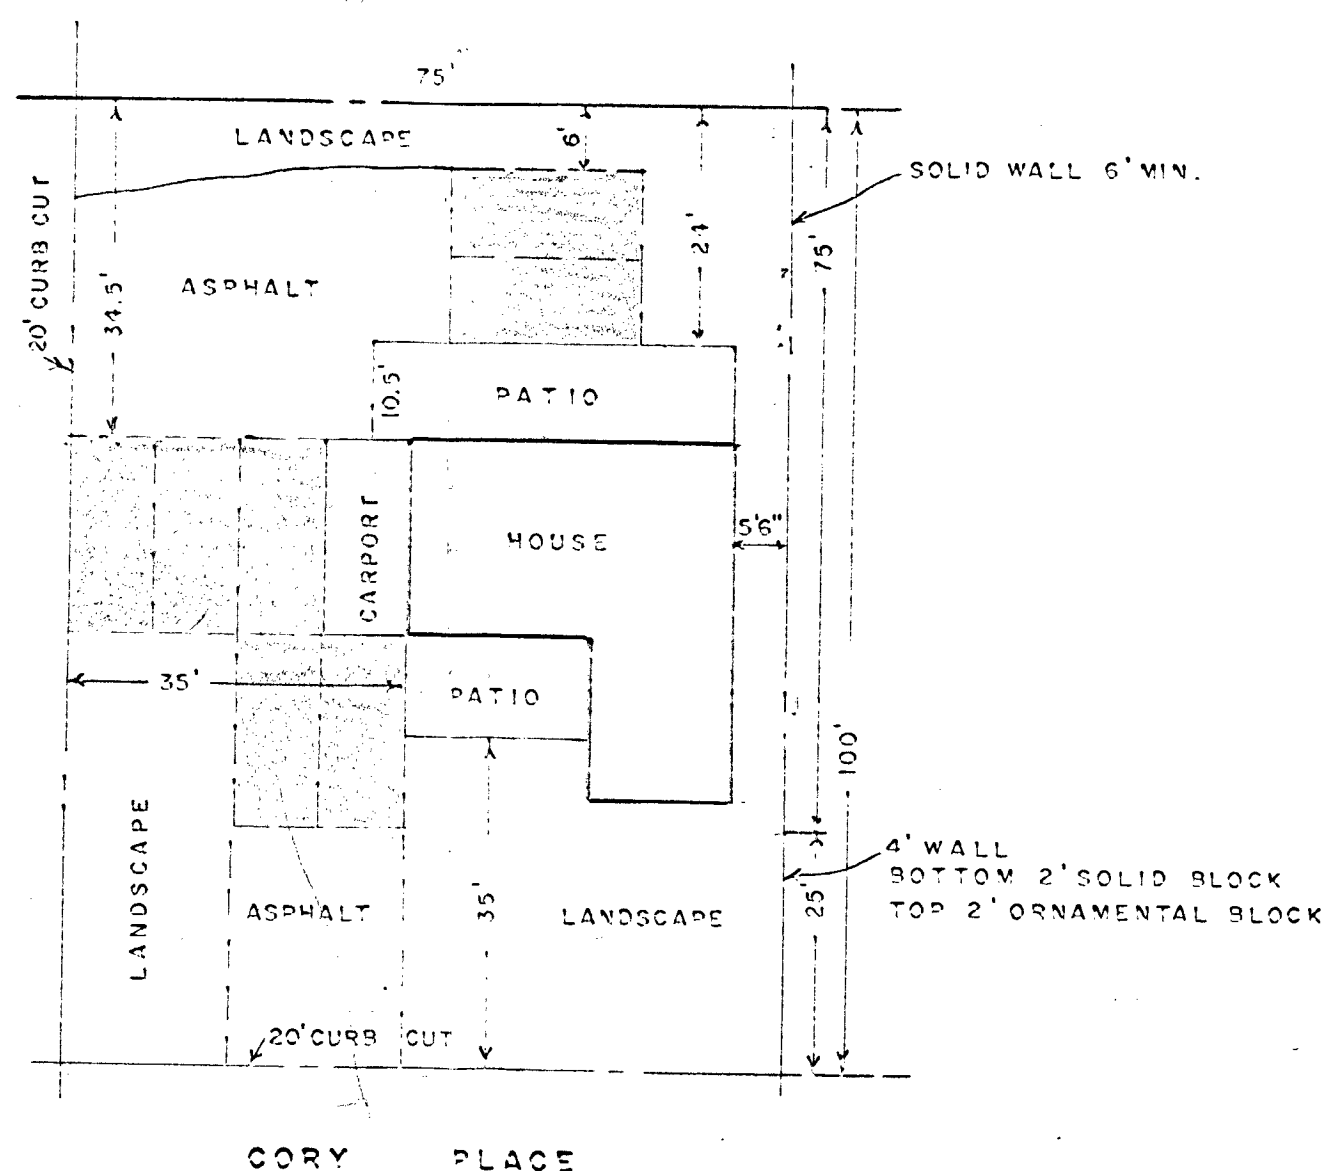


SCALE: 1" = 20'


DESCRIPTION:

LOT NO. 450 IN BLOCK 20 OF HYDE PARK SUBDIVISION NO. 3, AS SHOWN BY MAP THEREOF ON FILE IN BOOK 3 OF PLATS PAGE 99 IN THE OFFICE OF THE COUNTY RECORDER OF CLARK COUNTY, NEVADA.

LEGEND:

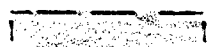 9' X 20' PARKING SPACE

PROPERTY LOCATED AT
4724 CORY PLACE, LAS VEGAS
NEVADA
ACCOMPANIED BY THE APPLICATION OF
WILLIAM S. SMITH

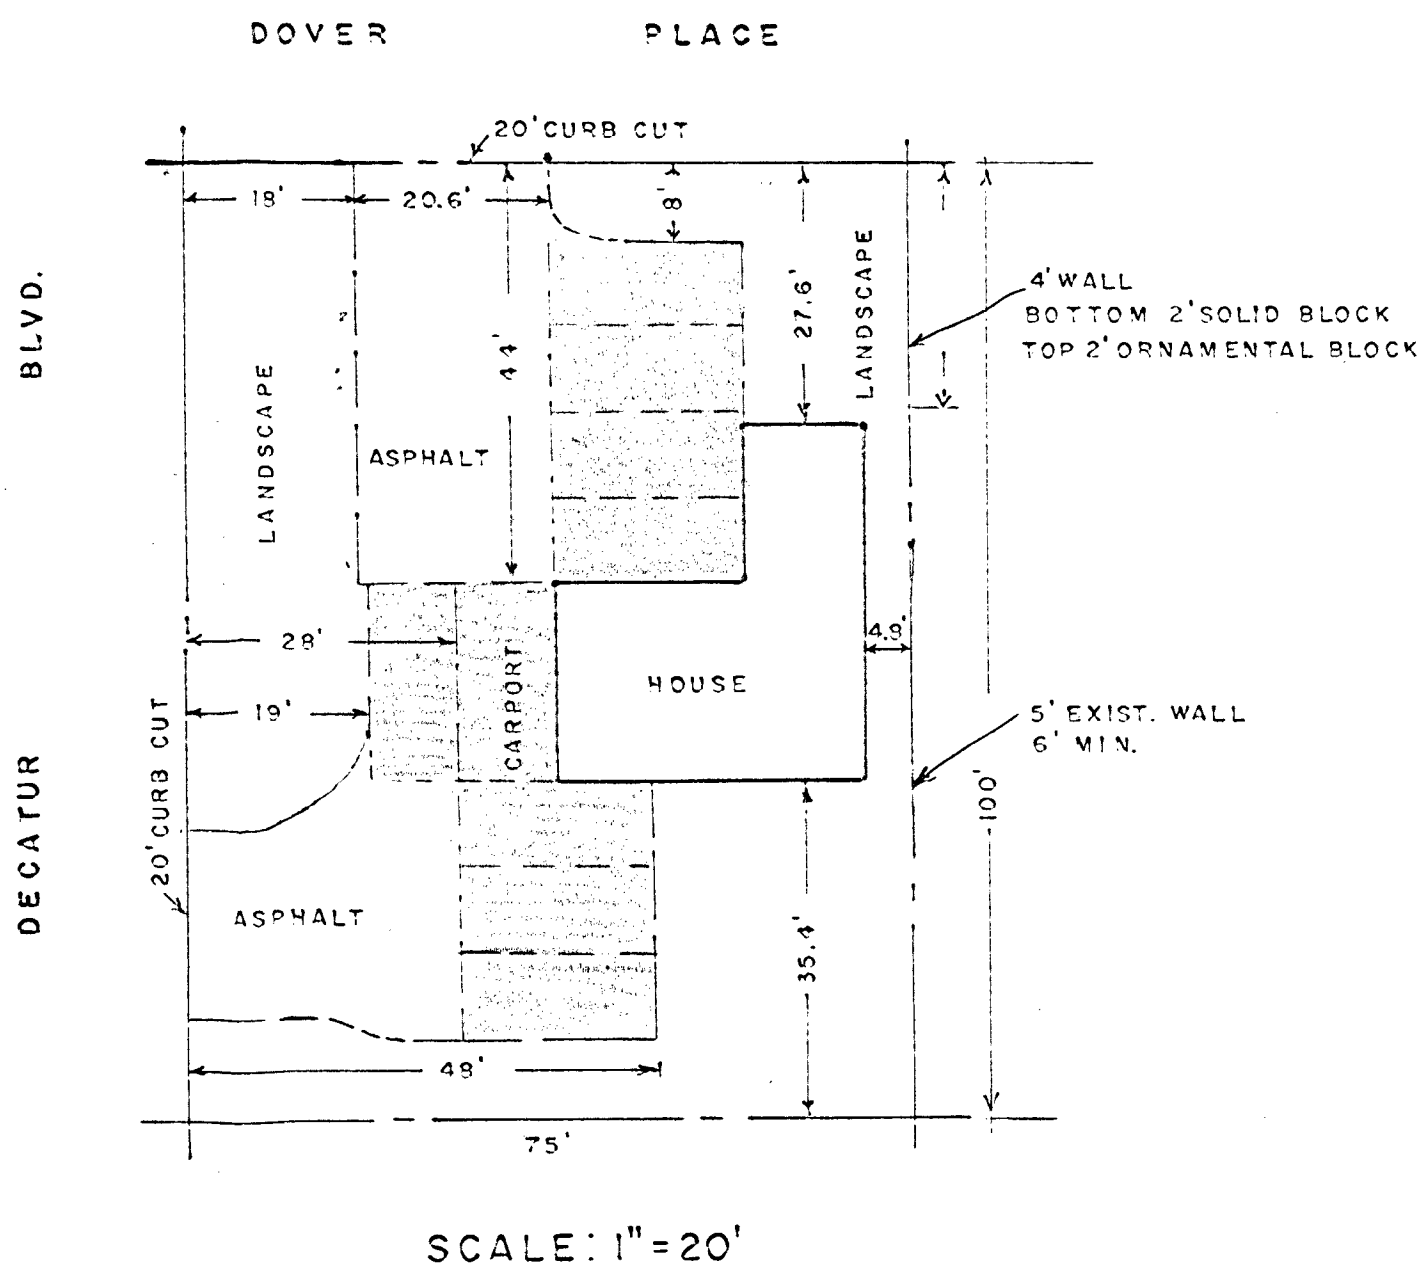


DESCRIPTION:

LOT NO. 474 IN BLOCK 20 OF HYDE PARK SUBDIVISION NO.3, AS SHOWN BY MAP THEREOF ON FILE IN BOOK 3 OF PLATS PAGE 99 IN THE OFFICE OF THE CO. RECORDER OF CLARK CO., NEVADA.

LEGEND:

 9'X 20' PARKING SPACE


PROPERTY LOCATED AT
4721 DOVER PLACE, LAS VEGAS
NEVADA
ACCOMPANIED BY THE APPLICATION OF
JAMES & HELEN WATTS

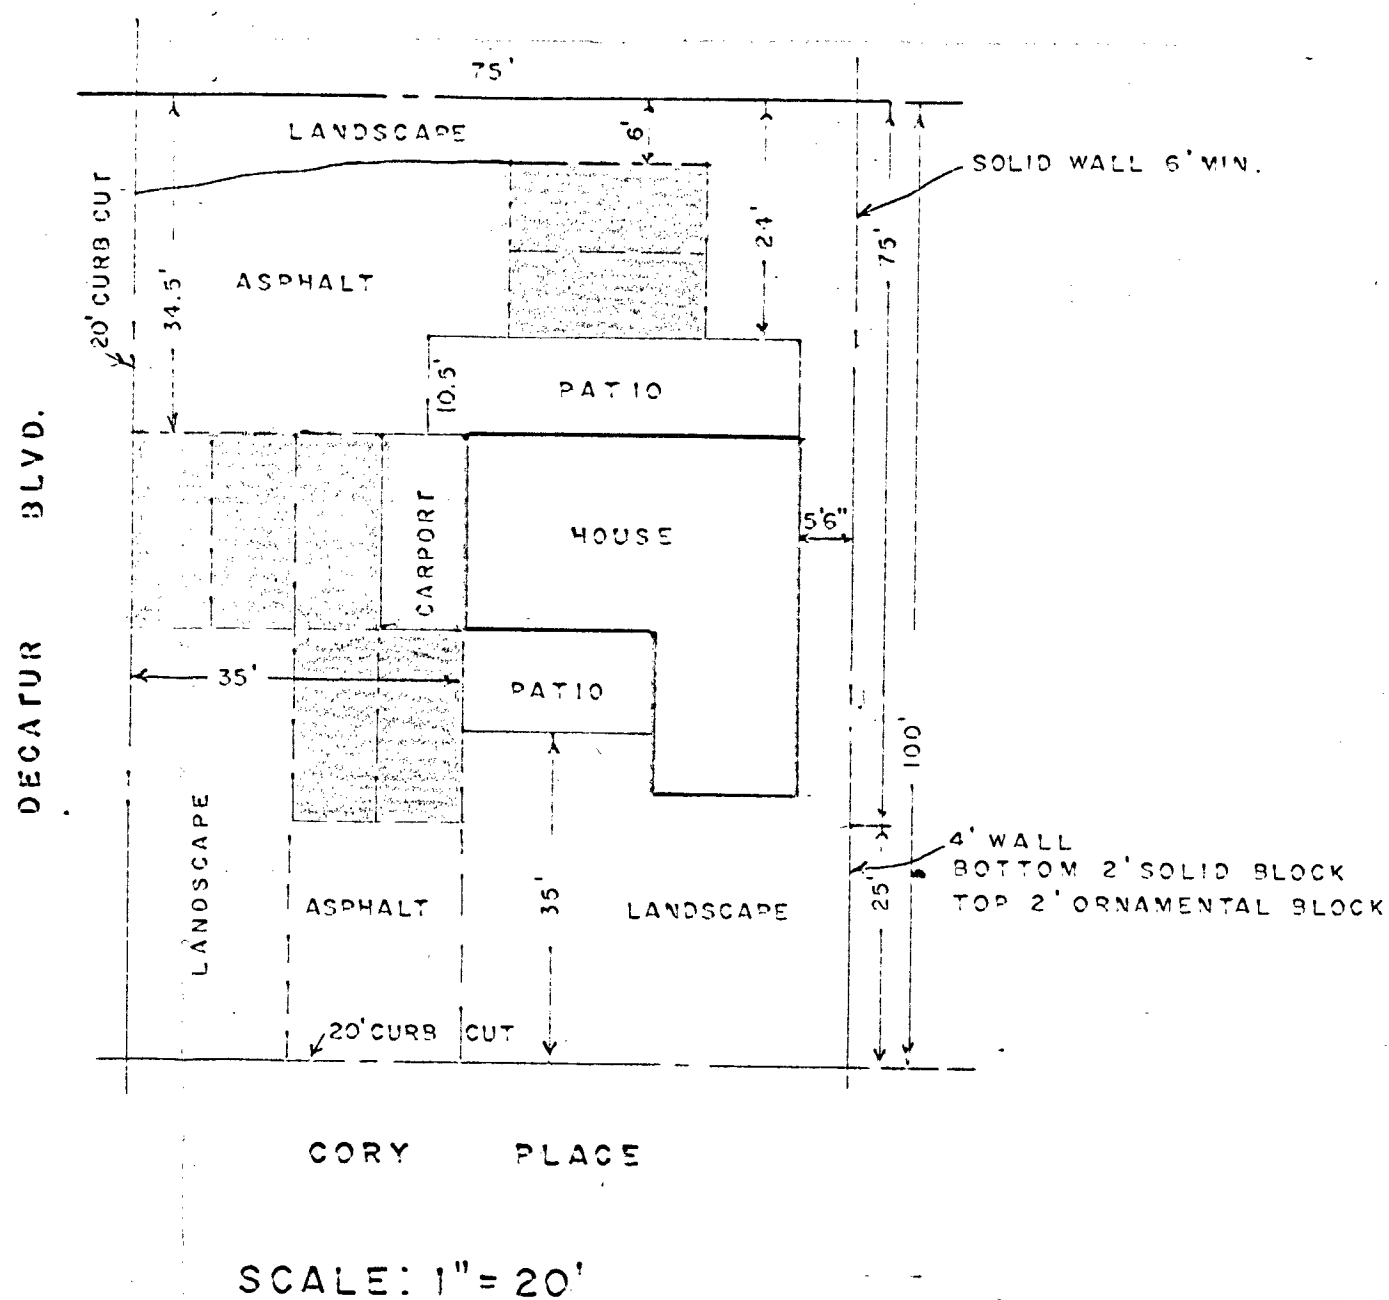

DESCRIPTION:

LOT NO. 450 IN BLOCK 20 OF HYDE PARK SUBDIVISION NO.3, AS SHOWN BY MAP THEREOF ON FILE IN BOOK 3 OF PLATS PAGE 99 IN THE OFFICE OF THE COUNTY RECORDER OF CLARK COUNTY, NEVADA.

LEGEND:

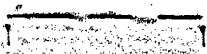 9'X 20' PARKING SPACE

PROPERTY LOCATED AT
4724 CORY PLACE, LAS VEGAS
NEVADA
ACCOMPANIED BY THE APPLICATION OF
WILLIAM S. SMITH