


COUNTY

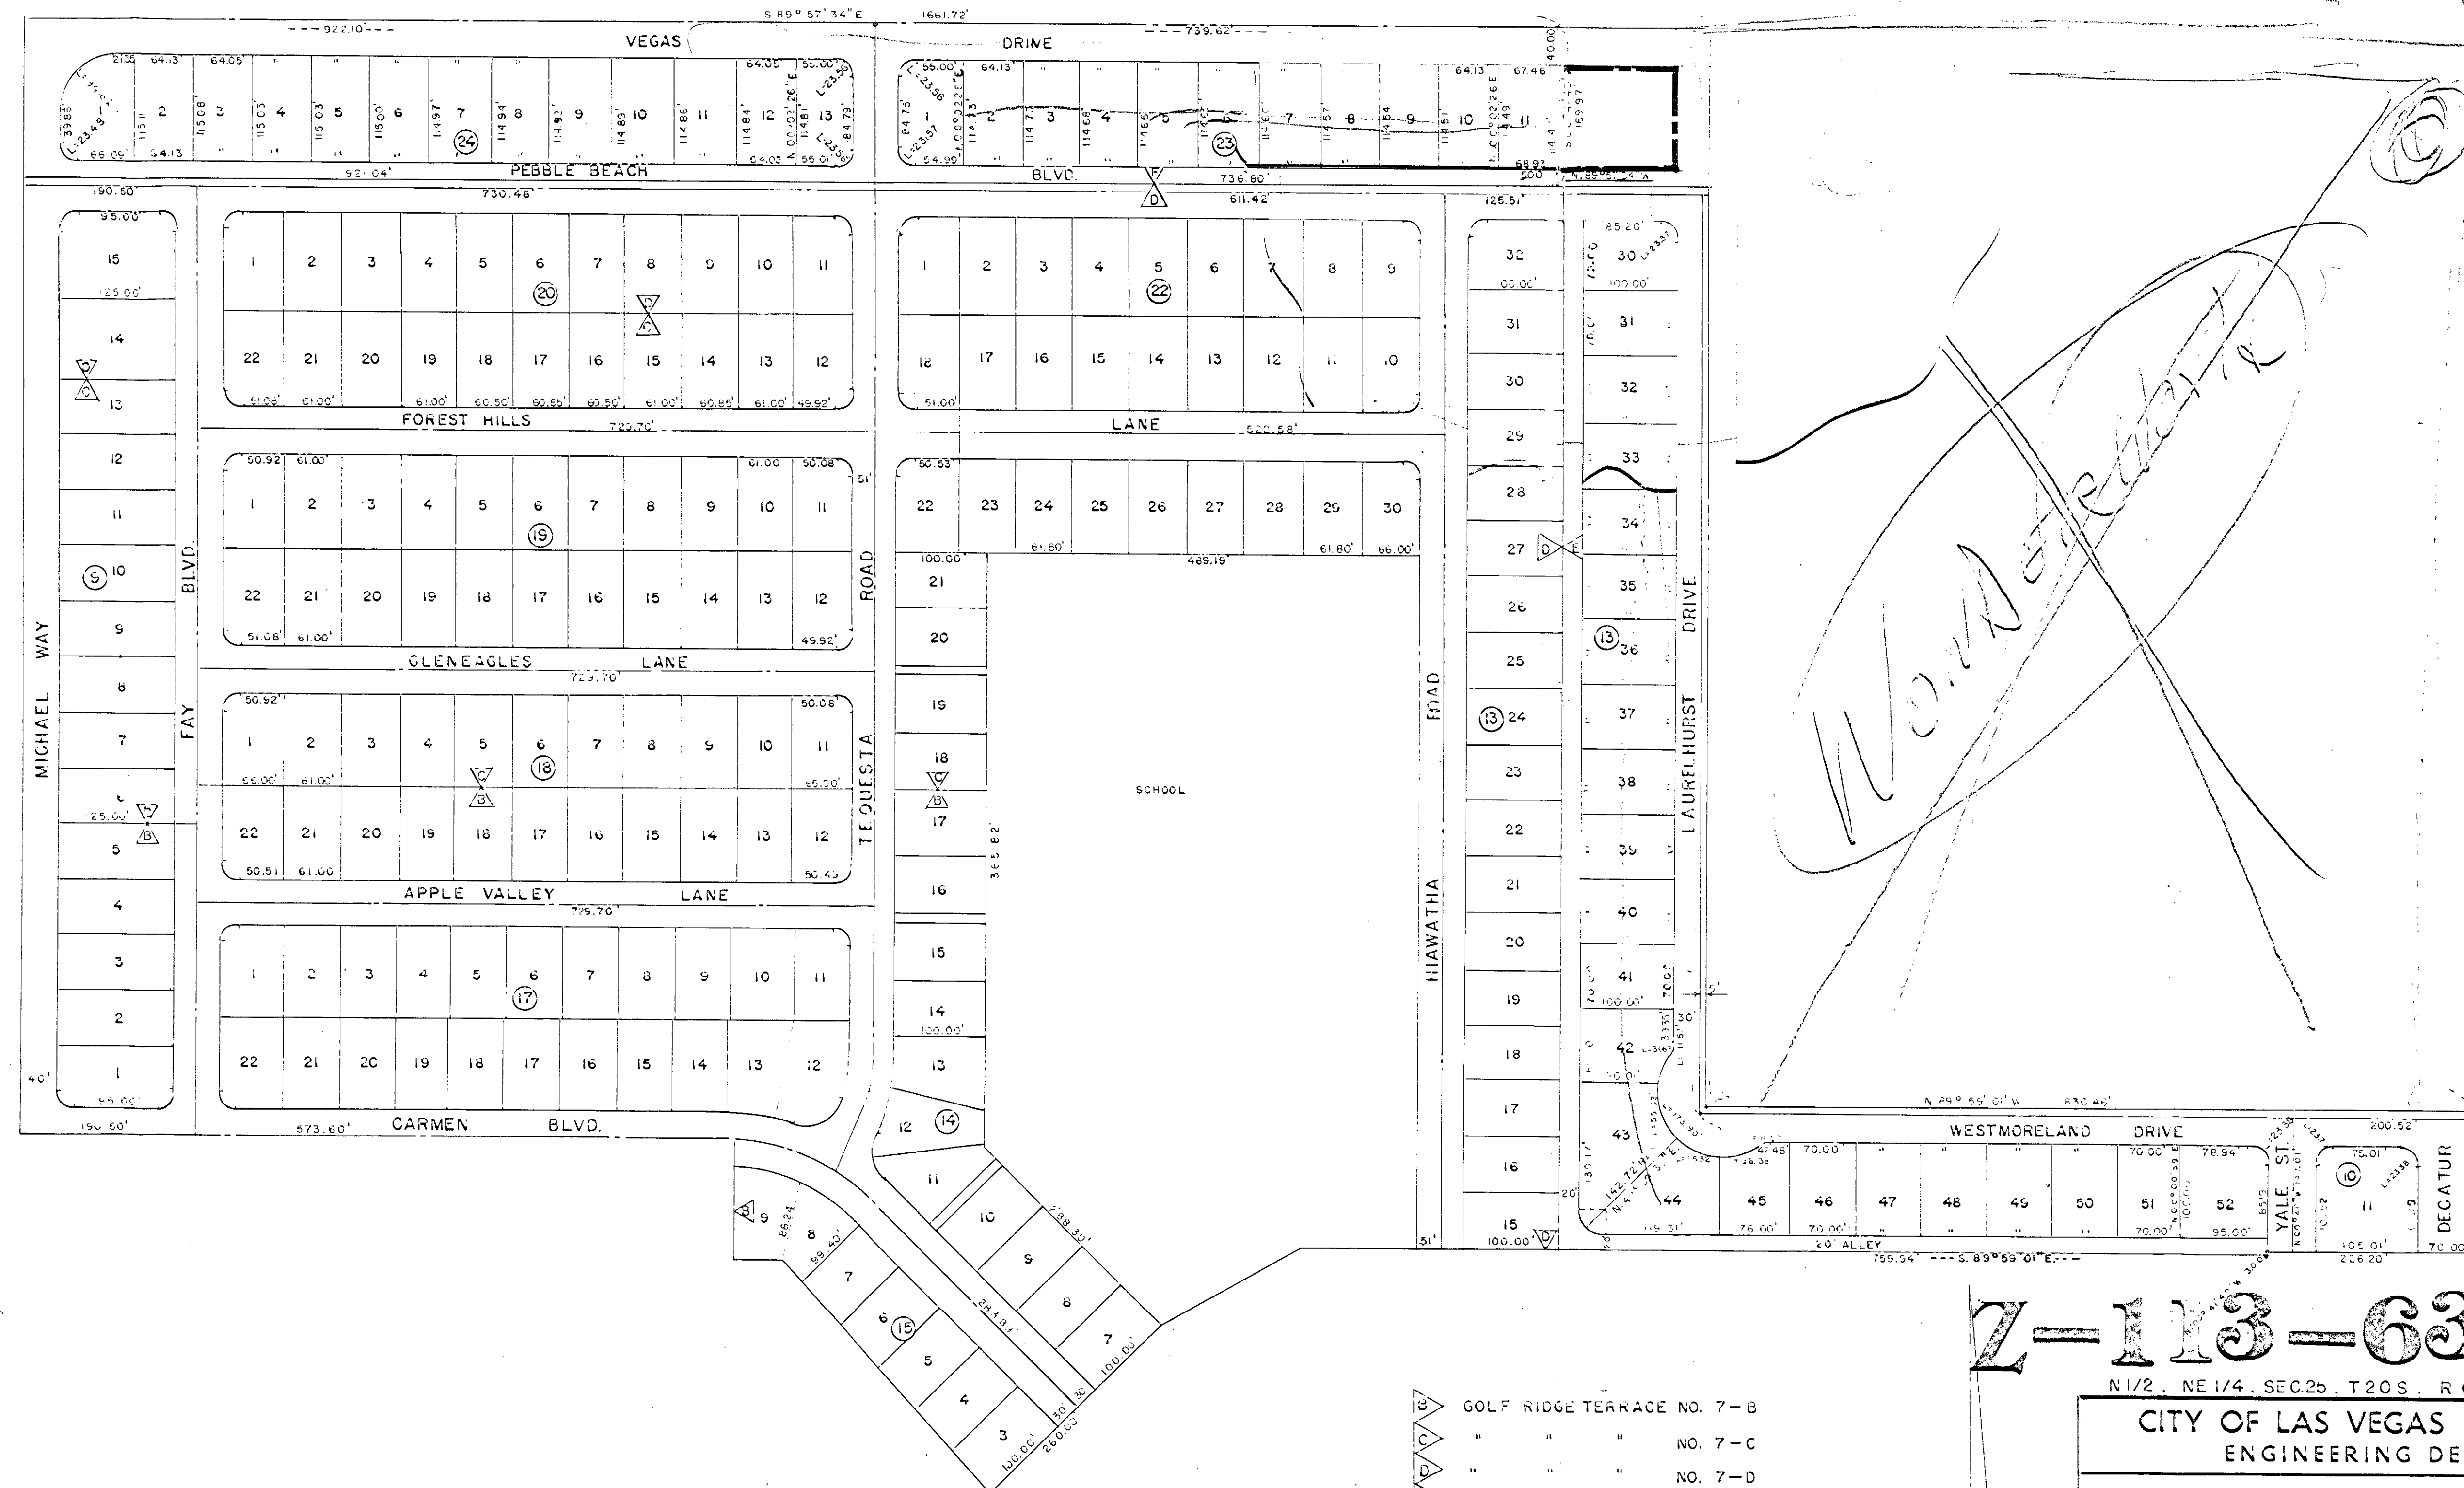

- GOLF RIDGE TERRACE NO. 7-B
- " " " NO. 7-C
- " " " NO. 7-D
- " " " NO. 7-E
- " " " NO. 7-F


Z-113-63

N 1/2, NE 1/4, SEC. 25, T. 20 S., R. 60 E.


CITY OF LAS VEGAS NEVADA
ENGINEERING DEPT.

DISTRICT MAP SHEET NO. 169

DESIGNED BY	DATE	SCALE	1" = 100'
DRAWN BY L. HARPER	4-6-62	FIELD BOOK NO.	
CHECKED BY		WORK ORDER NO.	
APPROVED		DRAWING NO.	Z-113-63
CITY ENGR.			

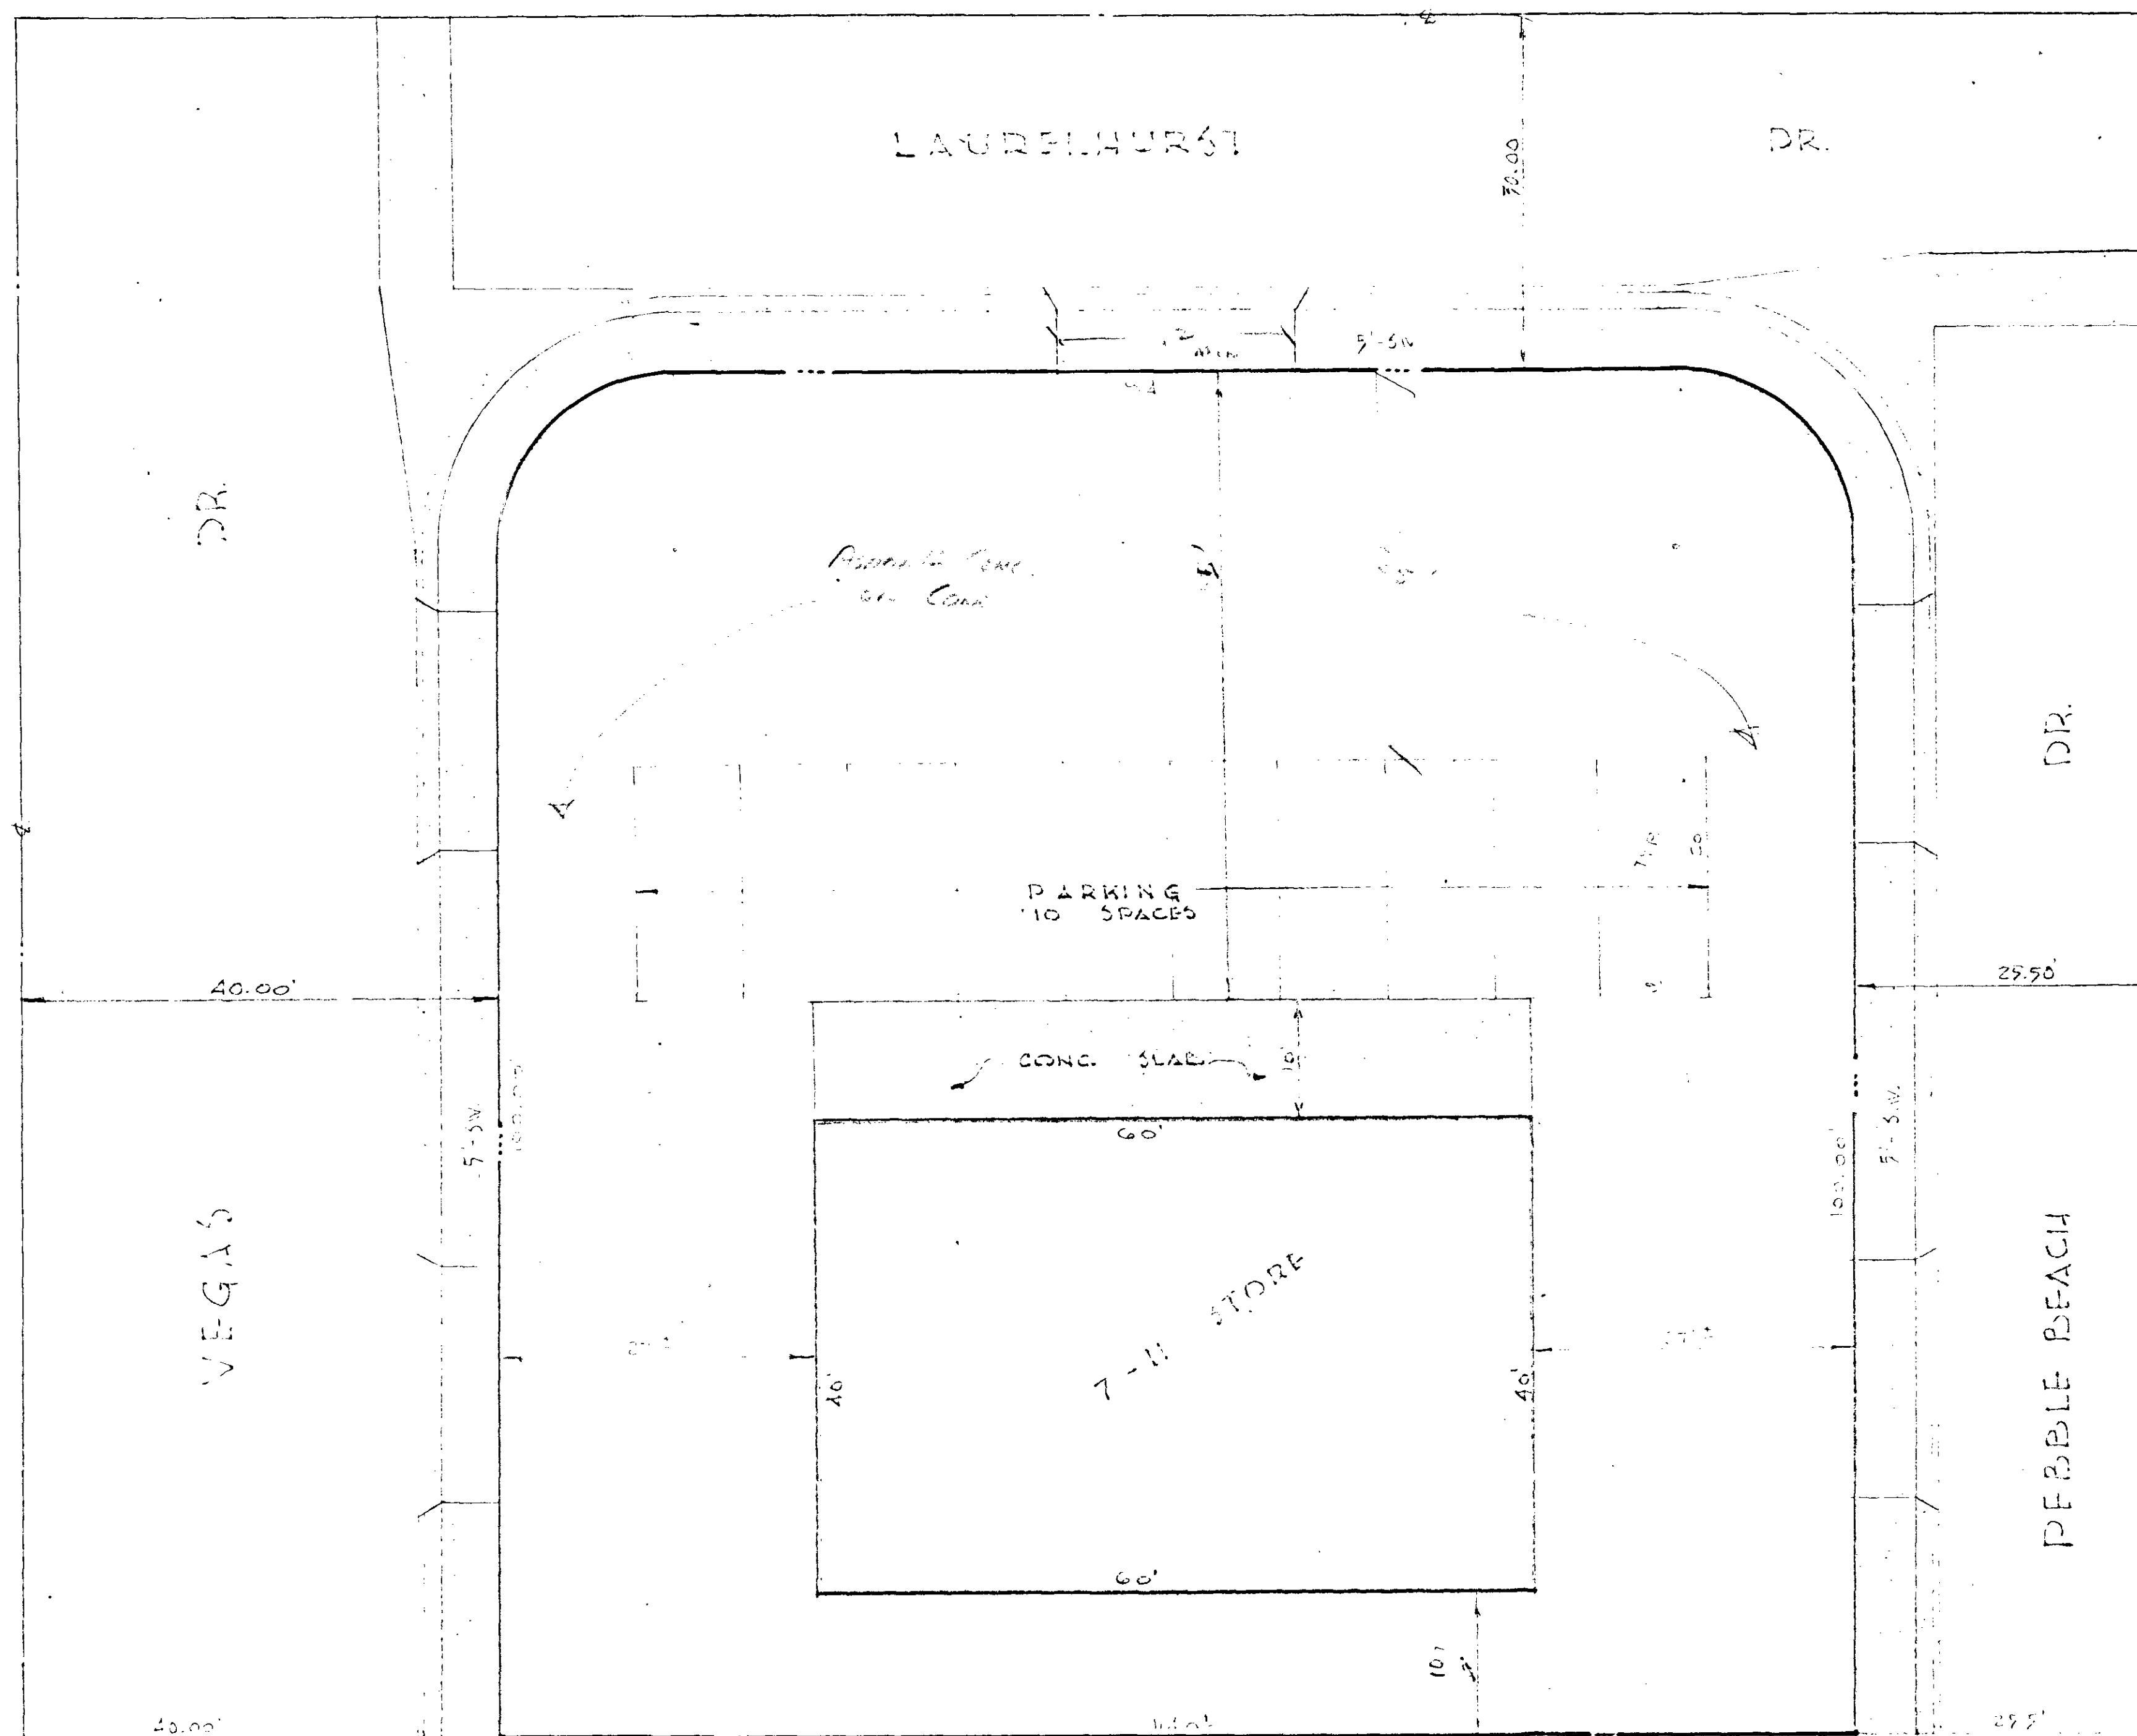

P L O T P L A N I - H S T O R E

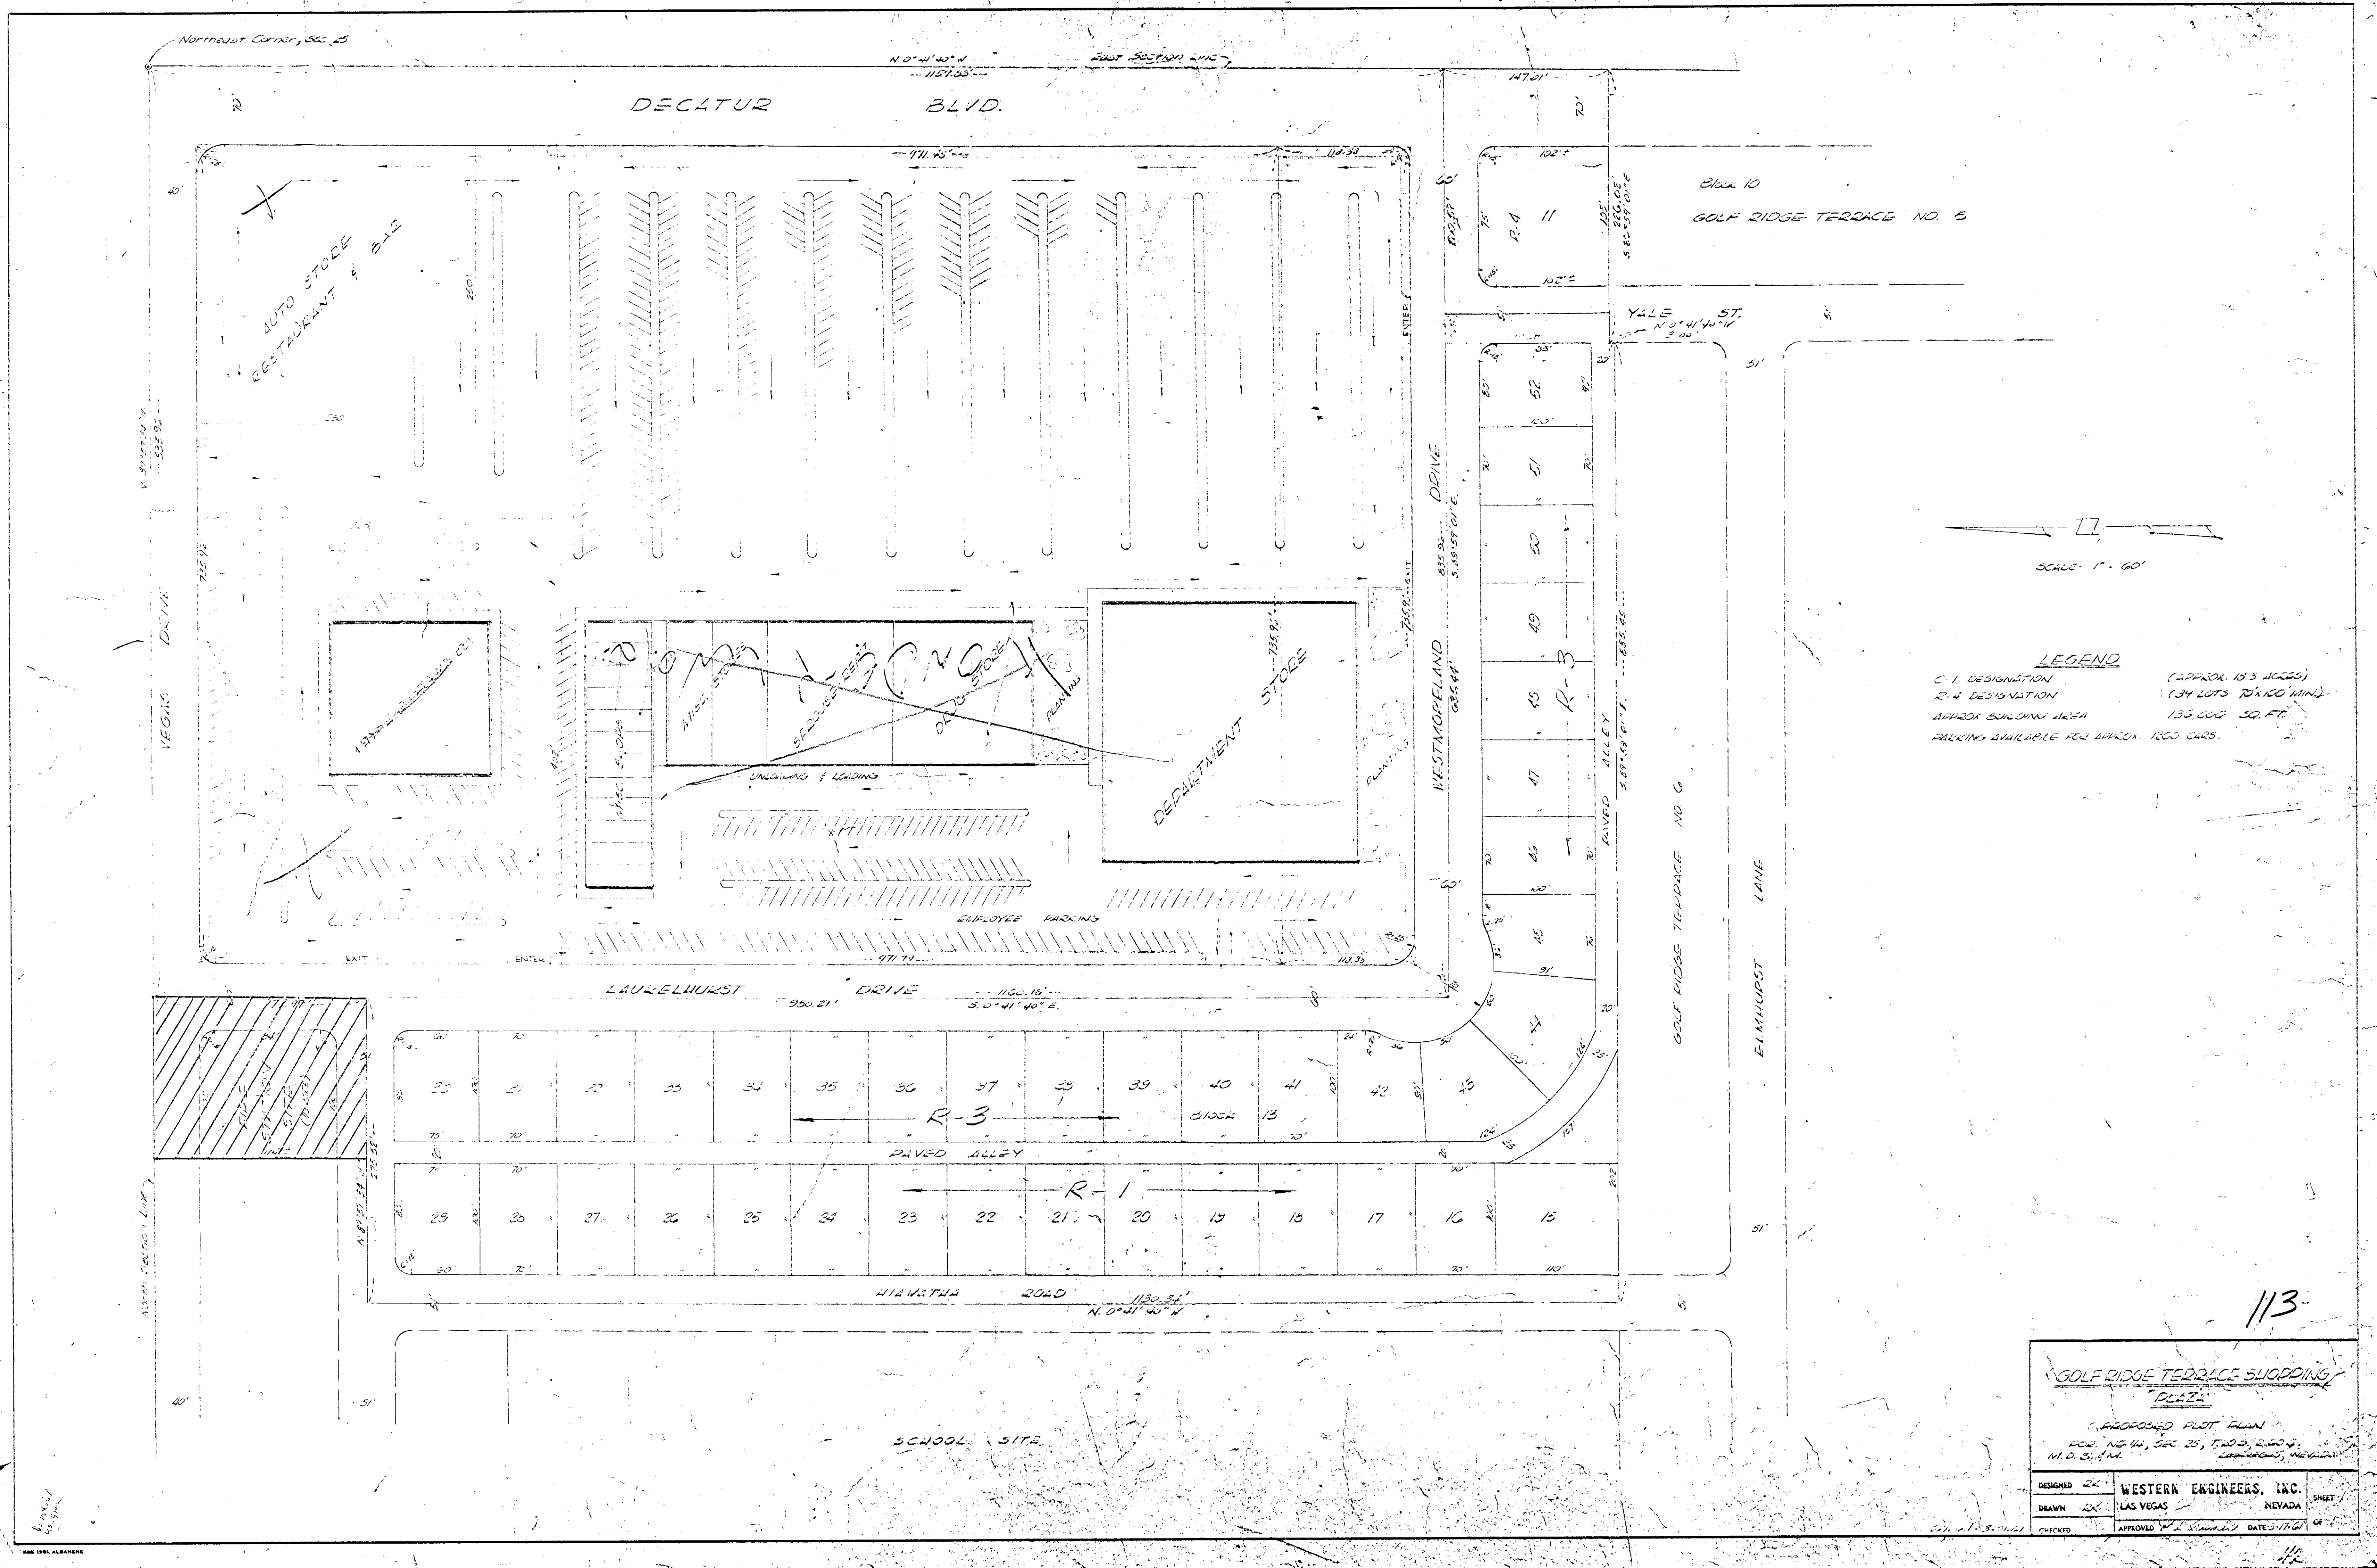

SCALE: 1" = 60'

LEGEND
C-1 DESIGNATION (APPROX. 18.3 ACRES)
R-4 DESIGNATION (34 LOTS 70'X100' MIN.)
APPROX. BUILDING AREA 135,000 SQ. FT.
PARKING AVAILABLE FOR APPROX. 1000 CARS.

GOLF RIDGE TERRACE SHOPPING PLAZA			
DESIGNED BY	WESTERN ENGINEERS, INC.	SHEET	113
