


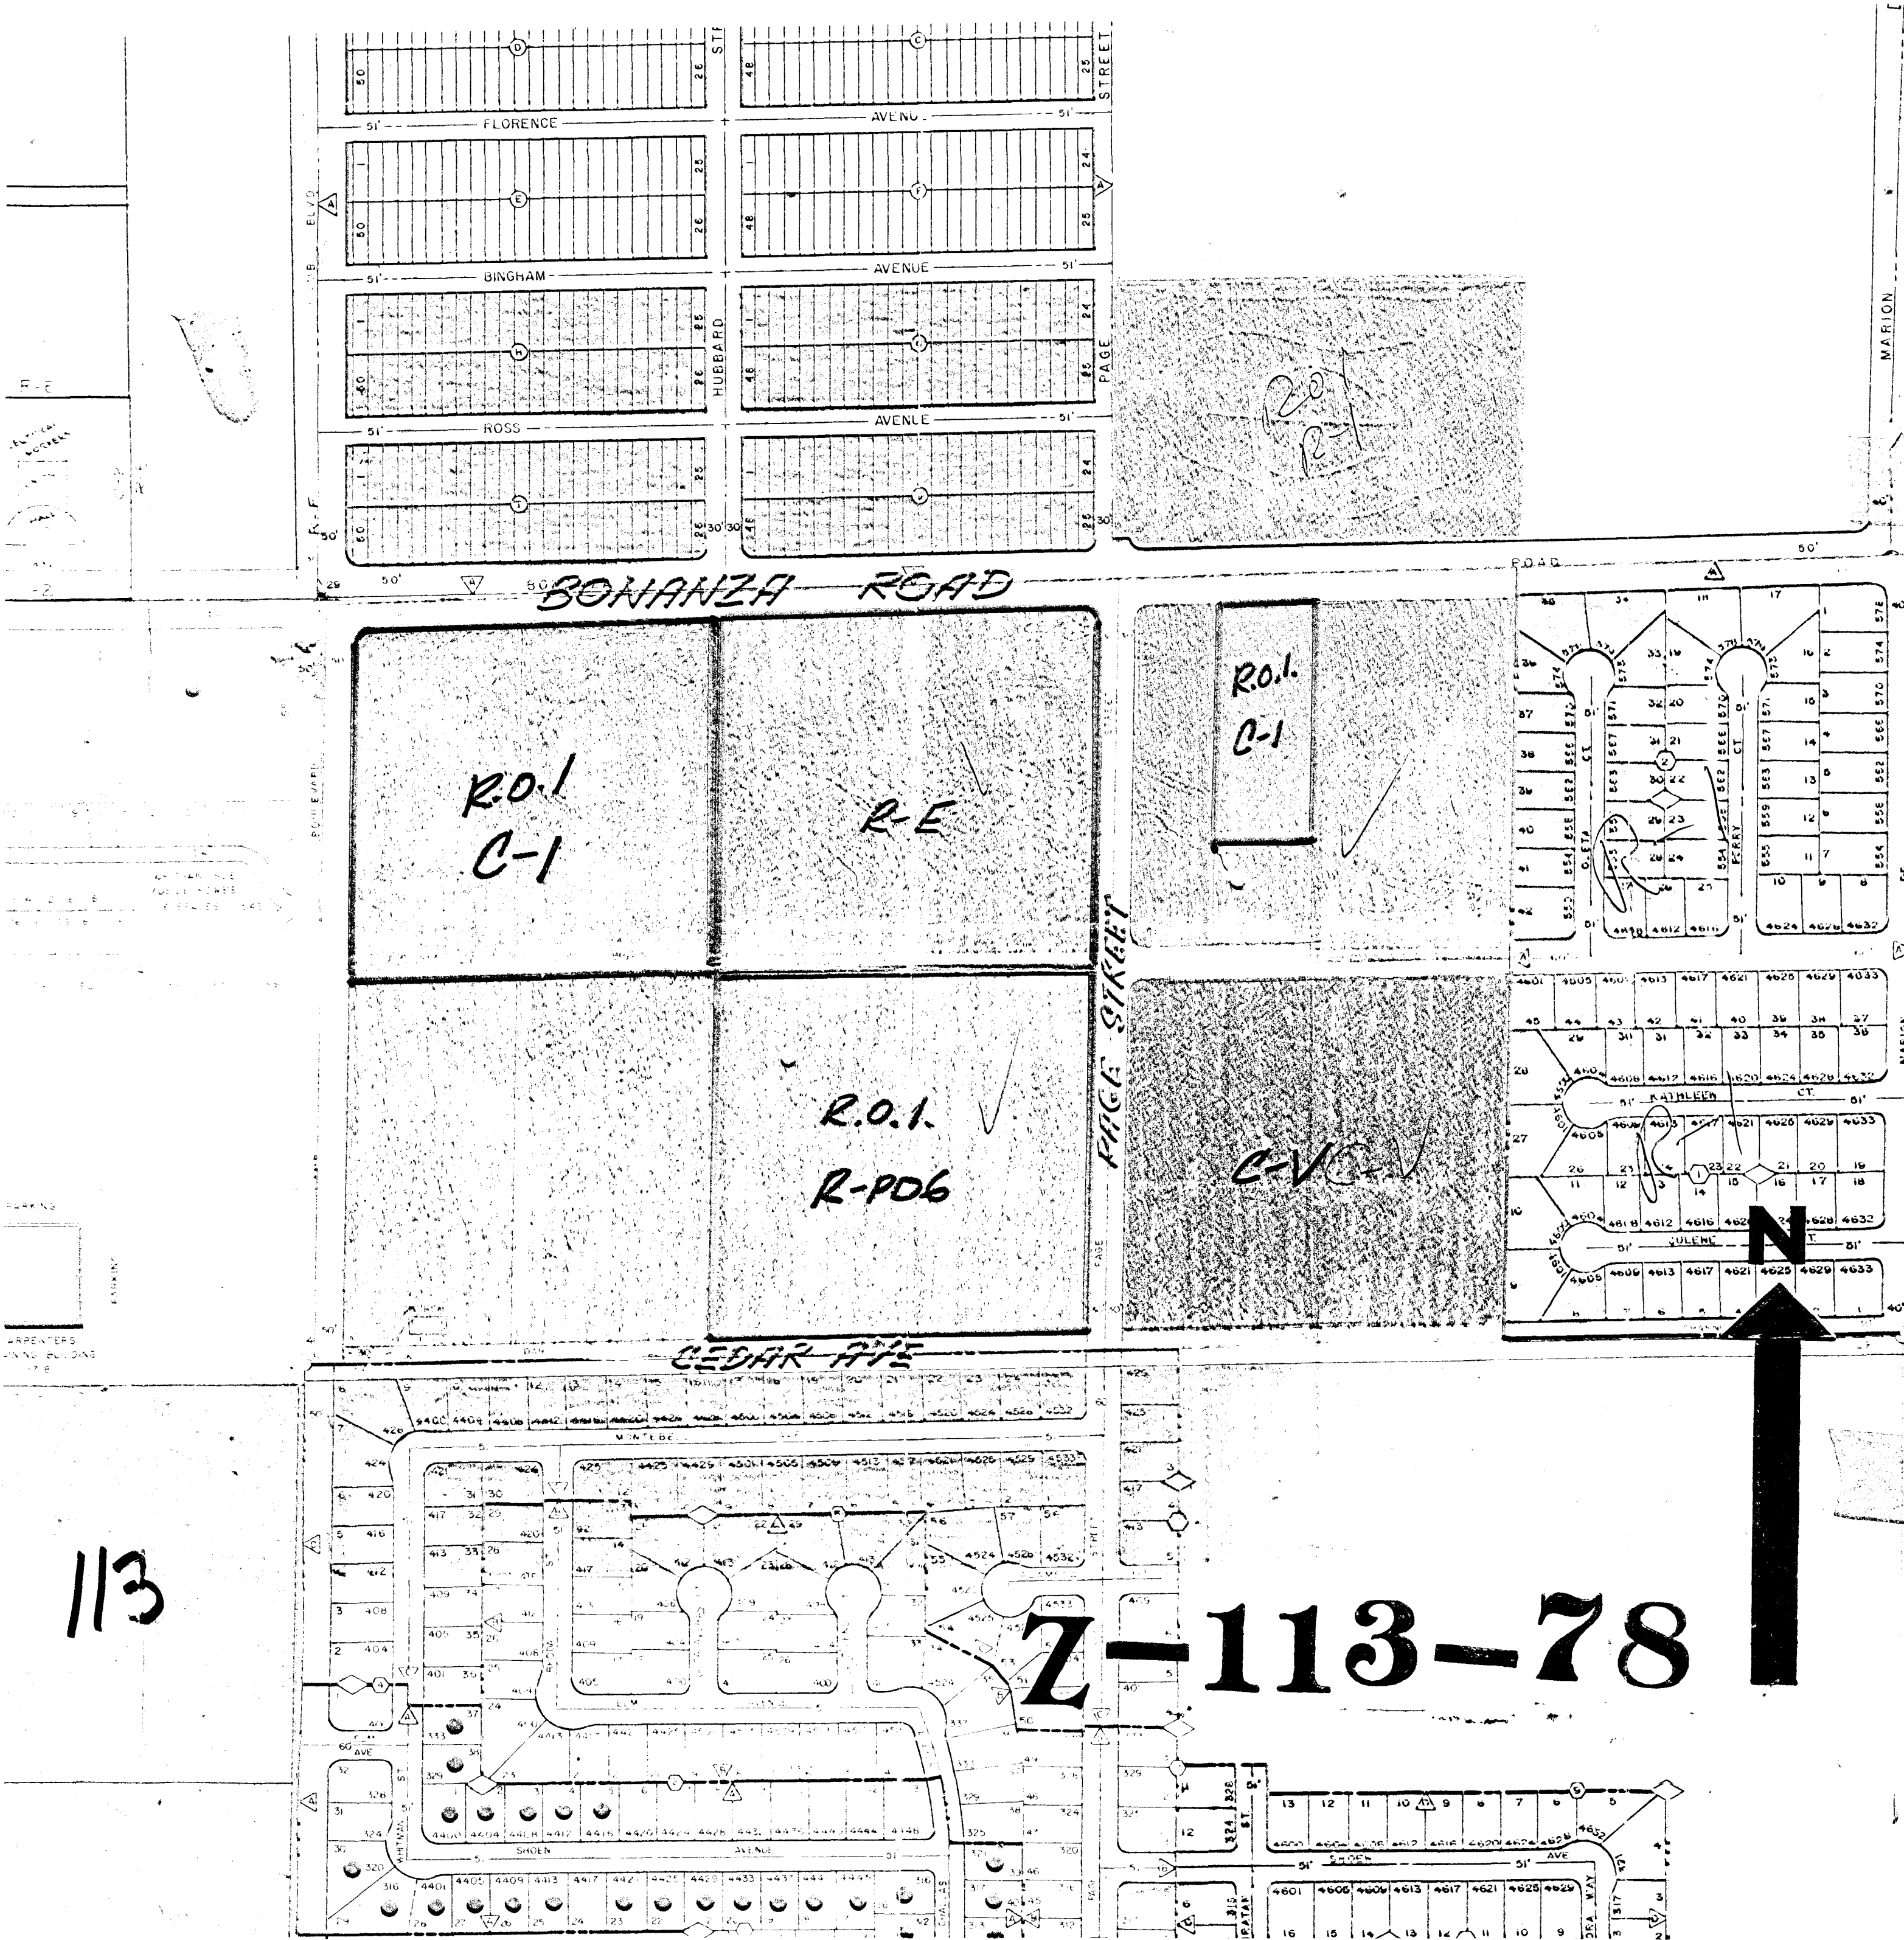

113

Z-113-78