

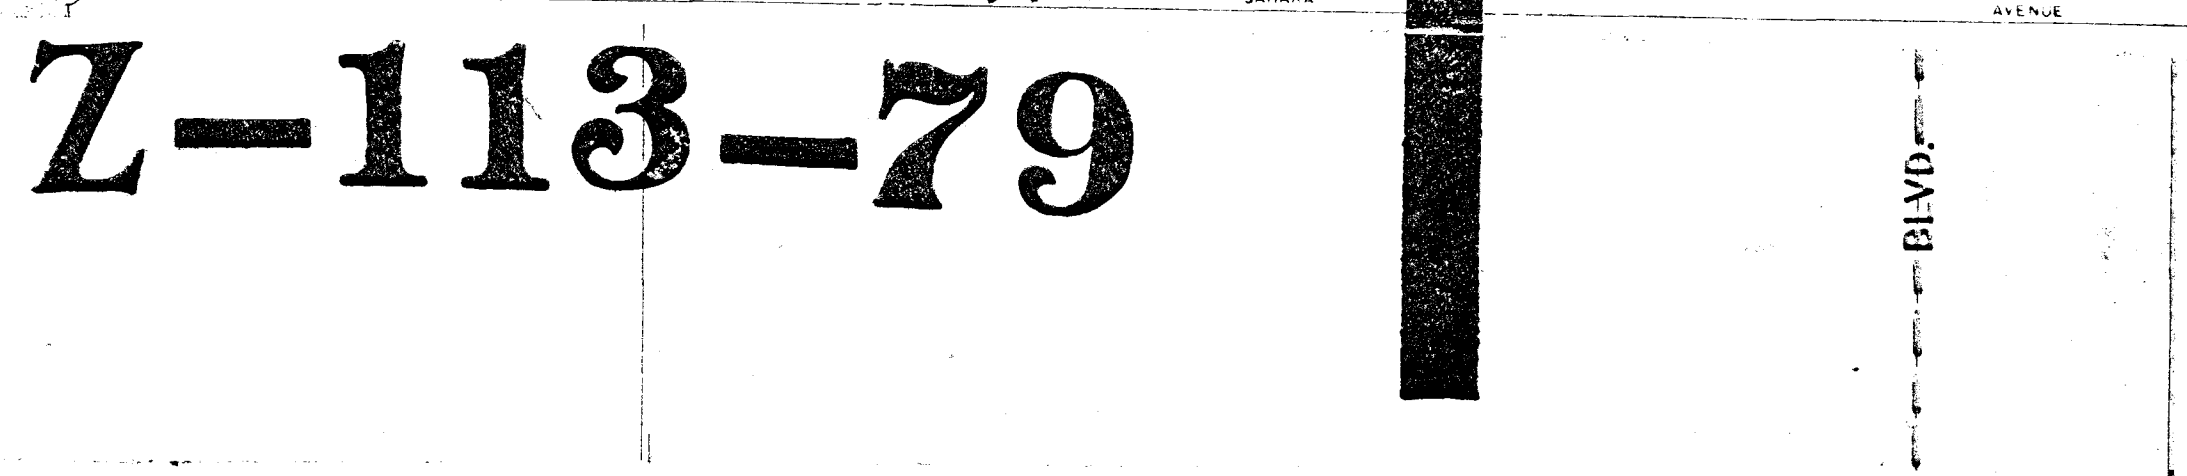
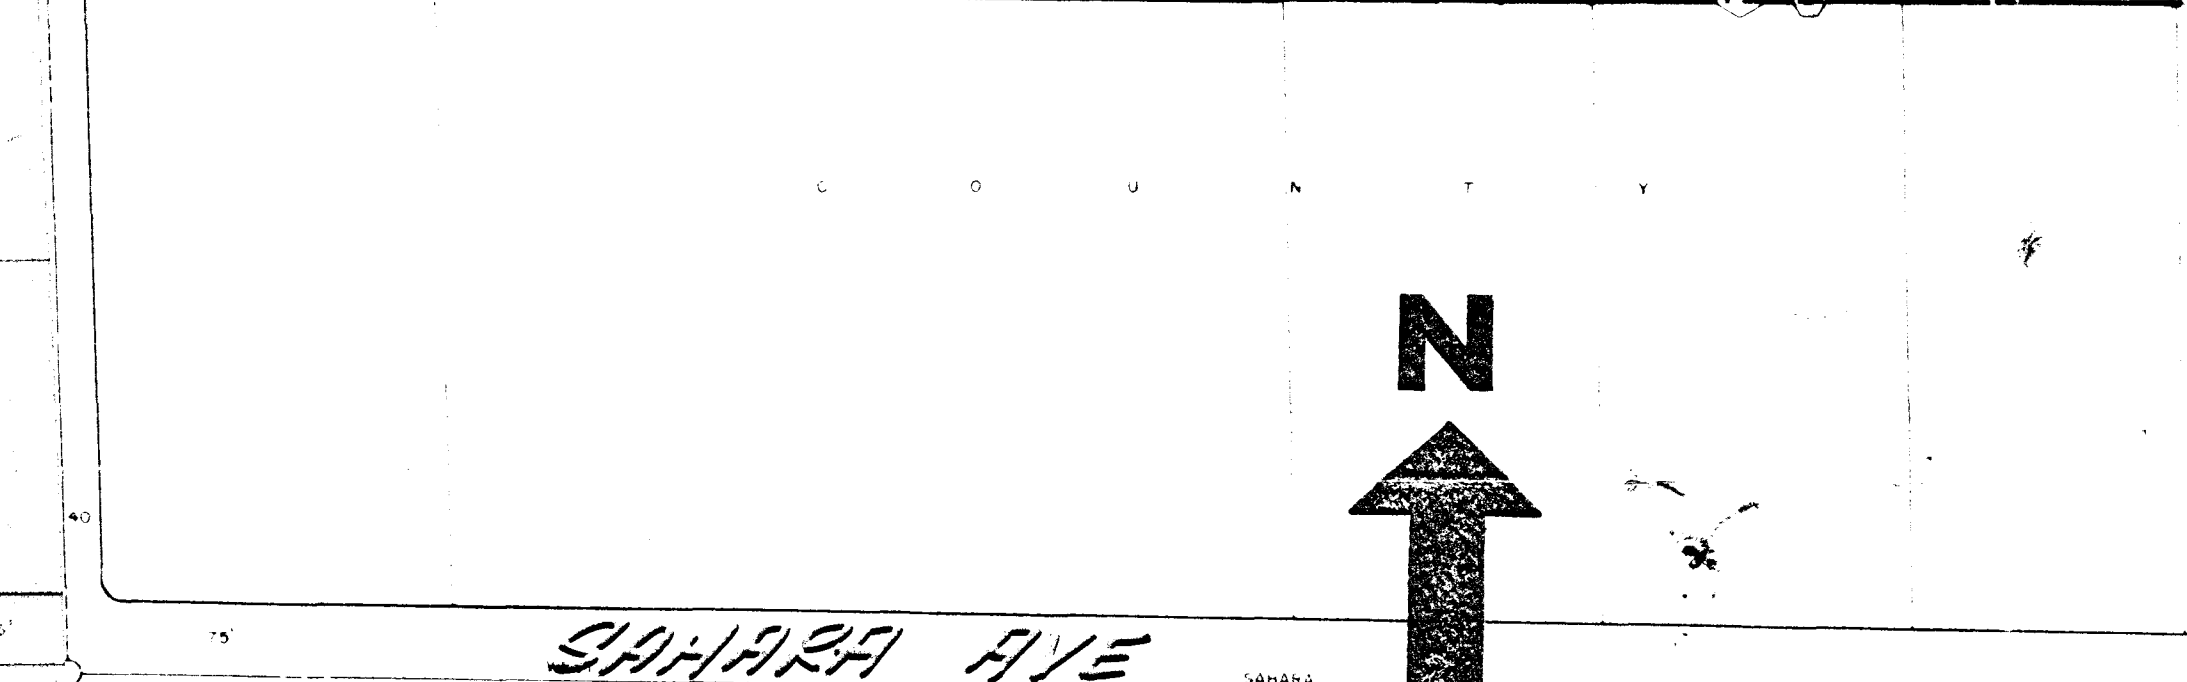
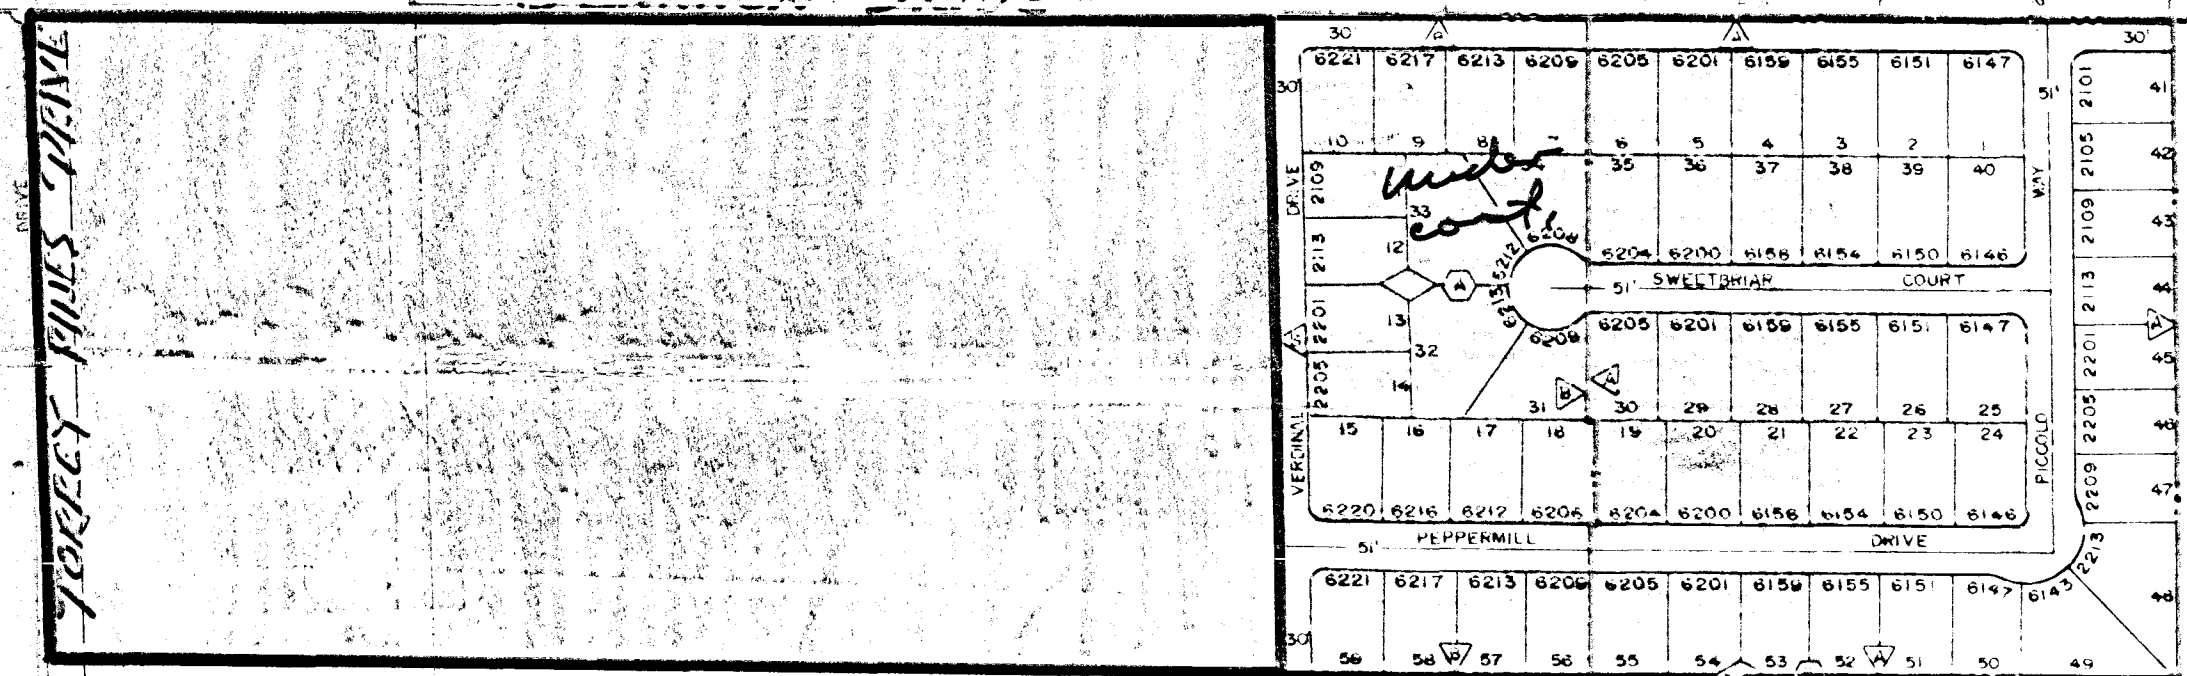


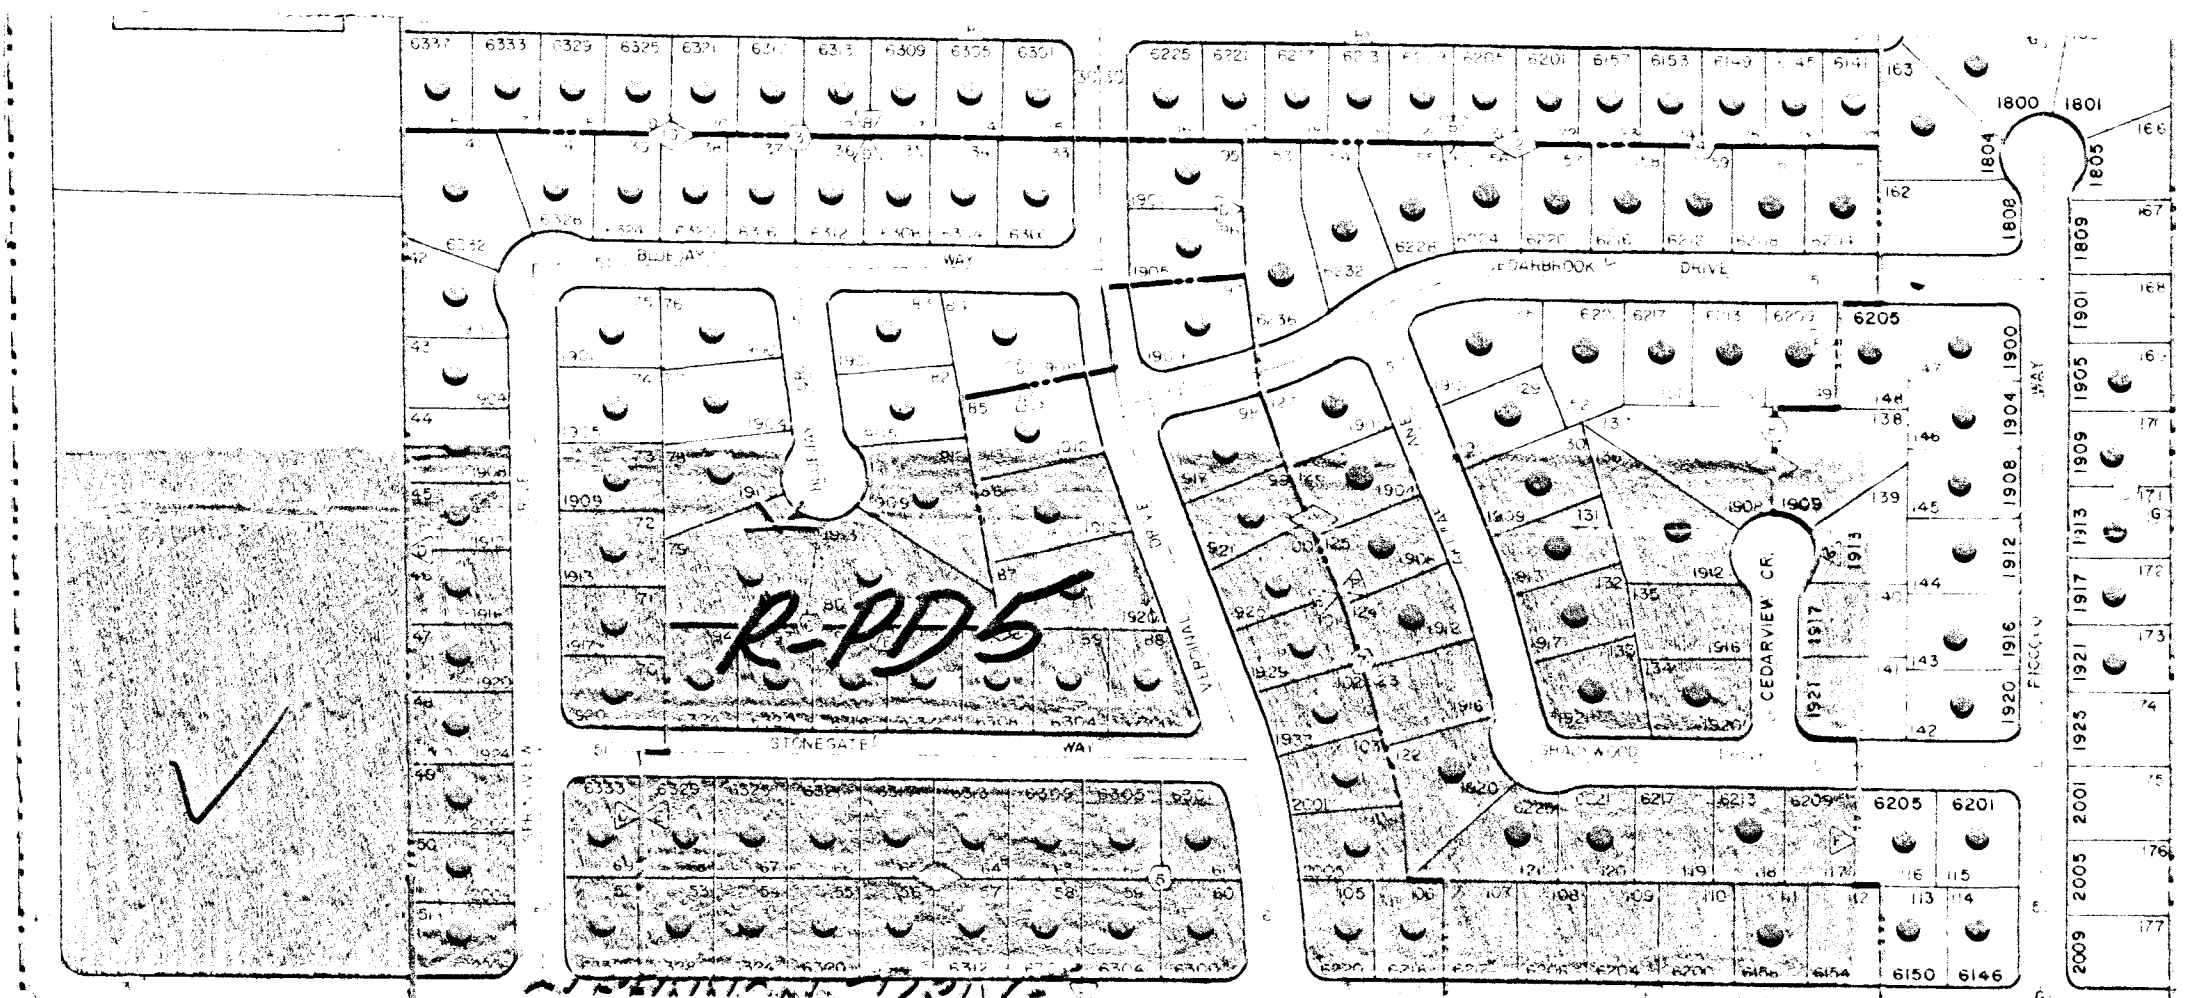

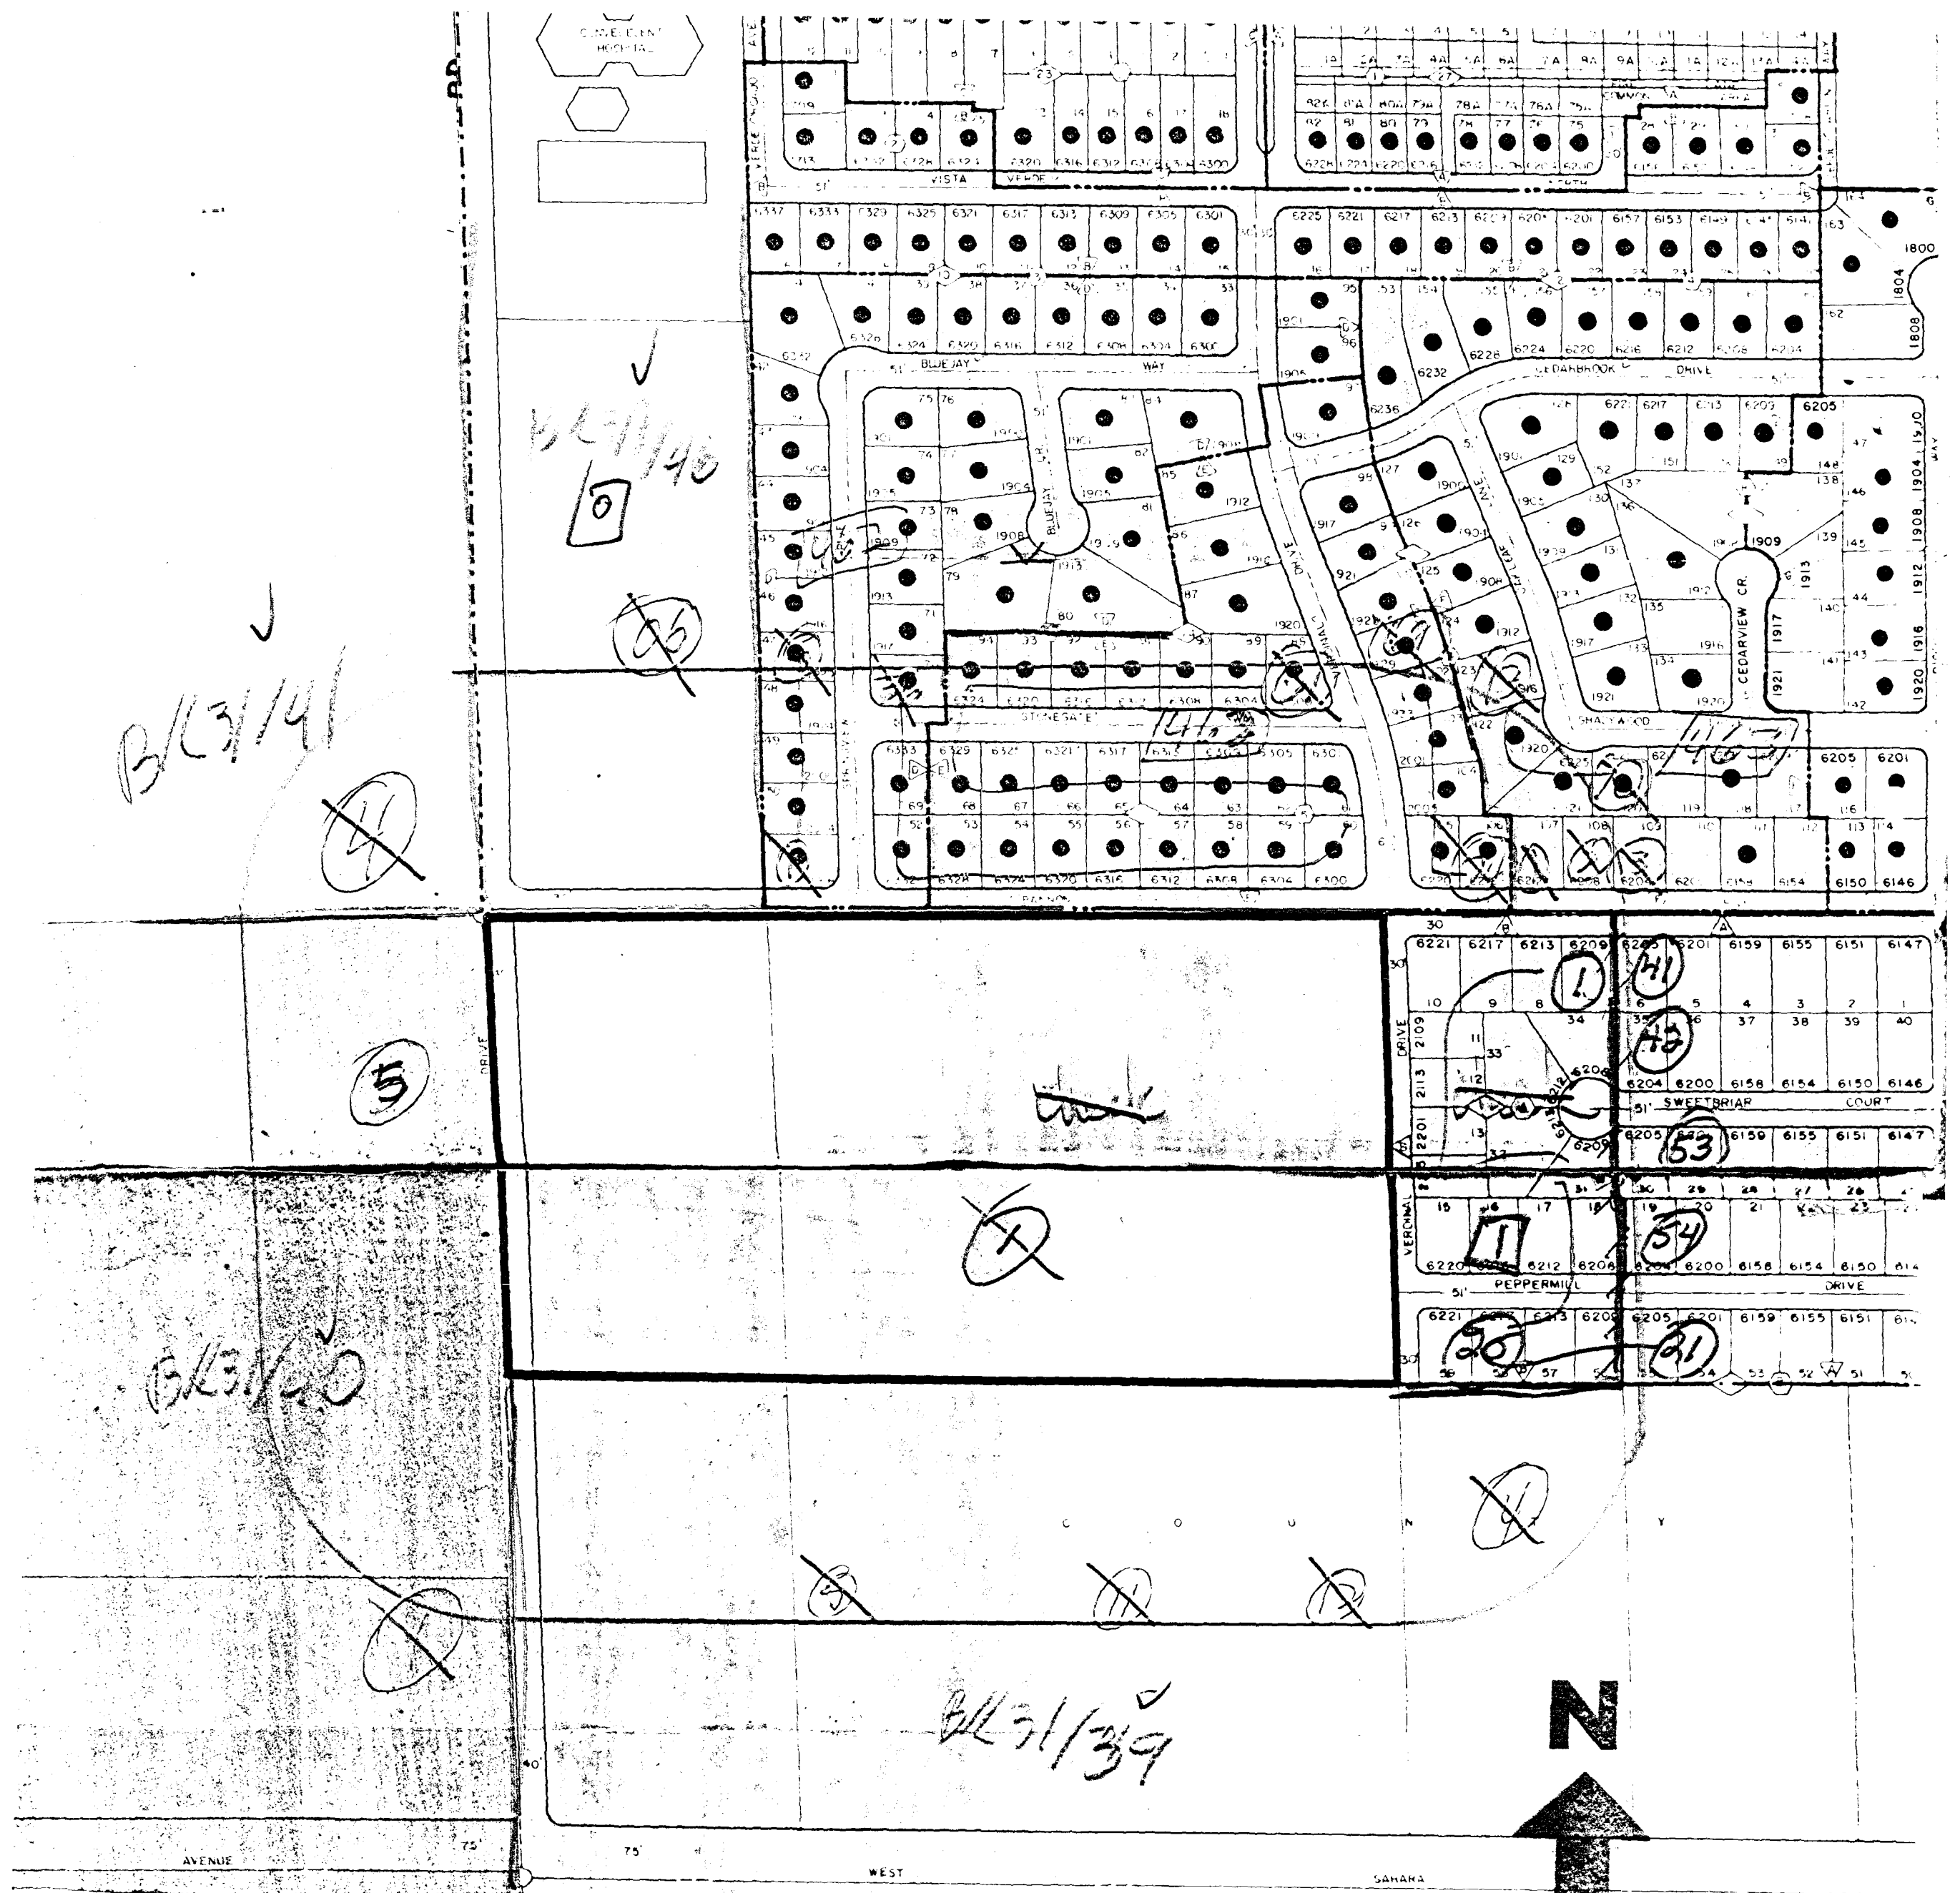

Z-113-79

LEWIS HOMES N-U-7-2-1