


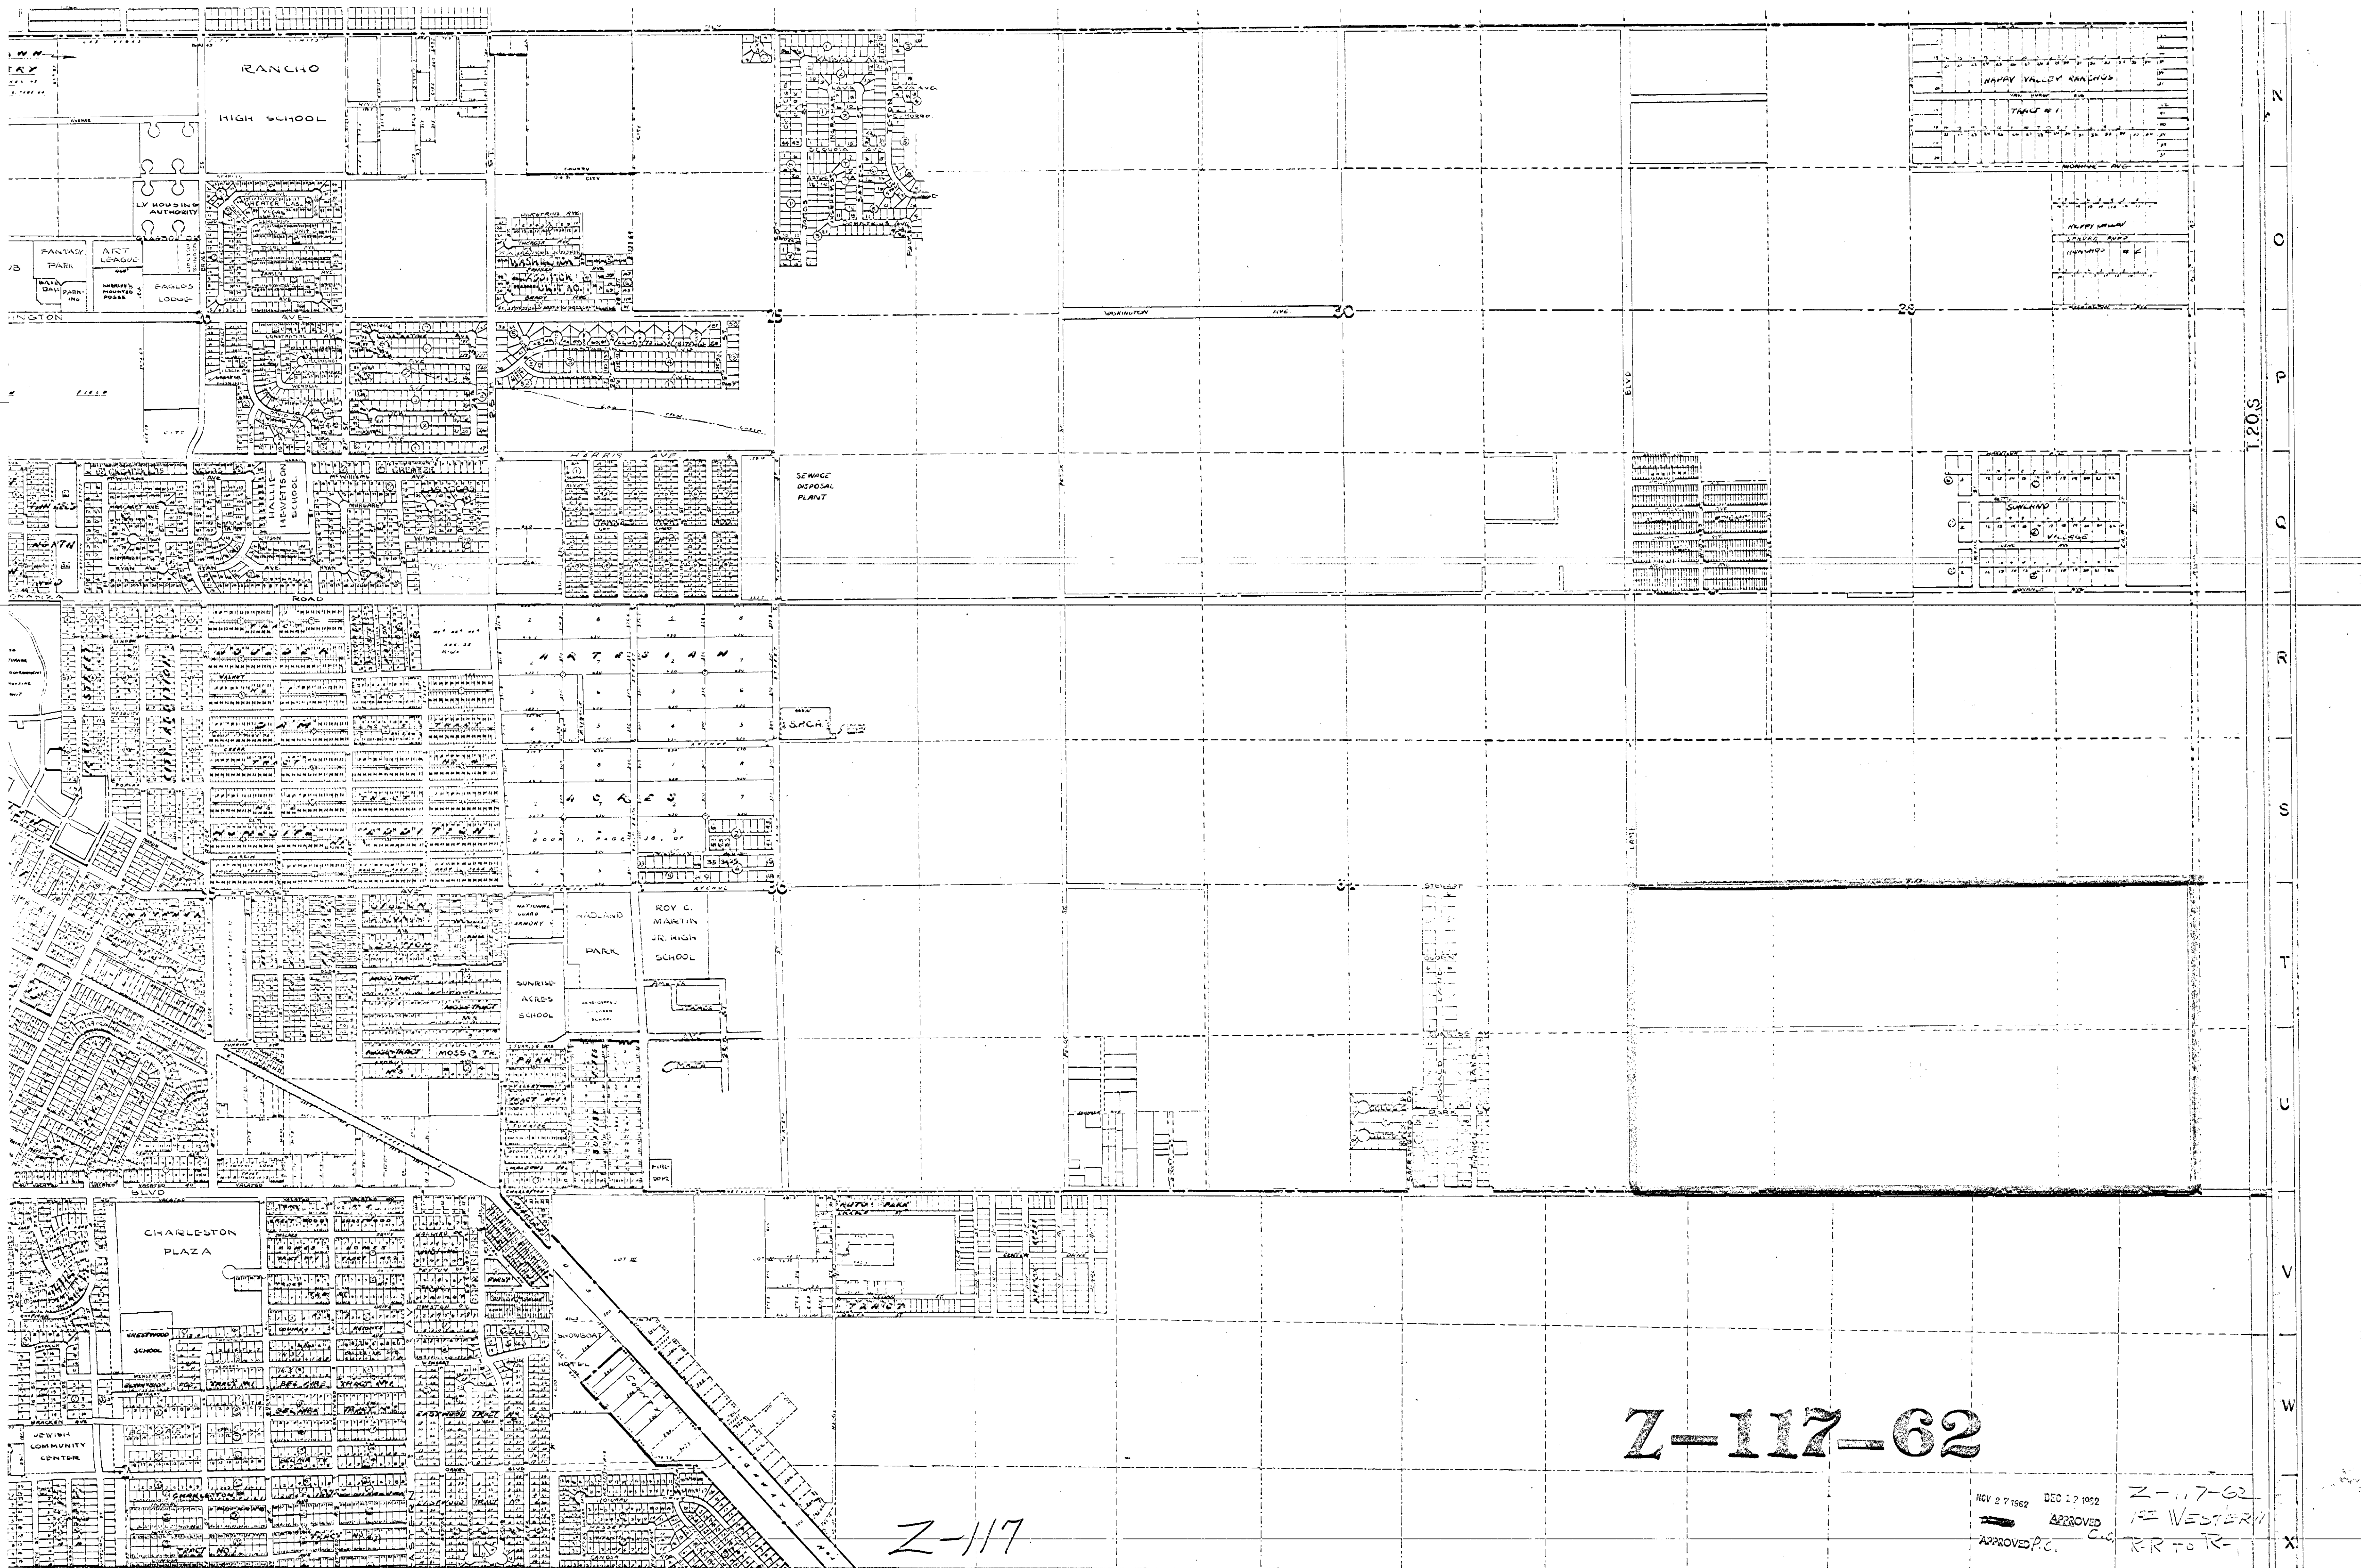

Z-117

Z-117-62

NOV 27 1962 DEC 13 1962
APPROVED RE. C. C. RE WESTERN
R.R. TO R.R.