


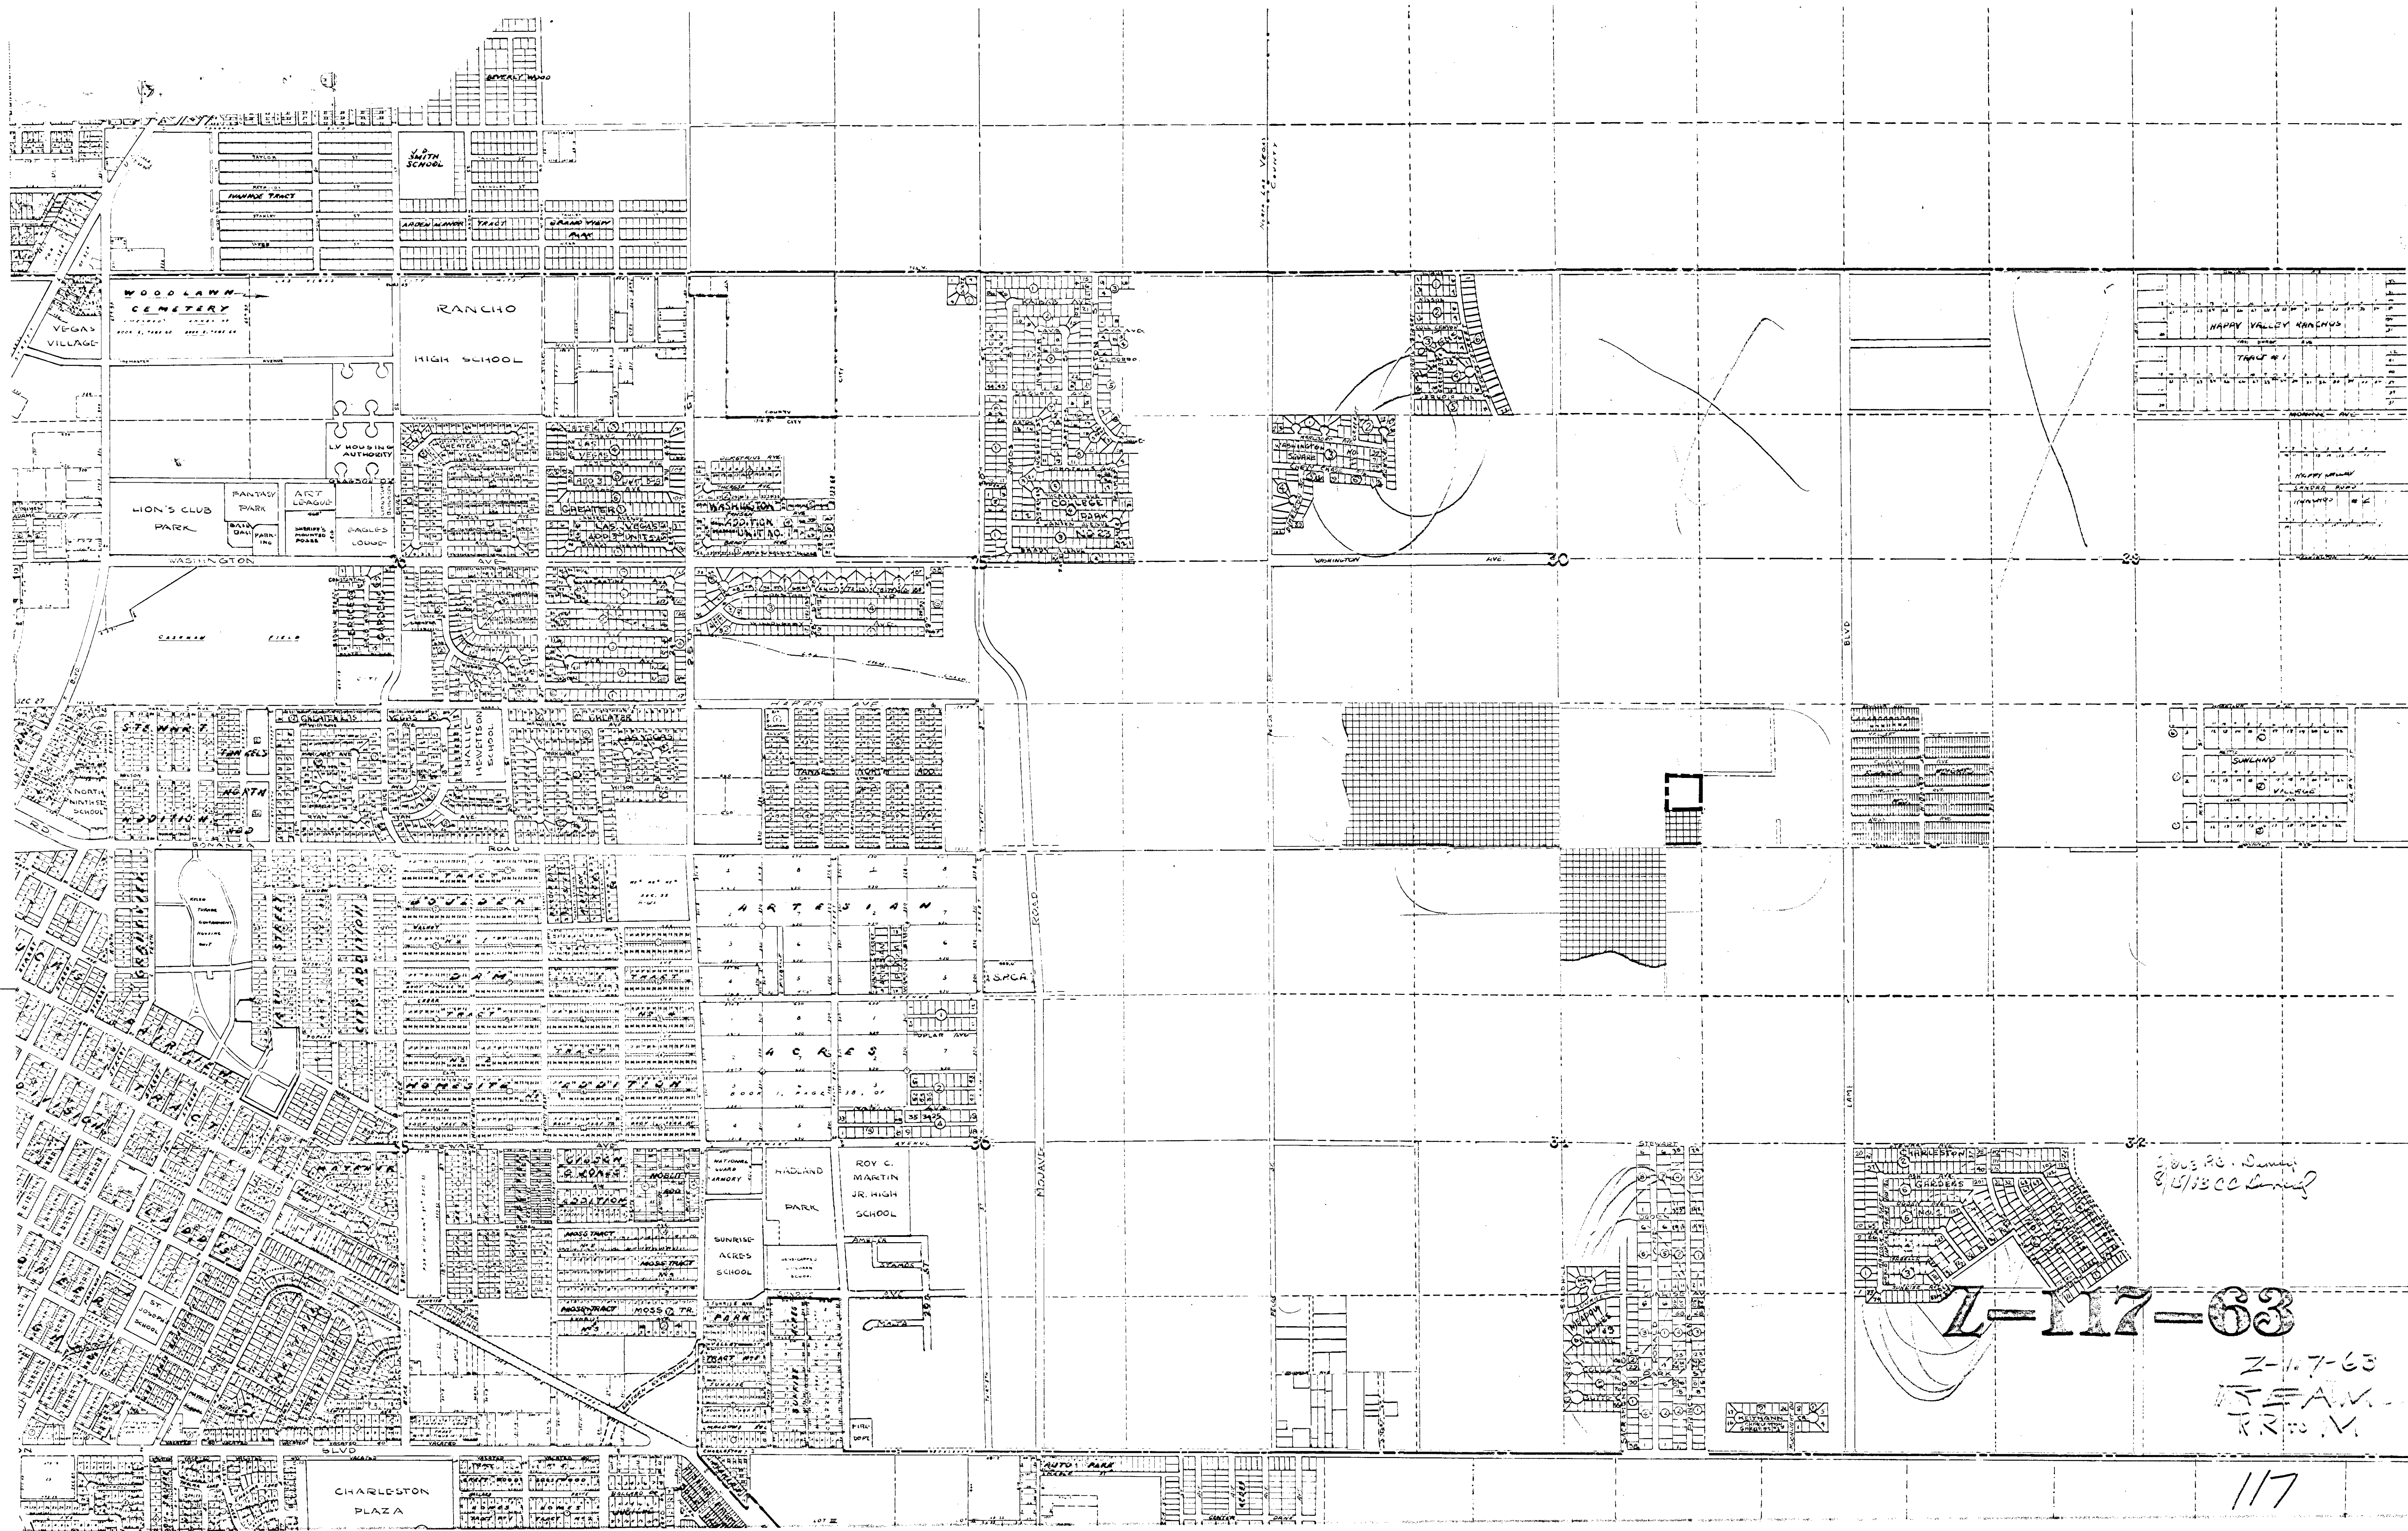

Z-117-63

Z-117-63
FEAV
R.R. 117

117