


Z-119-62

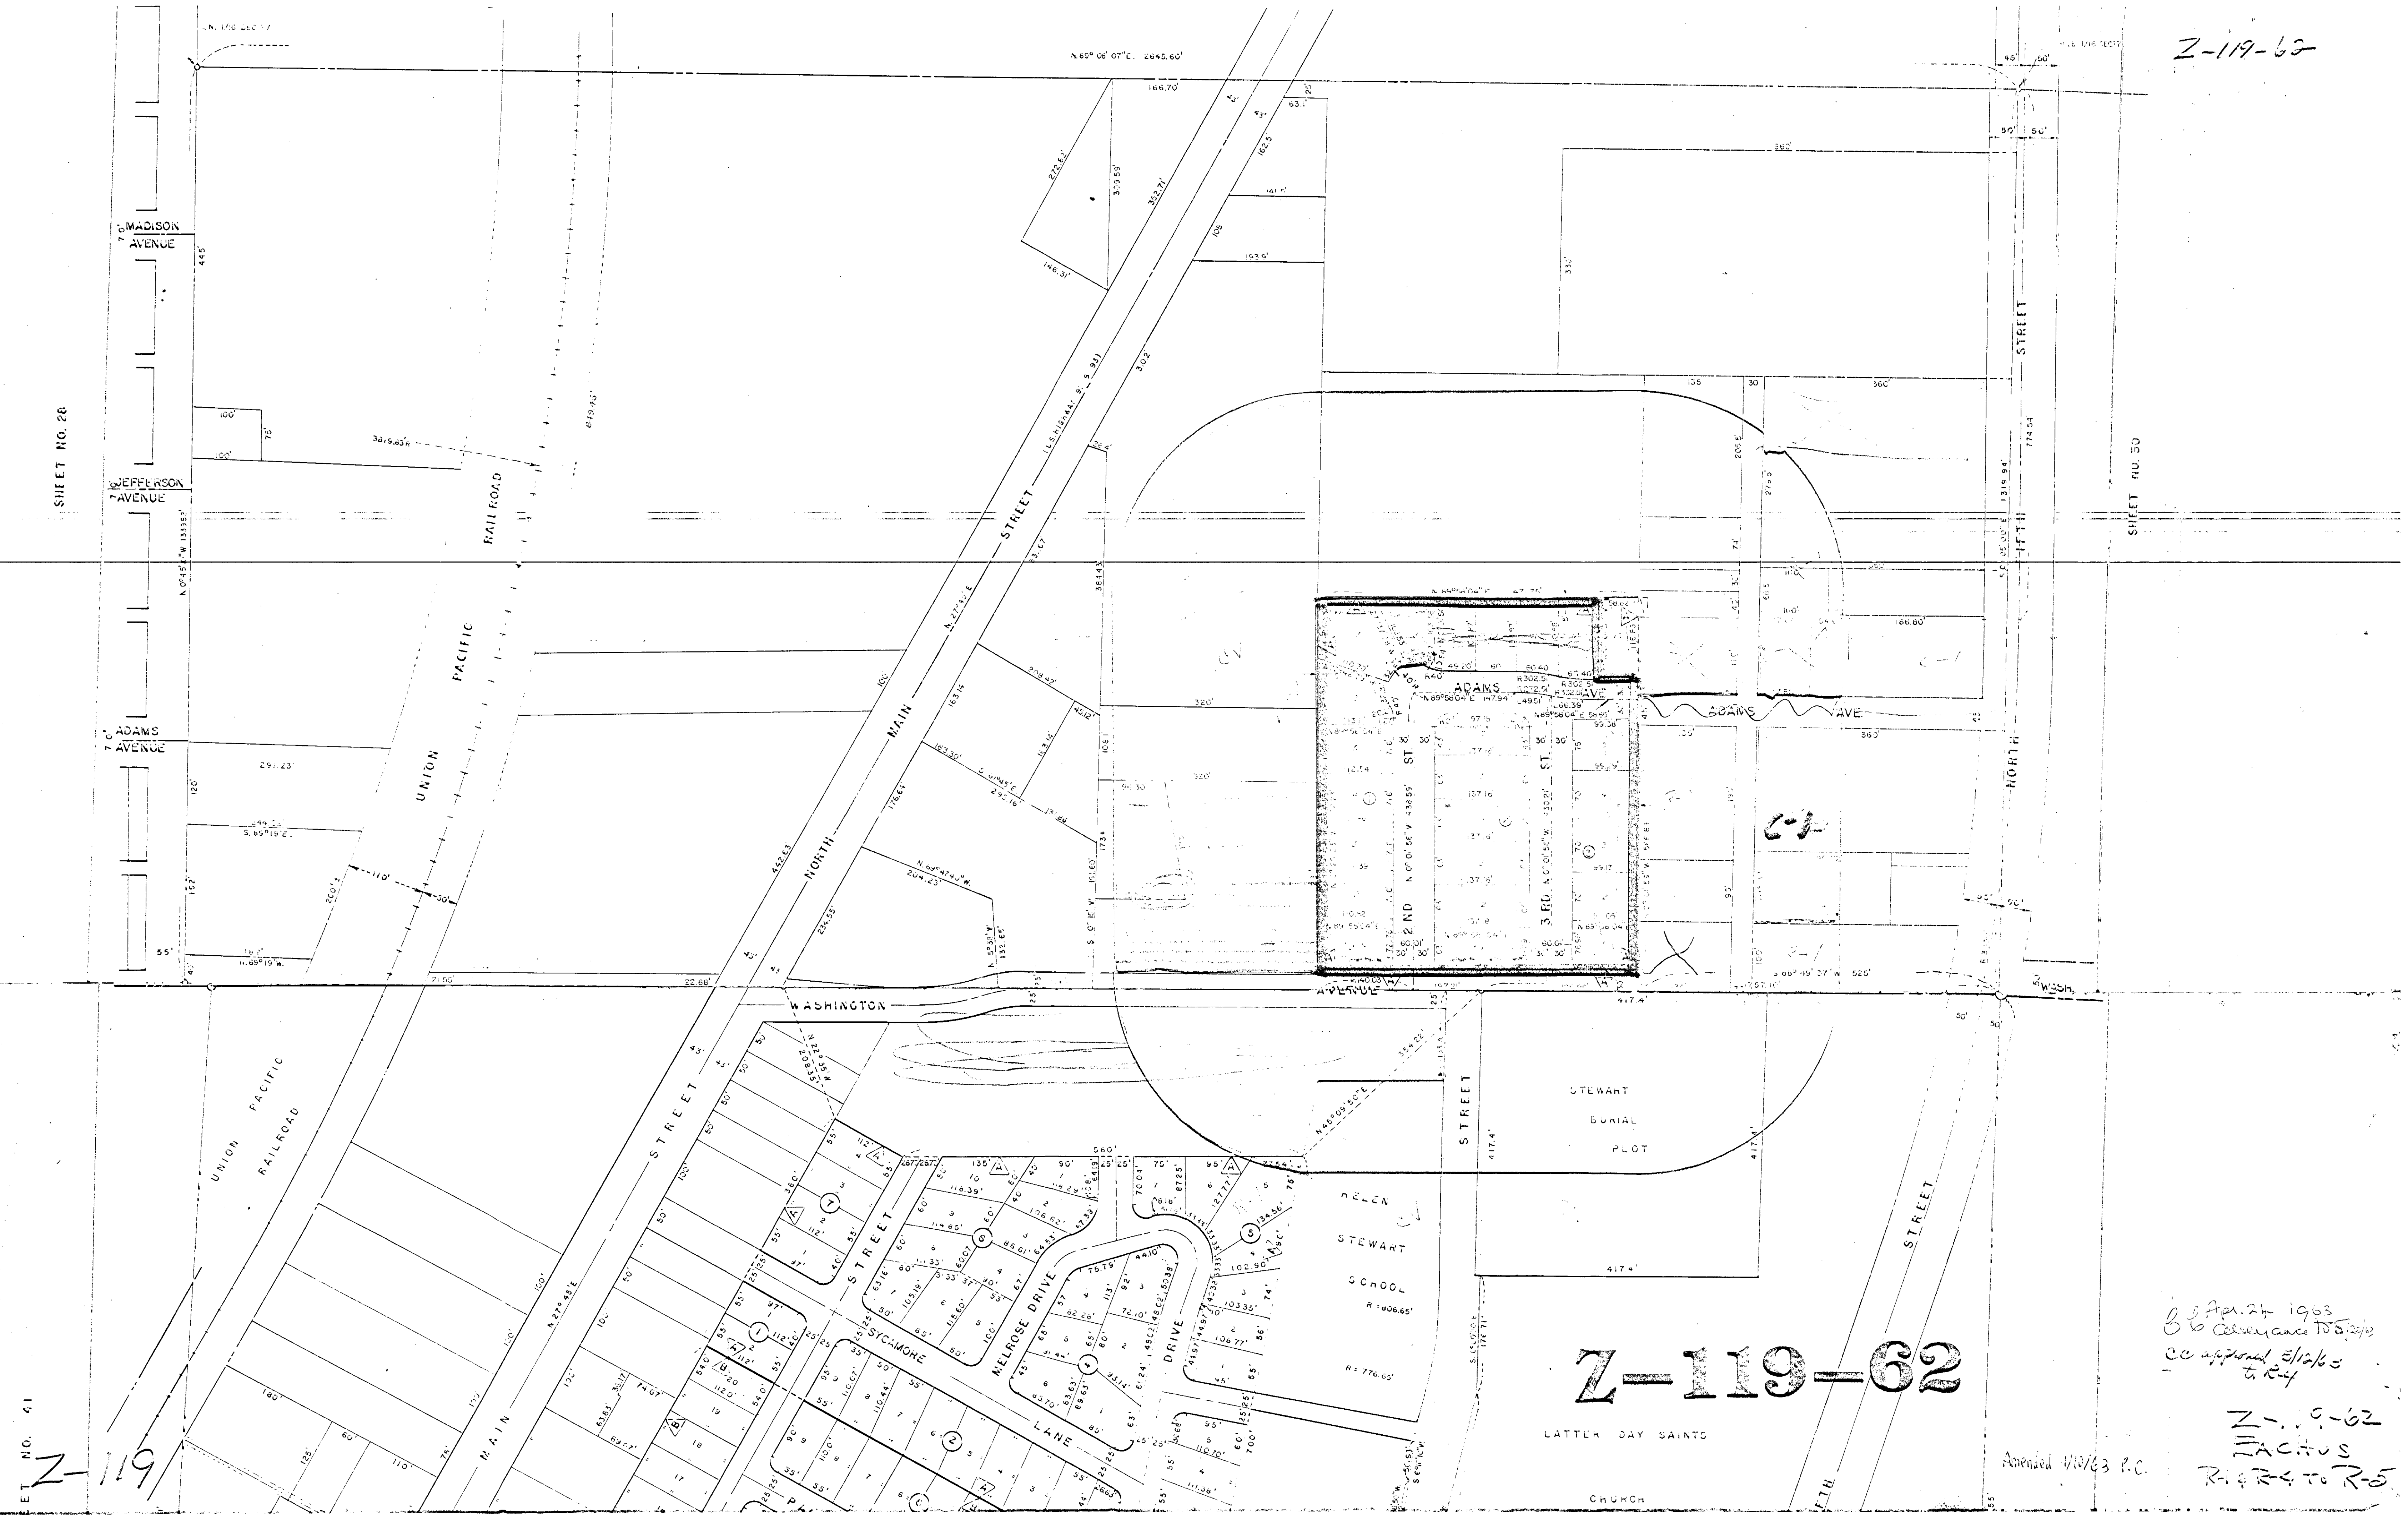

Z-119-62

LATTER DAY SAINTS

CHURCH

8 Apr. 24 1963
B to Clearance 105240
CC approved 5/12/63
to R-4

Z-119-62
FACHUS
R-4 R-4 to R-5

Amended 1/10/63 P.C.