

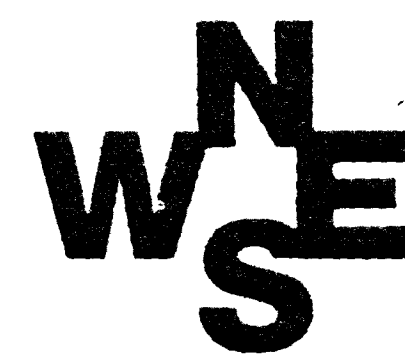


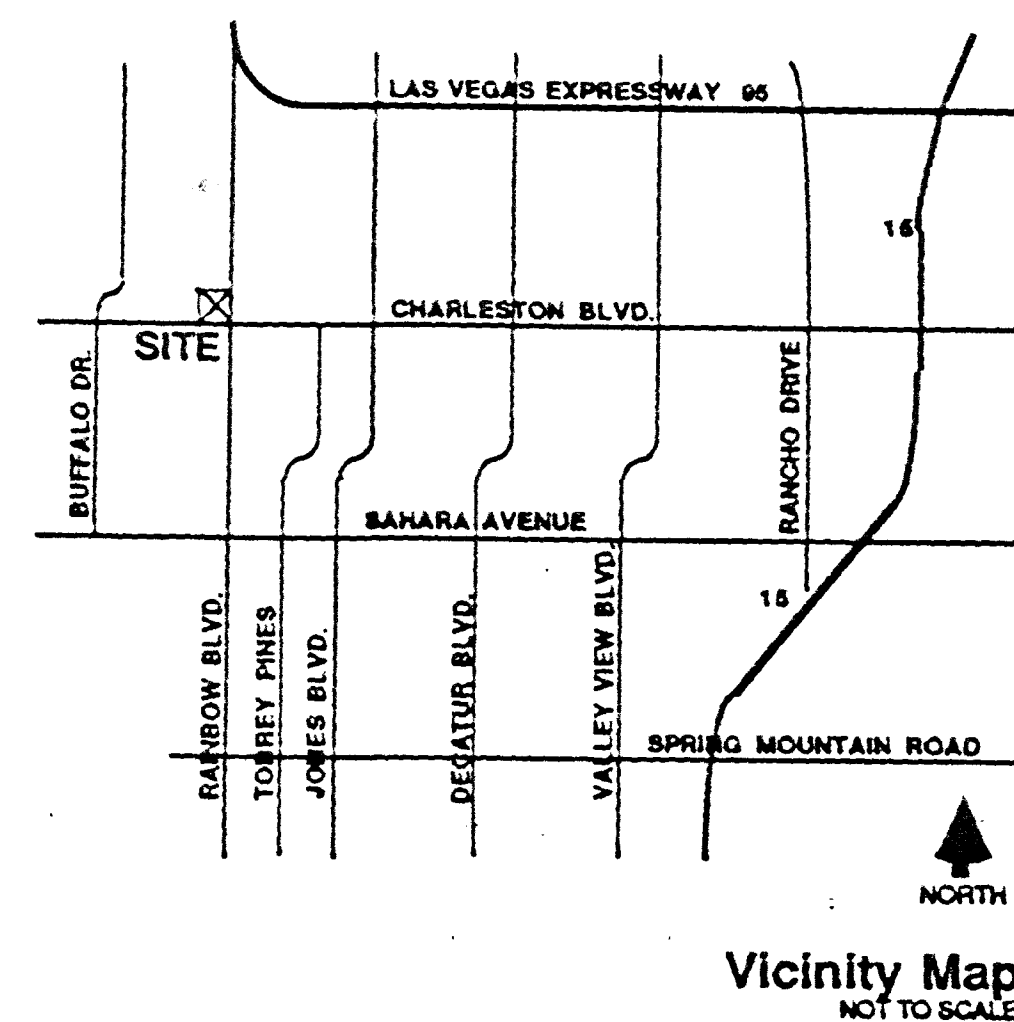


Summary
 516,802 sf land area
 11.86 acres
 140,708 sf building area
 2.7/1 land-to-bldg ratio
 736 stalls provided
 5.3/1000

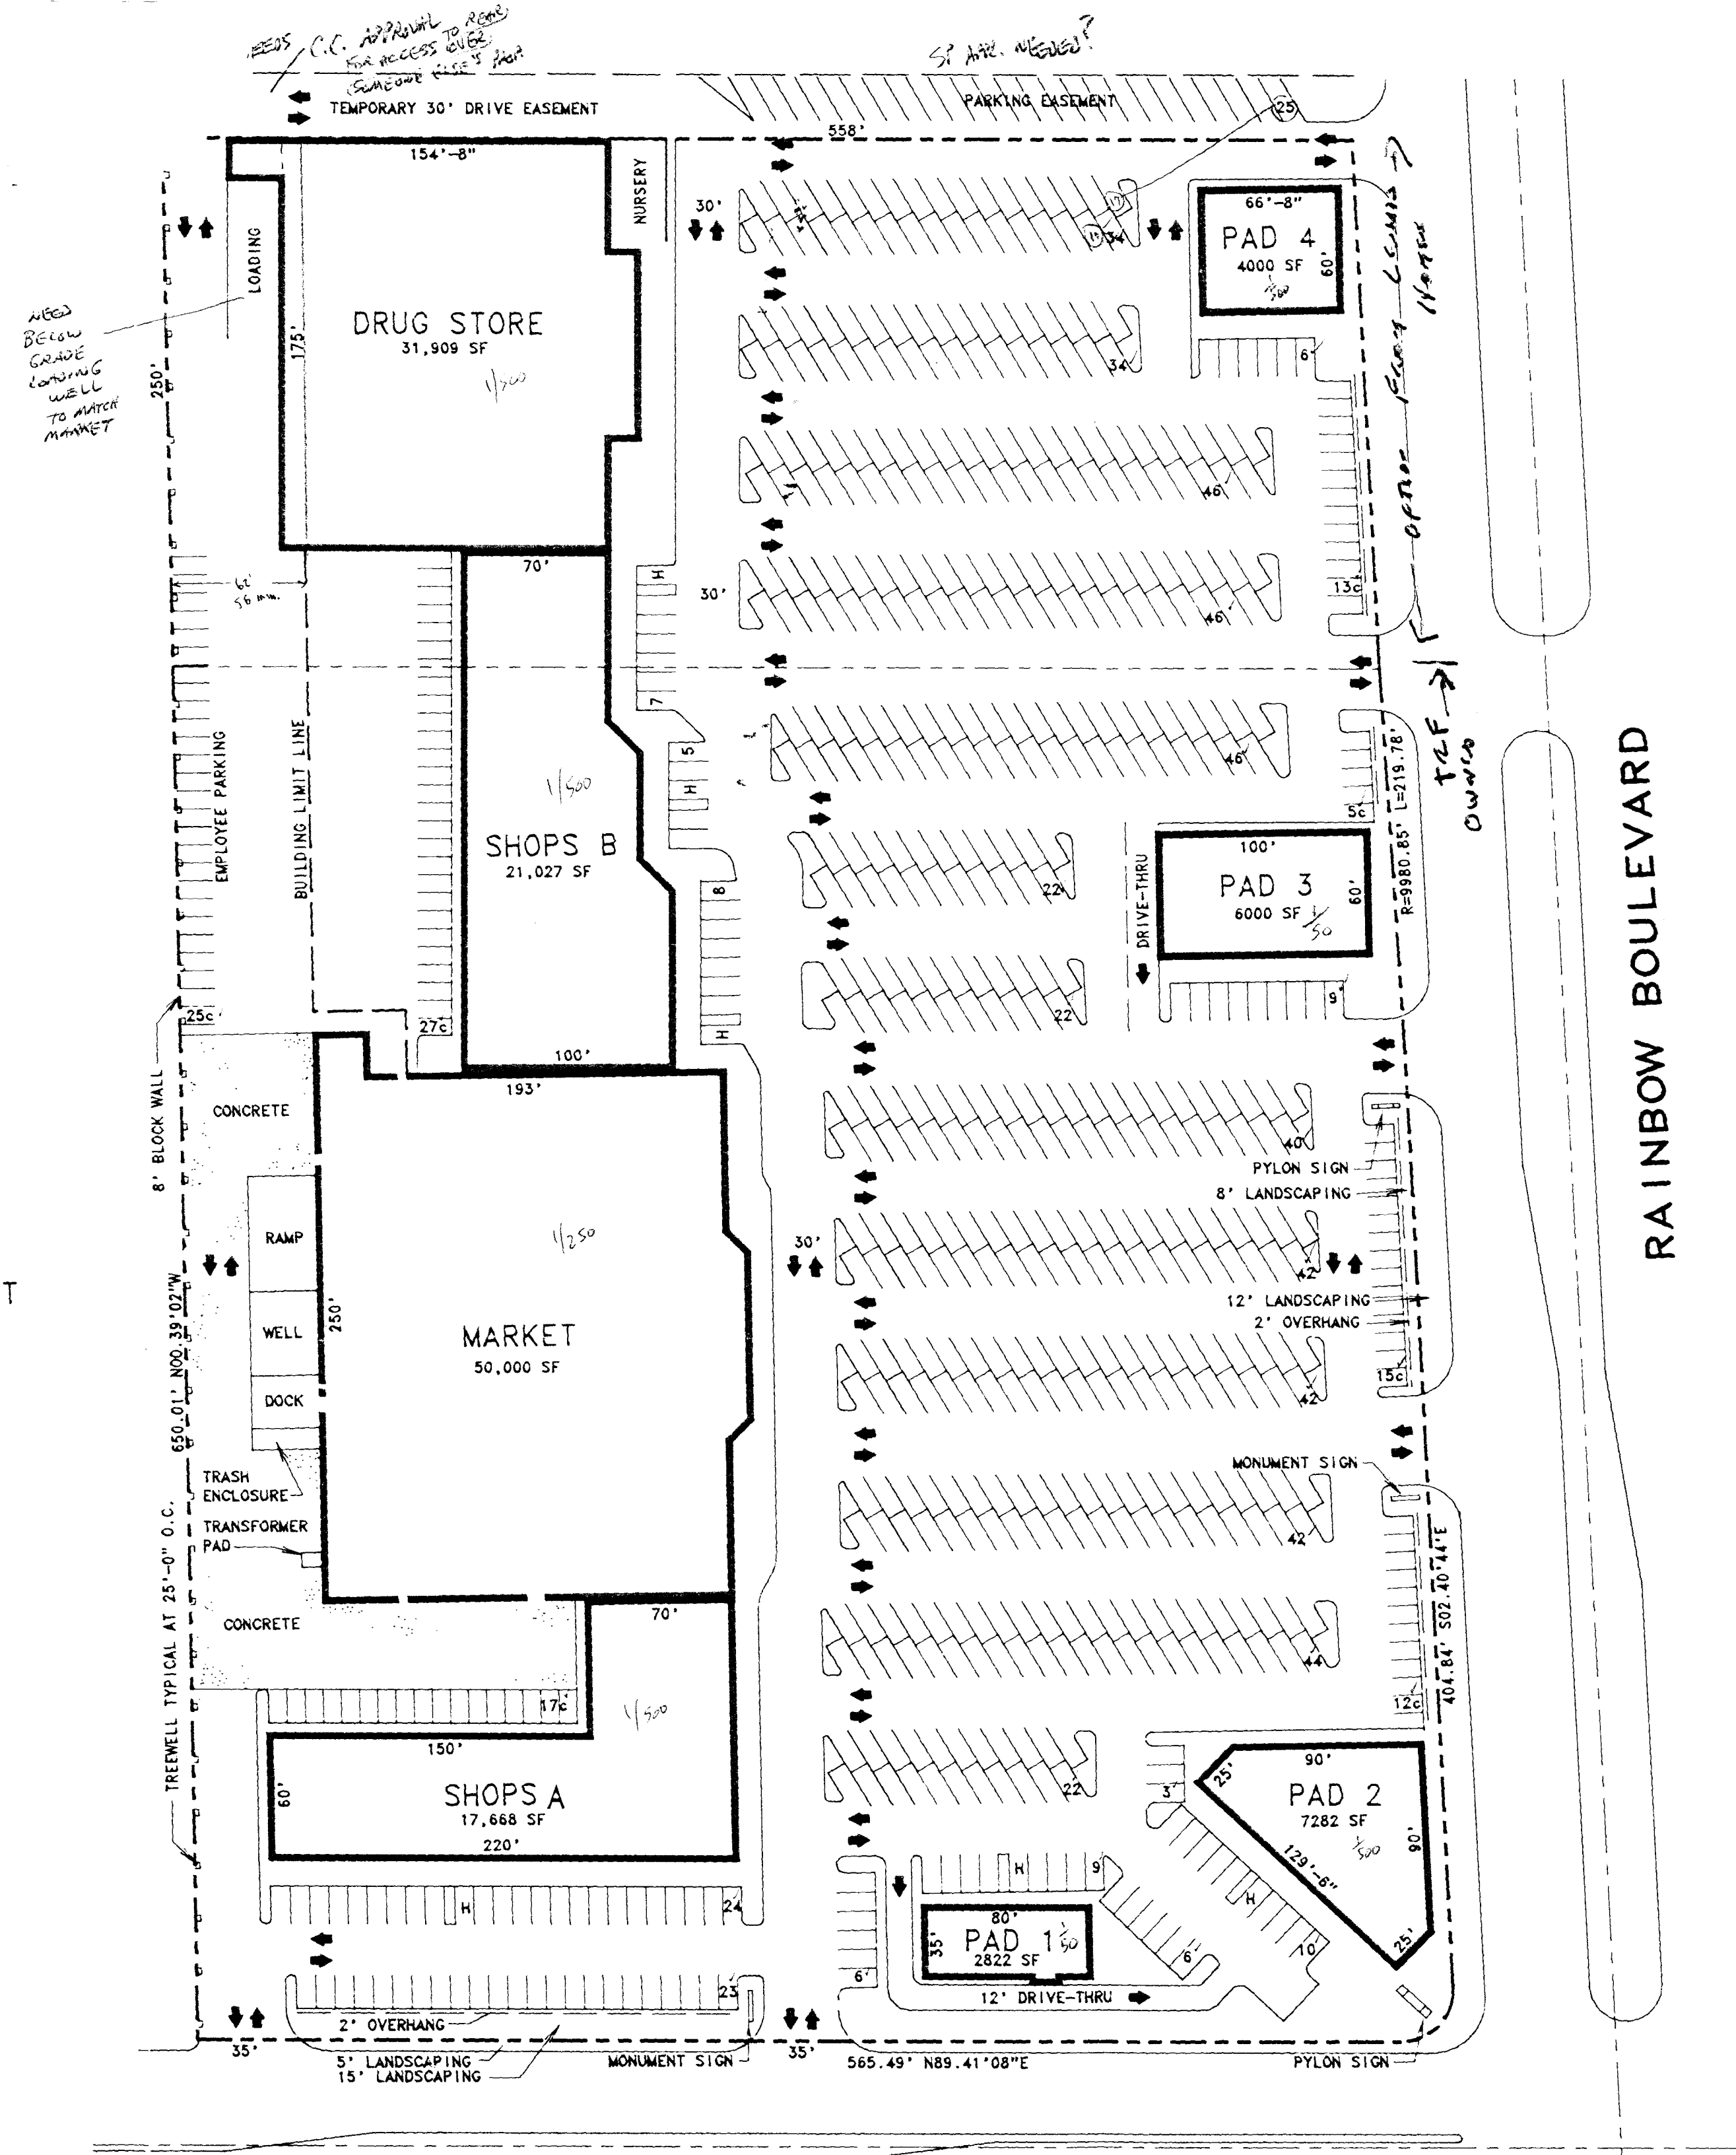

TRF DEVELOPMENT CORPORATION
 18400 Von Karman Avenue, Suite #330
 Irvine, California 92715 (714) 852-8080

RAINBOW PLAZA

Las Vegas, Nevada

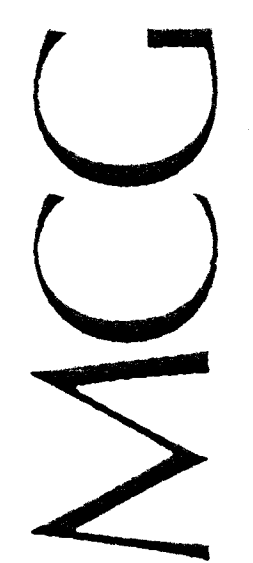

McClellan/Cruz/Gaylord & Associates
 Architecture • Planning • Interiors
 18201 Von Karman Avenue Suite 250
 Irvine, CA 92715-1028 (714) 553-1117
 12/13/88 LMC

81,886 $\frac{1}{500}$ = 163.772
 8000 $\frac{1}{250}$ = 200.000
 8000 $\frac{1}{50}$ = 176.000
 TOTAL 539.772 SPACES

675 w/o GRADING
 + 42 w/ GRADING
 TOTAL 717

REVISED PLAN
 SUBMITTED
 w/ 1-4-89 CTR.