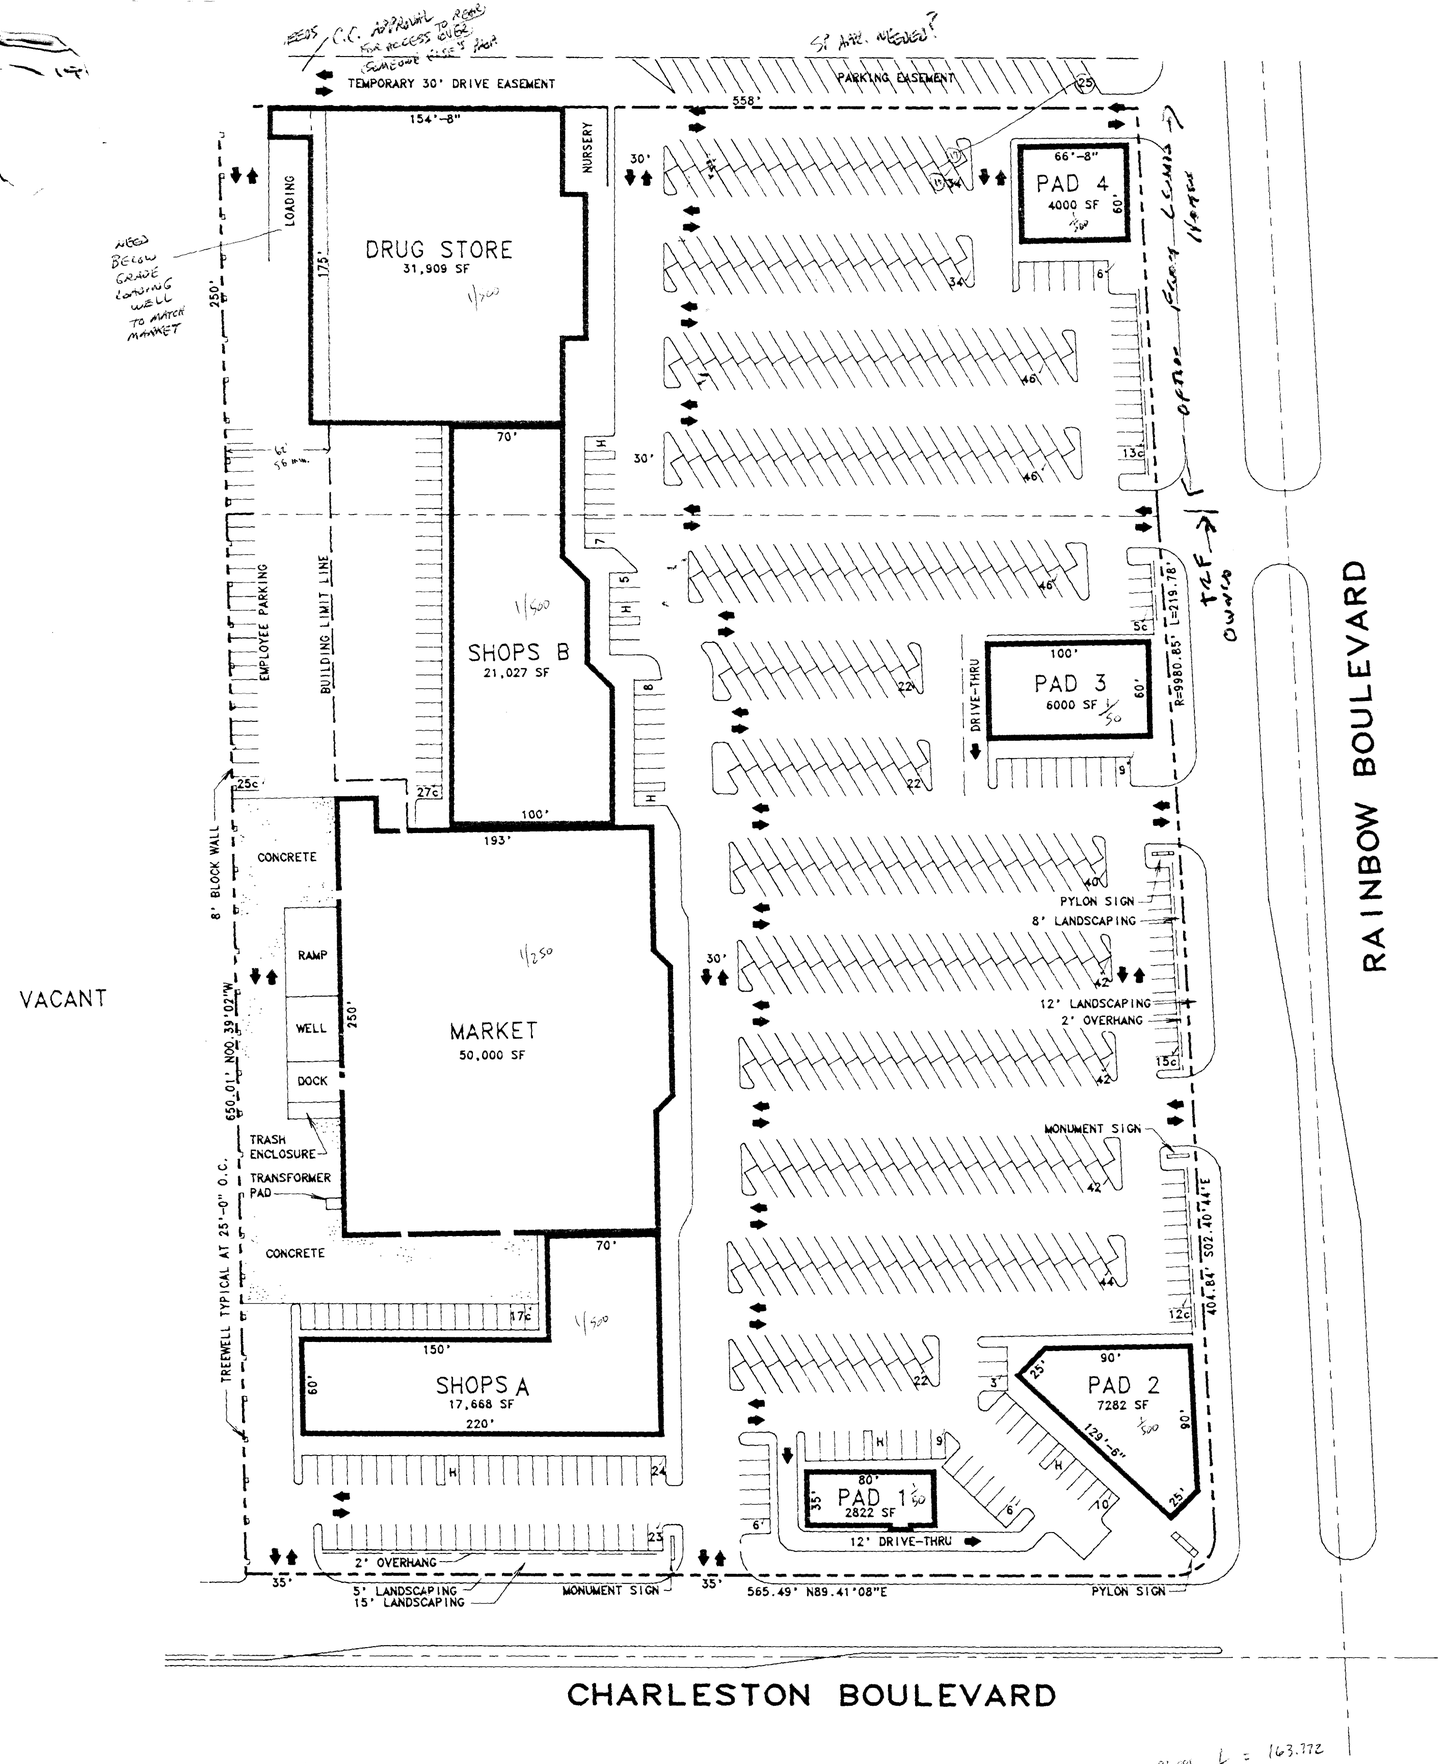

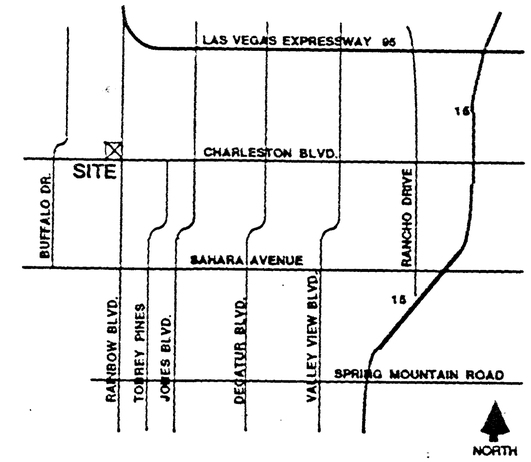

Vicinity Map
NOT TO SCALE

N W E S

60

Summary

516,802 sf land area
11.86 acres
140,708 sf building area
2.7/1 land-to-bldg ratio
736 stalls provided
5.3/1000

TRF DEVELOPMENT CORPORATION
18400 Von Karman Avenue, Suite #330
Irvine, California 92715 (714) 852-8080

RAINBOW PLAZA

Las Vegas, Nevada

MCG
McClellan/Cruz/Gaylord & Associates
Architecture • Planning • Interiors
88074.01 12/13/88 LMc
18201 Von Karman Avenue Suite 250
Irvine, CA 92715-1028 (714) 553-1117

81,886 1/500 = 163.772
50000 1/250 = 200.000
8822 1/50 = 176.440
TOTAL 539.212 SPACES

675 w/o EASEMENT
+ 42 w/ EASEMENT
TOTAL 717

REVISED PLAN SUBMITTED w/ 1-4-89 LTR.

-7-80-78 - C-1