


ALLEY


FIRST STREET

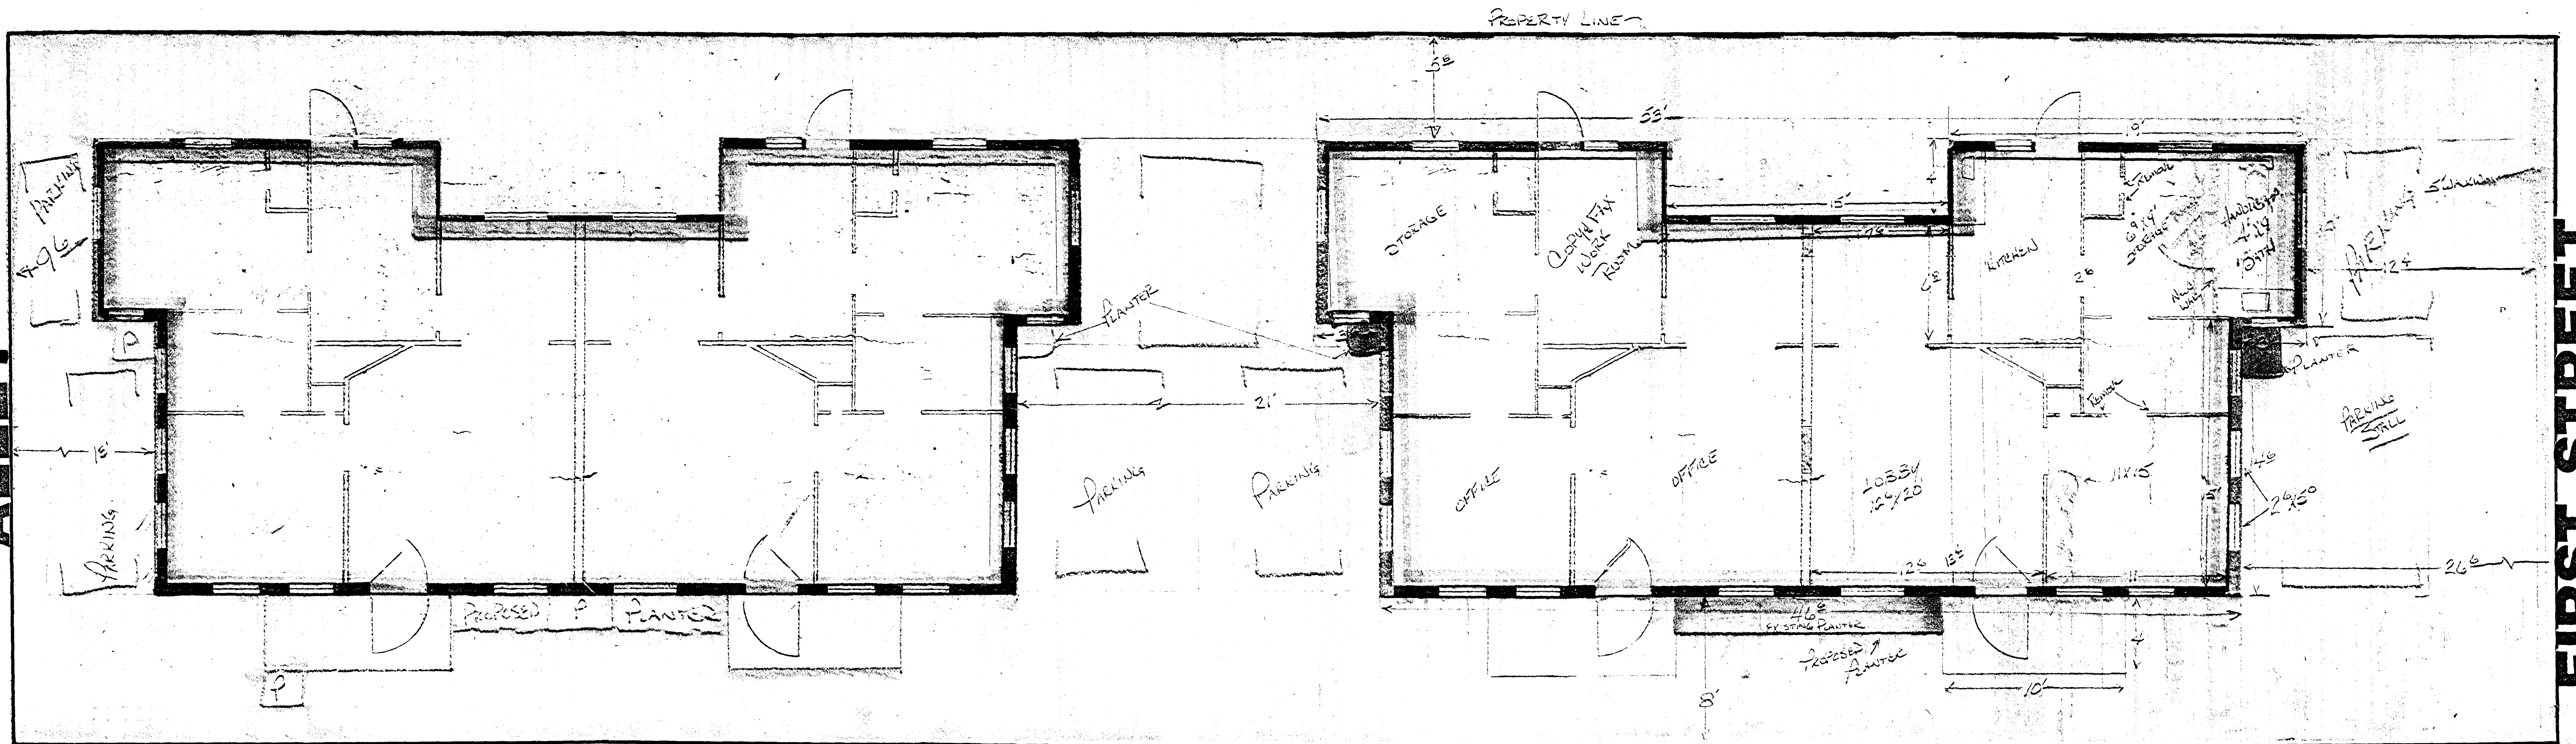

* EXISTING CONCRETE PARKING STRIP
SINCE 1967

BONNEVILLE AVENUE

NOTES: TOTAL P - 42200²
PARKING REQUIRED - 4
LOT SIZE 64/170

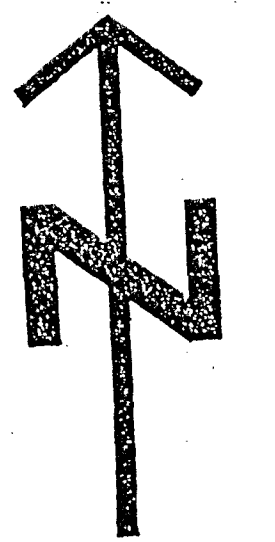

Z-100-64(147)

Z-120-90

BLADOCK BUILDING		
SCALE: 1/4" = 1'	APPROVED BY: JOHN BRINER	DRAWN BY: BRINER
DATE: 9-24-90	REVISED	
DRAWING NUMBER D 1		