


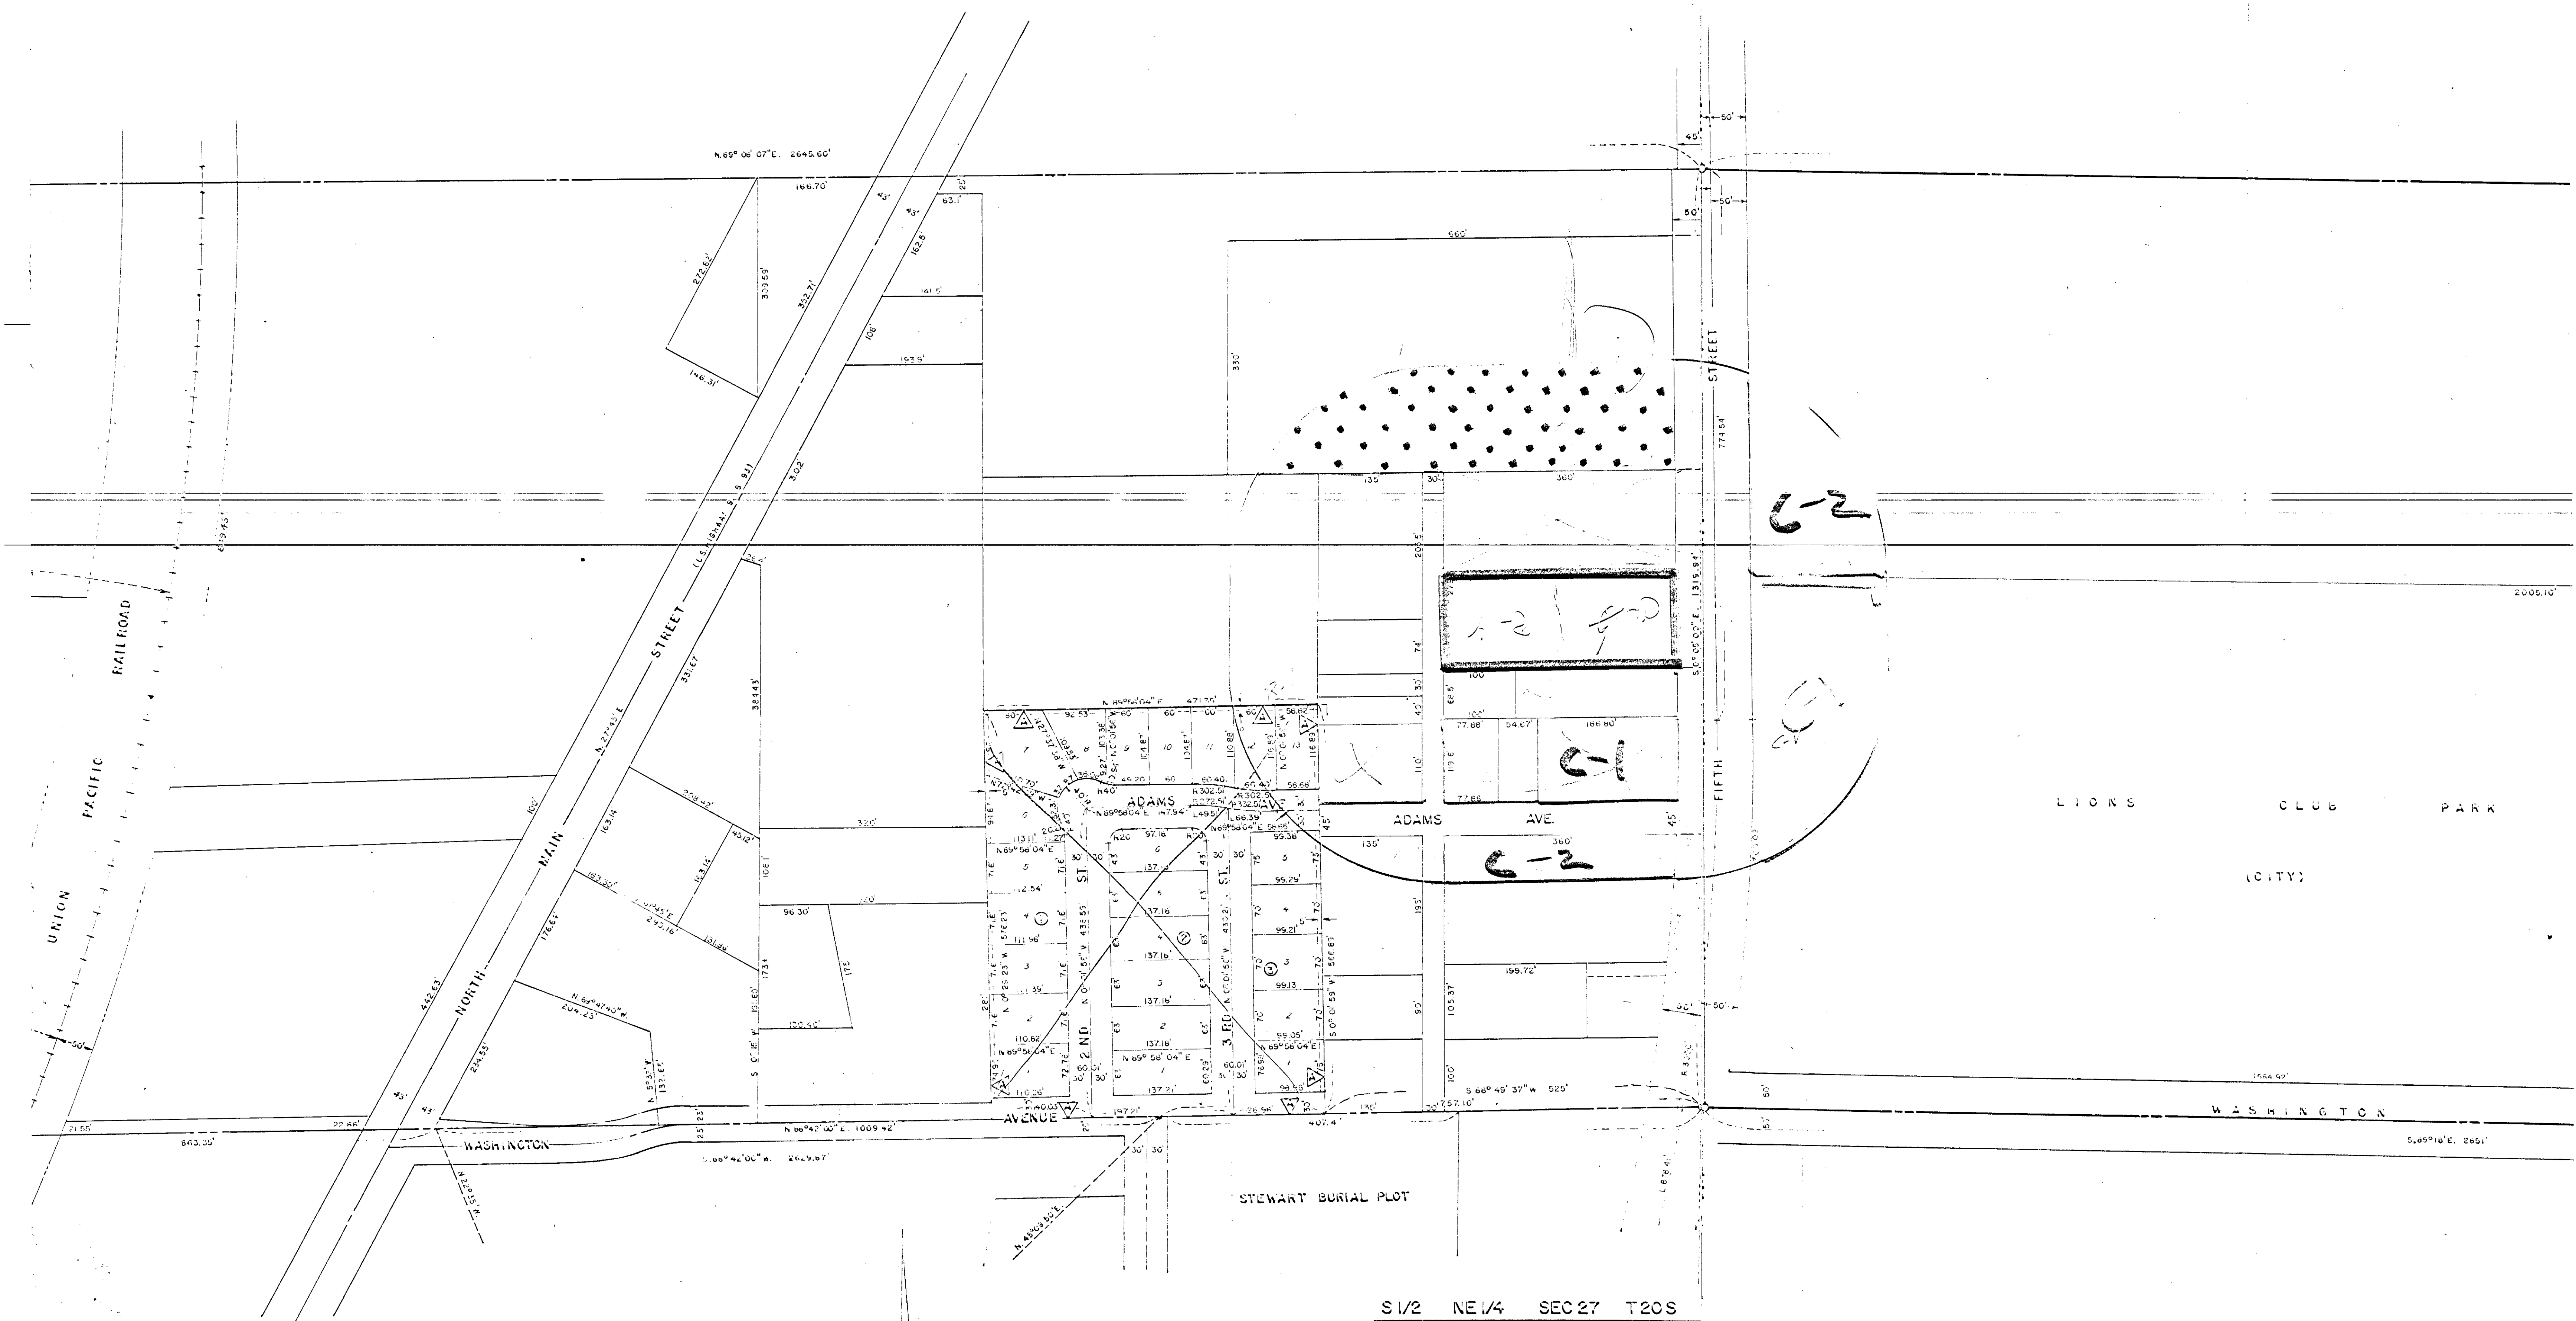

EDGEVIEW MANOR

S 1/2 NE 1/4 SEC 27 T20S  
CITY OF LAS VEGAS NV  
ENGINEERING DEPT.  
DISTRICT MAP - SHEET NO. 3

|               |      |            |
|---------------|------|------------|
| DESIGNED BY   | DATE | SCALE      |
| DRAWN BY E.R. |      | FIELD BOOK |
| CHECKED BY    |      | WORK ORDER |
| APPROVED      |      | DRAWING    |
| CITY ENGR.    |      |            |

Z-121-62

Z-121-62  
LEGAS VALLEY CORP  
R. V. TO C. 2-1-62

Z-121