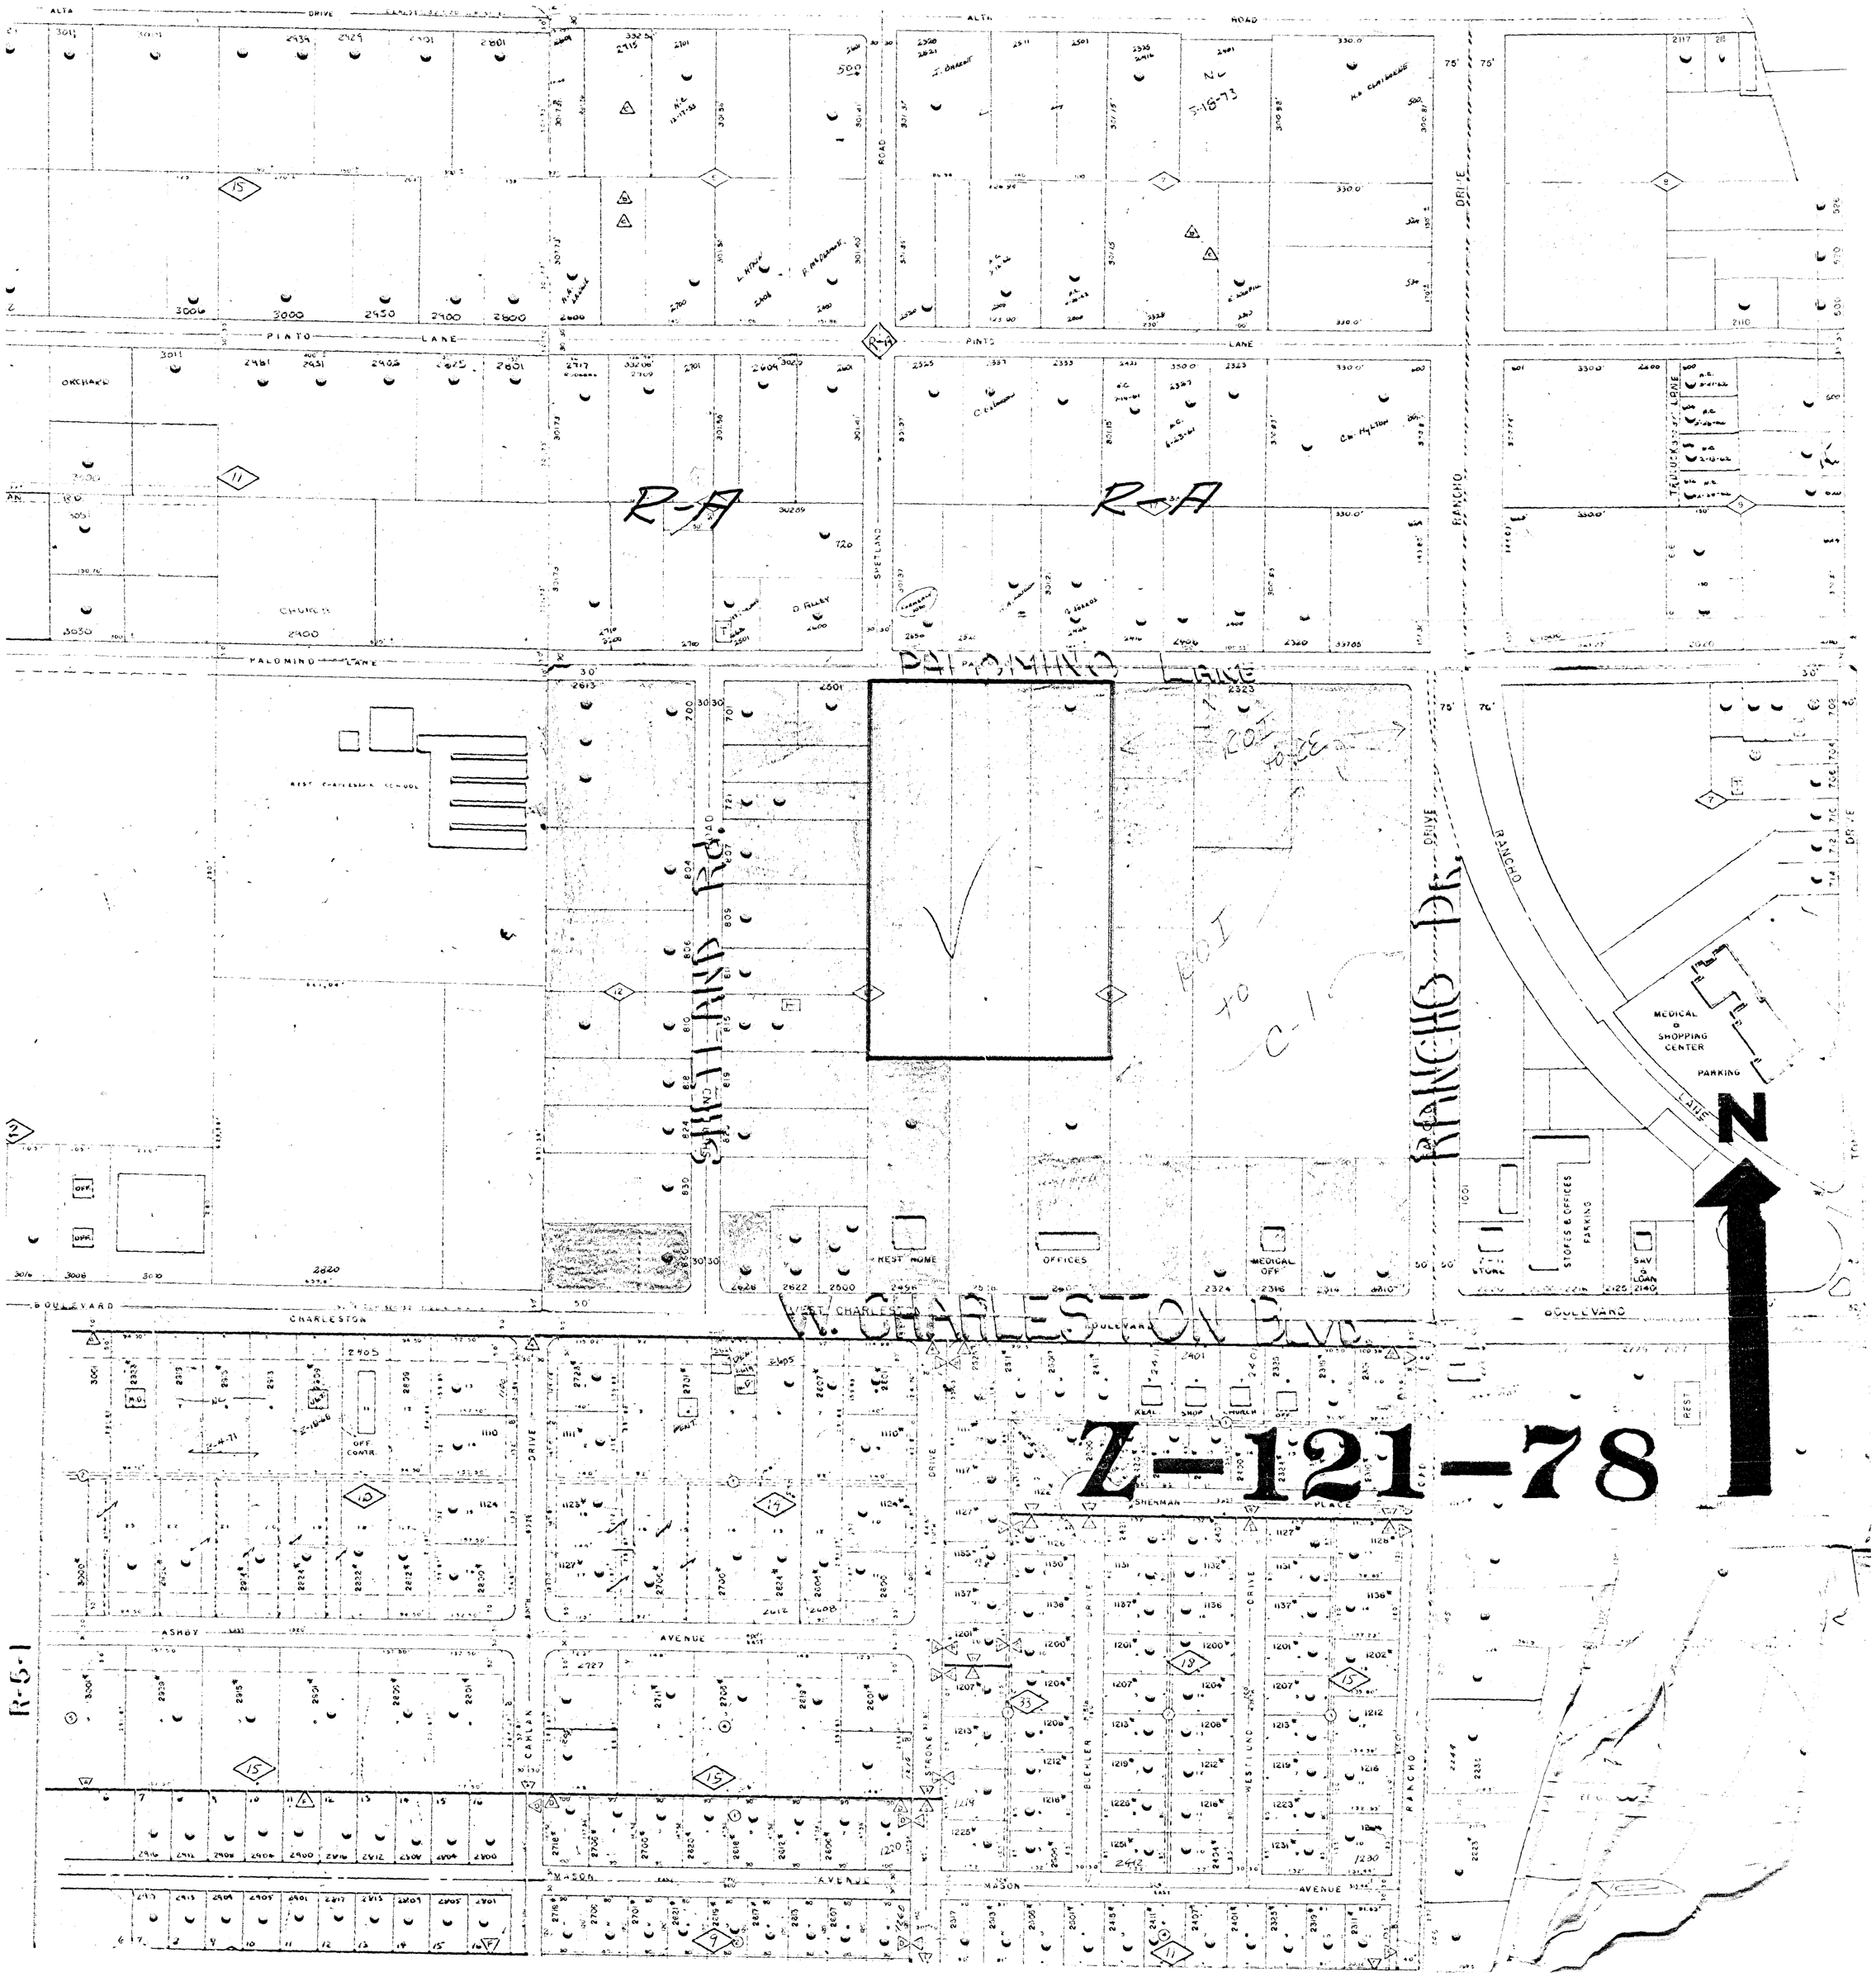
Z-121-78
N
R-A
R-A
R-5-1
ALTA DRIVE
ALTA ROAD
PINTO LANE
PALOMINO LANE
PALOMINO LANE
SHETLAND ROAD
RANCHO DRIVE
CHURCH
WEST CHARLESTON SCHOOL
REST HOME
OFFICES
MEDICAL OFFICE
MEDICAL & SHOPPING CENTER
PARKING
STORE
STORES & OFFICES
PARKING
SAV & LOAN
W. CHARLESTON BLVD
CHARLESTON BOULEVARD
BOULEVARD
ASHBY AVENUE
MASON AVENUE
SHERMAN PLACE
CARLAN DRIVE
STRONG DRIVE
BUEHLER DRIVE
WESTLAND DRIVE
REAL ESTATE
CHURCH
REST

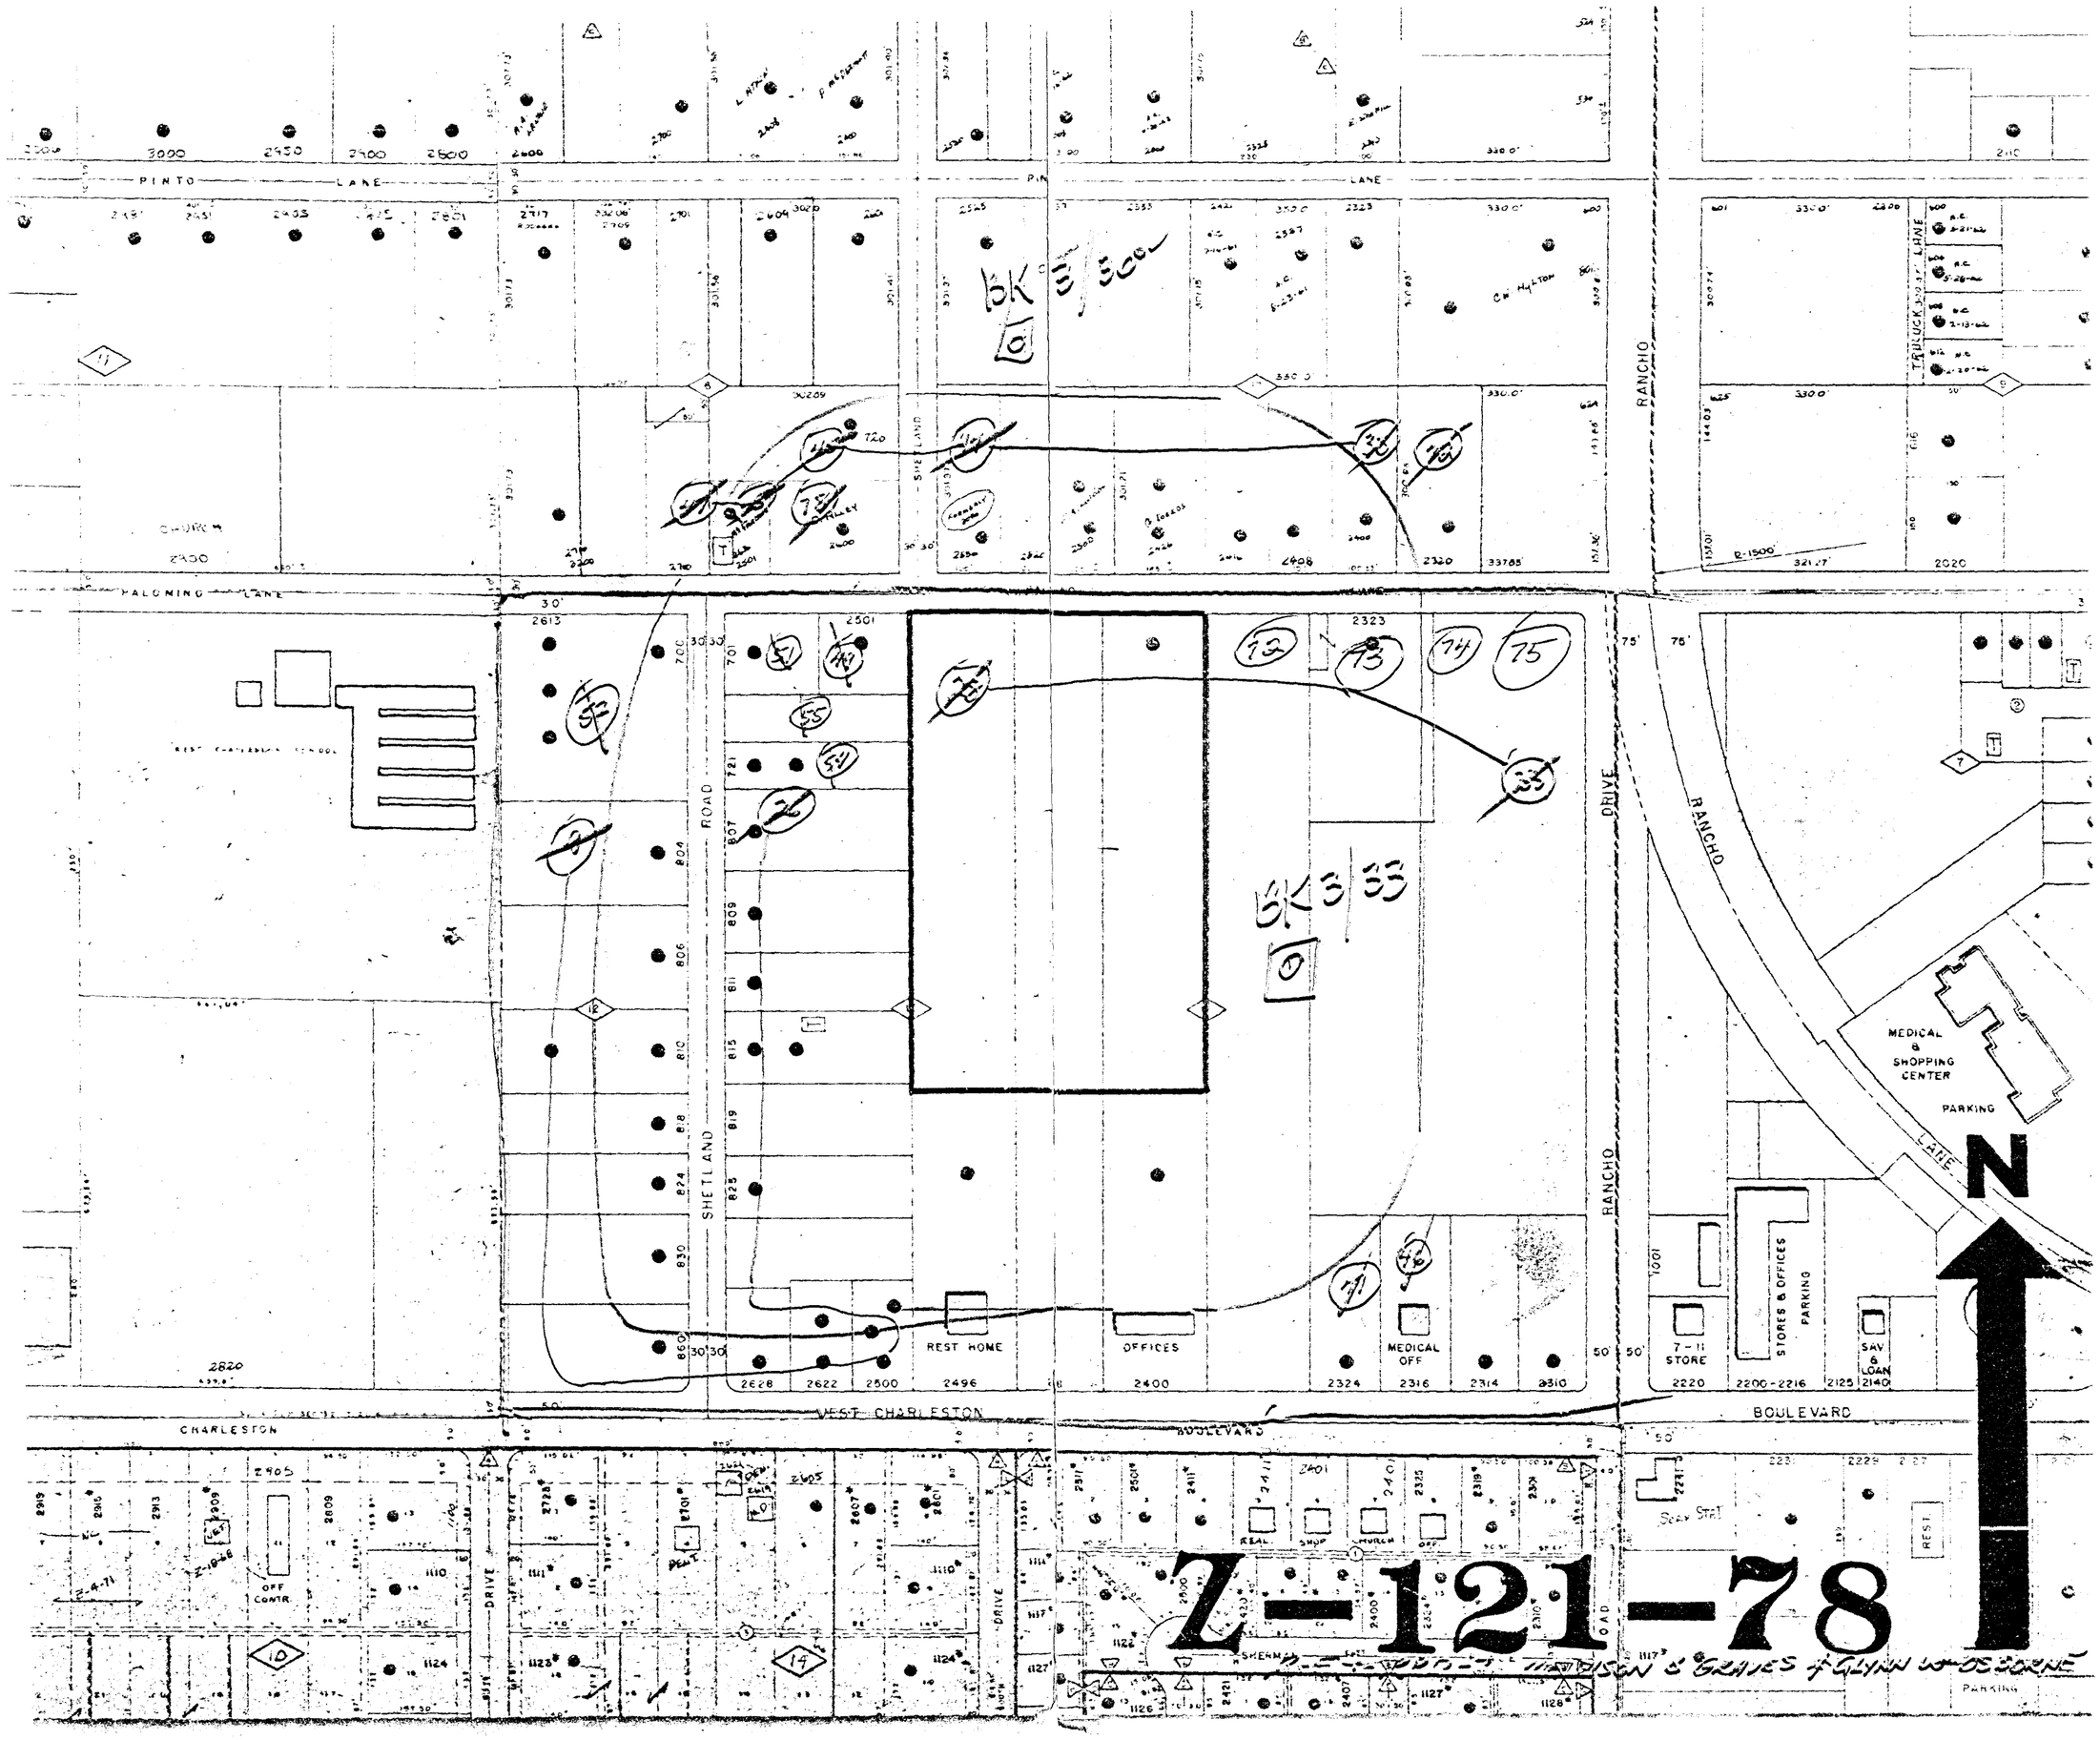
PINTO LANE
PALOMINO LANE
SHETLAND ROAD
RANCHO DRIVE
RANCHO LANE
TRUCK LANE
CHARLESTON BOULEVARD
WEST CHARLESTON BOULEVARD
REST HOME
OFFICES
MEDICAL OFF
7-11 STORE
STORES & OFFICES
PARKING
SAV & LOAN
MEDICAL & SHOPPING CENTER
PARKING
OFF CONTR
REAL
SHOP
CHURCH
REST
BK 3/33
Z-121-78
N