



Per Packer Application

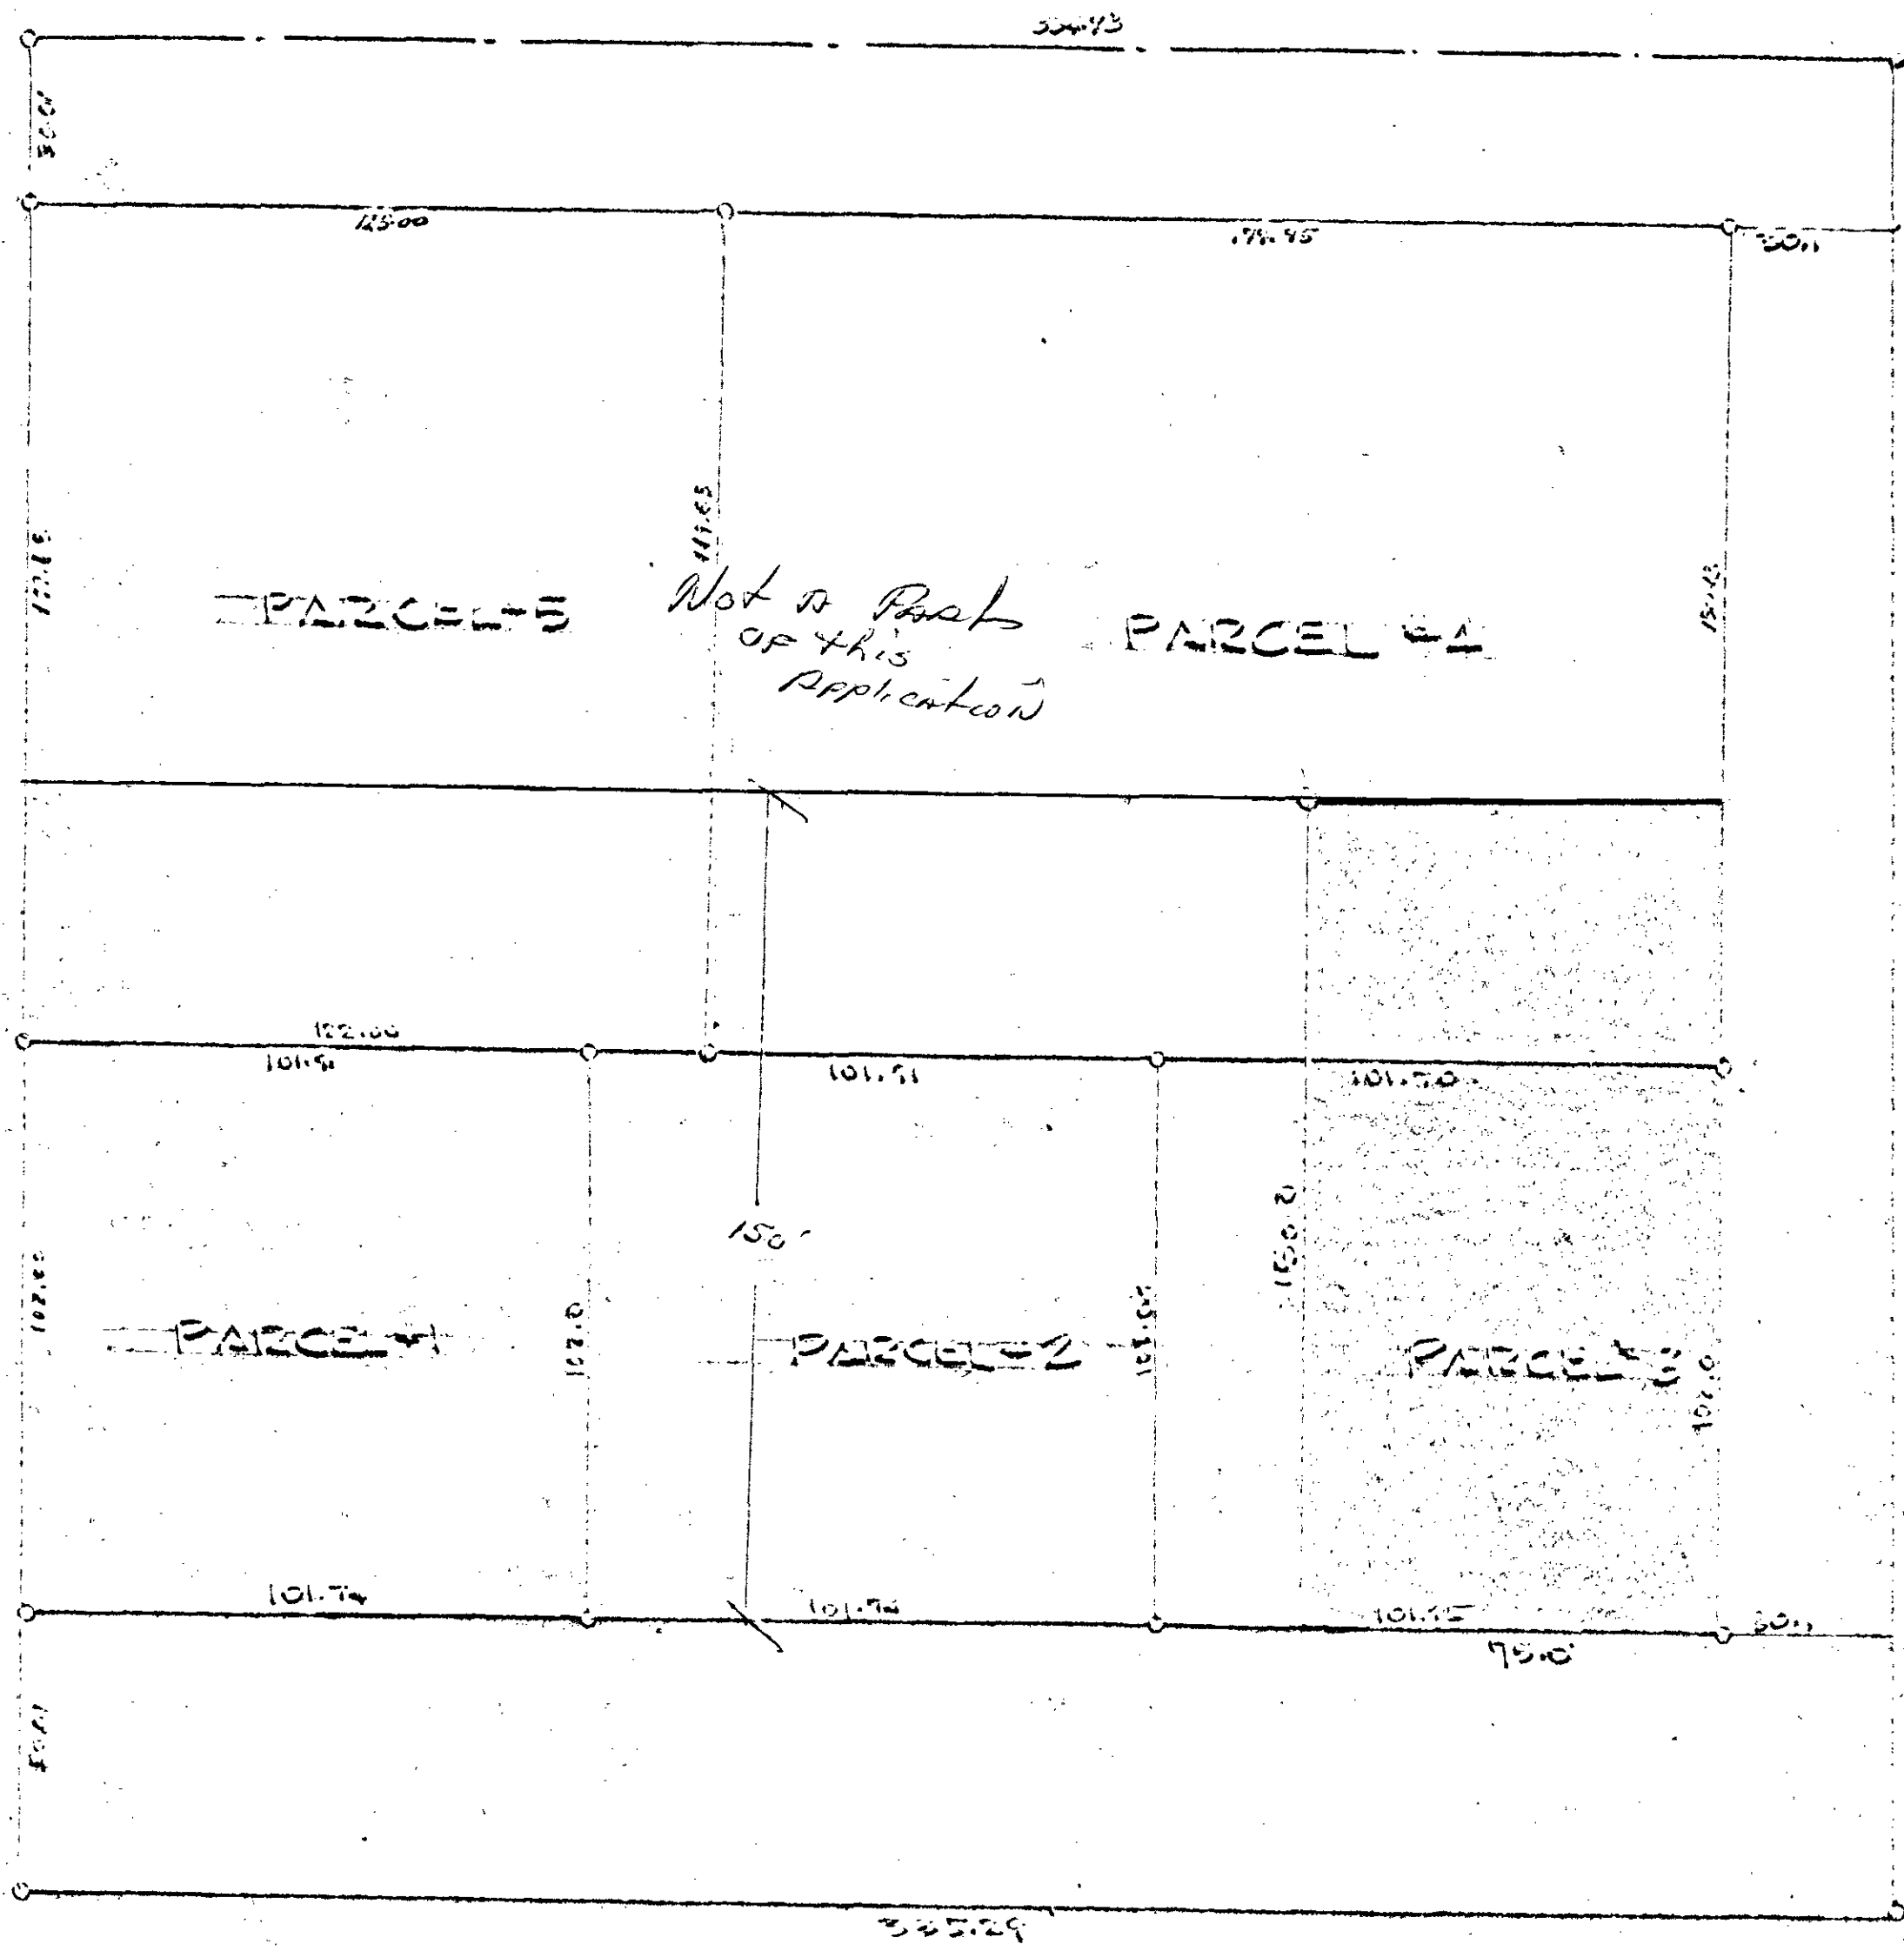


WEST CHARLESTON BLVD

BRUSH STREET

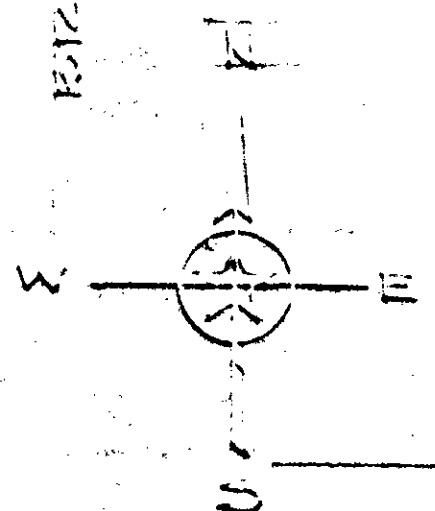

PLOT PLAN
(As Shown on Map)
Scale: 1" = 200'


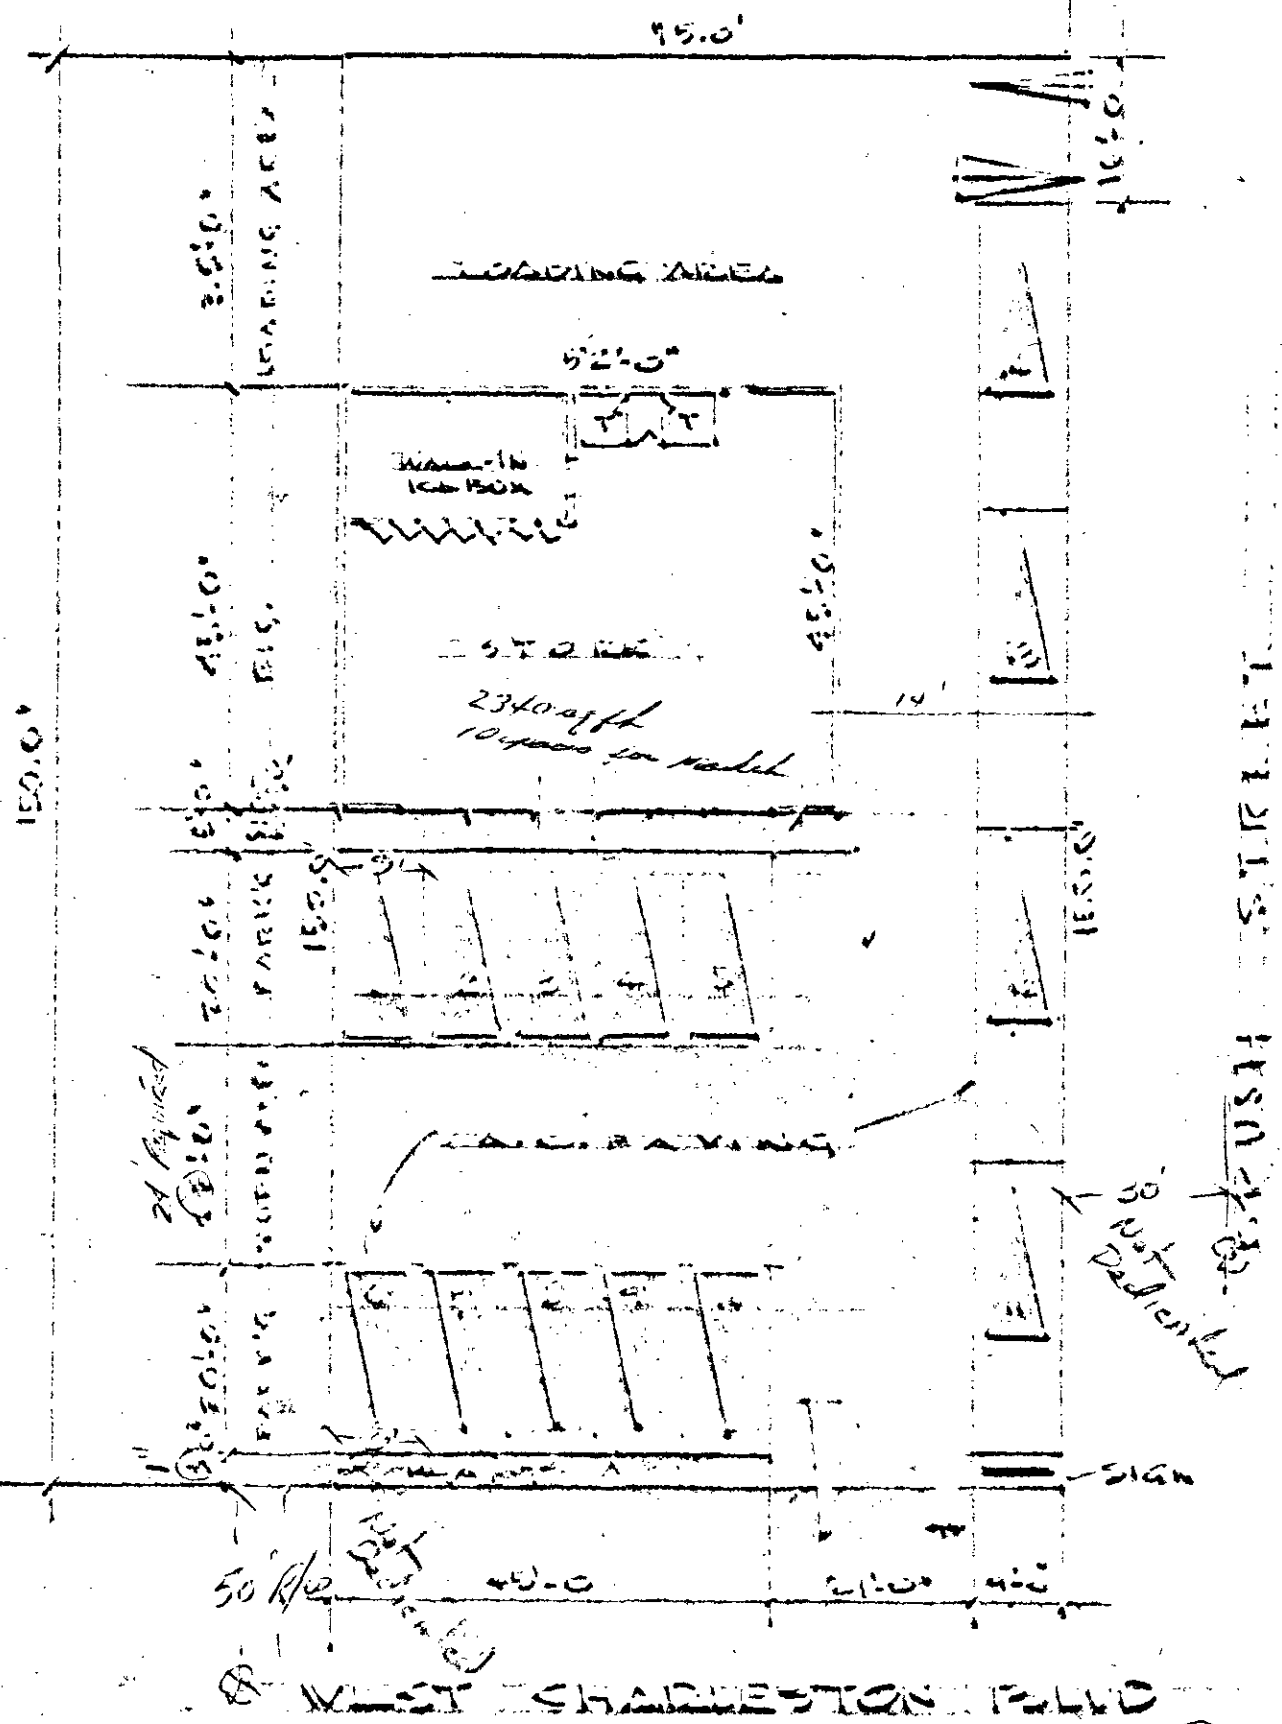

WEST CHARLESTON BLVD

123
ORIG.

PLOT PLAN - 1/200'

FOR STOP N' CO MARKET