



Per Rucker Application

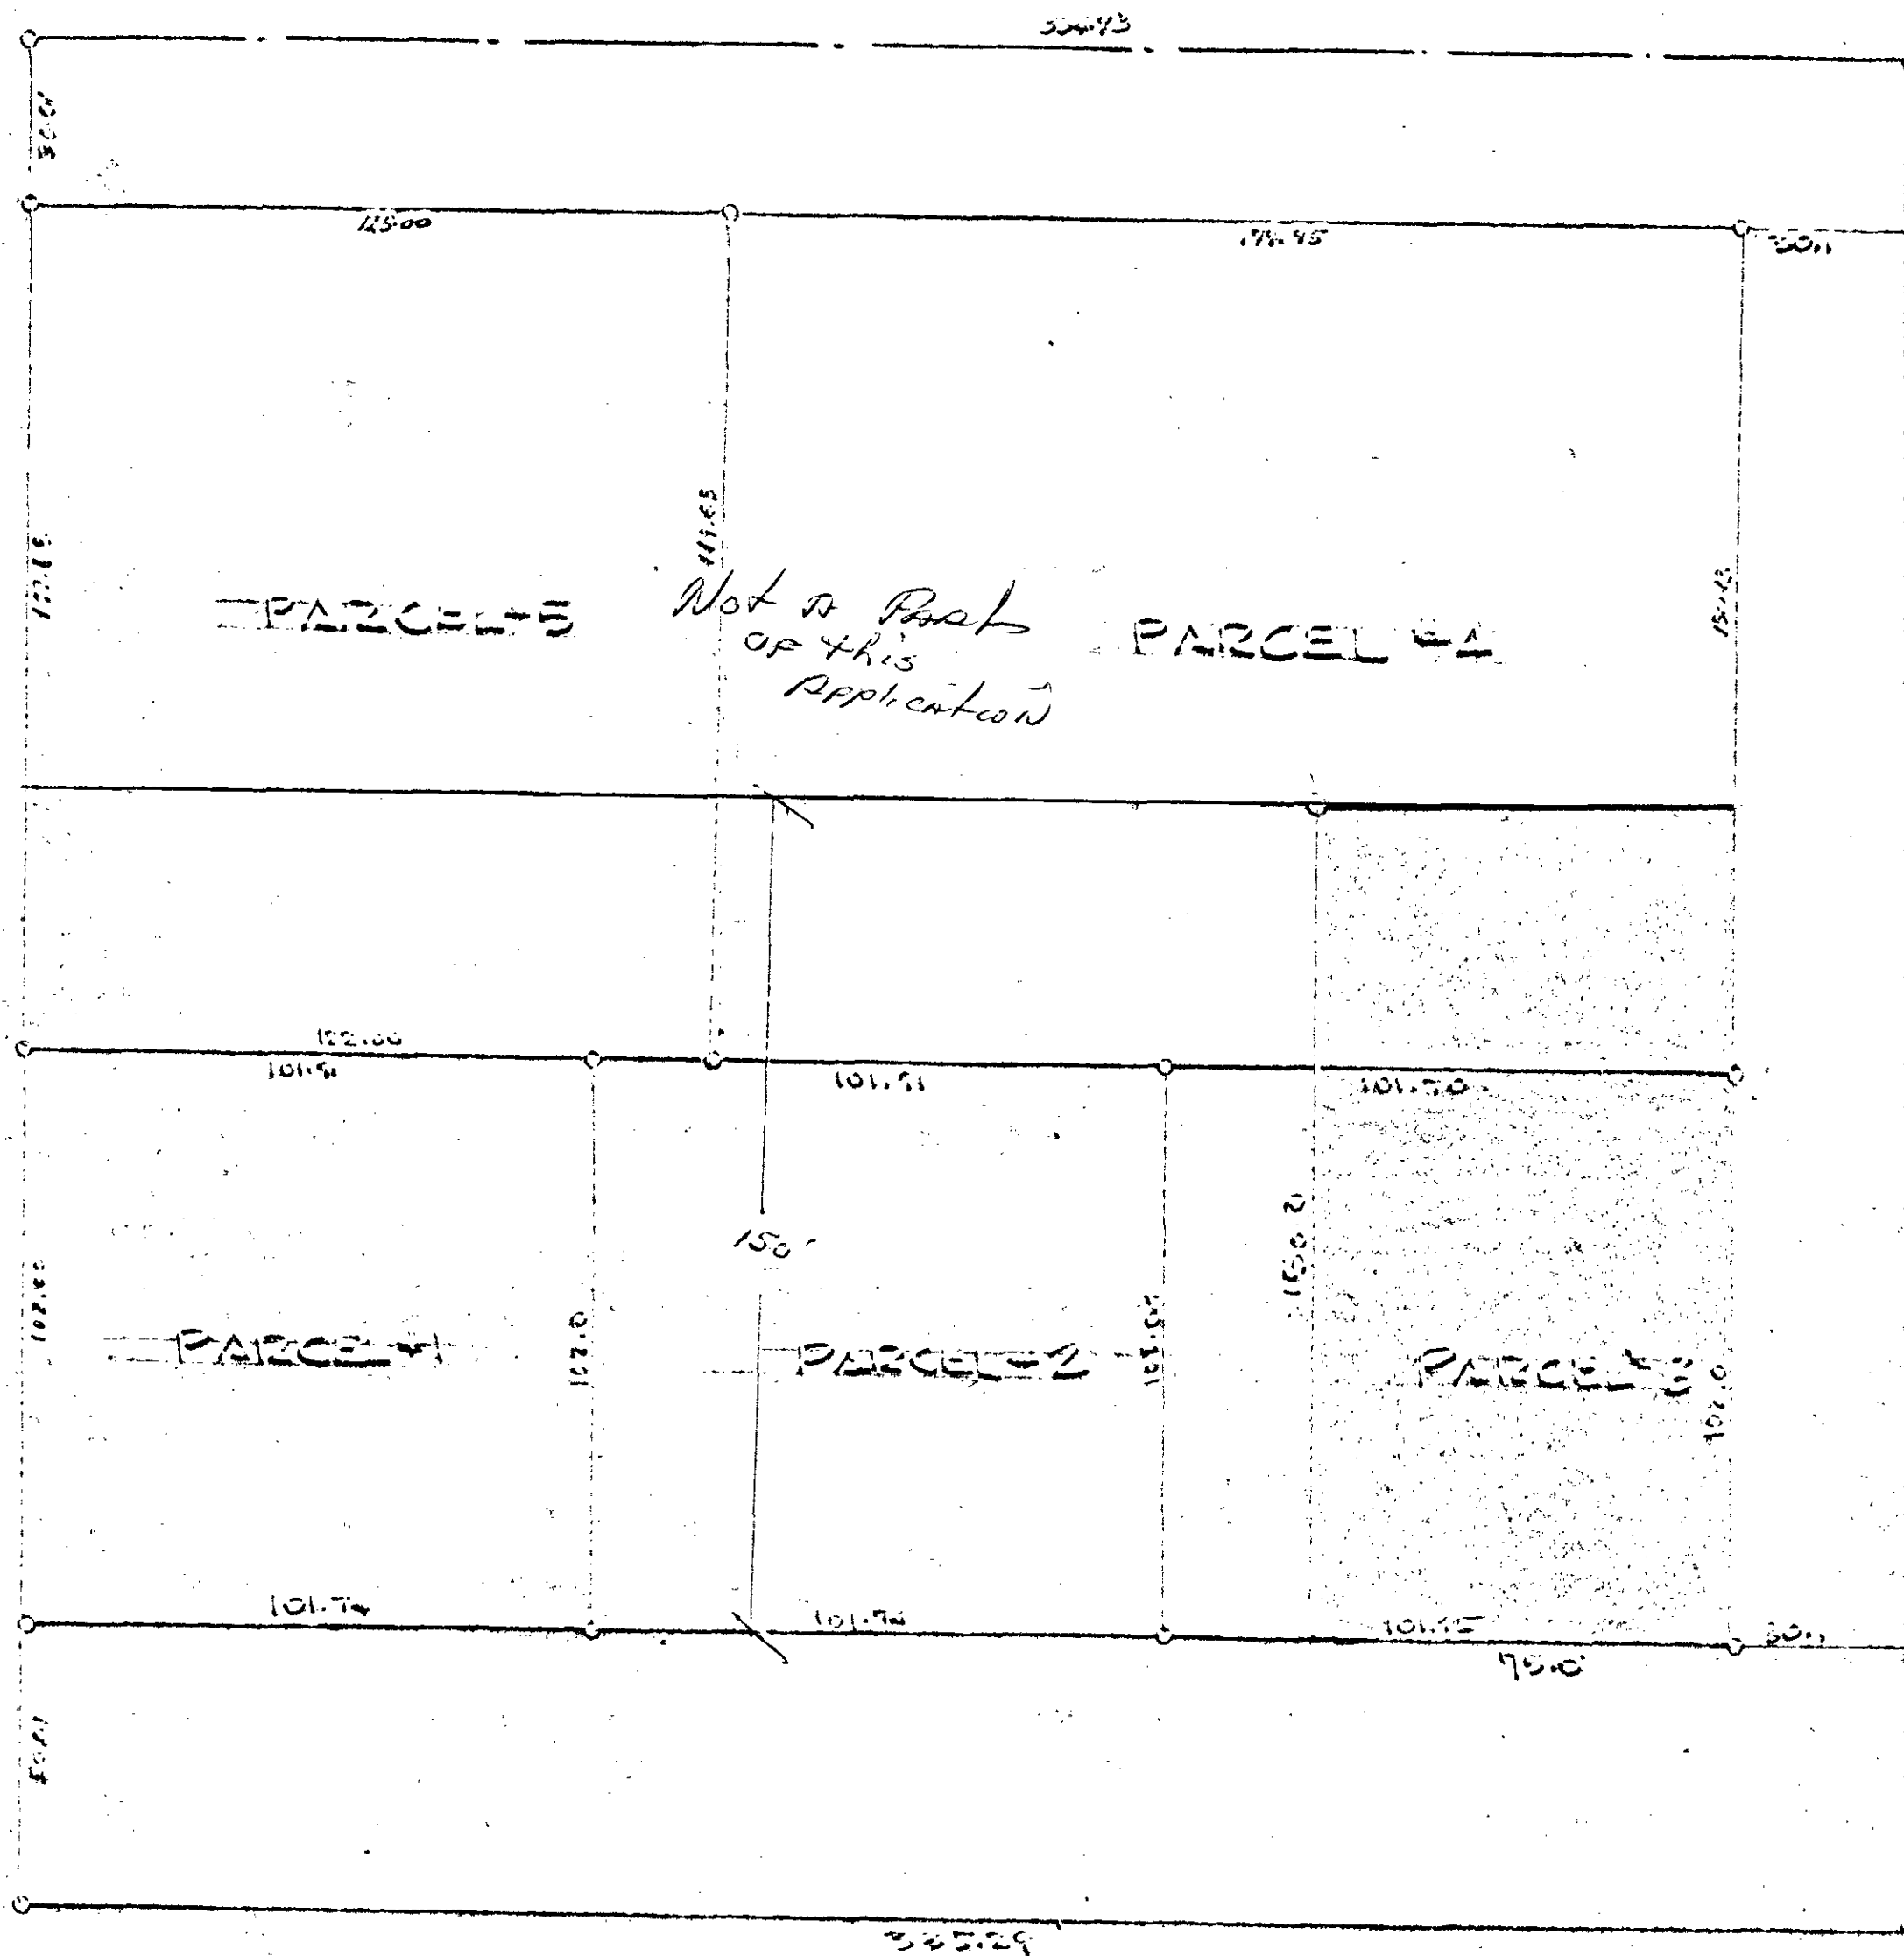


WEST CHARLESTON BLVD

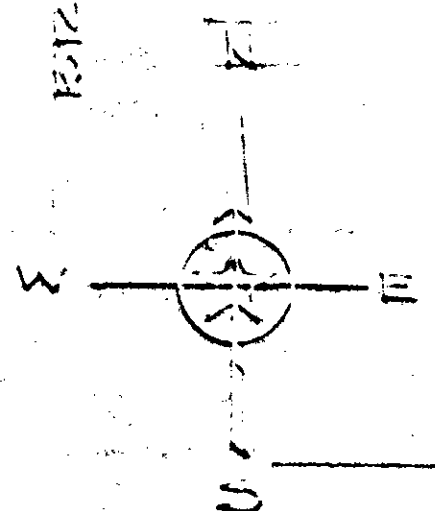

PLOT PLAN
Scale: 1" = 20.0'


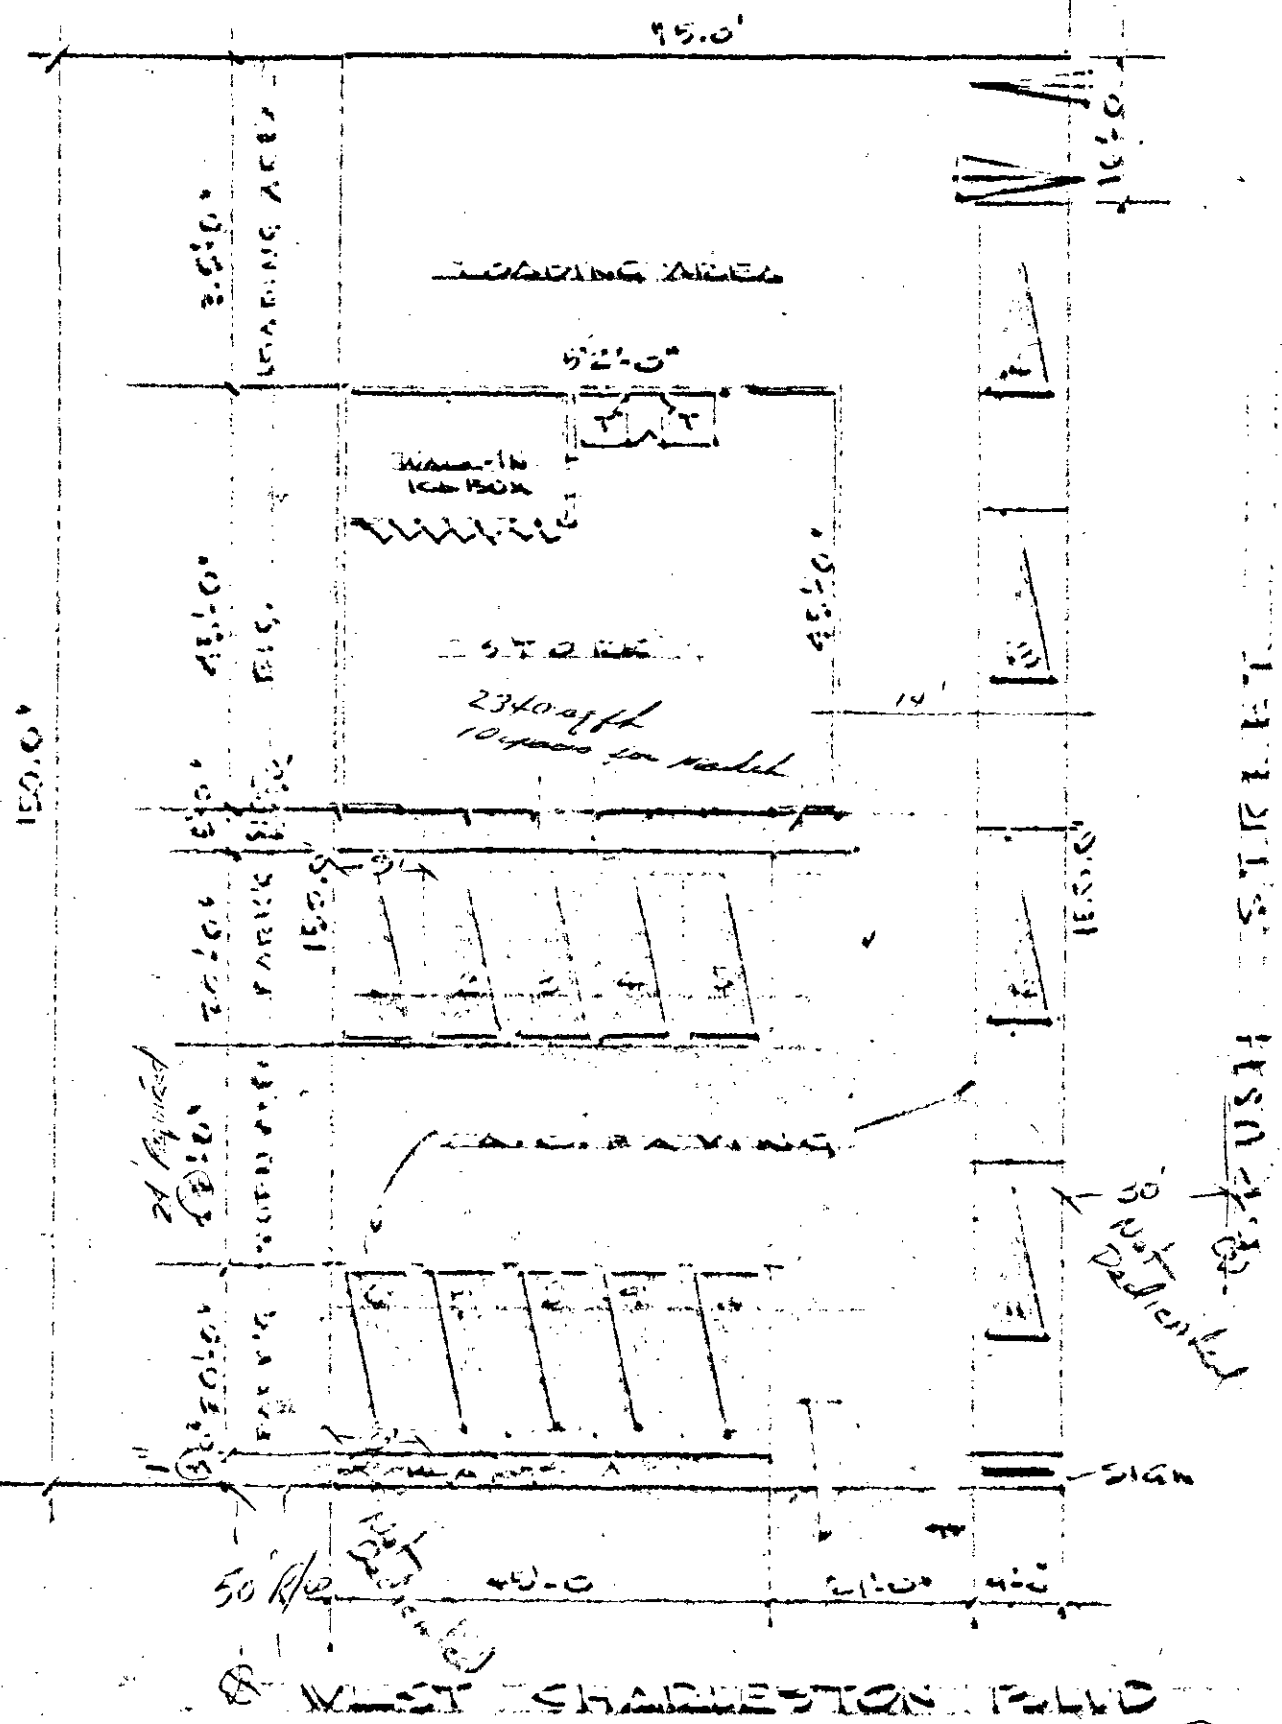

WEST CHARLESTON BLVD

PLOT PLAN - Scale: 1" = 20.0'

FOR STOP N' CO MARKET

123

ORIG.