


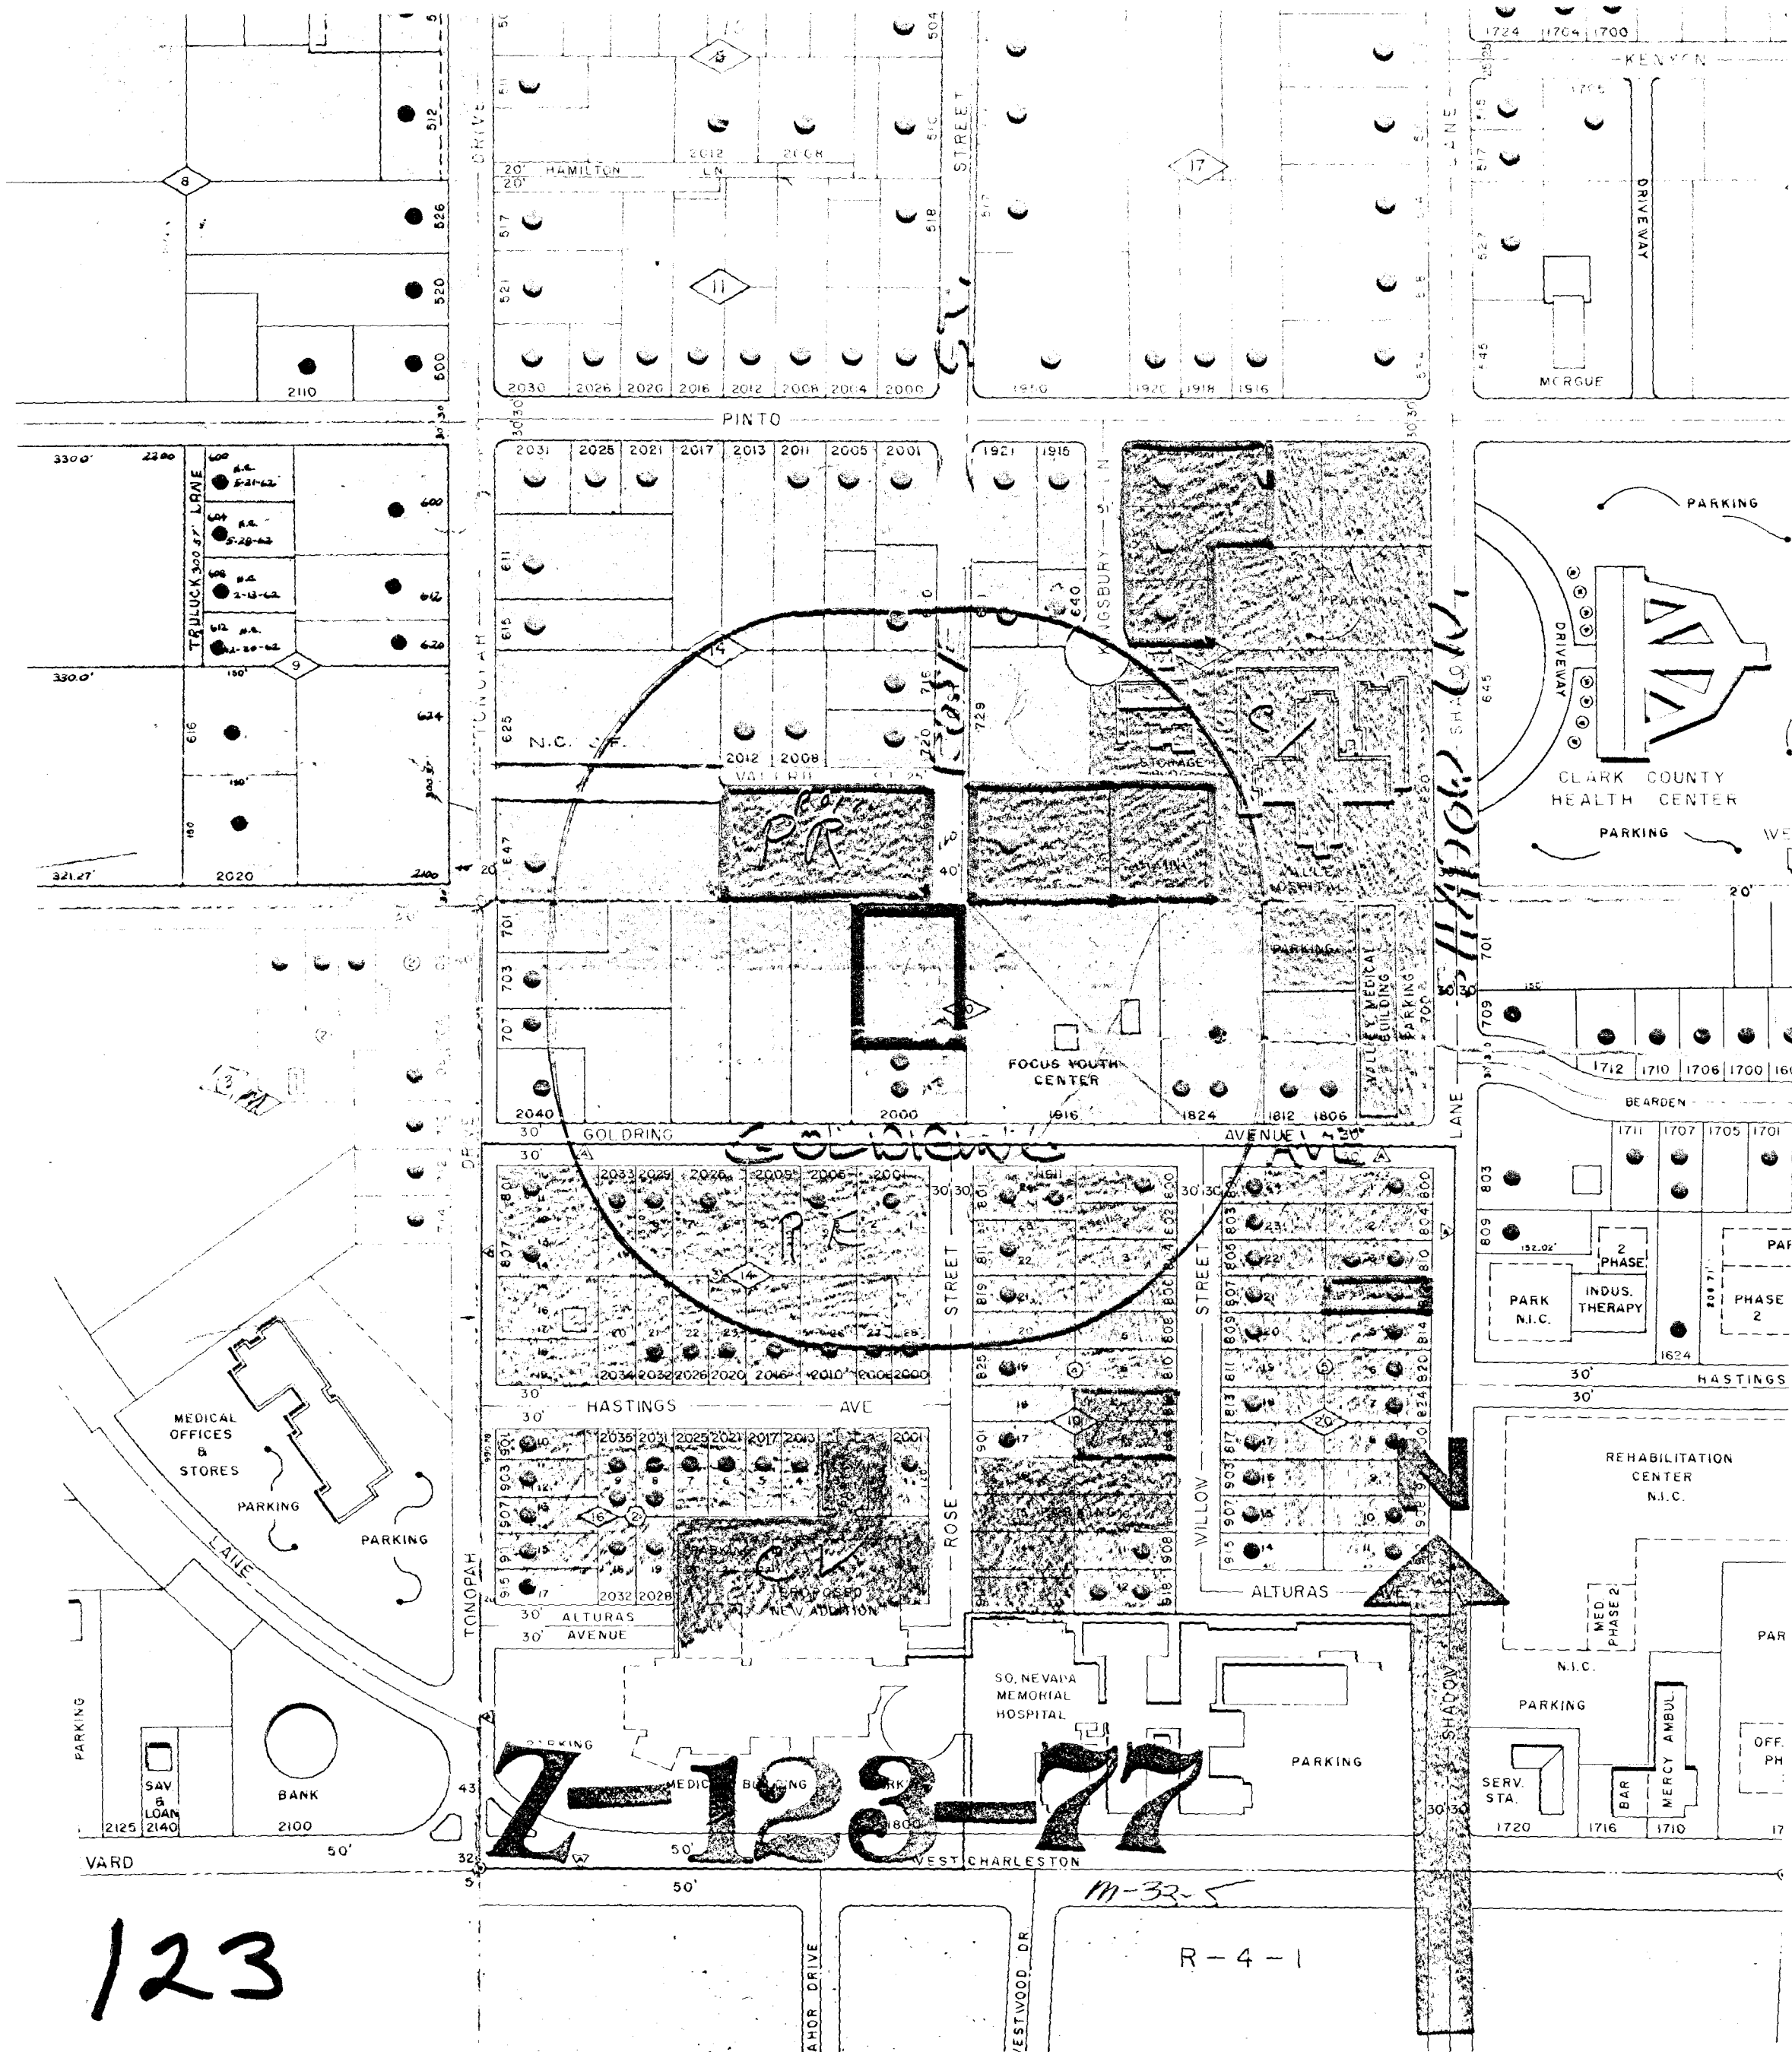

123

R-4-1