

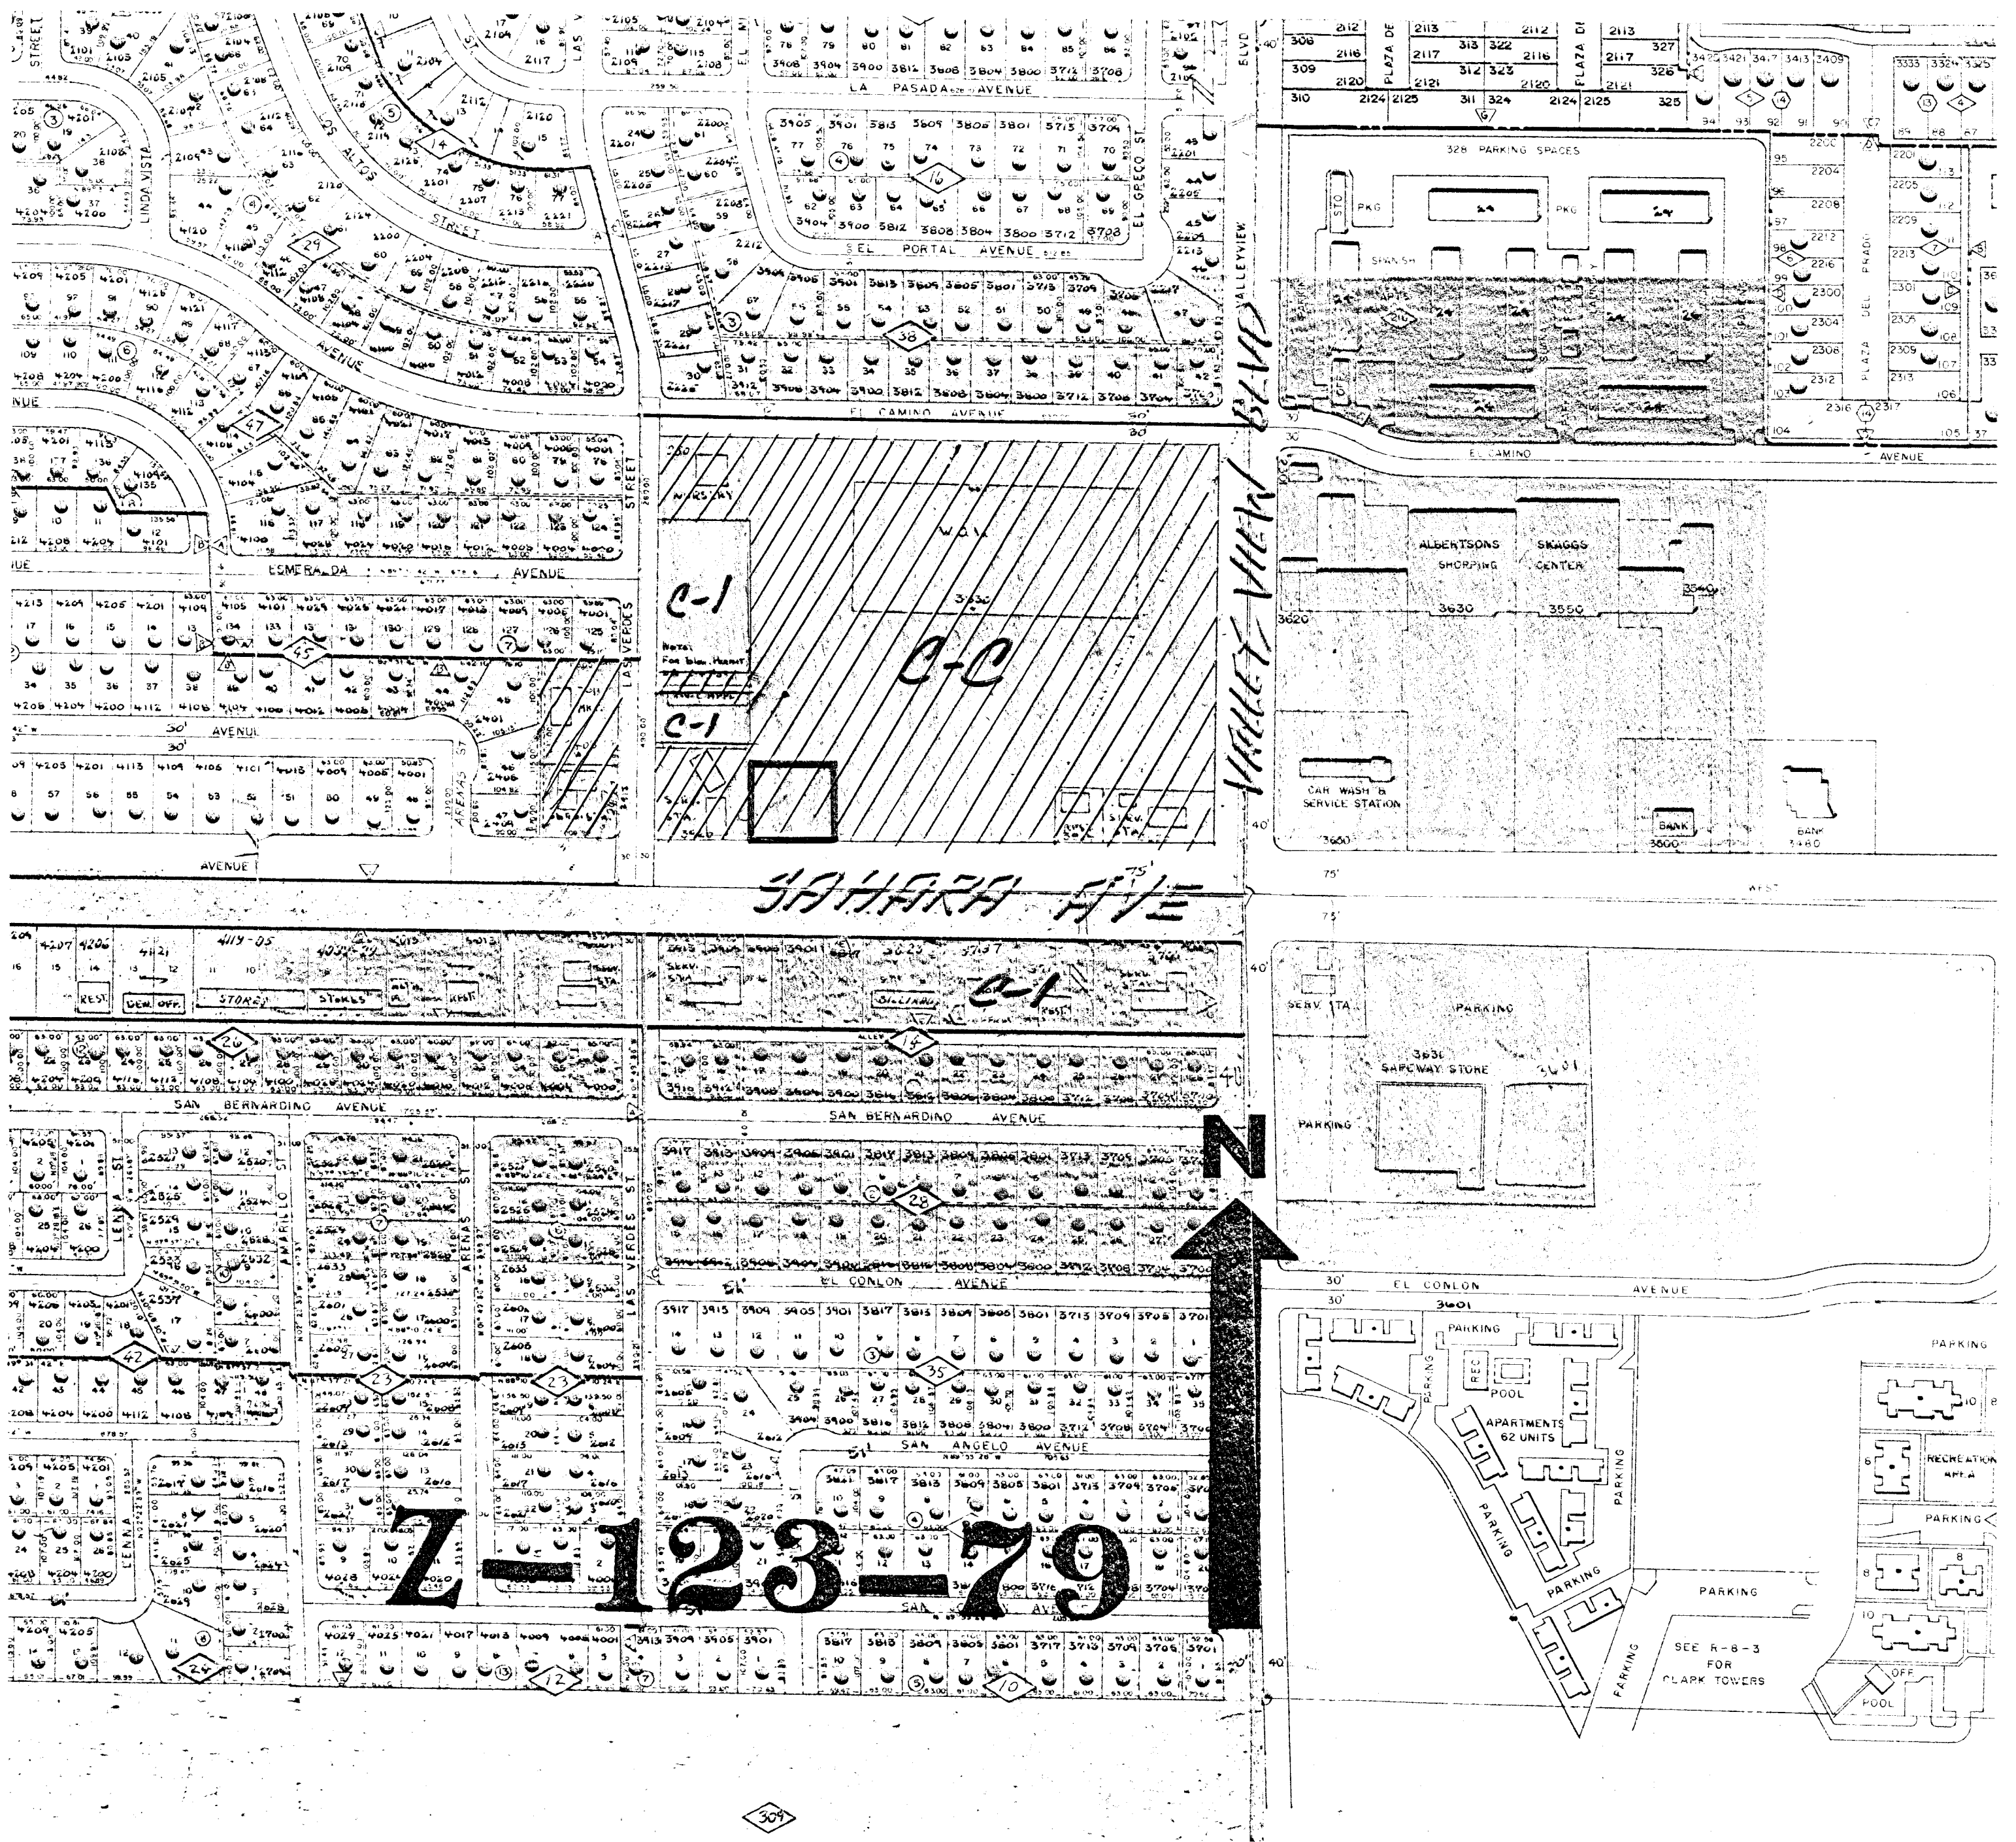


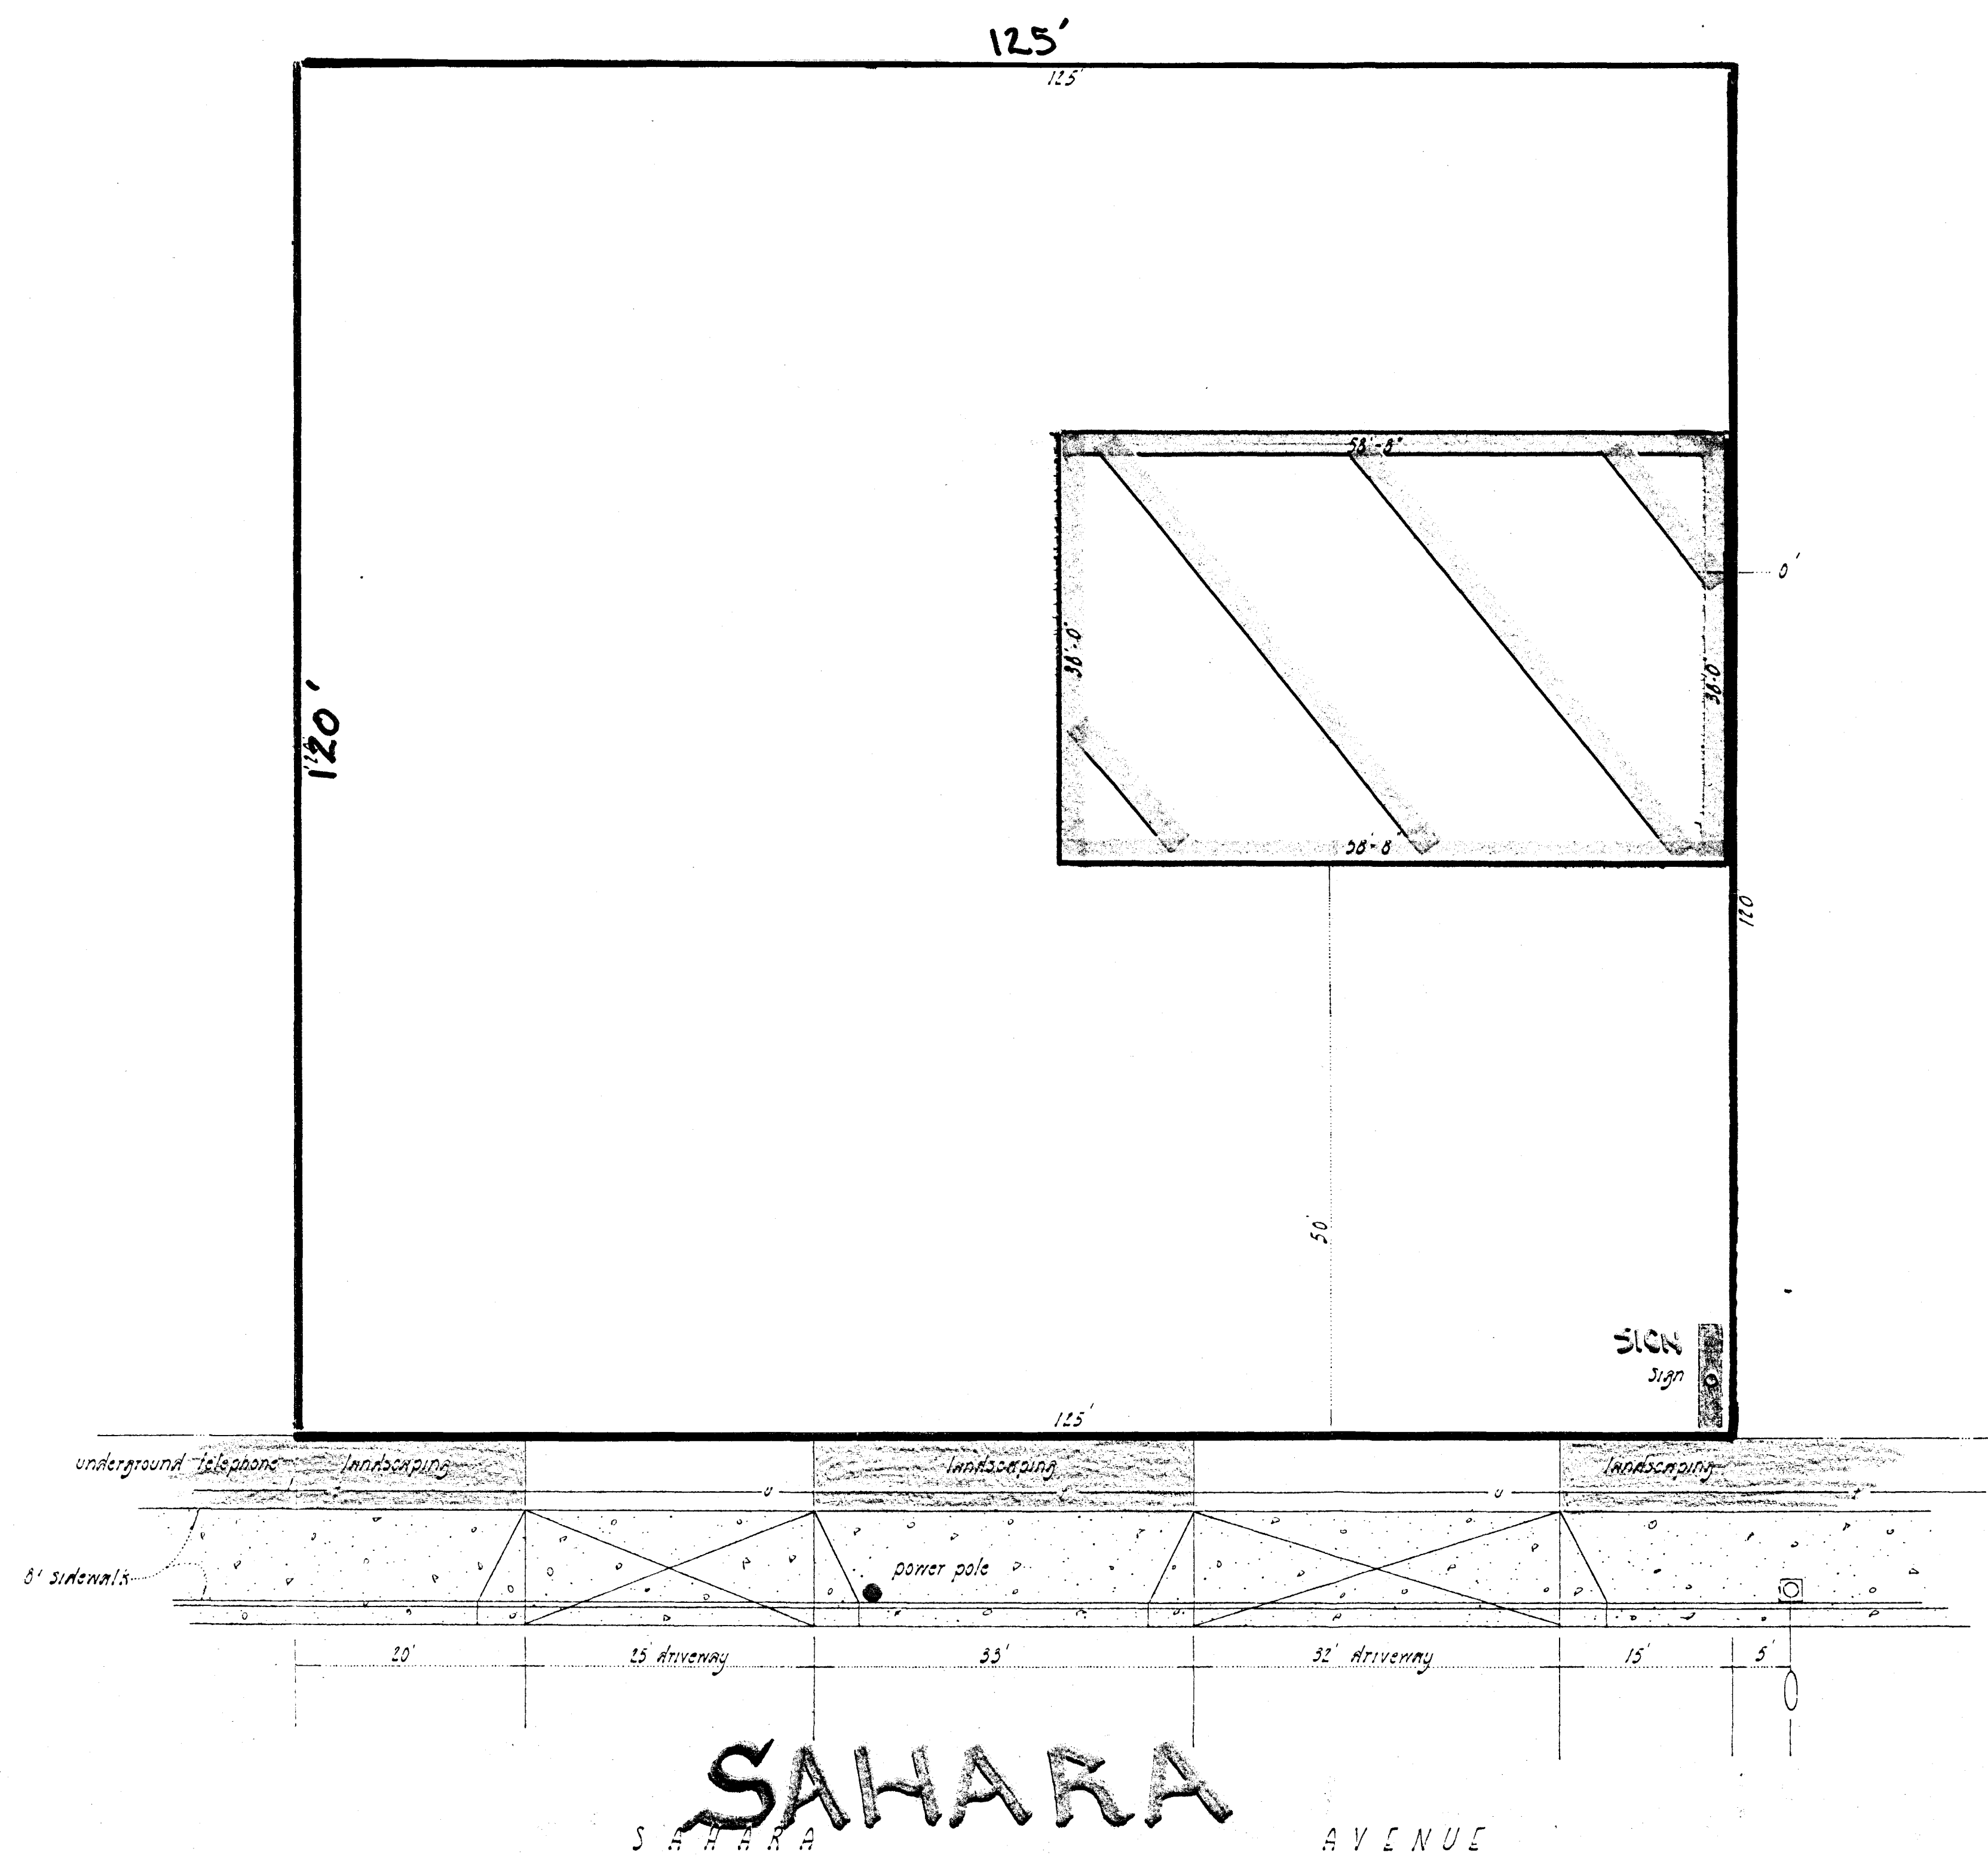

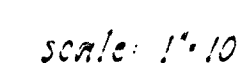

PT. SE4 SECTION 6, T.21 S., R.61 E., M.D.M.


Z -123-79

7.12370

Revised 11-15-79 R.
7928

PC 11/25/7


scale 1"=10'

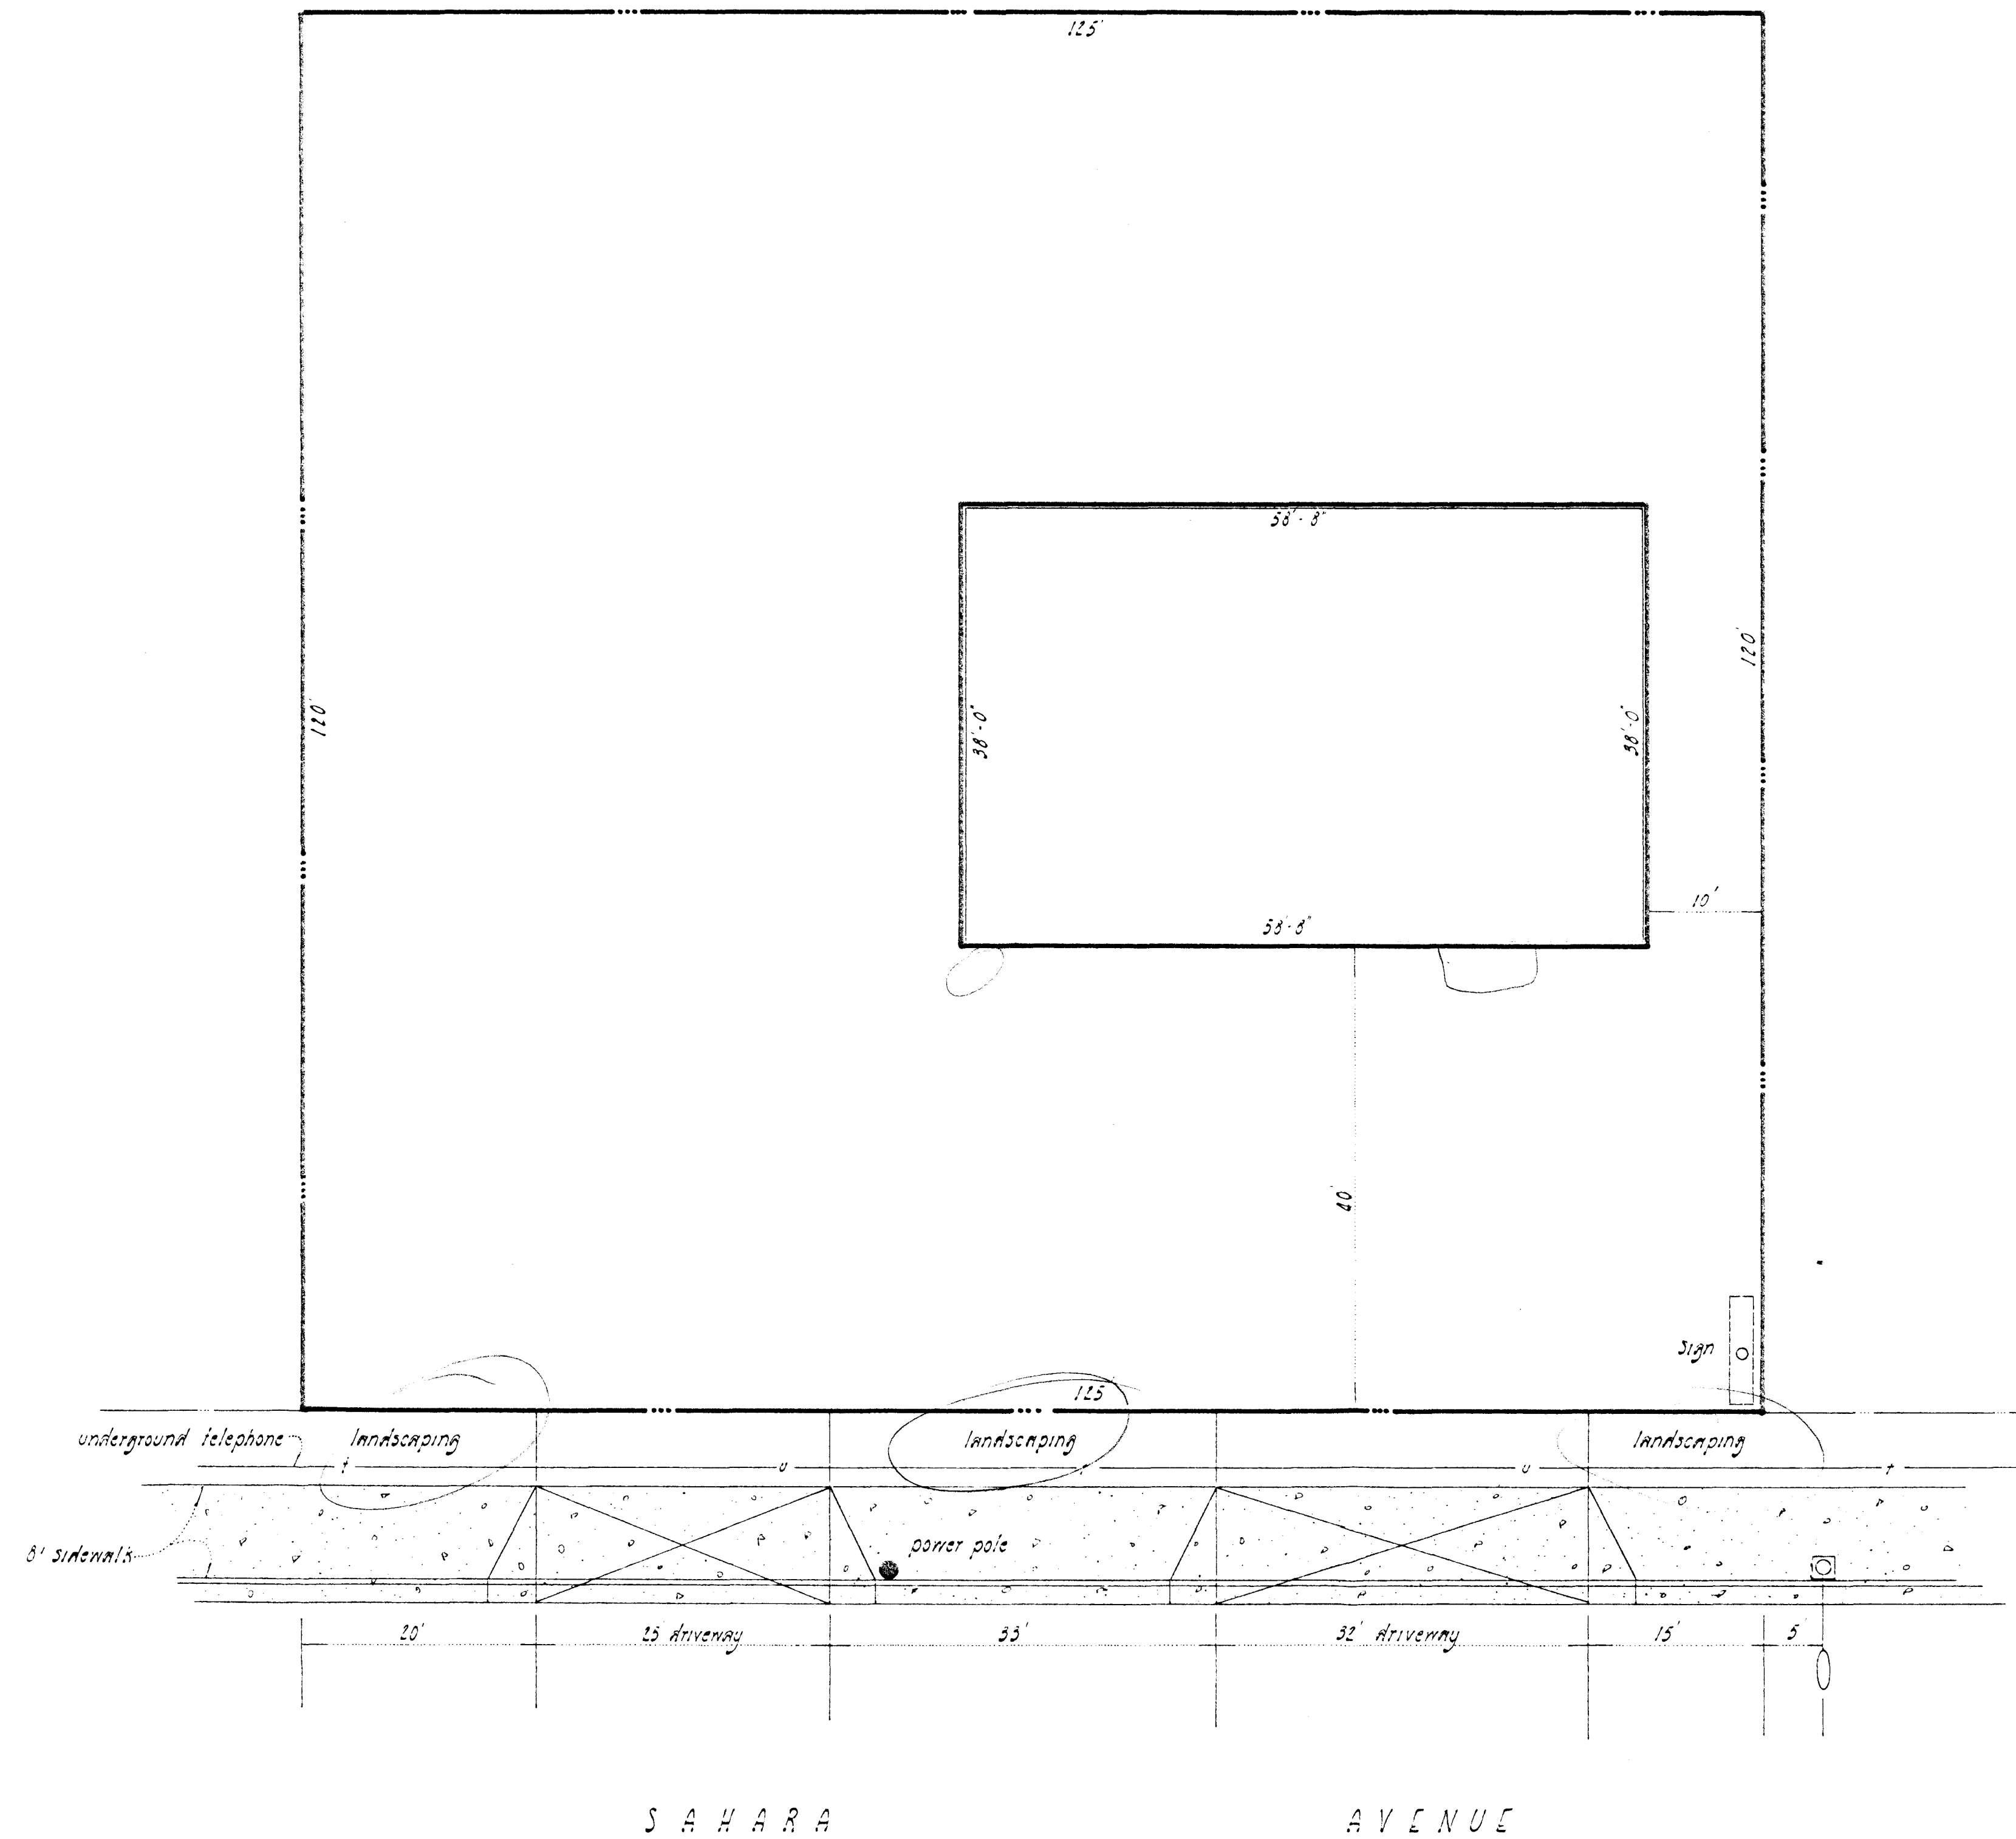


PLOT PLAN

PT. SE4 SECTION 6, T.21 S., R. 61 E., M. D. M.

SEE REVISED
TRAN.

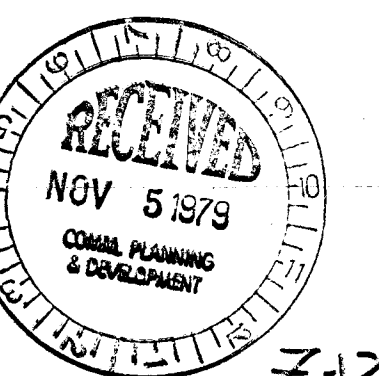


scale: 1"=10'

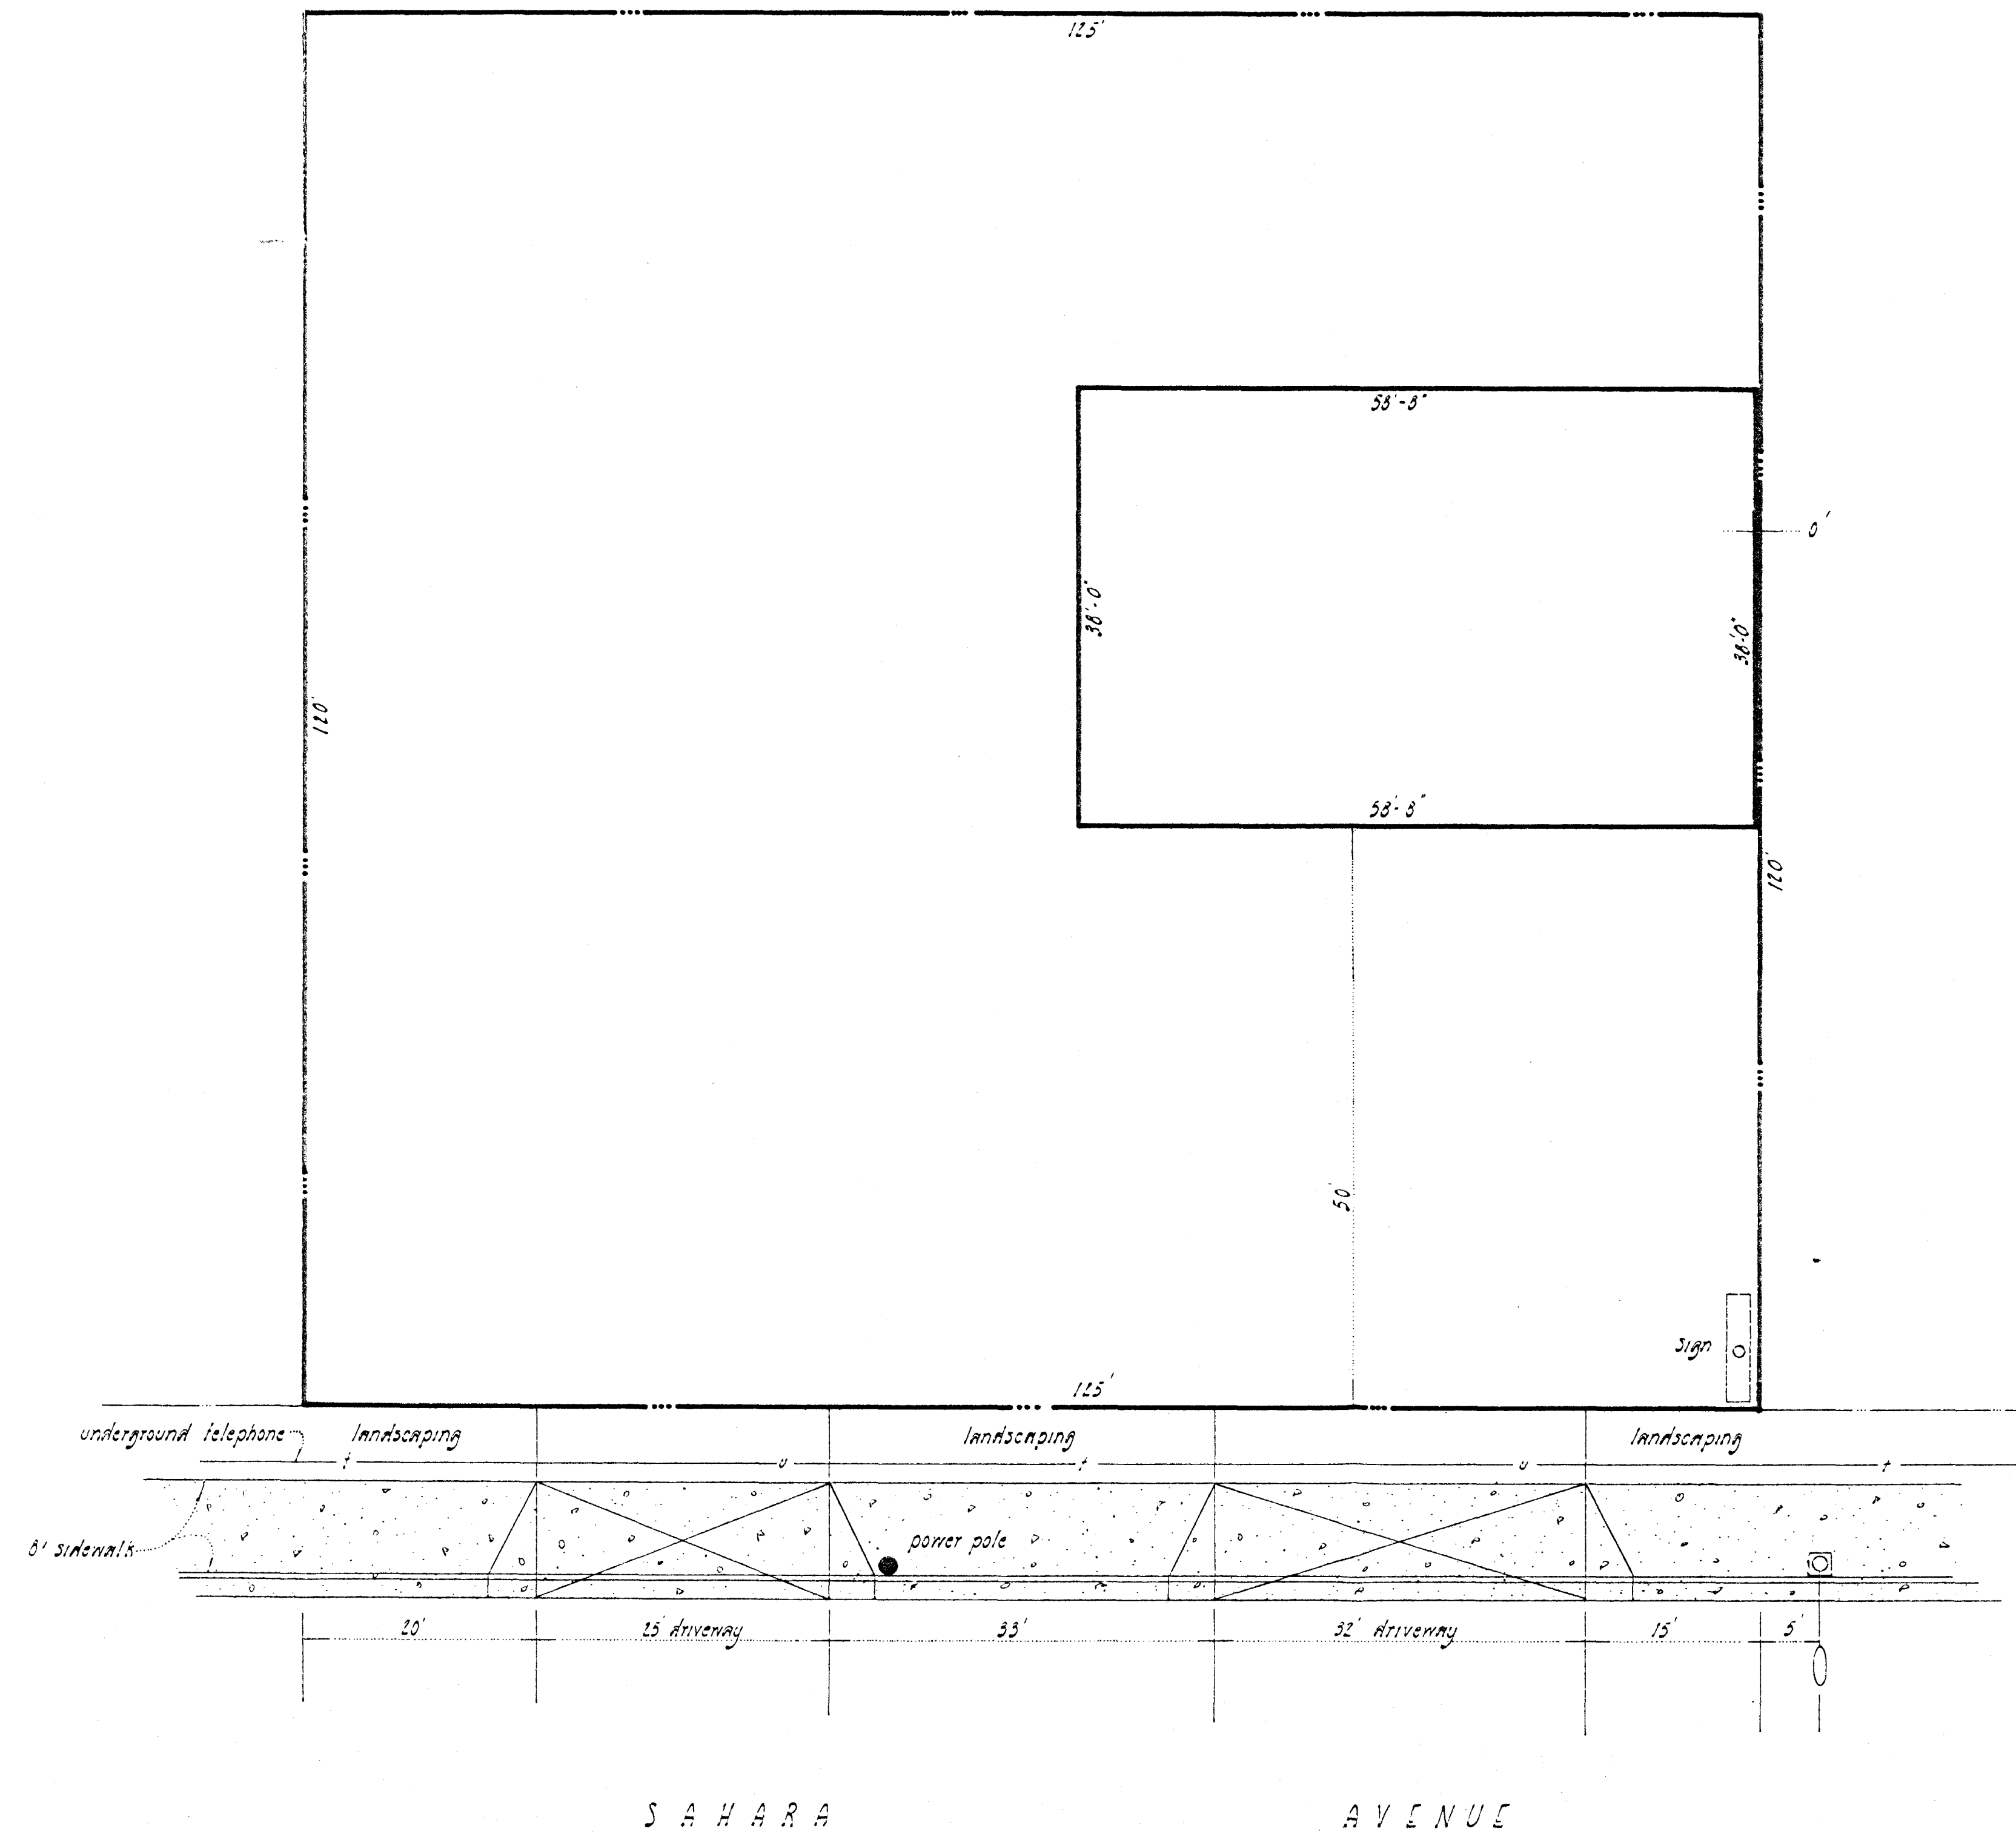

PLOT PLAN

PT. SE⁴ SECTION 6, T.21 S., R. 61 E., M. D. M.

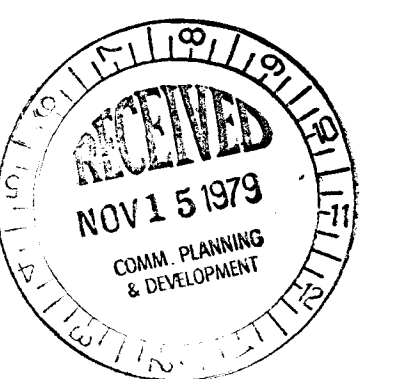

Rensel/HK 1979
Z-12379