


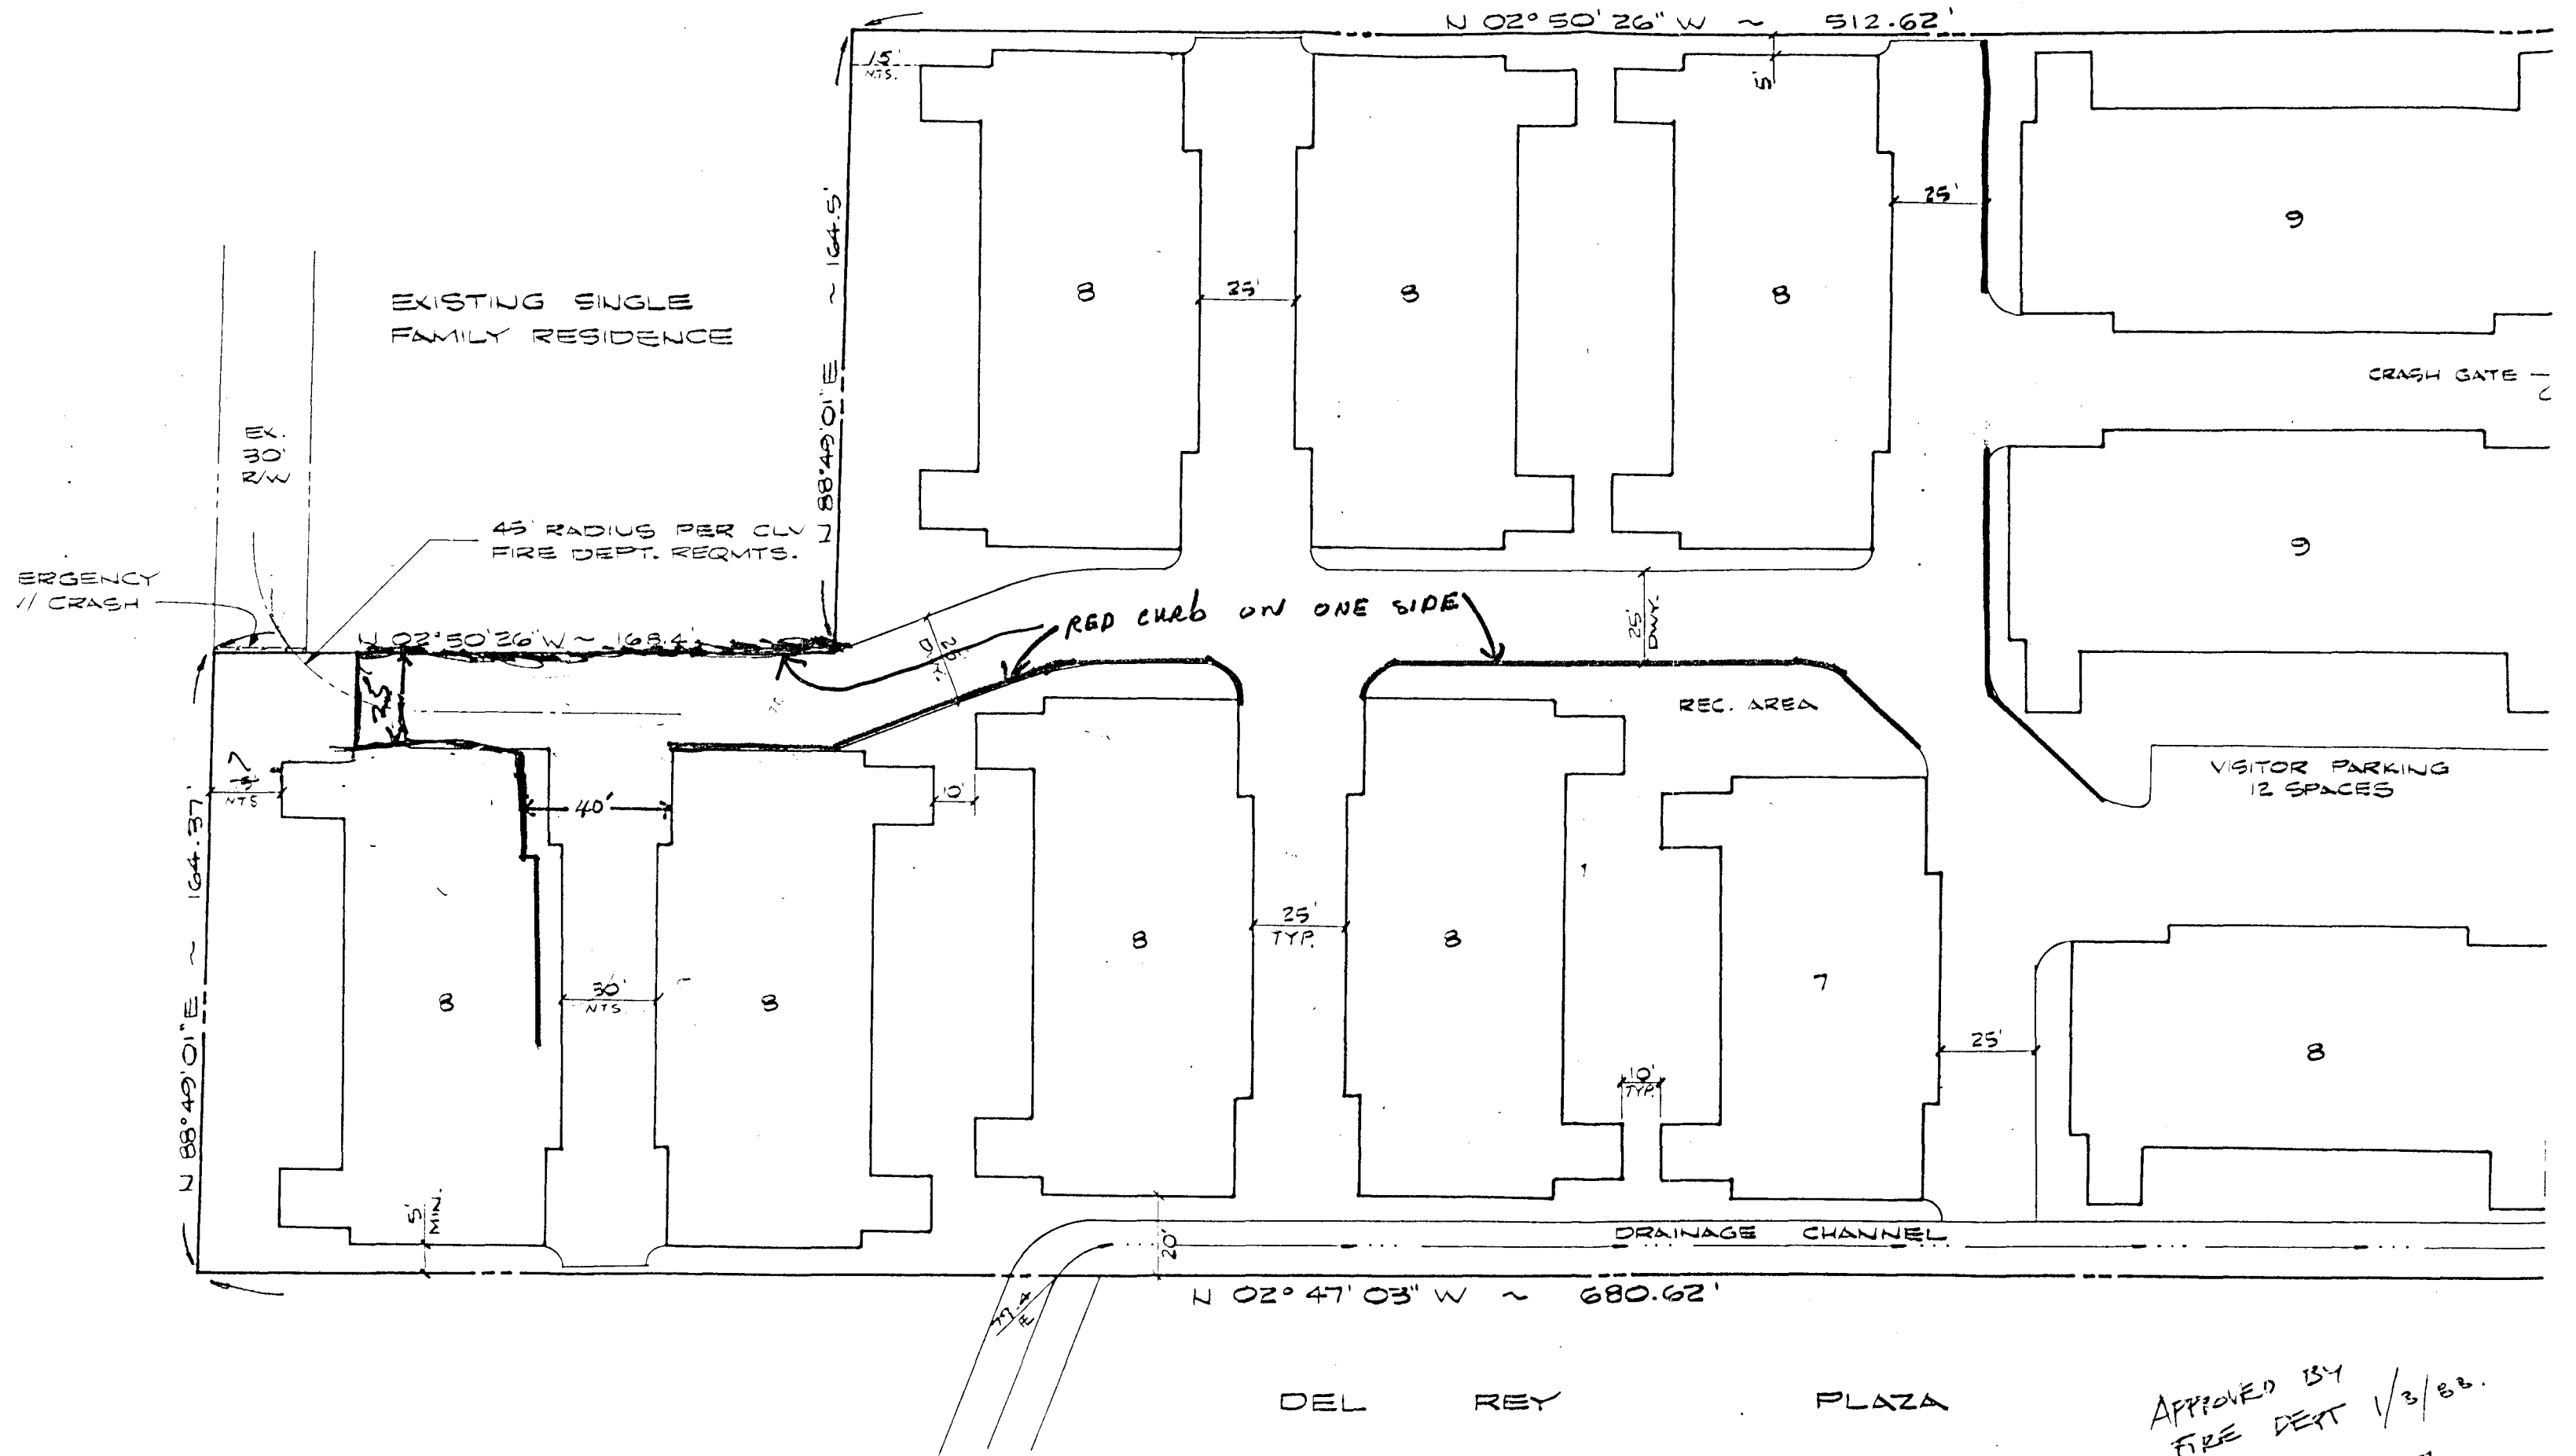

APPROVED BY
FIRE DEPT 1/3/88.
2-123, 87