


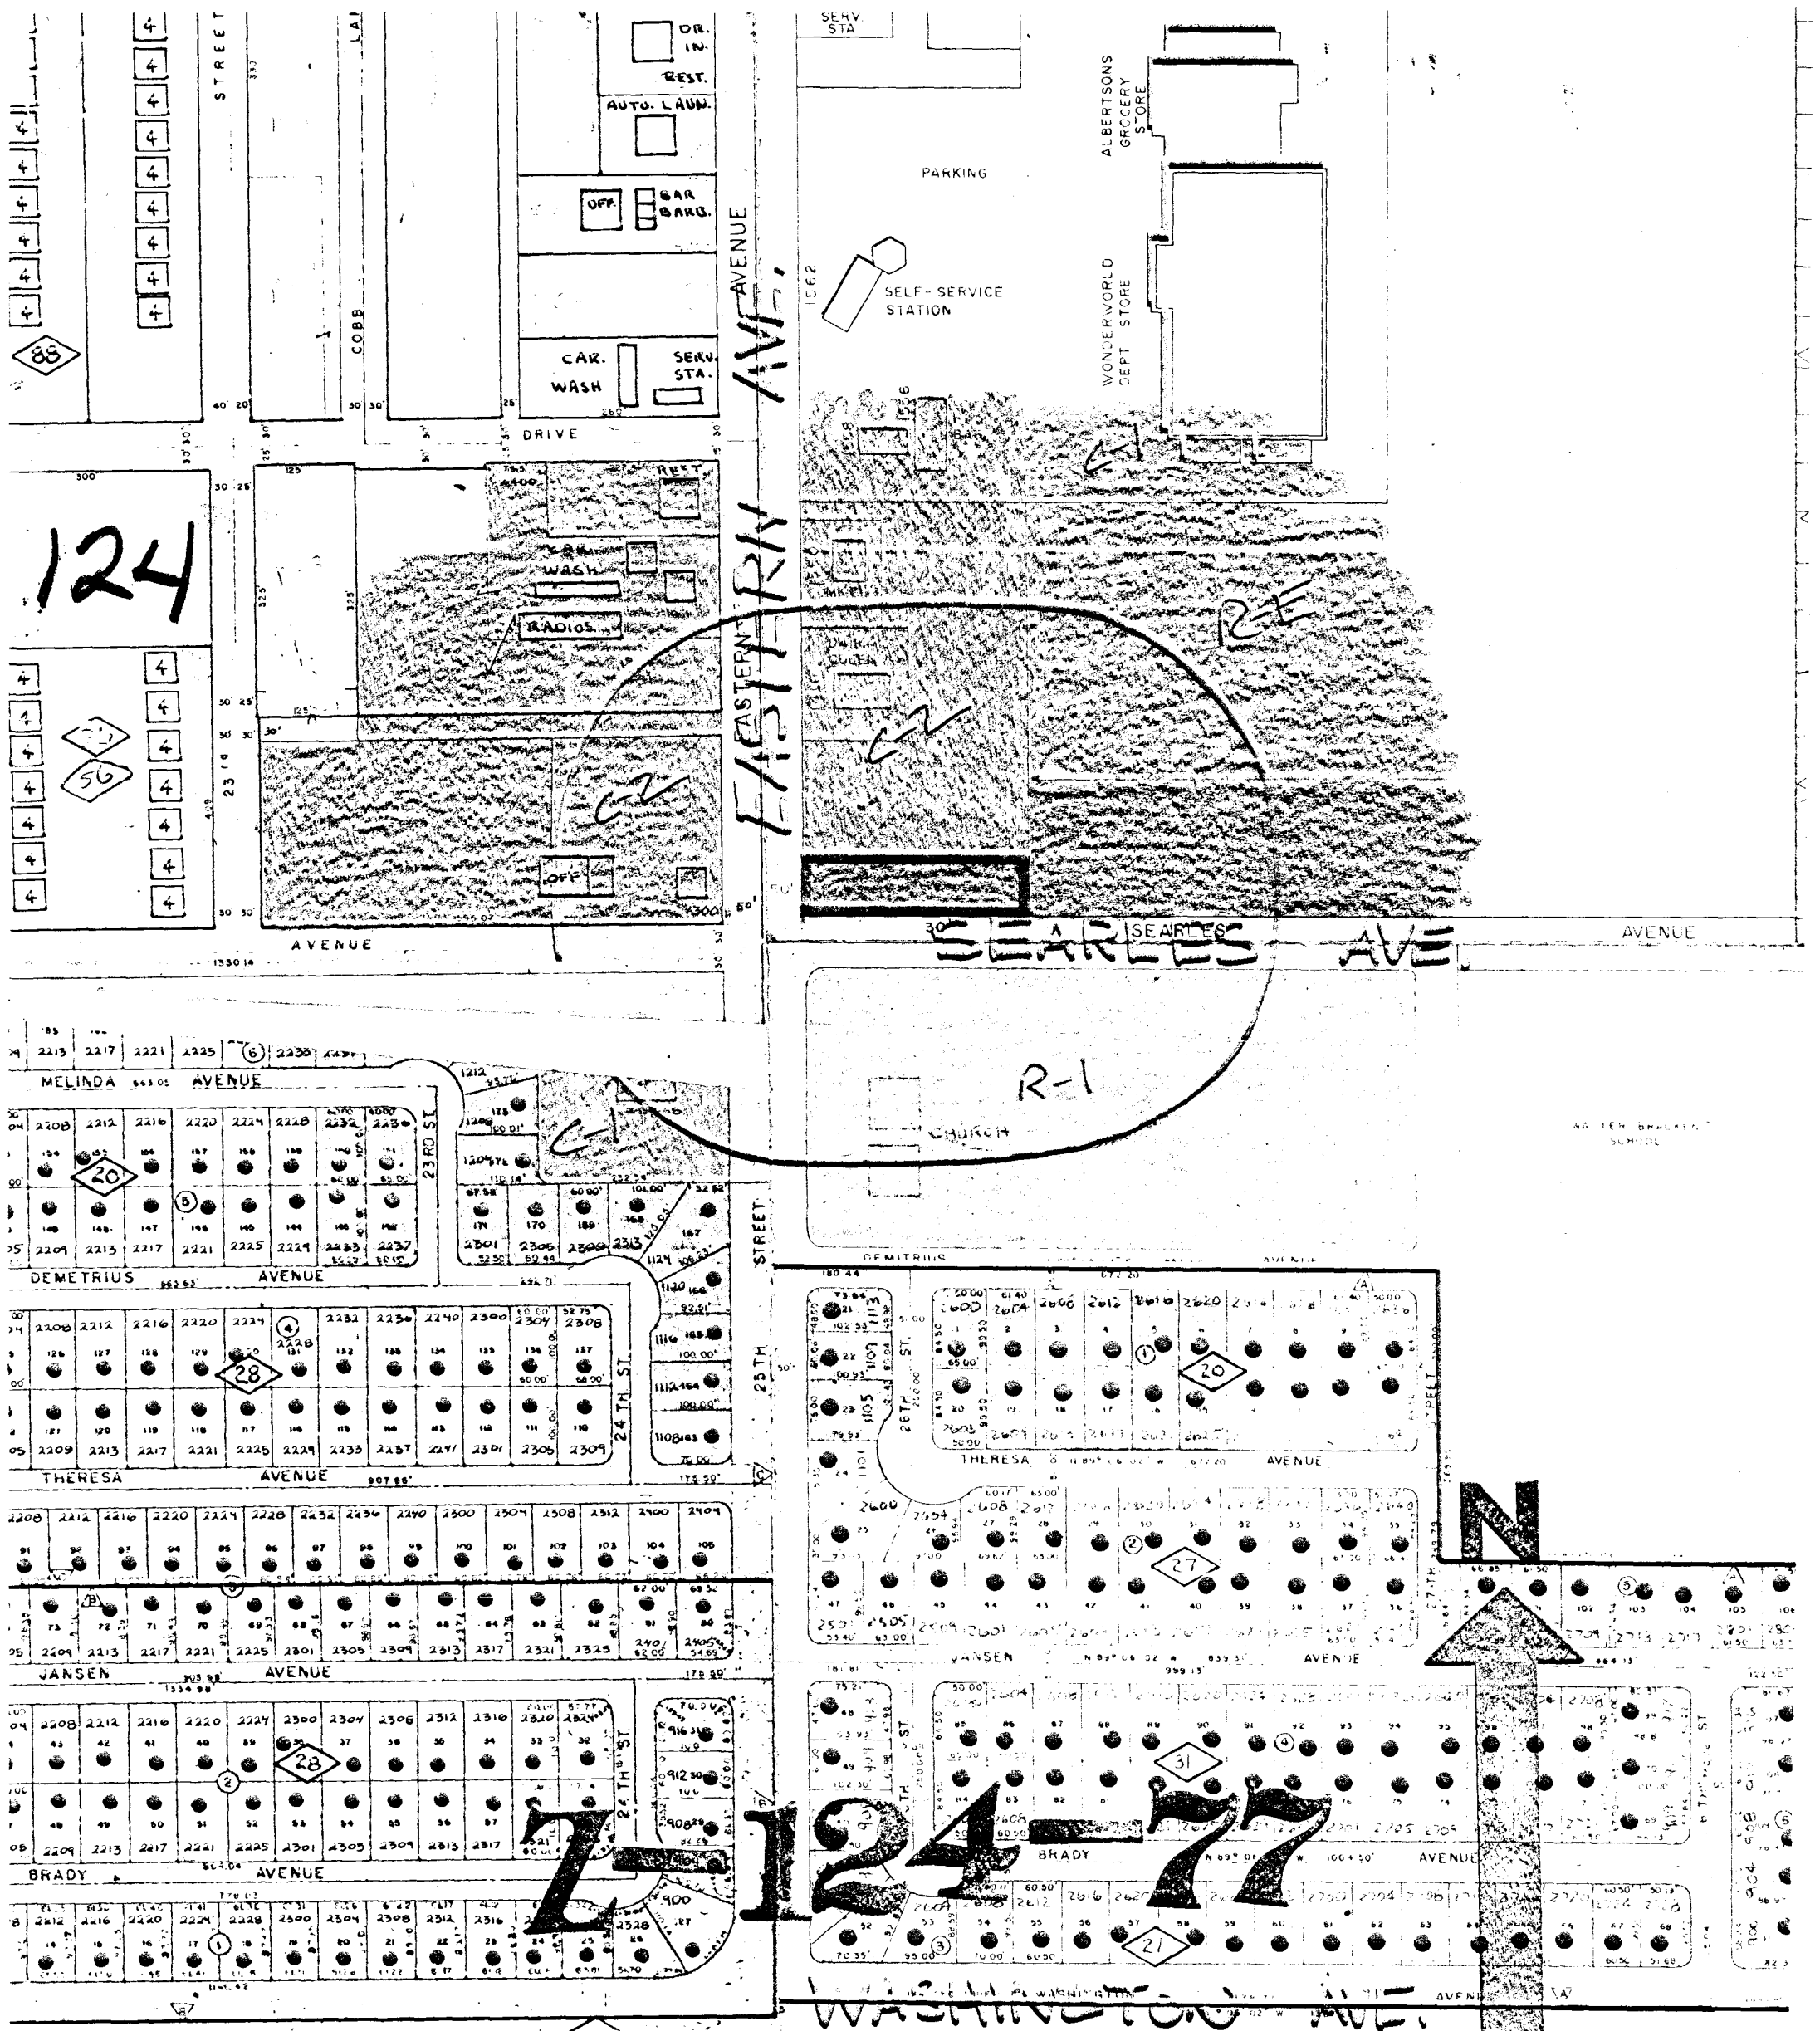

REVISED 10/11/77
10/11/77
CITY OF LAS VEGAS NEVADA 10/11/77


Sheet 2-69

PT. W² NW⁴ NW⁴ SEC 25 T. 20 S. R. 61 E.

020-720

124

SCALE: 1" = 100'

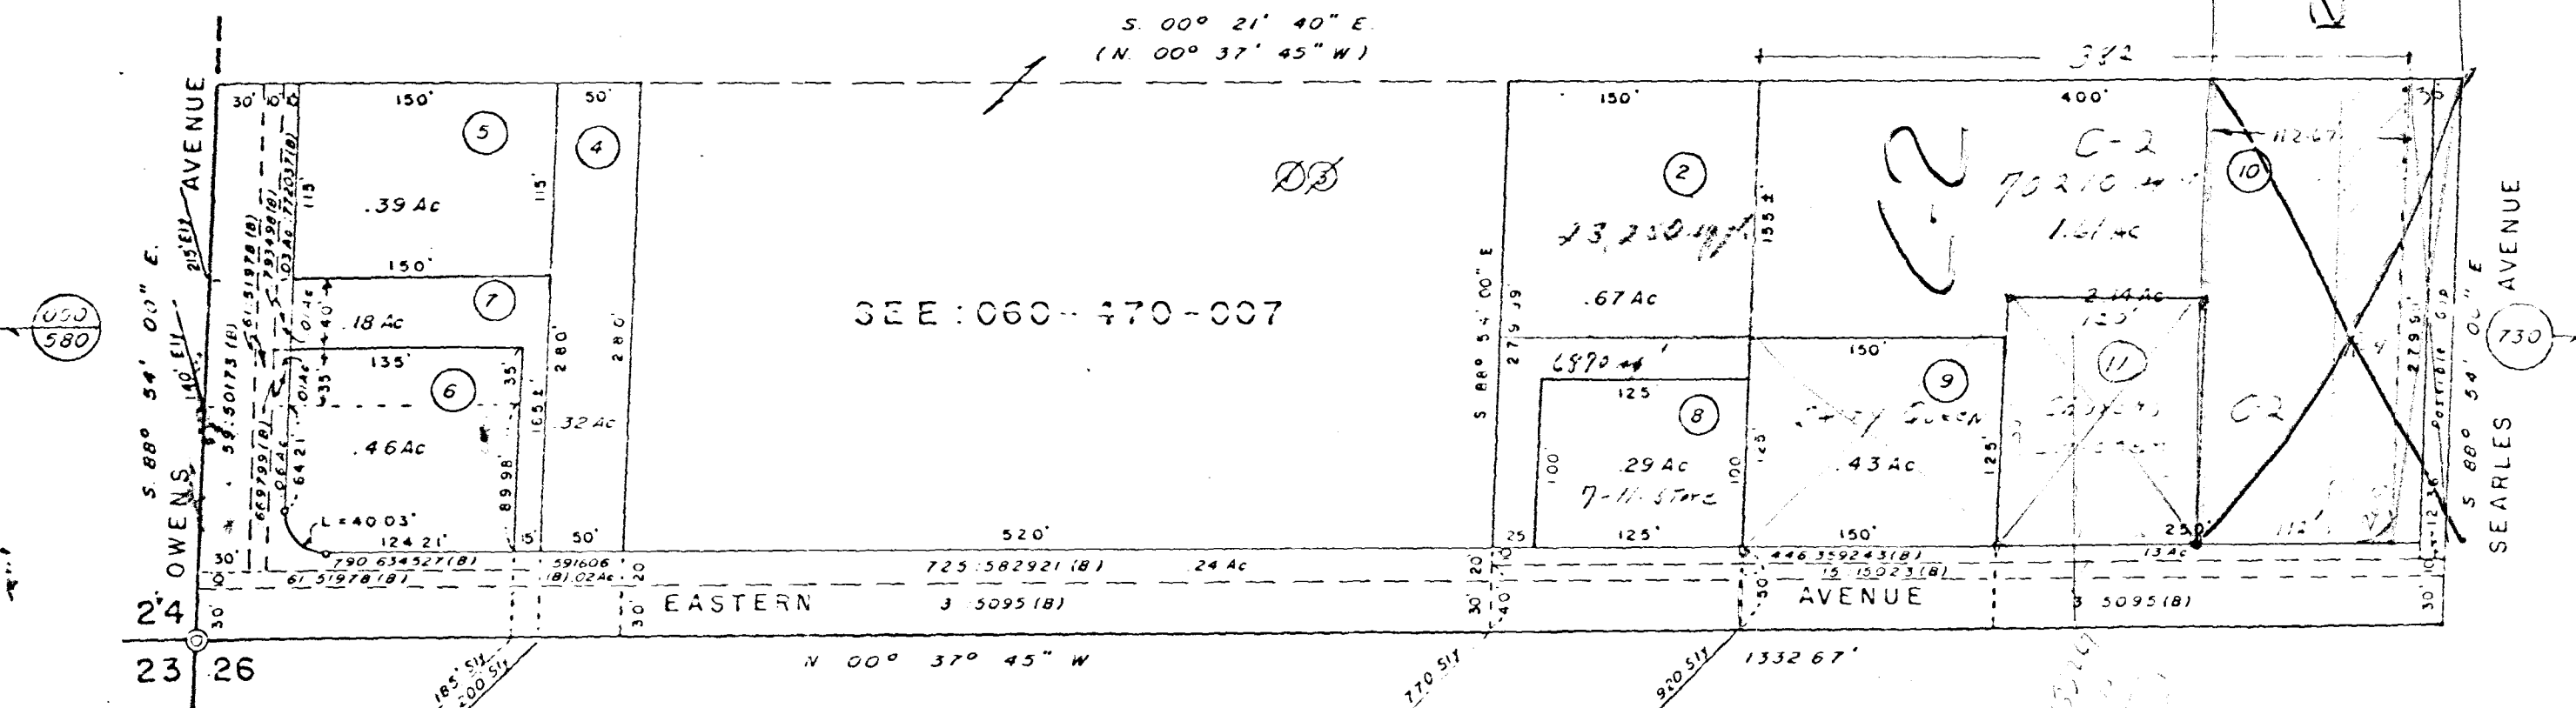

(2)(8)(9)(10) Files: 2/21, 15/11, 15/22, 21/25

ANNEX ORD 1065


CCAO Redraw MS 2-22-77

STAFF

CLV-200 2-124-77

020-720

124

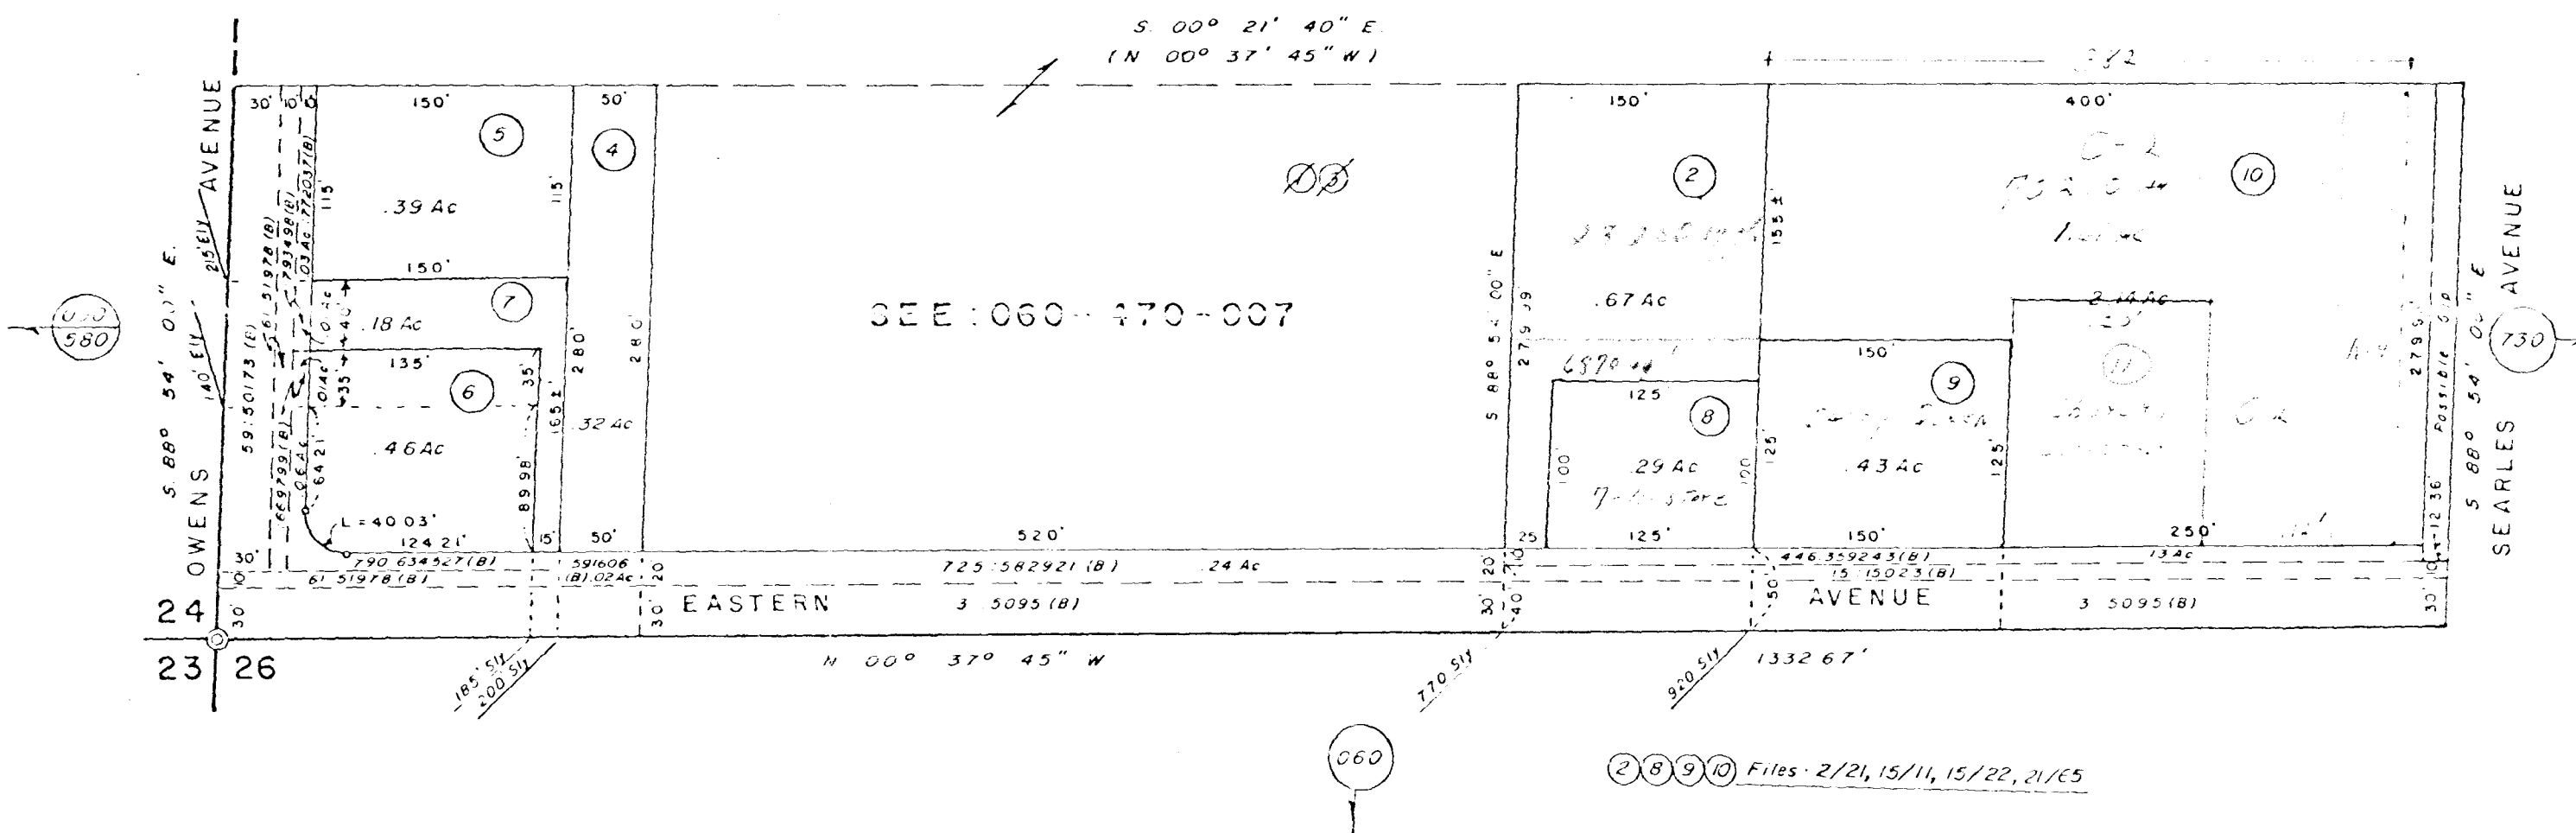

ANNEX ORD. 1065

CCAO Redrow MS 2-22-77

CLV - 200 *2-124-77*