


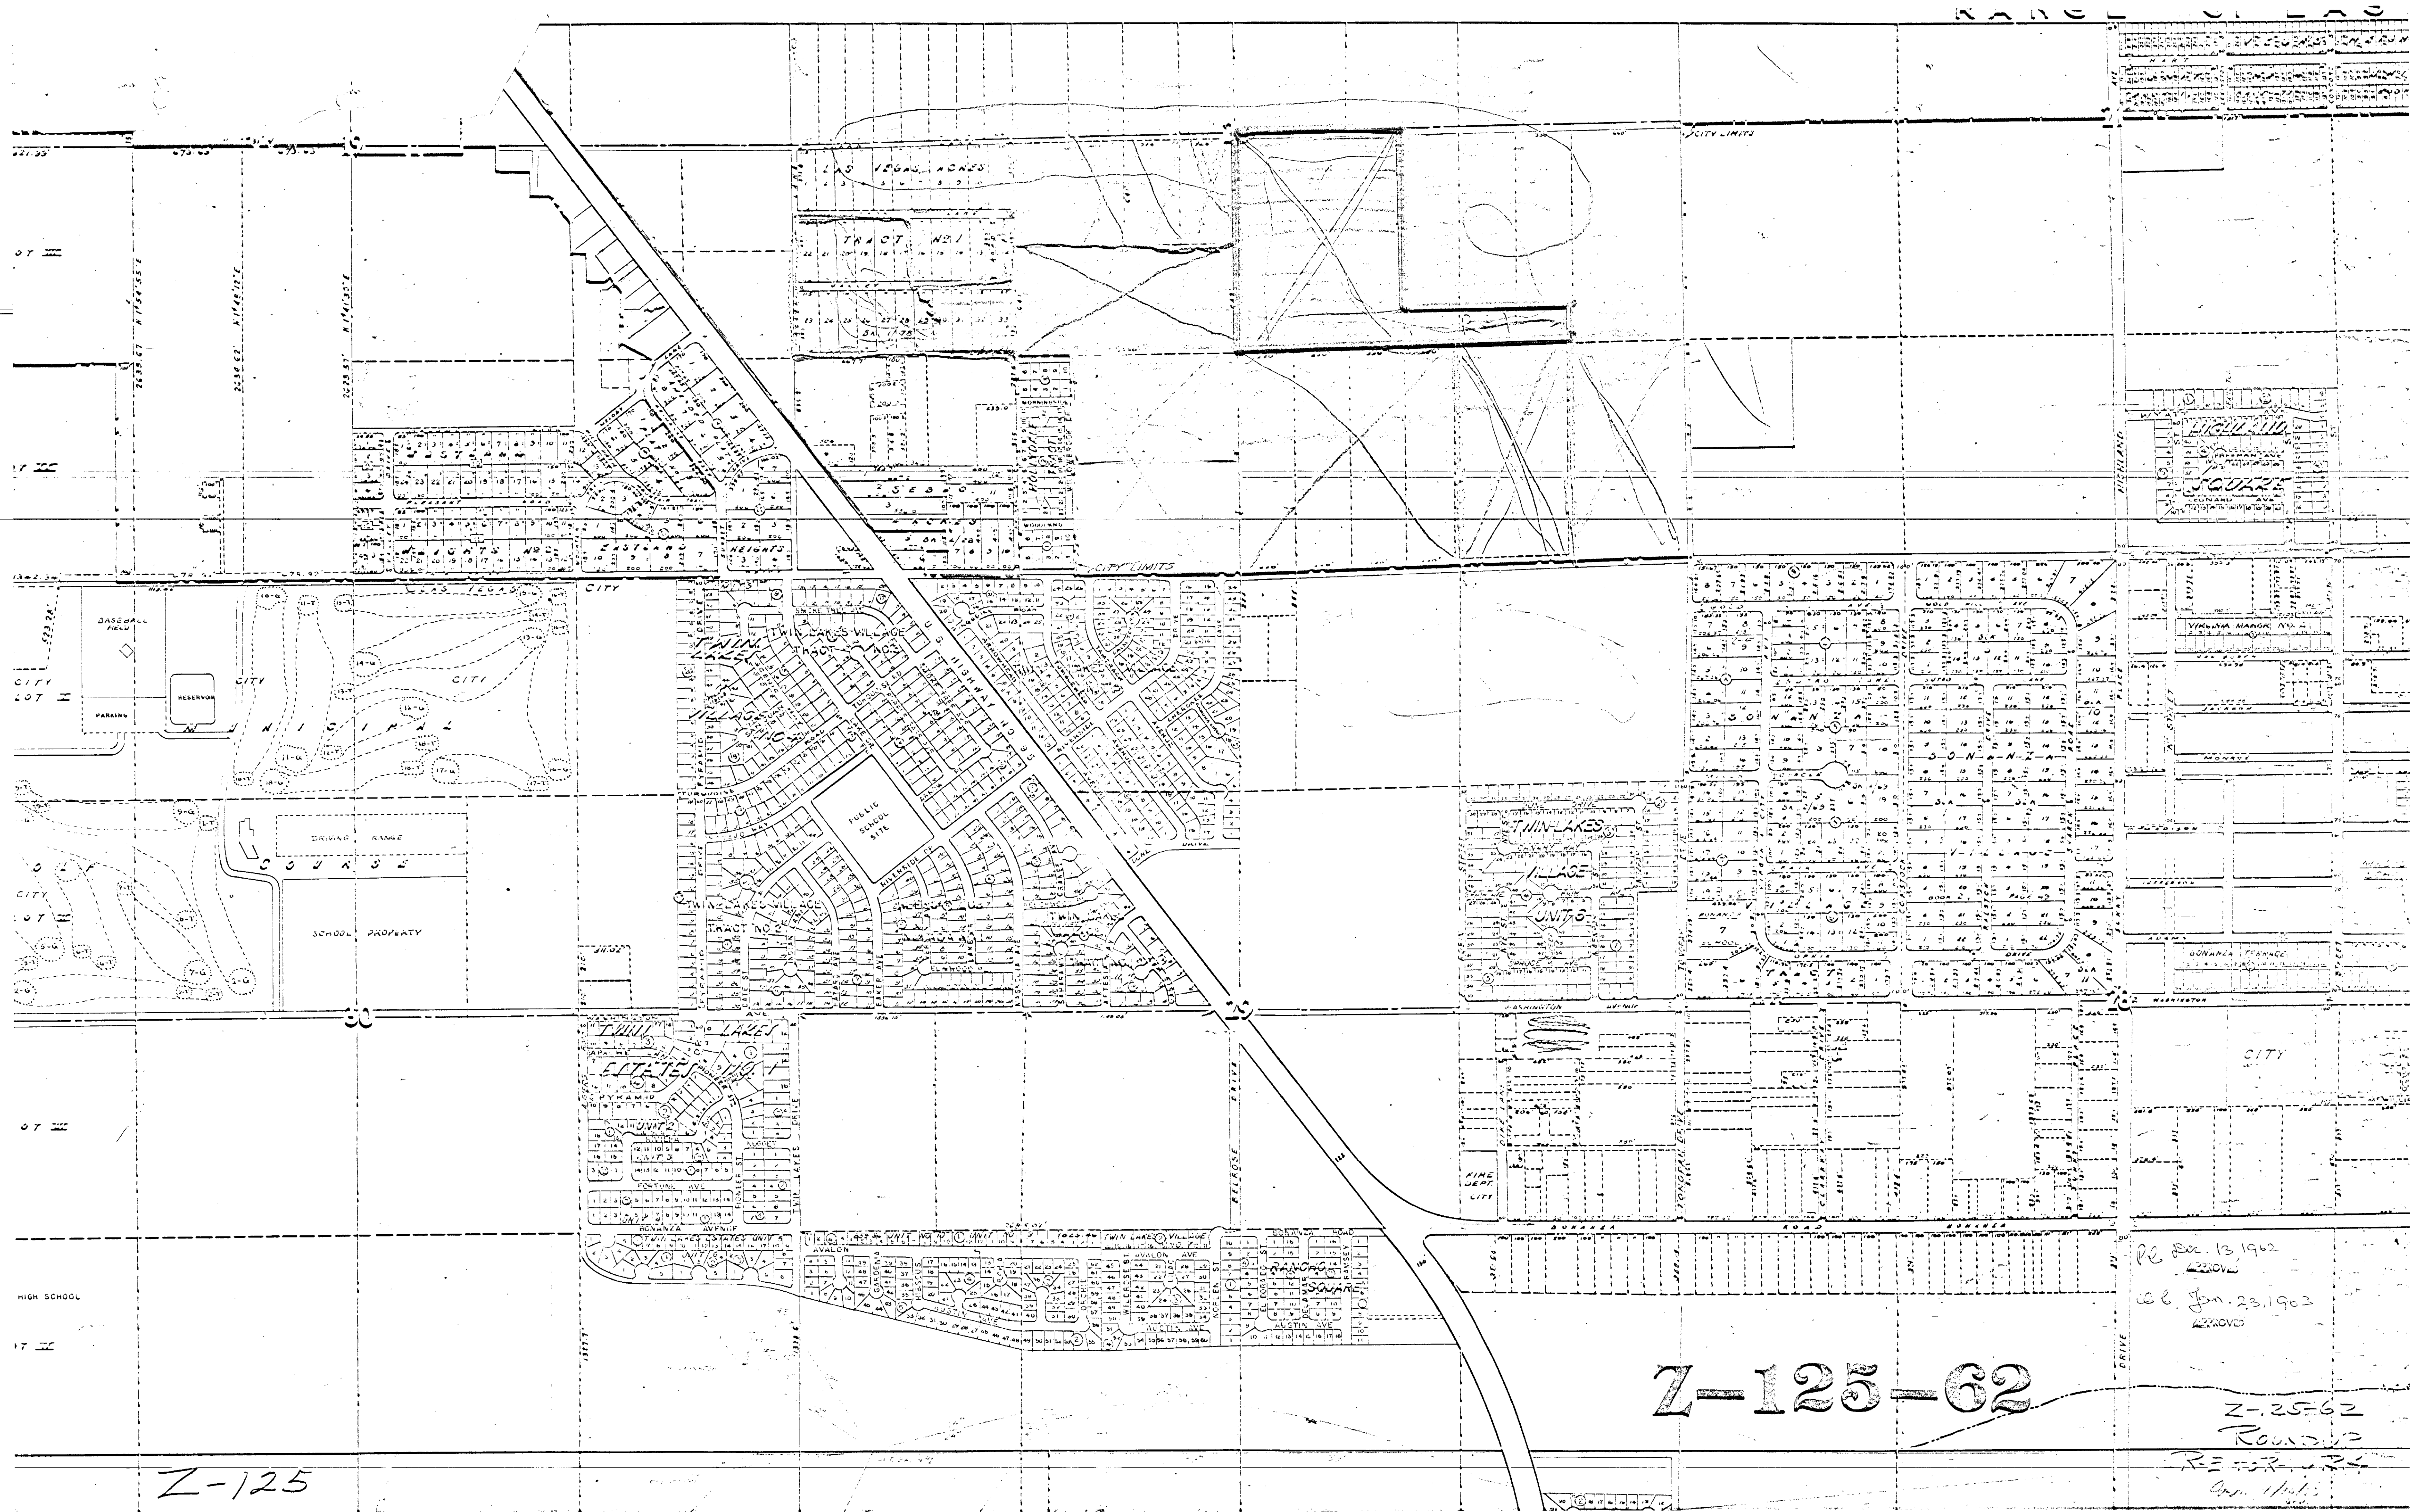

RE REC. 13 1962
JAN. 23, 1963
Z-25-62

Z-125-62

ROUNDUP
RE-RE-RE
Apr. 1/63

Z-125