

[illegible]

MAP TO COMPANY
RECLASSIFICATION APPLICATION
NEW NEW WAY SEC. 26 T-20S R-60F
M.D.M. CITY OF LAS VEGAS
CLARK COUNTY, NEVADA
FOR
LIED MOTOR CAR CO.


CAUSEY ENGINEERING SERVICE LTD.
ENGINEERS · PLANNERS · SURVEYORS
112 WEST WYOMING AVENUE PO BOX 11866
LAS VEGAS, NEVADA 89111 TELEPHONE 702-384-7732

David F. Causey 4/14/72

DAVID F. CAUSEY, P.E.
112 WEST WYOMING AVENUE, BOX 11866
LAS VEGAS, NEVADA 89111
TELEPHONE 702-384-7732


JOB NO.	SHEET	1
7527-3	OF	1

2-125-77

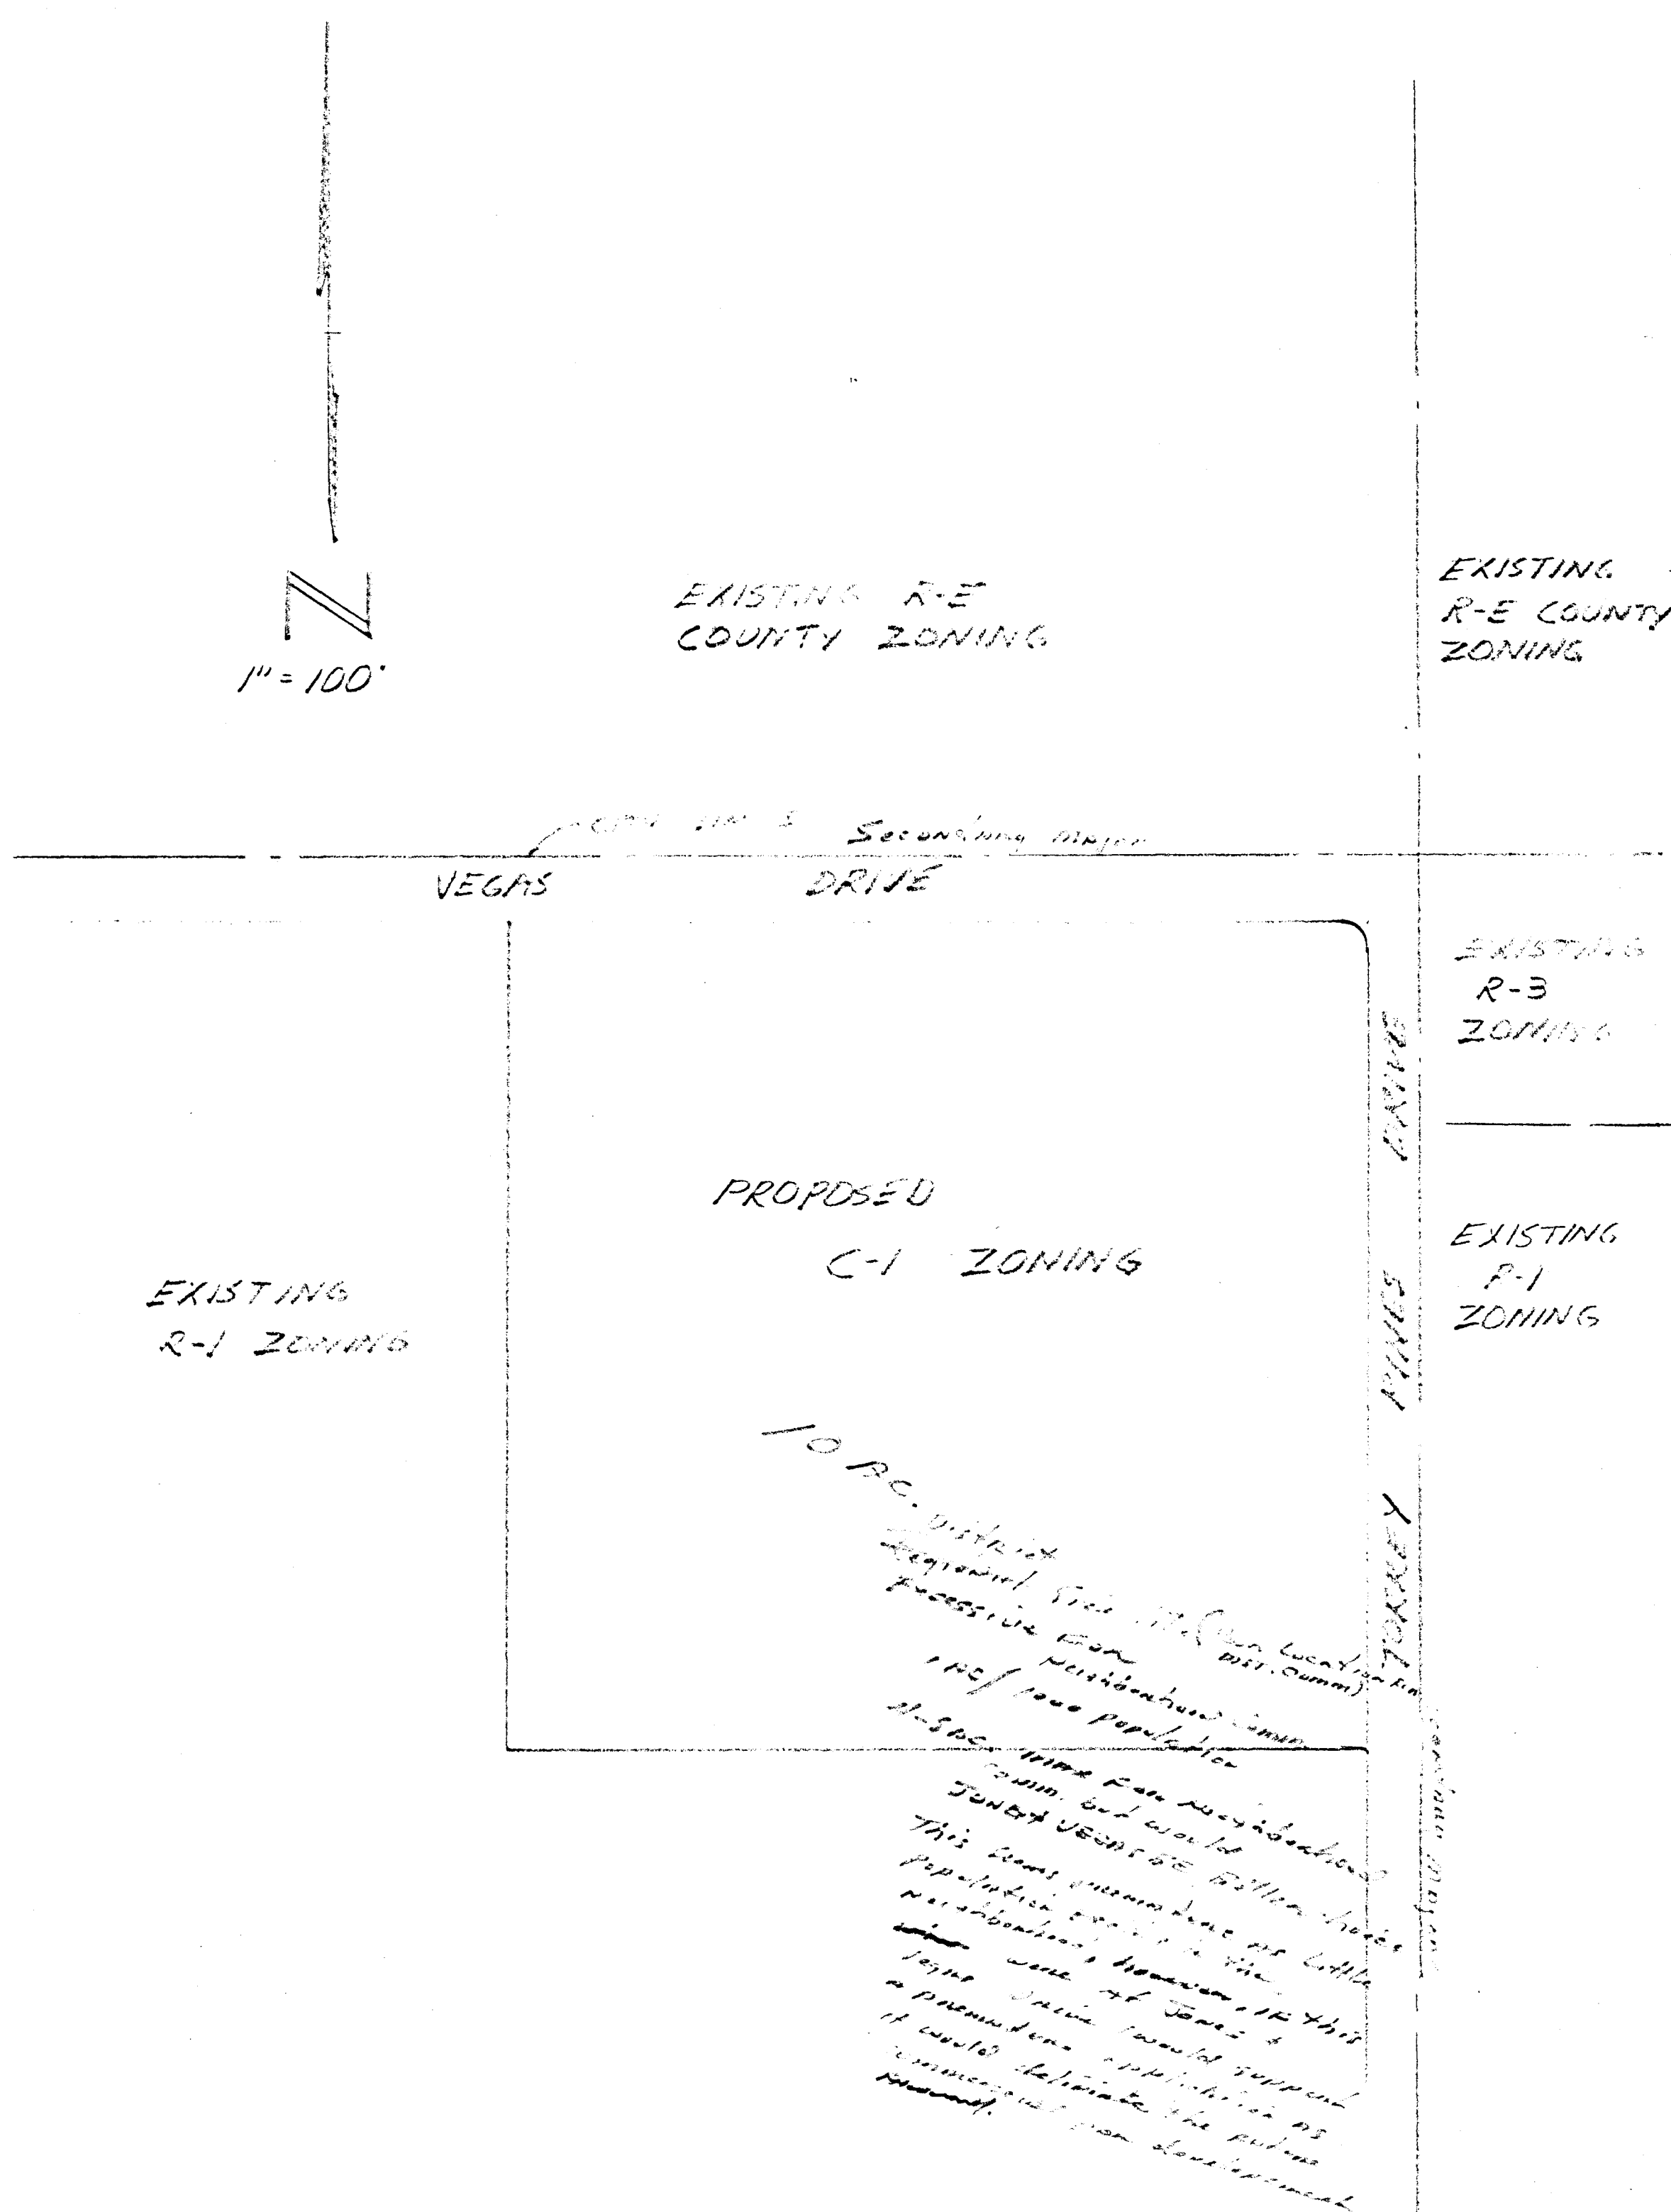


5/17/77

125

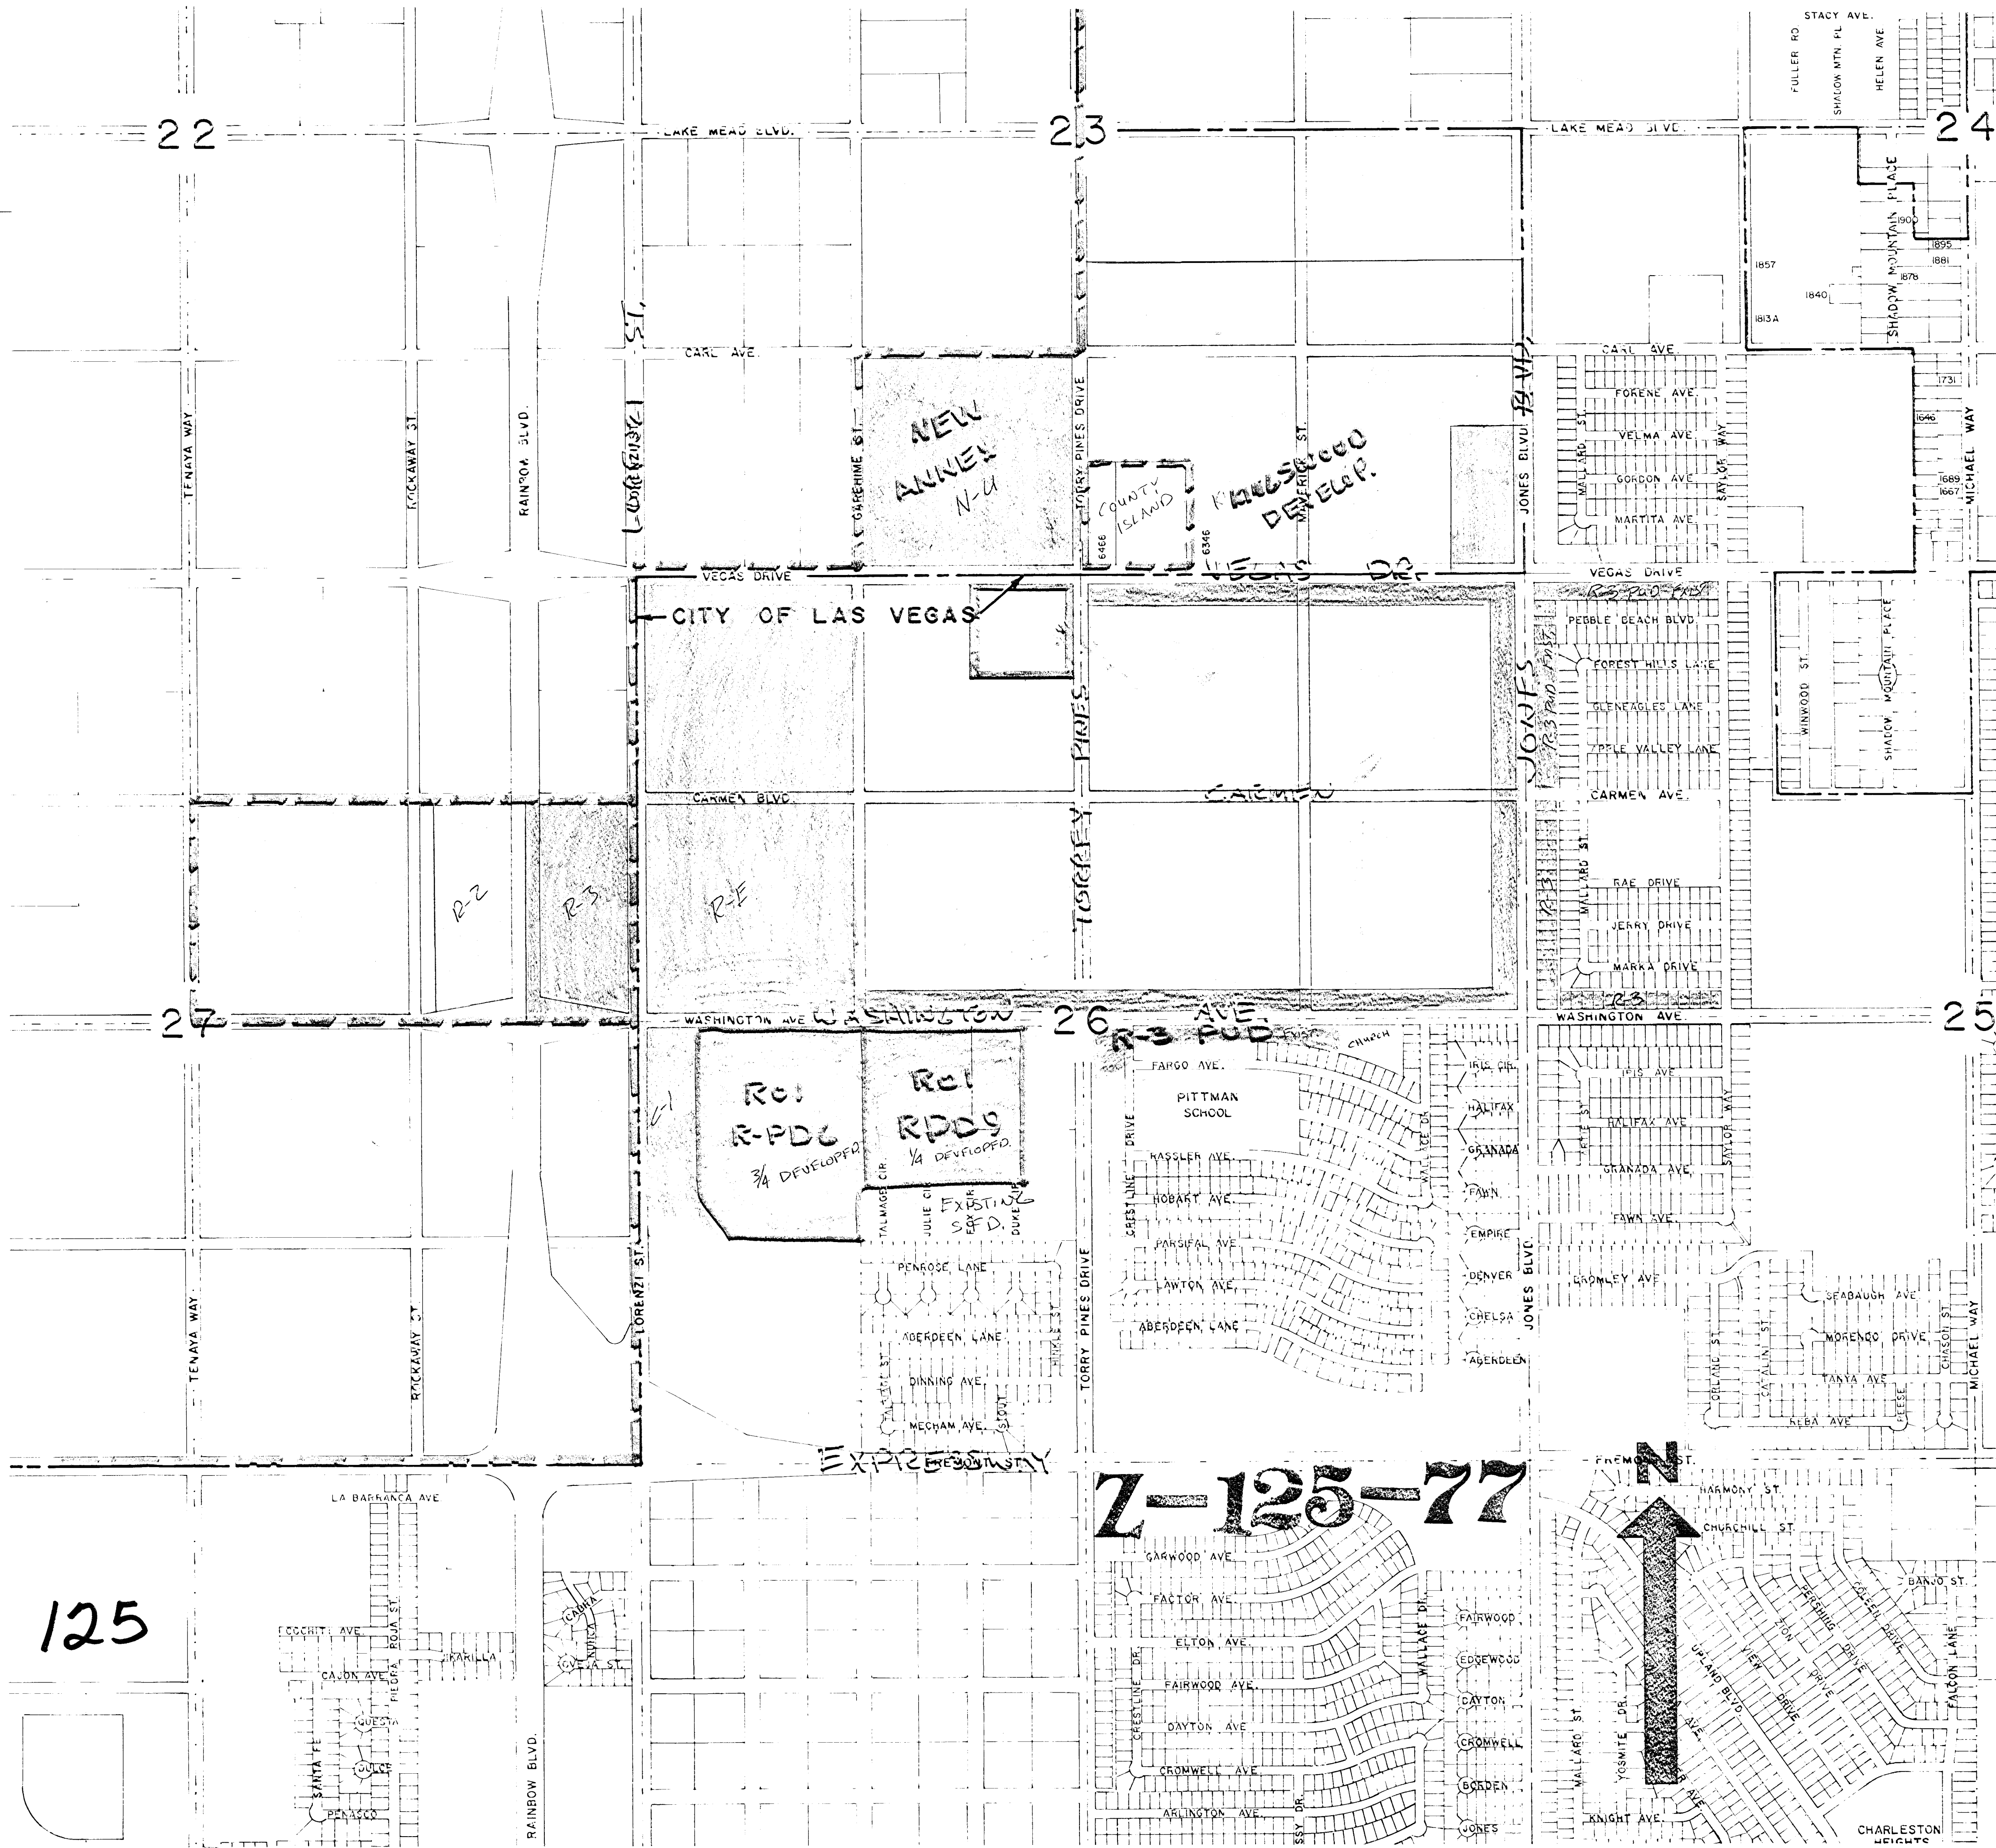


125

7-125-77

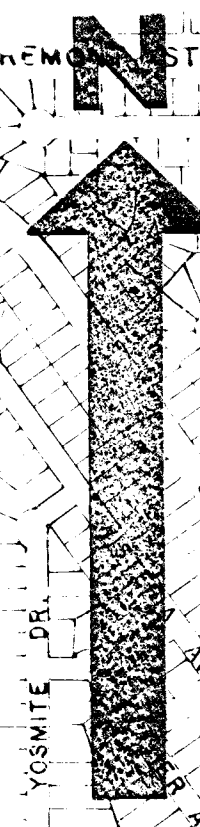

CHARLESTON LIGHTS

125

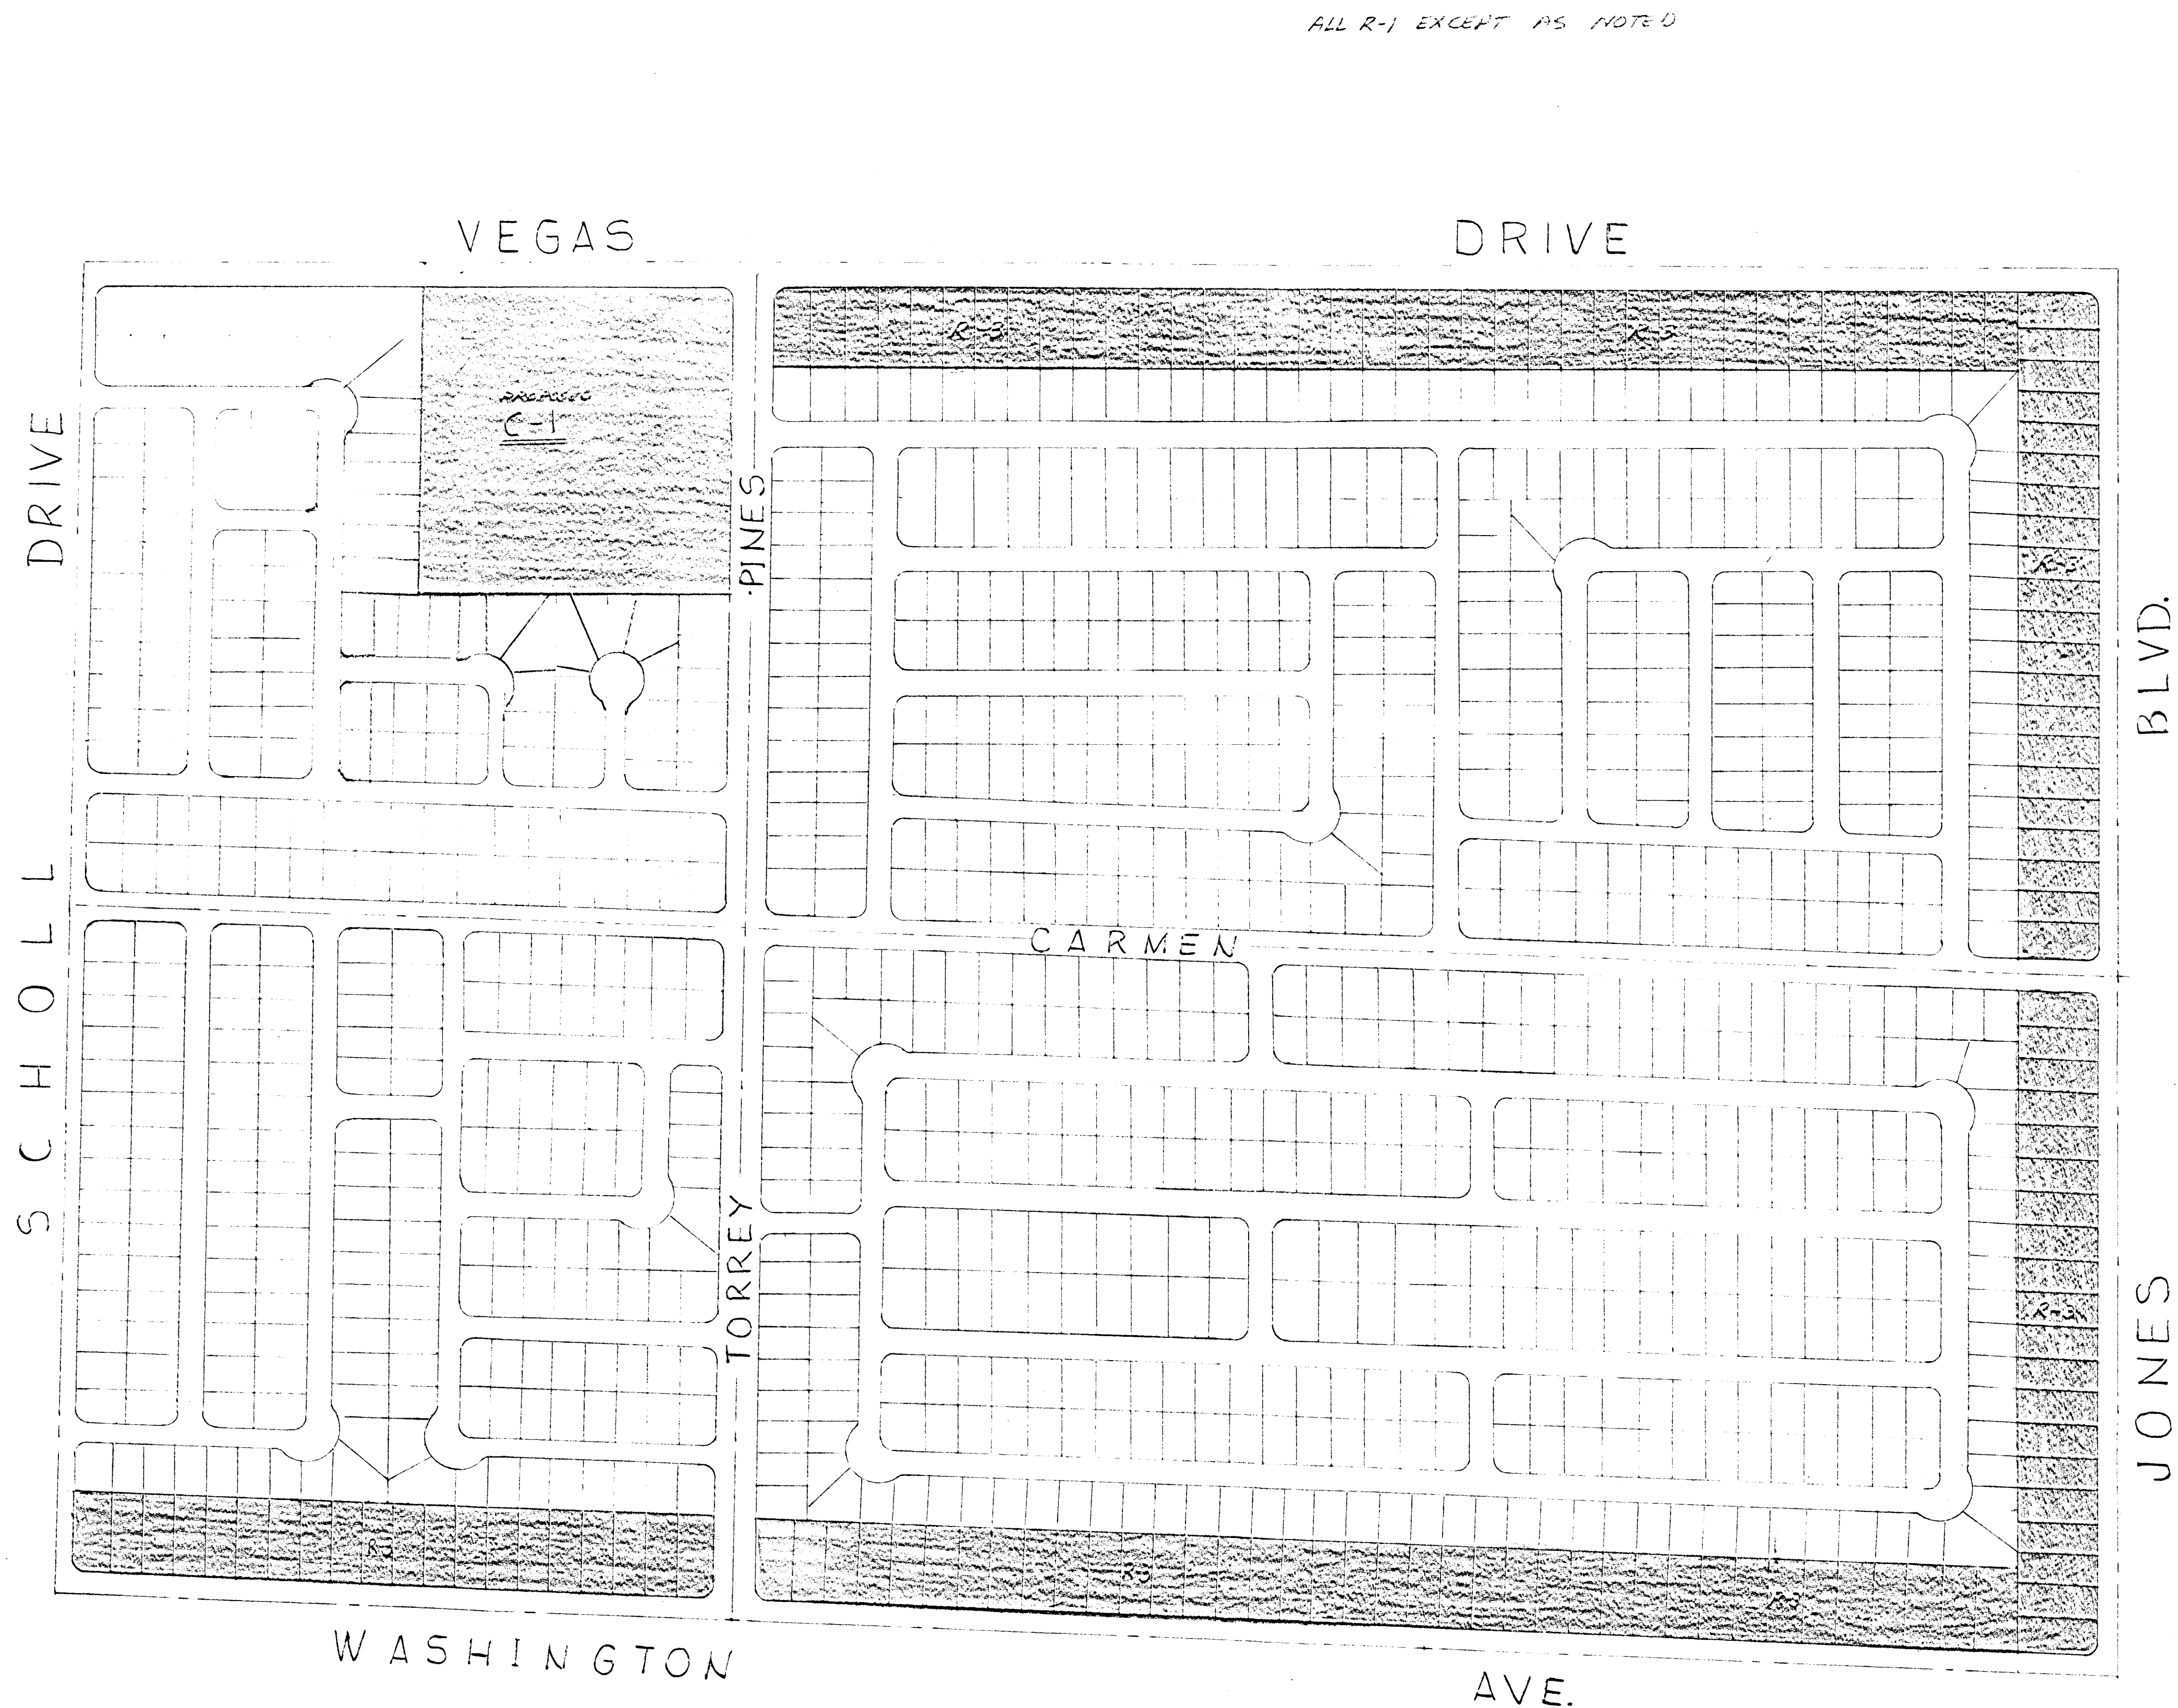

SCALE 1" = 200'

CAUSEY ENGINEERING SERVICE LTD.
ENGINEERS - PLANNERS - SURVEYORS
112 WEST WYOMING AVENUE P.O. BOX 14846
LAS VEGAS, NEVADA 89114 TELEPHONE 702-384-7432

DAVID CAUSEY P.E.
REGISTERED PROFESSIONAL ENGINEER - CIVIL
STATE OF NEVADA LICENSE NO. 12-8-77

PRELIMINARY MASTER PLAN
FOR N¹/₂ SEC. 26 T-20-S. R-60-E
M.O.M. CITY OF LAS VEGAS
CLARK COUNTY, NEVADA

LIED MOTOR CAR CO.

THE USE OF THESE PLANS AND SPECIFICATIONS SHALL BE RESTRICTED TO THE ORIGINAL SITE FOR WHICH THEY WERE PREPARED AND NO PART THEREOF IS EXPRESSLY LIMITED TO SUCH USE. REPRODUCTION, PUBLICATION OR REUSE BY ANY METHOD IN WHOLE OR IN PART IS PROHIBITED. TITLE TO THE PLANS AND SPECIFICATIONS REMAINS WITH THE ENGINEER WITHOUT PREJUDICE TO VISUAL CONTACT WITH THESE PLANS AND SPECIFICATIONS SHALL CONSTITUTE PRIMA FACIE EVIDENCE OF THE ACCEPTANCE OF THESE RESTRICTIONS. ENGINEER RESERVES COPYRIGHT AND ALL OTHER RIGHTS TO THESE PLANS AND SPECIFICATIONS.