


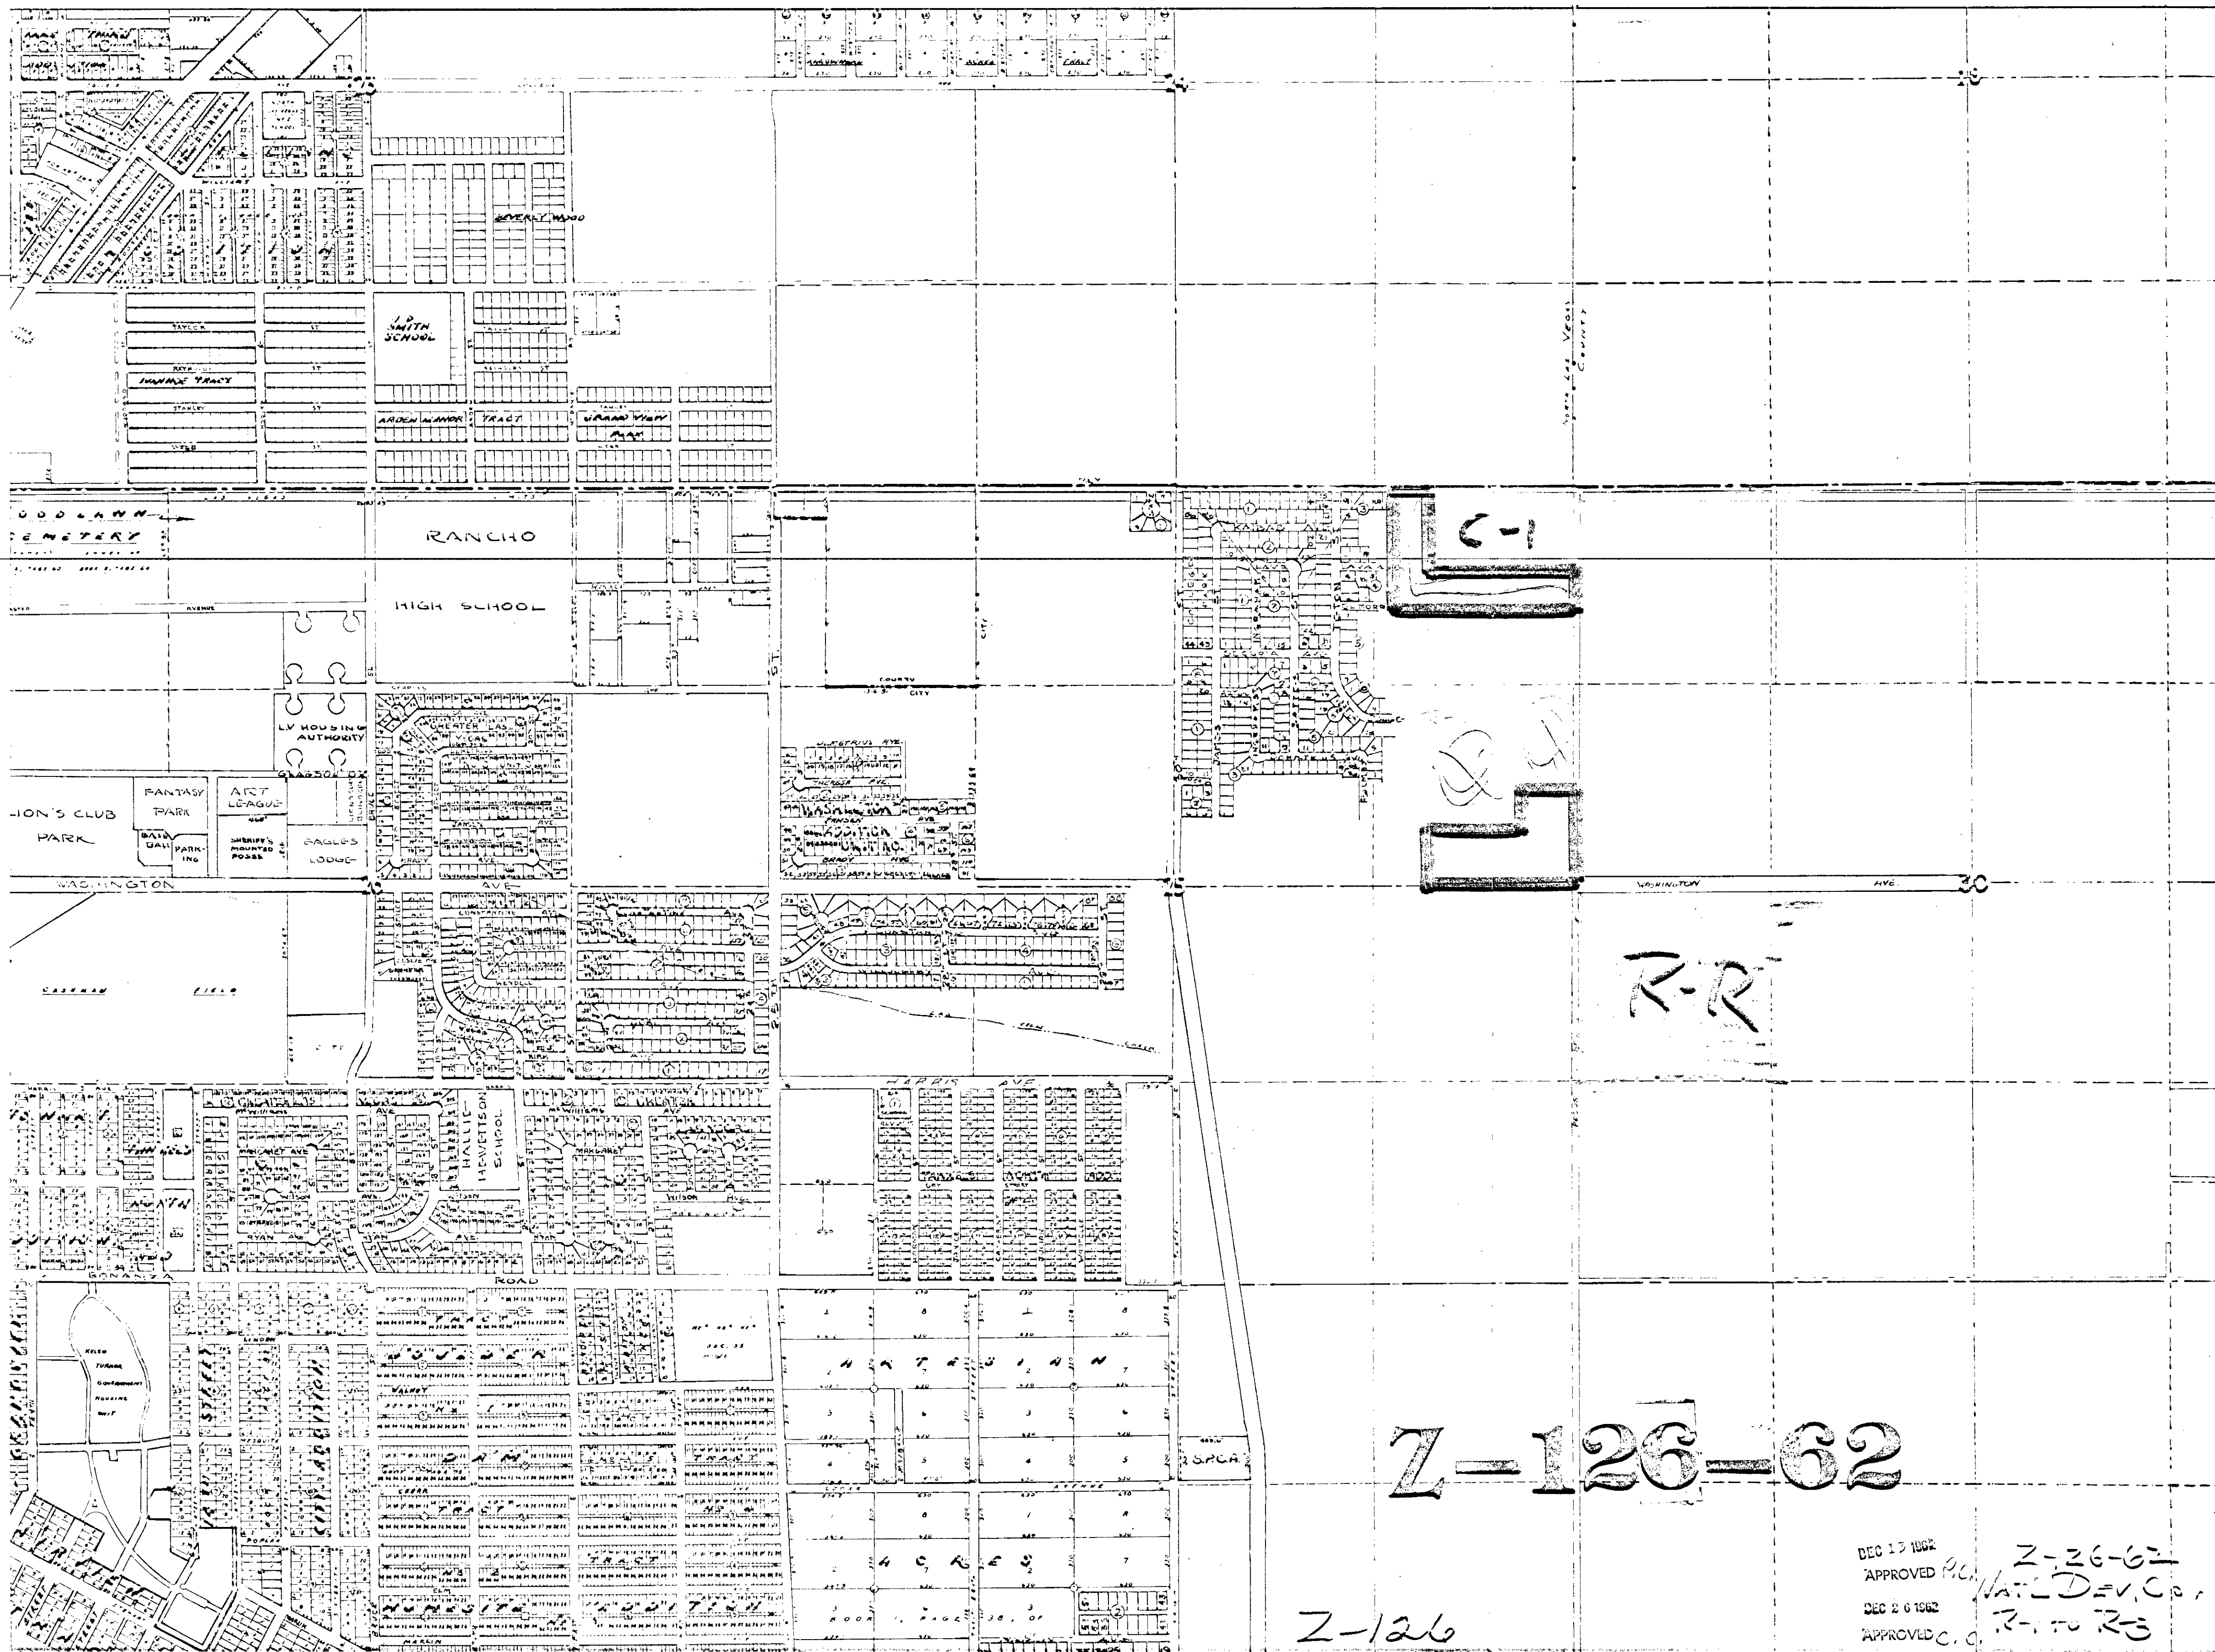

DEC 13 1962
APPROVED *PC*
DEC 26 1962
APPROVED *C. G.*

Z-26-62
NATL DEV. CO.
R-1 to R-3