


SHEET NO. 89

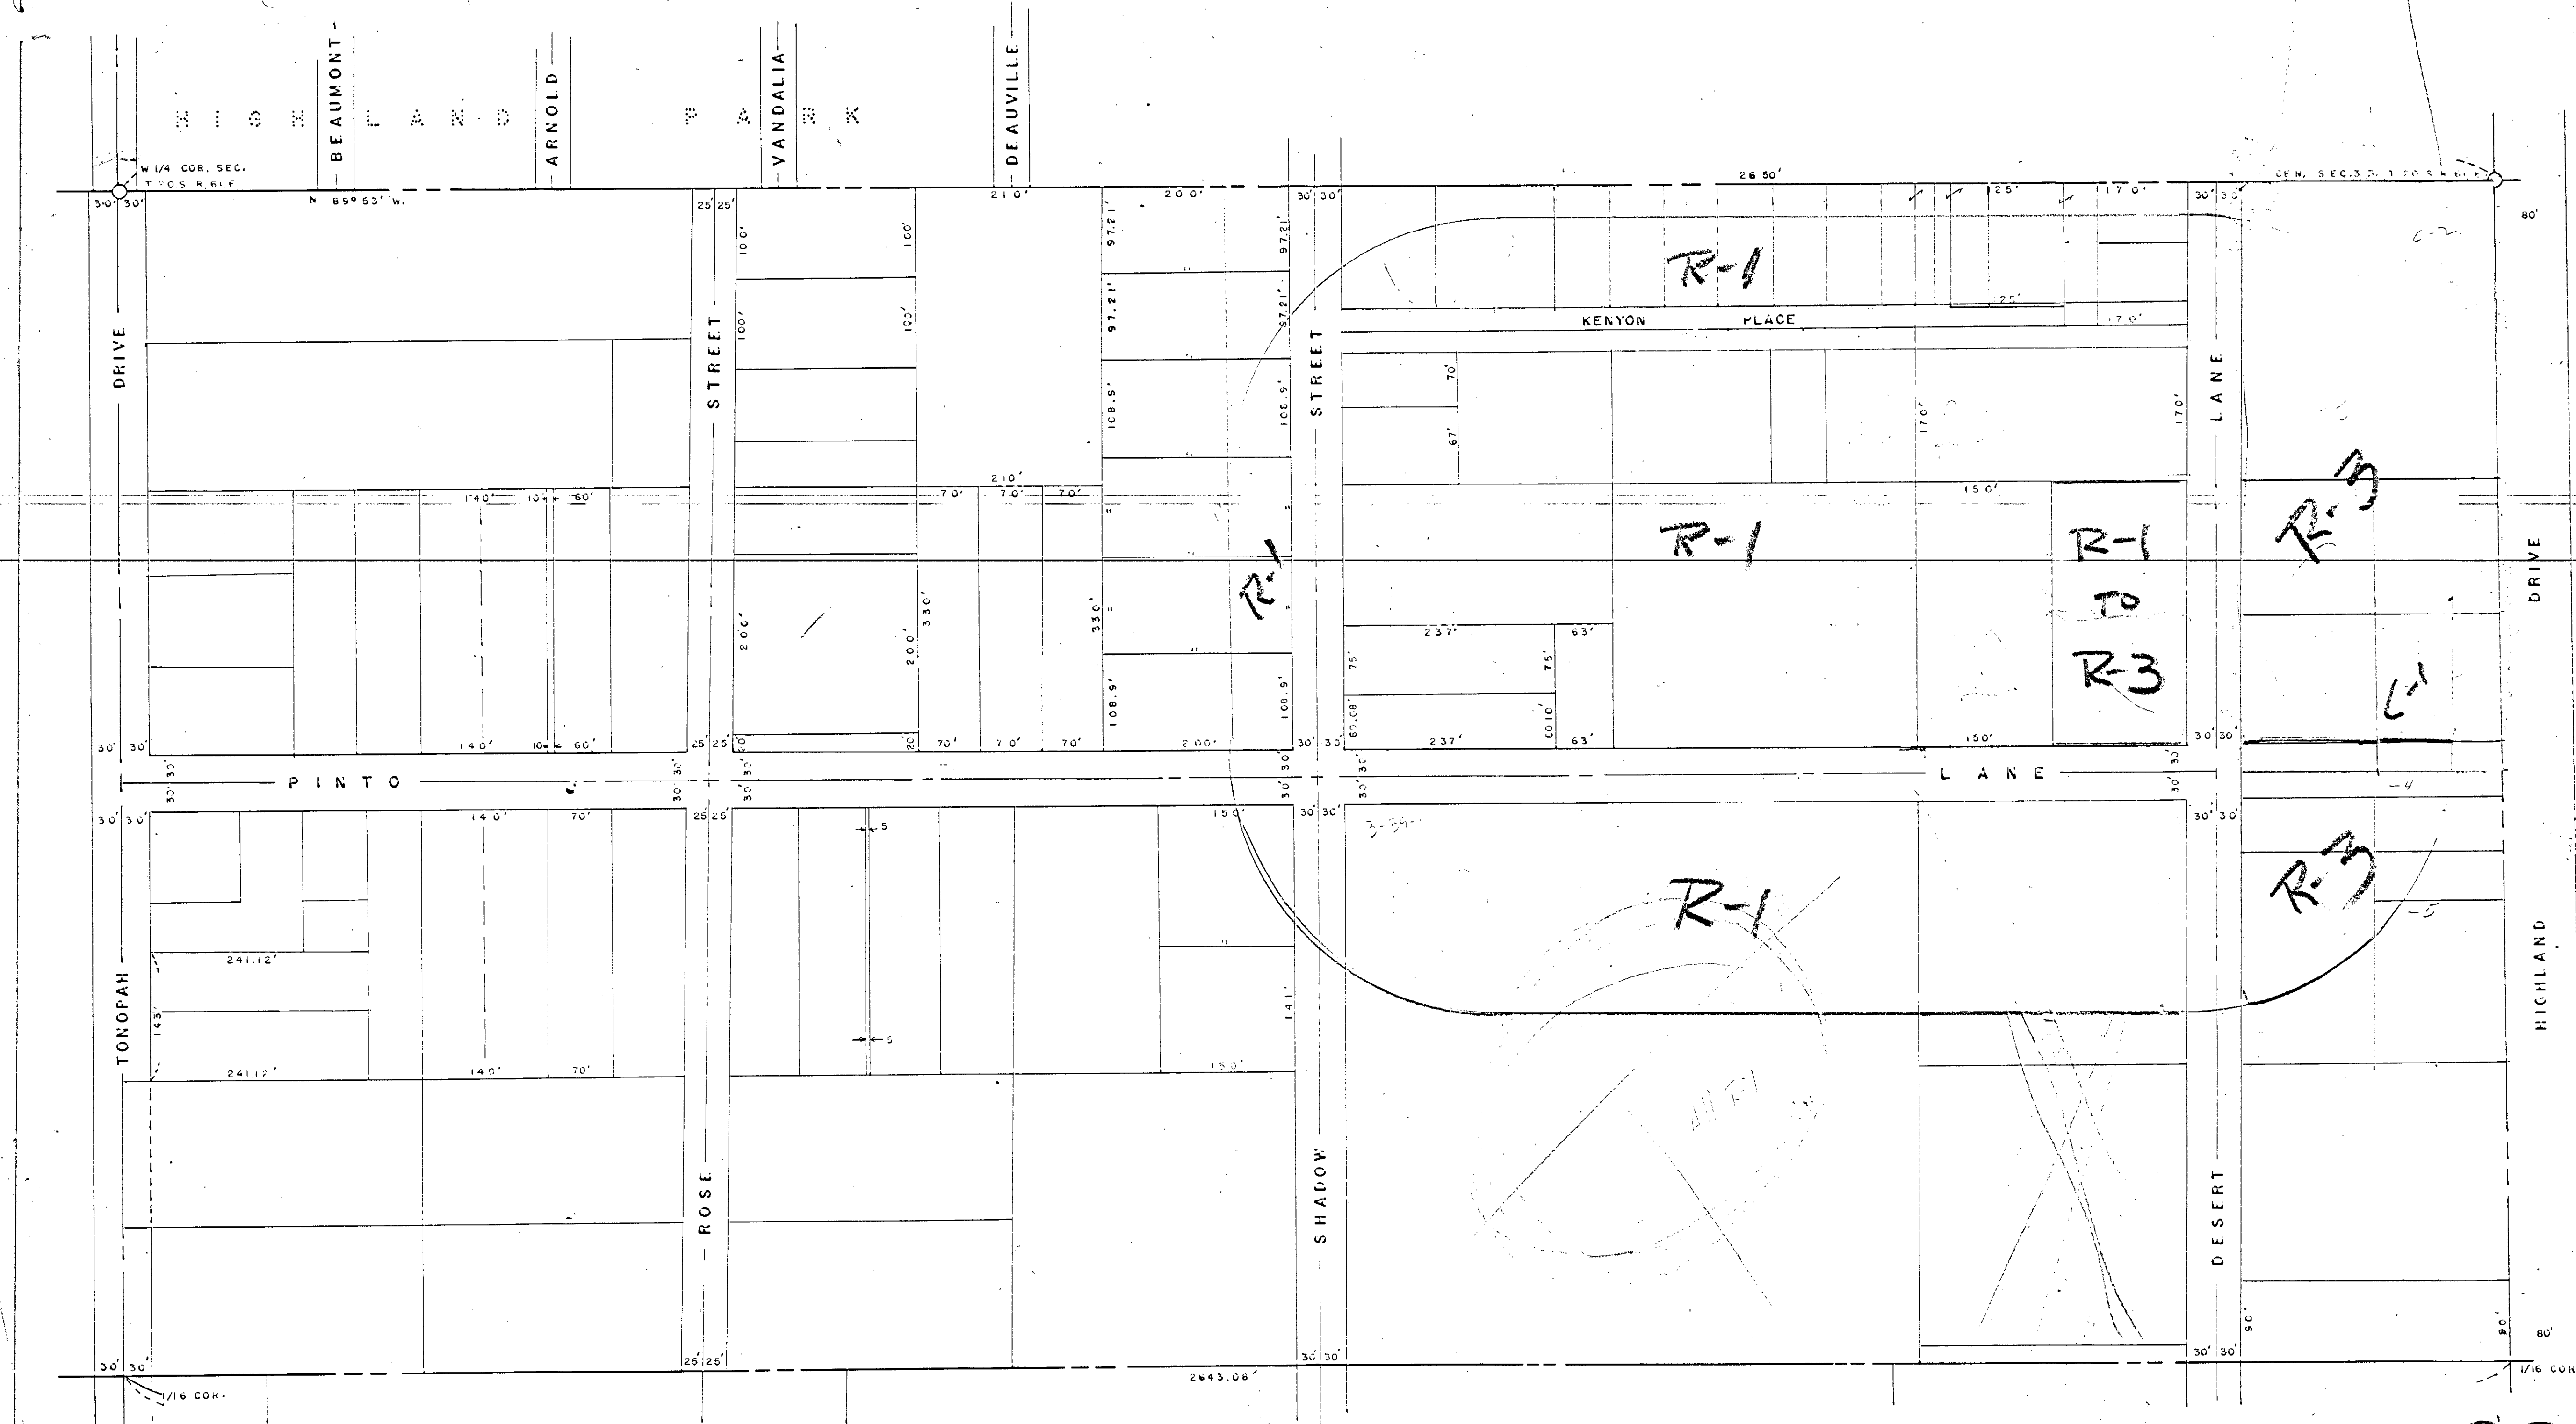

SHEET NO. 91

Z-127-62

N 1/2 SW 1/4 SEC.33 T20S, R 1 E

CITY OF LAS VEGAS NEVADA
ENGINEERING DEPT.

DISTRICT MAP — SHEET NO. 90

DESIGNED BY	DATE	SCALE 1" = 100'
DRAWN BY	FIELD BOOK NO.	
CHECKED BY	WORK ORDER NO.	
APPROVED	DRAWING NO.	
CITY ENGR.		

pg Dec. 13 1962
DENIED
bb MAR 13 1966
APPROVED

Z-127-62
S.M.P. CON
R-1 TO R-3

SHEET NO. 101

Z-127