


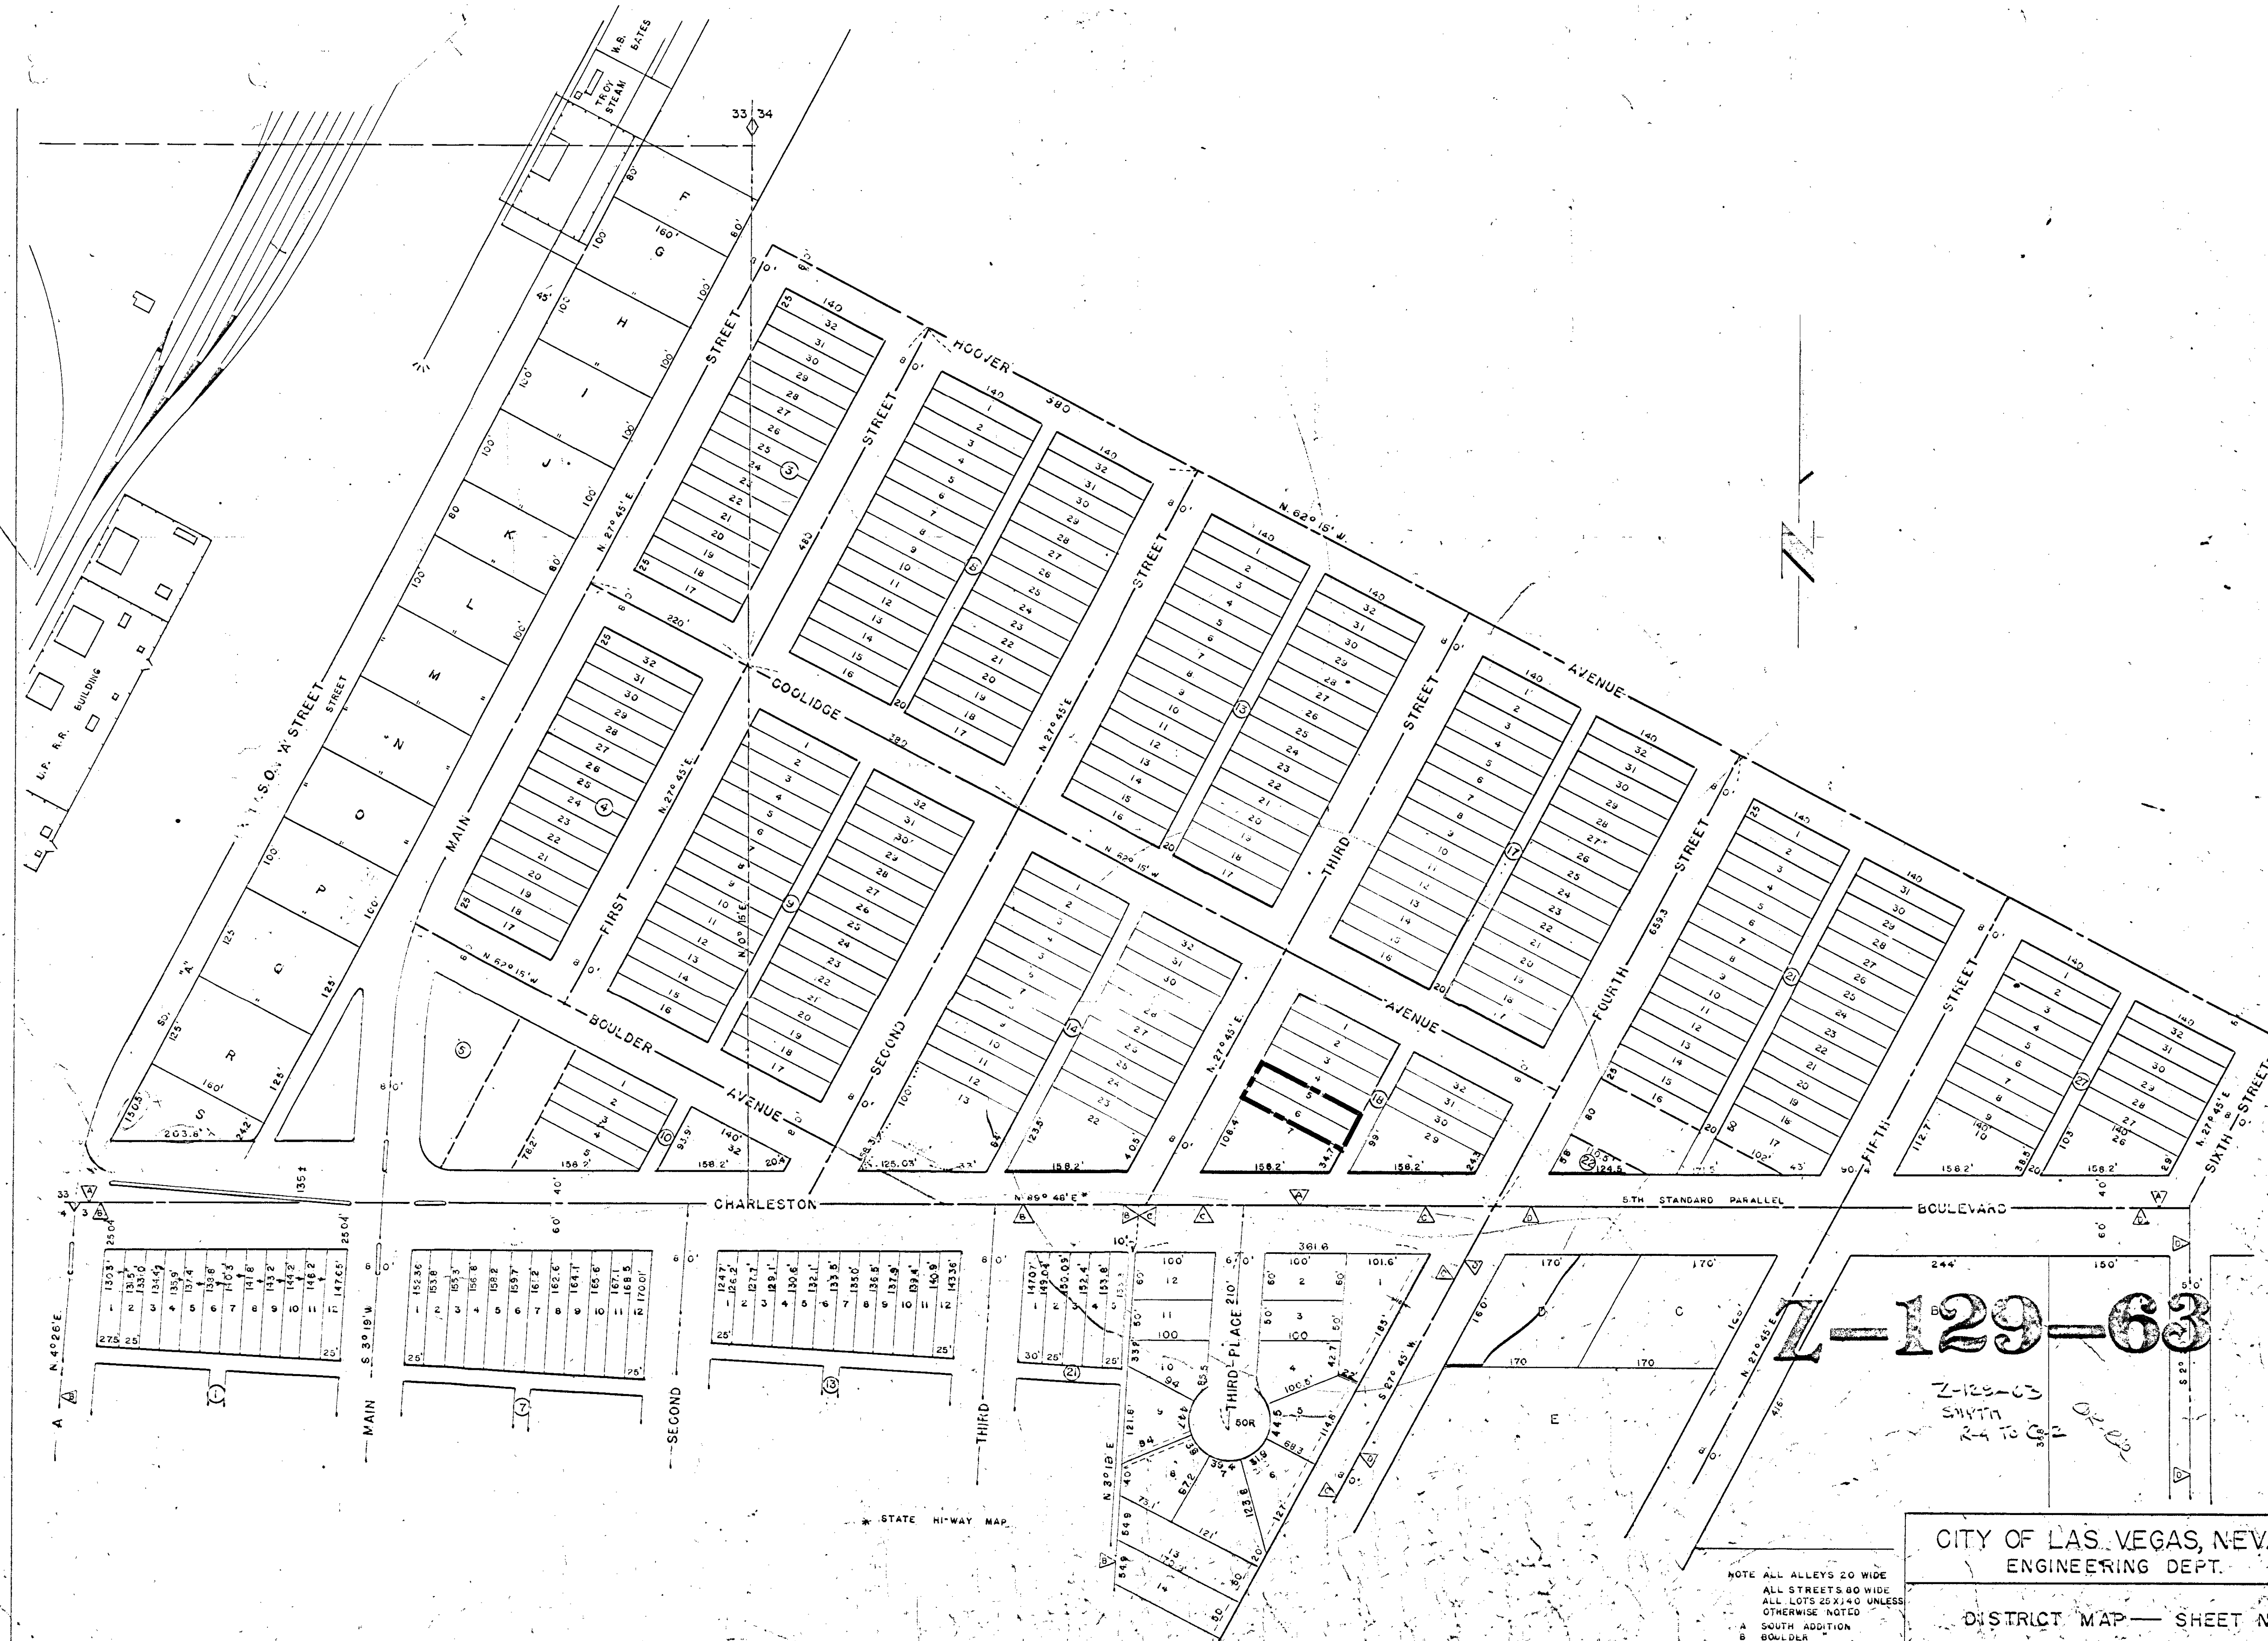

129