


SHEET NO. 143

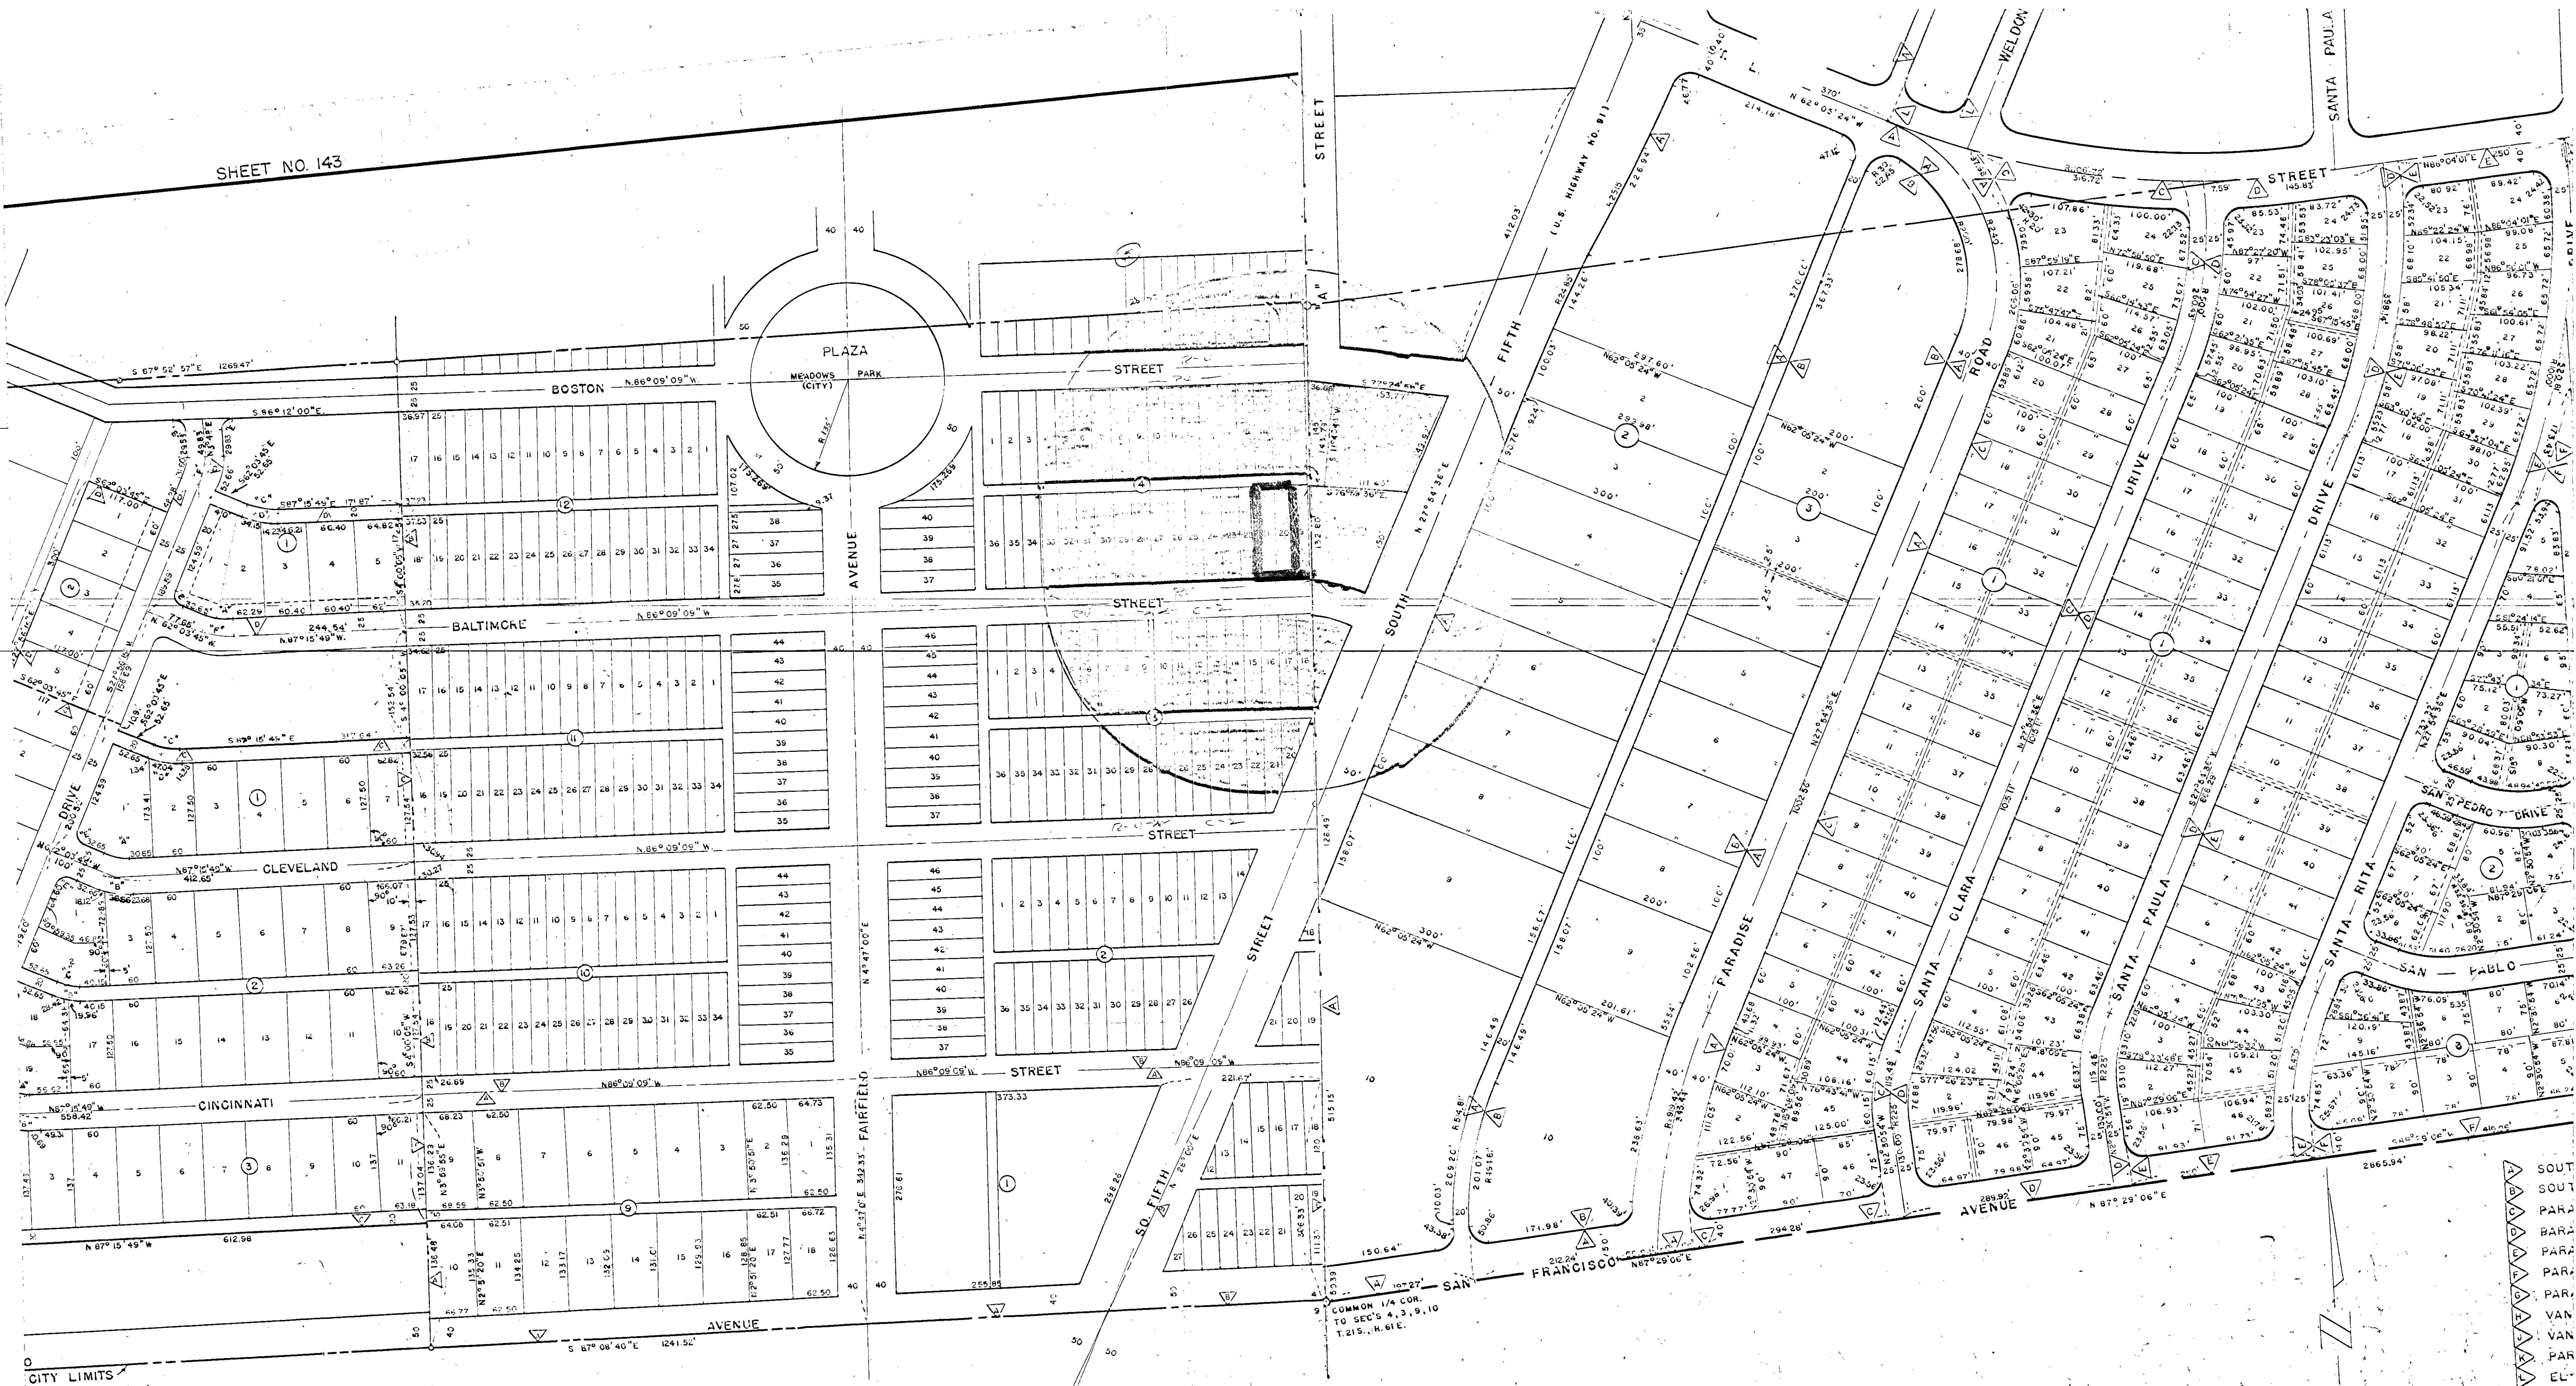

A=R 75' L=32.988'
B=R 125' L=54.980'
C=R 90' L=39.586'
D=R 110' L=48.383'
E=R 20' L=15.708'
F=R 100' L=42.13'

- MEADOWS ADDITION (RE-SUB)
- MEADOWS ADDITION
- JUDY RICH TRACT
- JUDY RICH TRACT II

NOTE: ALL LOTS FACING
FAIRFIELD 27.5 X 130,
OTHERS 25 X 130.
AVENUES 80' WIDE
STREETS 50' WIDE
ALLEYS 15' WIDE

SV/2 SE1/4 SEC 4 T2S
CITY OF LAS VEGAS
ENGINEERING DEPT

DISTRICT MAP — SHEET

DESIGNED BY	DATE	SCALE
DRAWN BY J. MC MILLAN	T-12-4	FILE
CHECKED BY		WORK
APPROVED		DRA
CITY ENGR.		

Z-131-62

DEC 17 1982
APPROVED
DEC 20 1982
APPROVED

Z-131-62
J. B. S.
R-4 TO C-2