
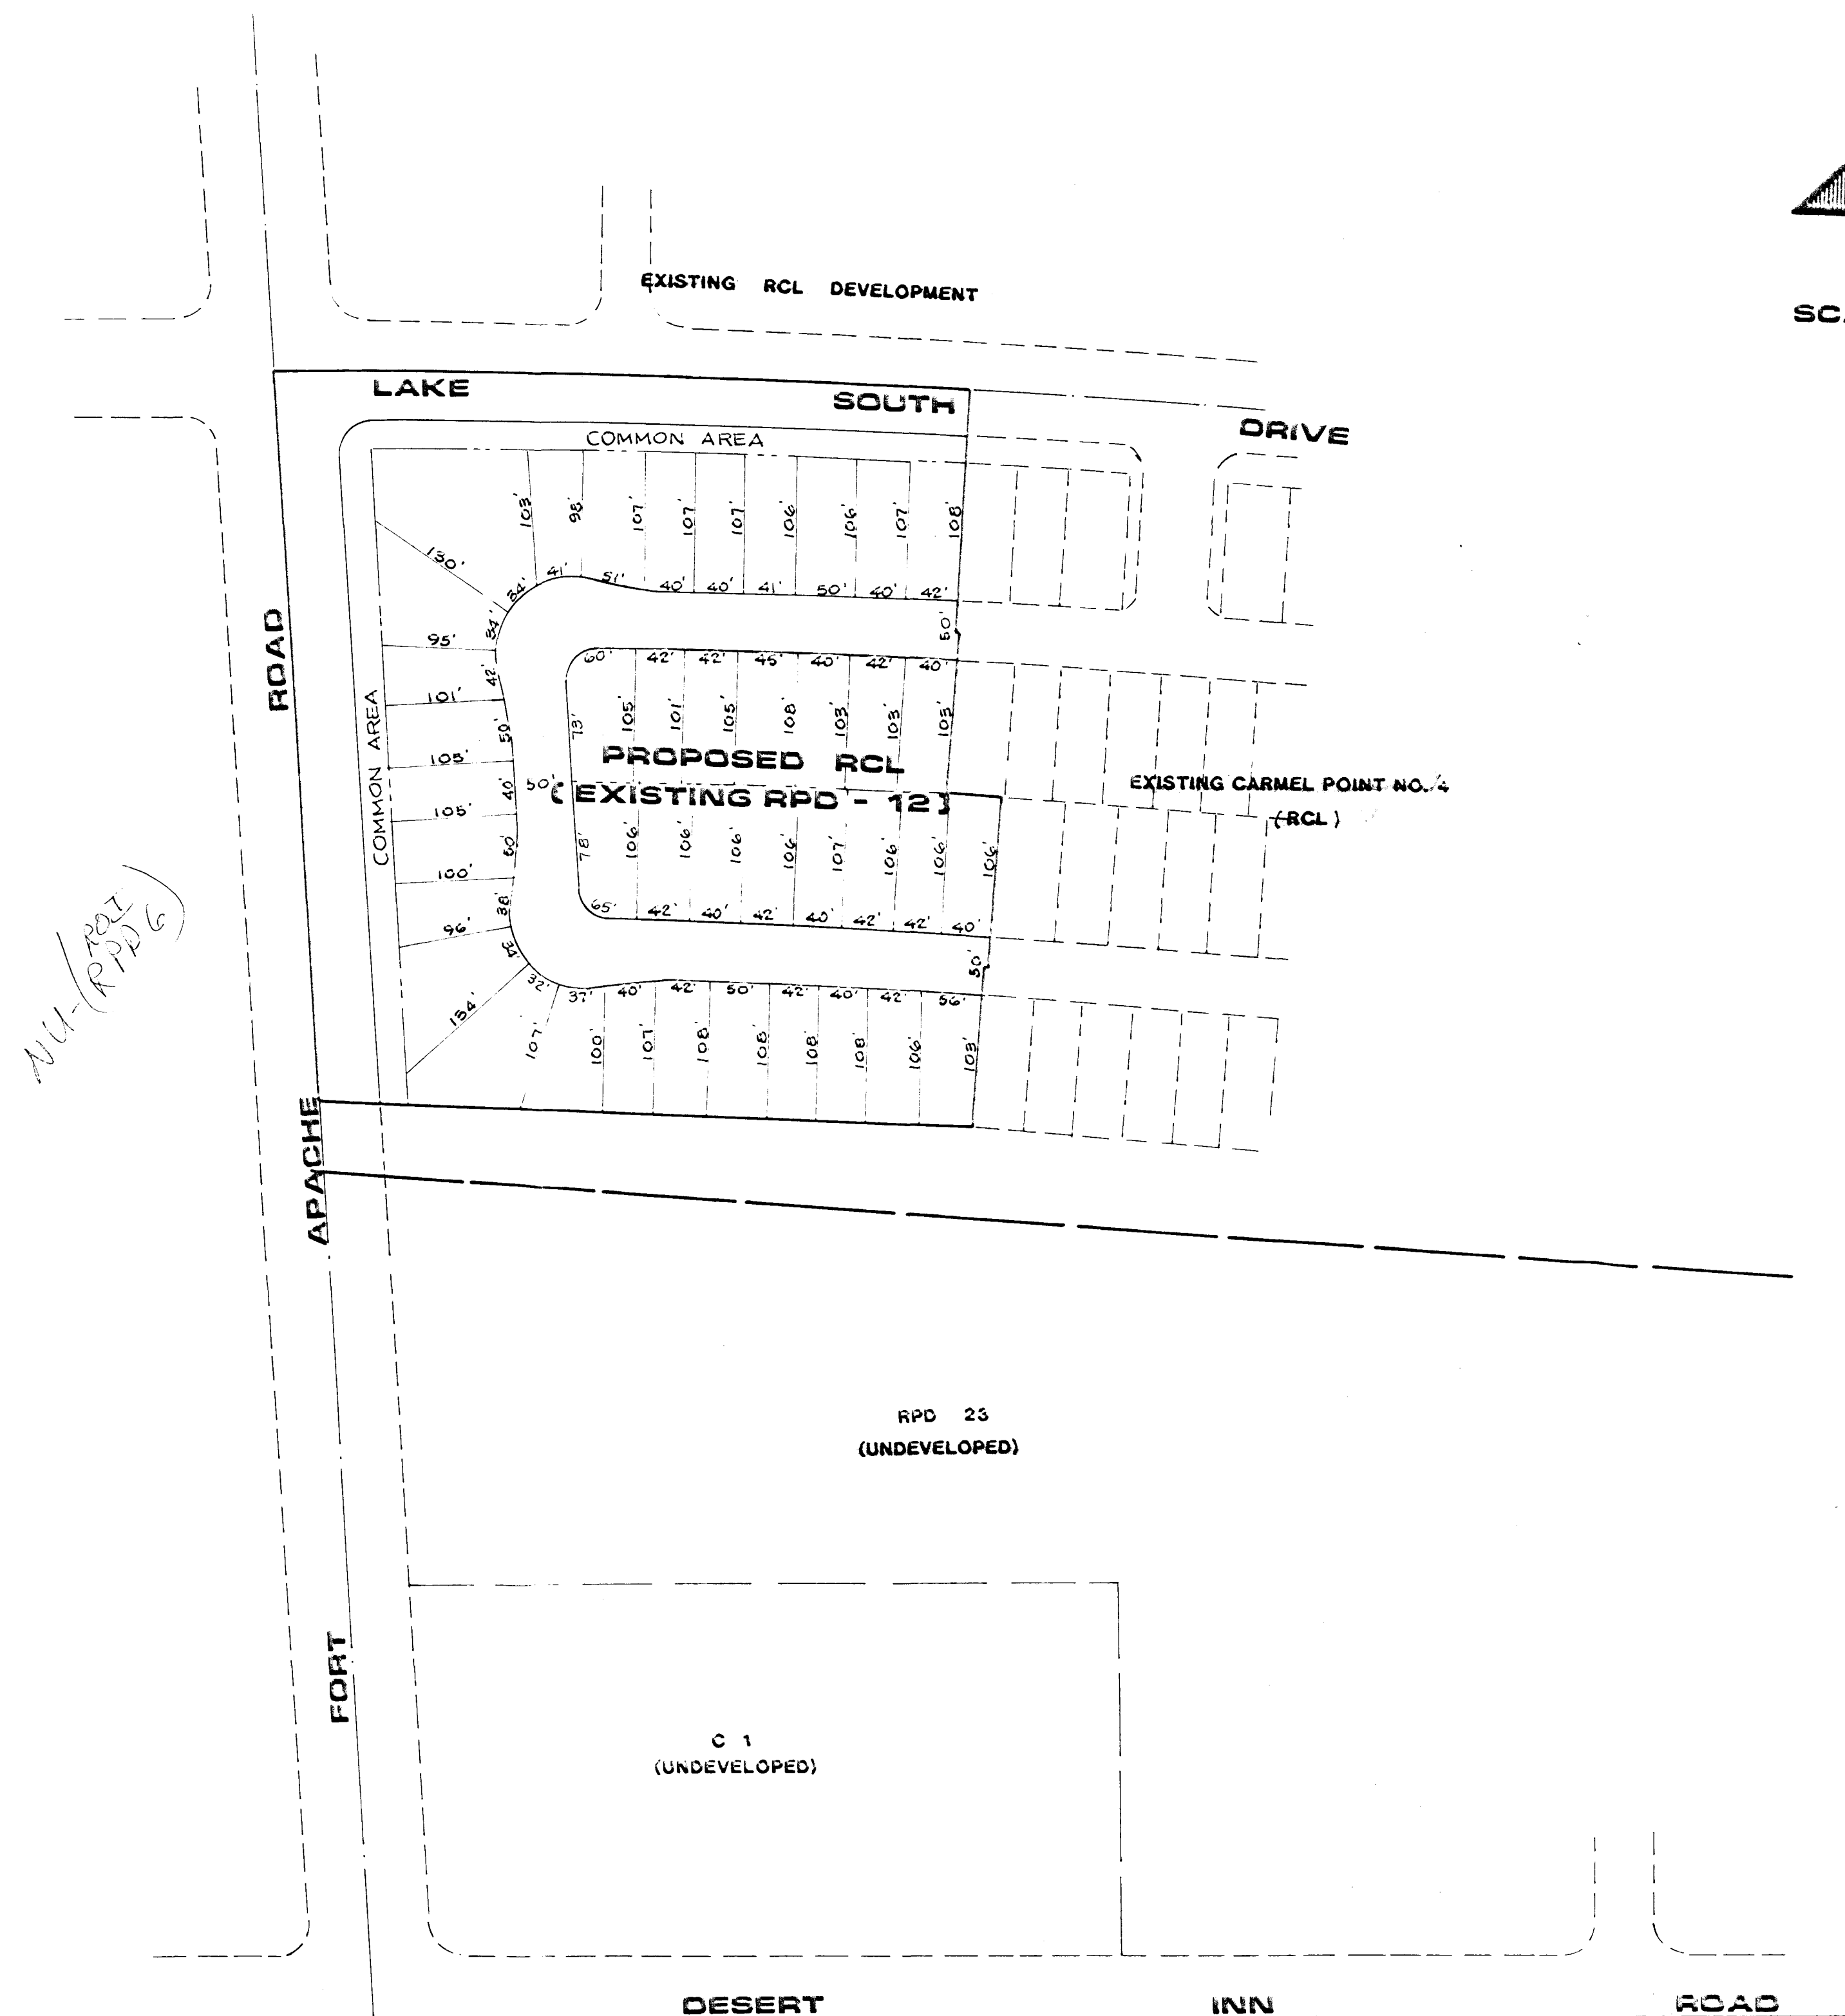


ZONING MAP OF CARMEL POINT NO. 5 BY LEWIS HOMES

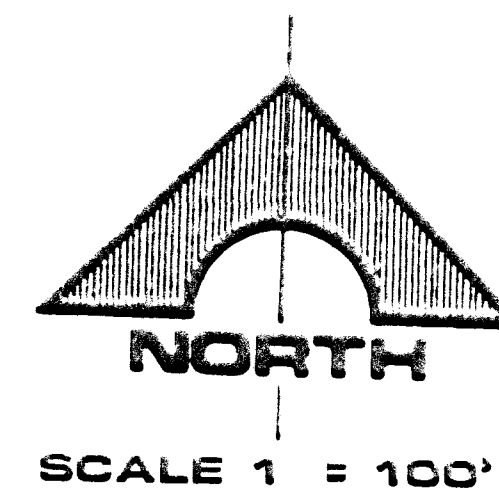

LAND USE DATA

EXISTING ZONING: RPD-12

PROPOSED ZONING: RCL
 GROSS ACREAGE: 6.1 AC. 7.4 on TMA
 MIN. LOT SIZE: 36 x 100'
 TOTAL NO. OF LOTS: 40
 DENSITY: 6.60 LOTS/AC

LEGAL DESCRIPTION

A PORTION OF THE SOUTHWEST QUARTER (SW 1/4) OF SECTION 8, TOWNSHIP 21 SOUTH, RANGE 60 EAST, M.D.M., CITY OF LAS VEGAS, CLARK COUNTY, NEVADA.

RECORD OWNER & DEVELOPER

LEWIS HOMES OF NEVADA
 5240 SOUTH POLARIS AVENUE
 LAS VEGAS, NEVADA 89118
 TEL. (702) 736-8960

STAFF

DESCRIPTION

REV DATE

RE NO DATE

RECOMMENDED

G.C. WALLACE, INC.
 Engineering/Architecture
 1555 SOUTH RAINBOW BLVD. LAS VEGAS, NEVADA 89102



LEWIS HOMES OF NEVADA
 CARMEL POINT NO. 5 BY LEWIS HOMES
 ZONING MAP

SHEET

2 SHEETS

JOE NO. 5543.8580

LEWIS HOMES

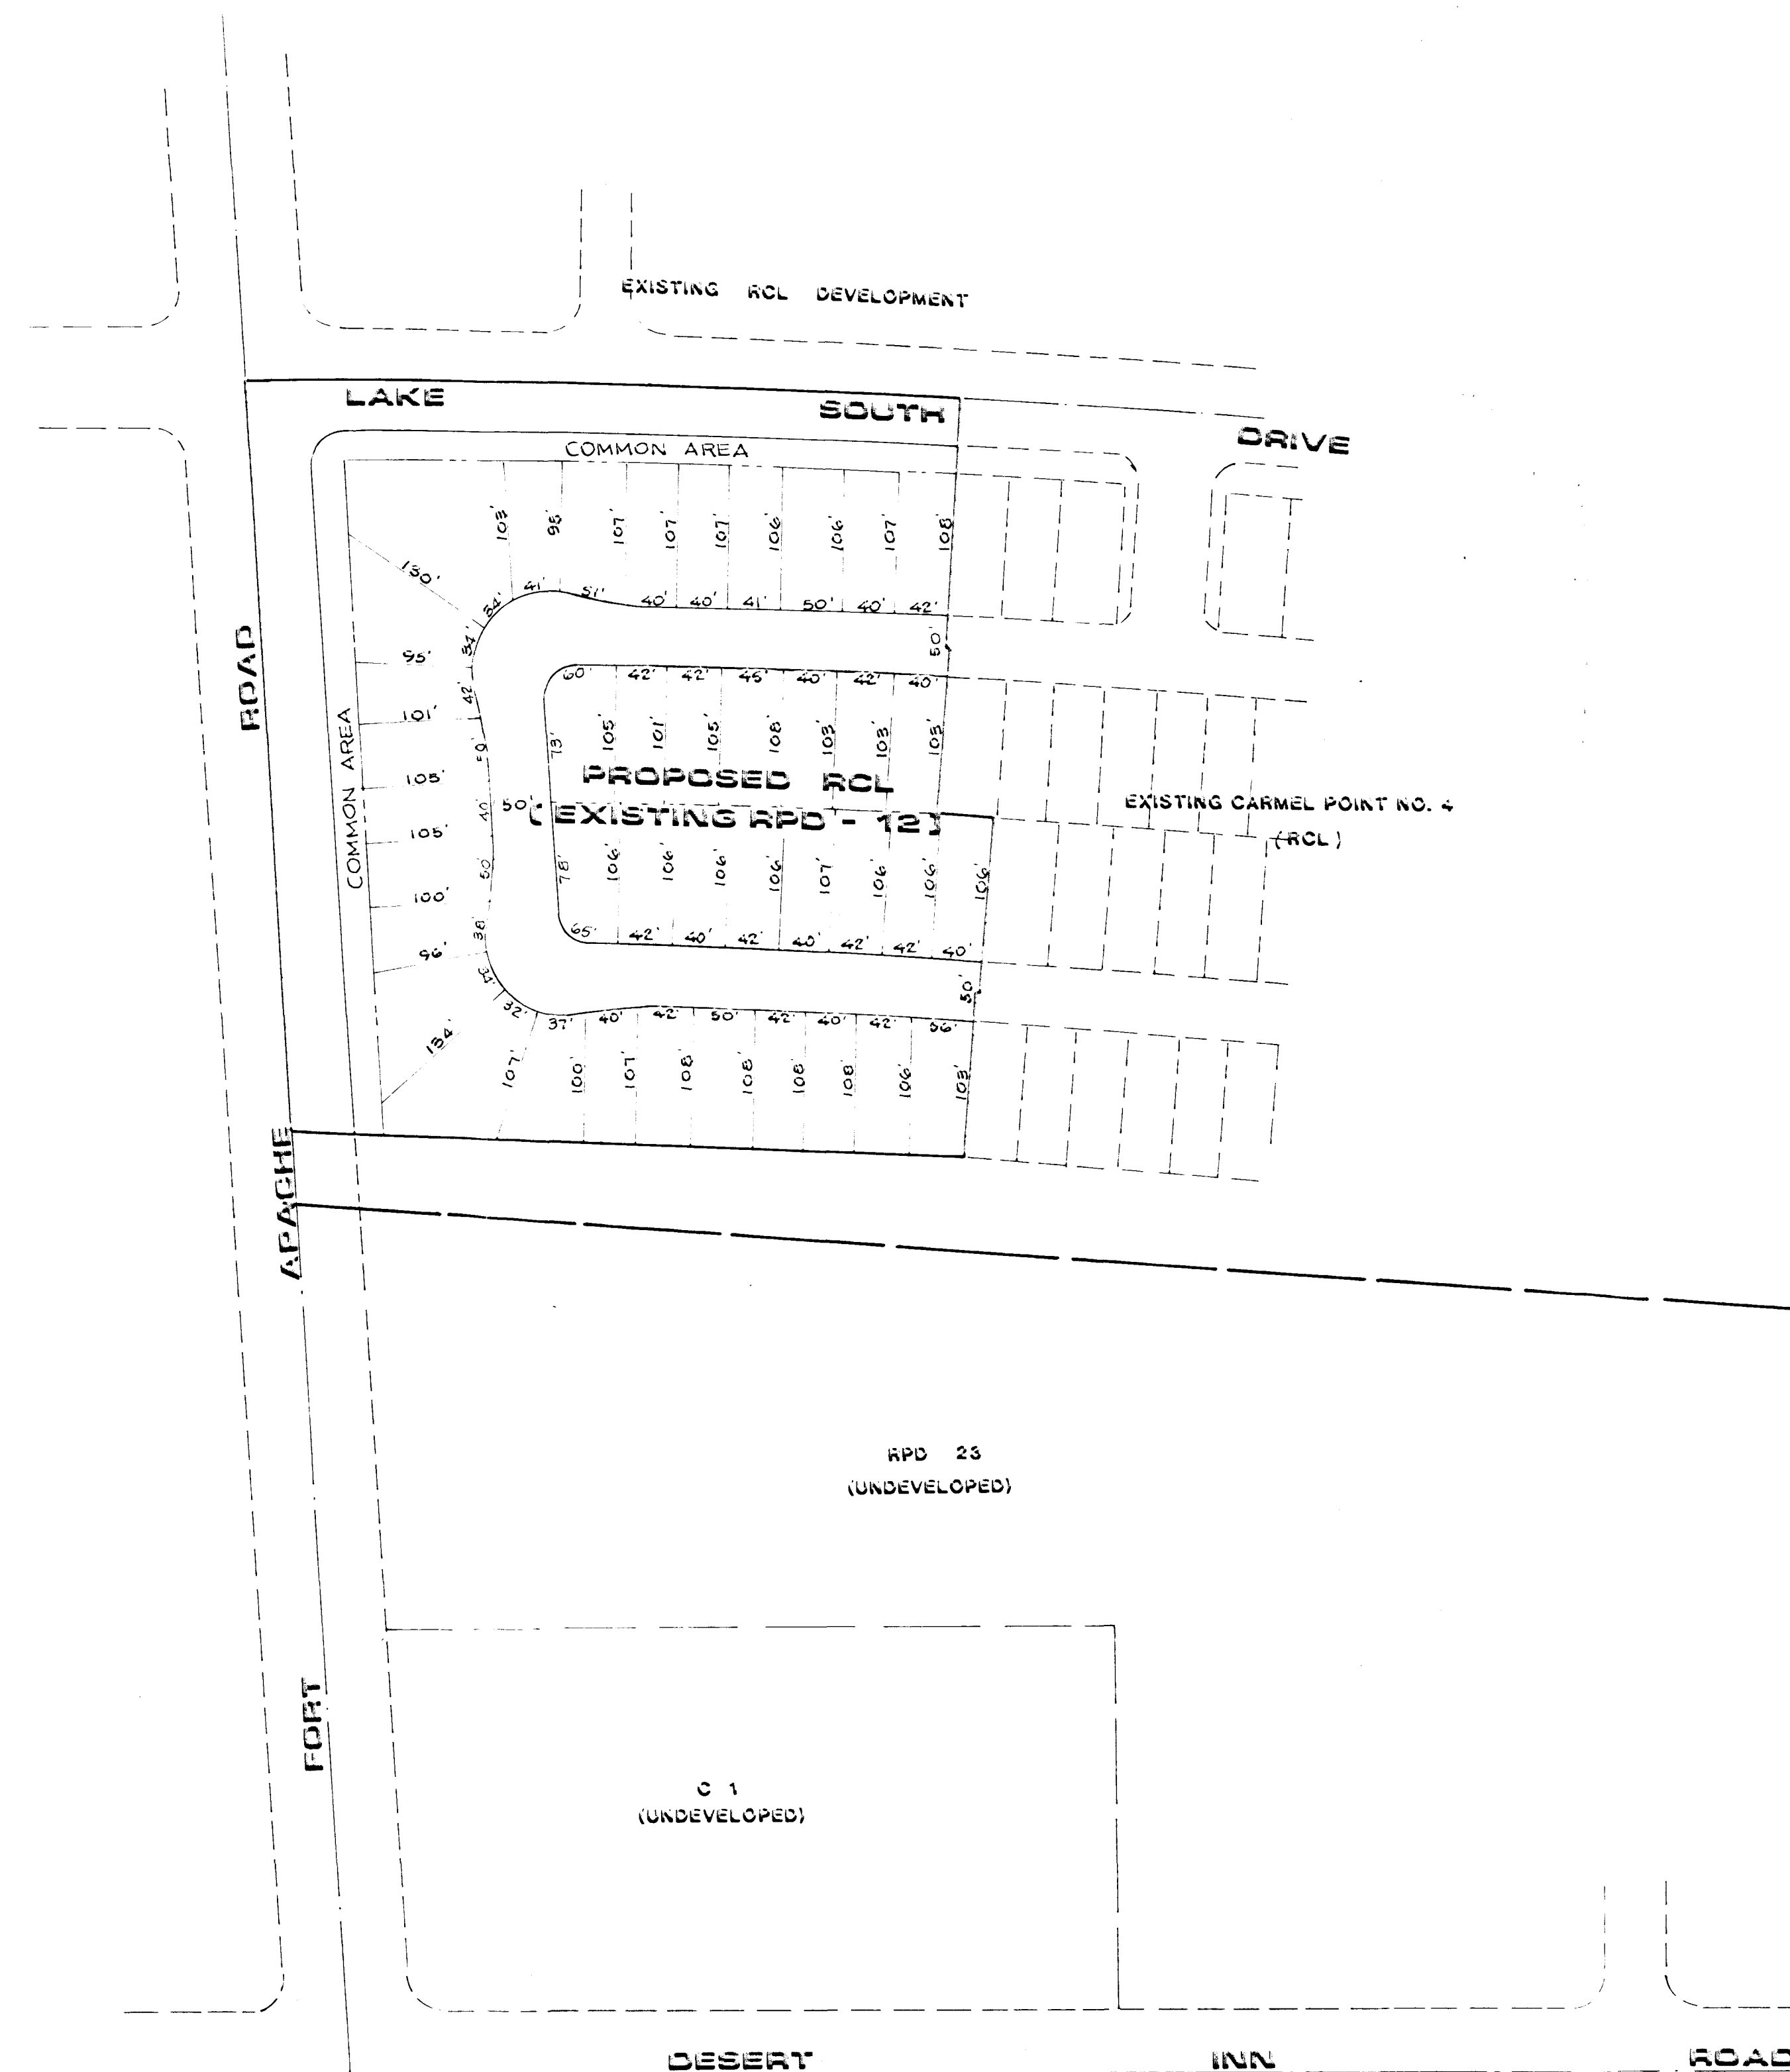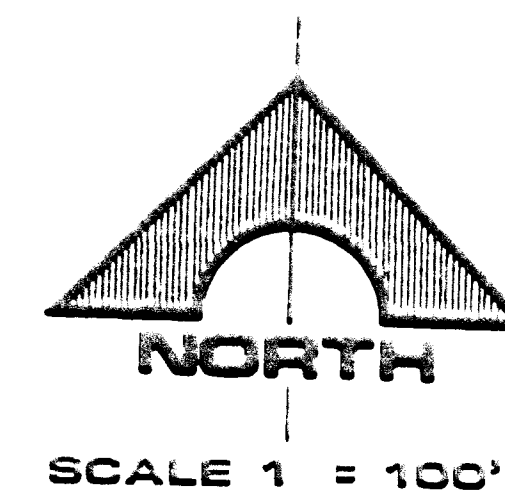

LAND USE DATA

EXISTING ZONING: RPD-12

PROPOSED ZONING: RCL
GROSS ACREAGE: 6.1 AC.
MIN. LOT SIZE: 36'x100'
TOTAL NO. OF LOTS: 40
DENSITY: 6.60[±] LOTS/AC

LEGAL DESCRIPTION

A PORTION OF THE SOUTHWEST QUARTER (SW 1/4) OF
SECTION 8, TOWNSHIP 21 SOUTH, RANGE 60 EAST,
M.D.M., CITY OF LAS VEGAS, CLARK COUNTY, NEVADA.

RECORD OWNER & DEVELOPER

LEWIS HOMES OF NEVADA
5240 SOUTH POLARIS AVENUE
LAS VEGAS, NEVADA 89118
TEL. (702) 736-8960

OF 1 SHEETS