


REBECCA ROAD

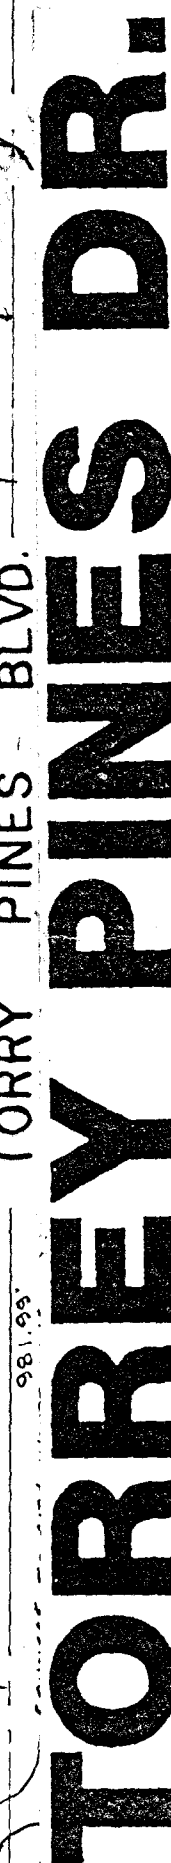


SCALE - 1" = 100'

WATER LINE
FIRE HYDRANT
SEWER LINE
WATER VALVE
SEWER MANHOLE
SQUARE FEET



- A) A.C. PAV. TO BE $\frac{1}{2}$ " ABOVE LIP OF GUTTER AFTER COMPACTION
- B) SUBGRADE FOR TYPE I UNDER CURB & GUTTER AND UNDER A.C. TO BE CONTINUOUS.
- C) THE MAX. GRADE BREAK OCCURRING IN THE CROSS SECTION SHALL BE 2.0% AND SHALL FALL BETWEEN DRIVING LANES OR BETWEEN A DRIVING LANE AND A PARKING LANE.

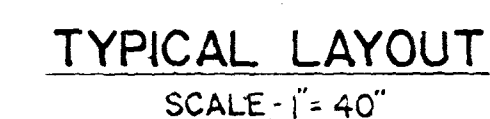

P.C. 1/24/89
C.C. 2/15/89

Z-134-88

2020 Aug 8 - 11/2/89
1-24-89
1-24-89
CC-3/15/89 APPD