

OWNER/DEVELOPER

BONANZA PROPERTIES
5606 S EASTERN AVE
LAS VEGAS, NV
(702) 736-1022


TOTAL ACREAGE 1.5'

PRESENT LAND USE: VACANT (H-E)

PROPOSED LAND USE GRAVEL STORAGE YARD

LEGAL DESCRIPTION ~~AS PER THE PARCELS~~

100 251

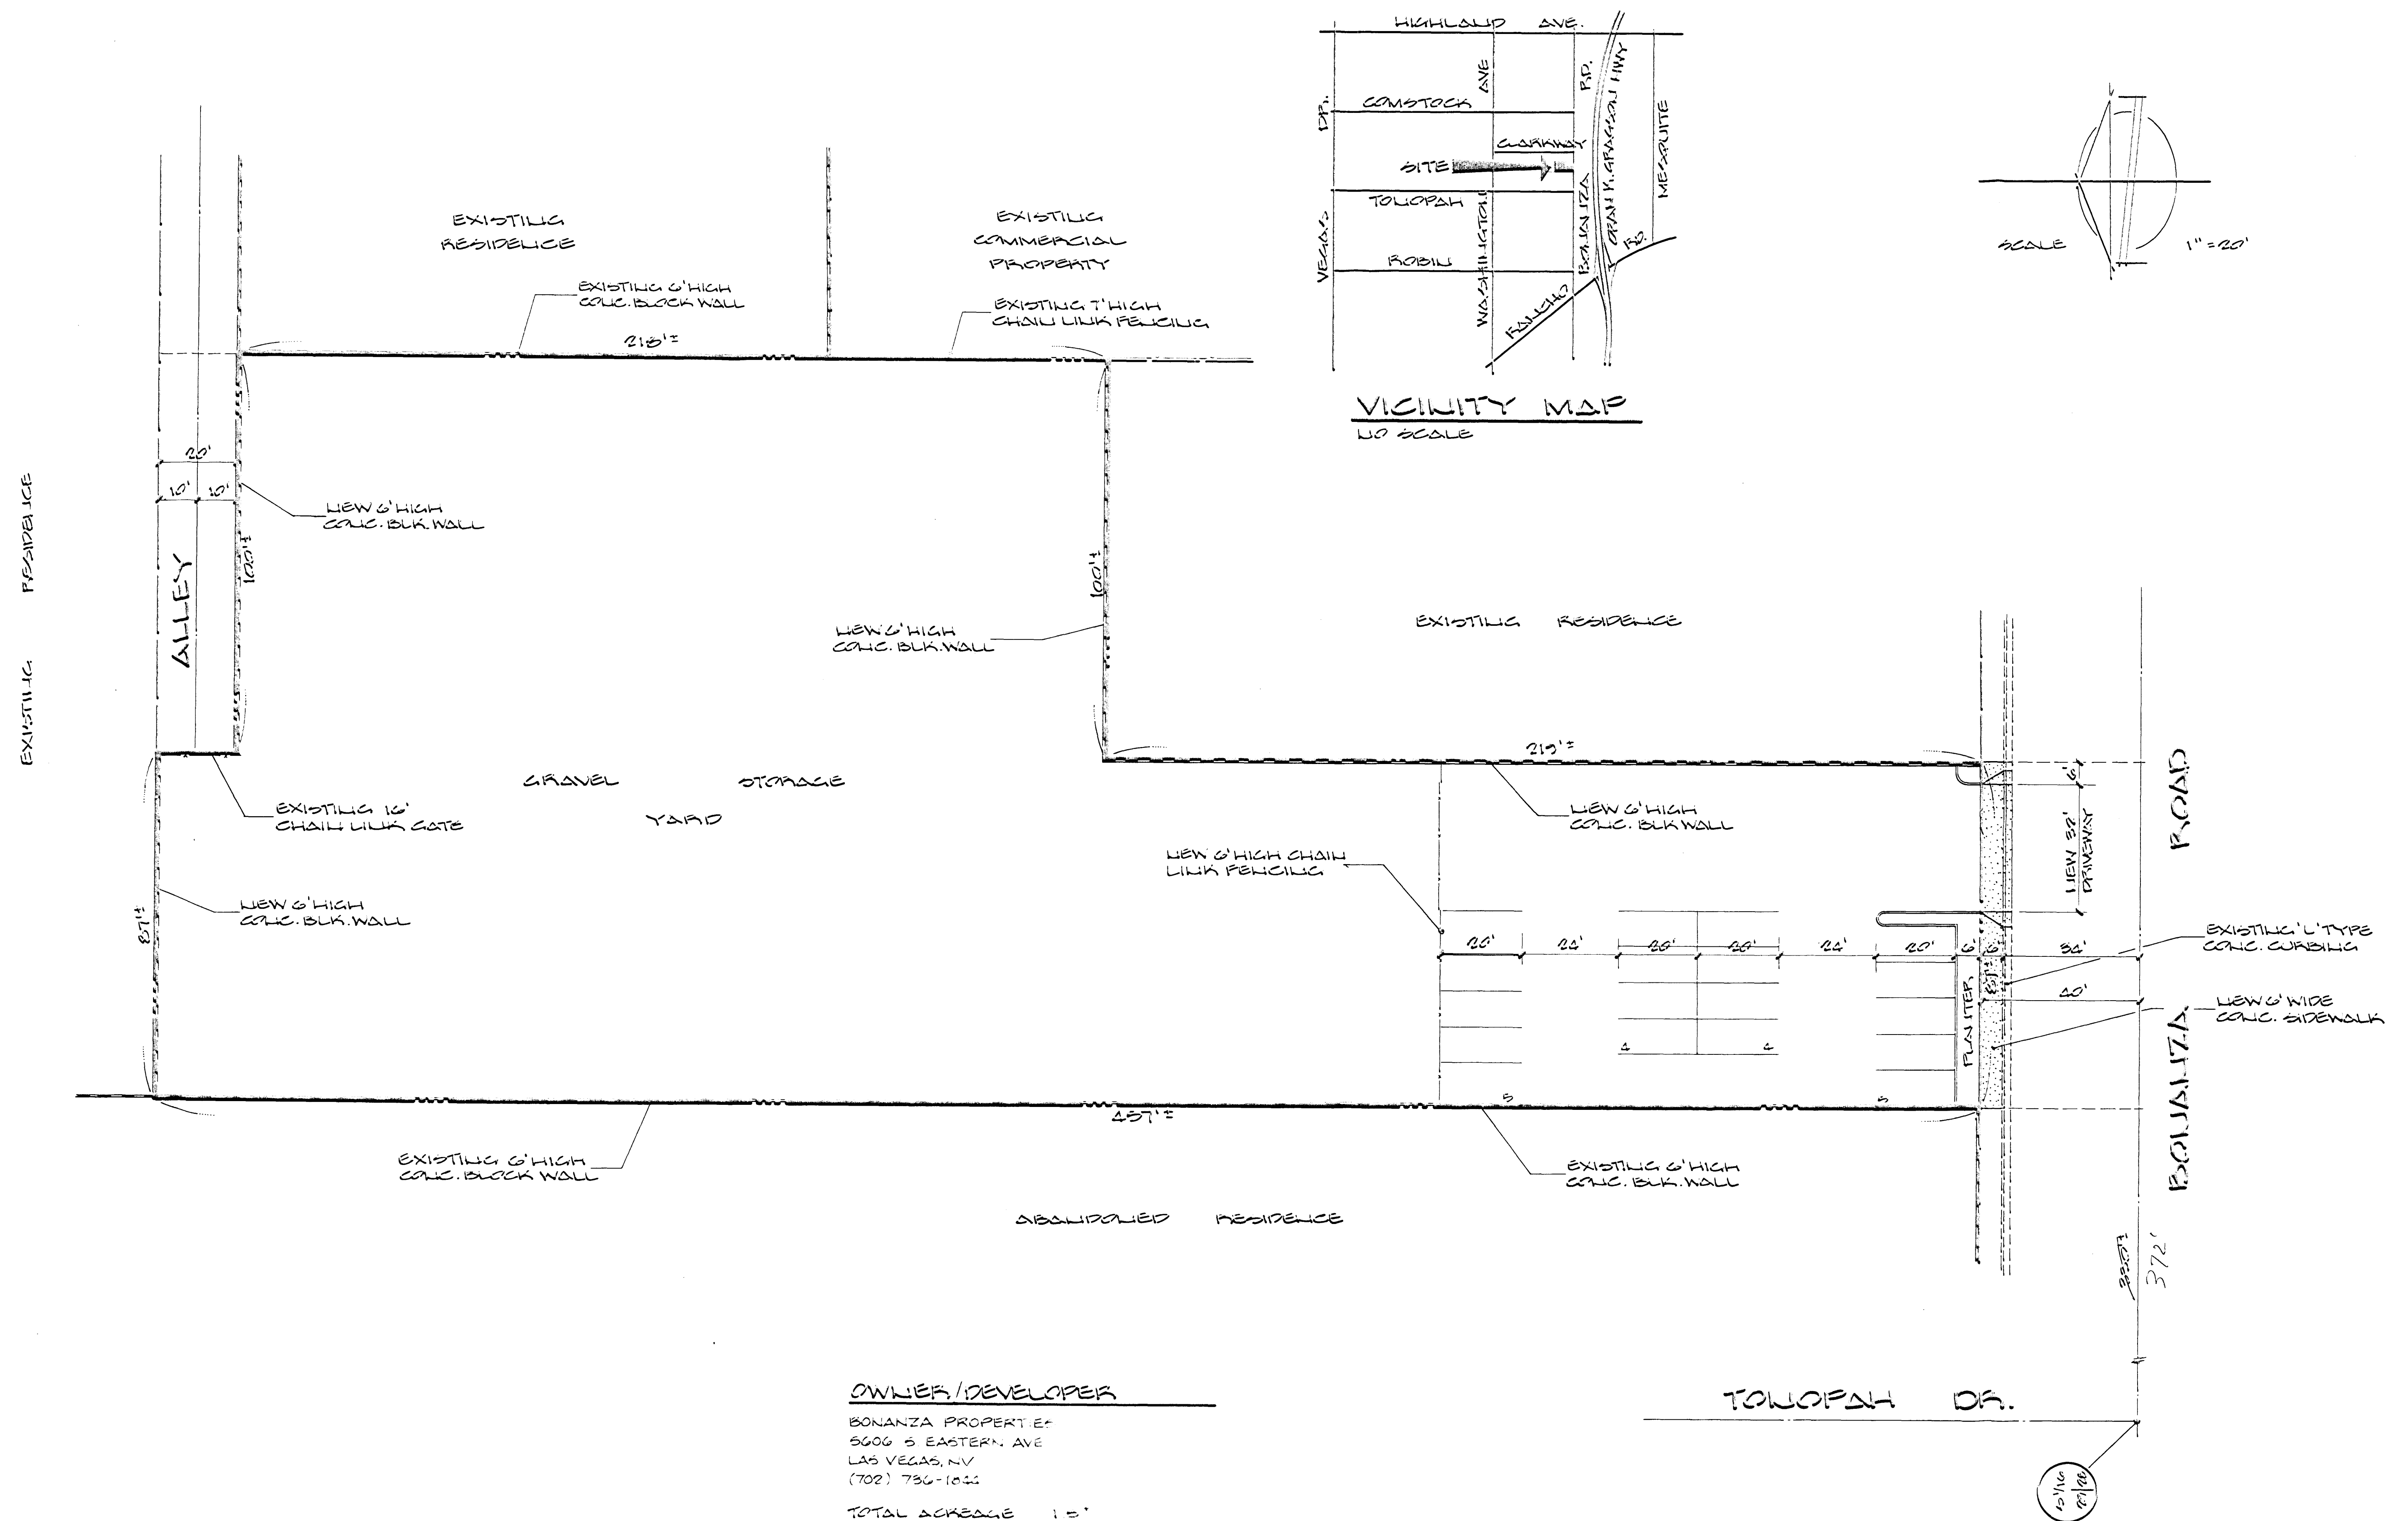


DATE	DESIGN	DRAWN	CHECK	SCALE
DEC. 21, 1967	ANNA	ANNA	JWL	1" = 40'

DATE NO. _____
 REVISIONS _____
 PREPARED FOR: **BOB DOWNLEY**

BAUGHMAN & TURNER
 CIVIL ENGINEERS
 MINING ENGINEERS
 LAND SURVEYORS
 2325 WEST CHARLESTON BOULEVARD
 702-770-8771
 LAS VEGAS, NEVADA
 89102

 CITY OF LAS VEGAS
 NEVADA

PLOT PLAN
31
45

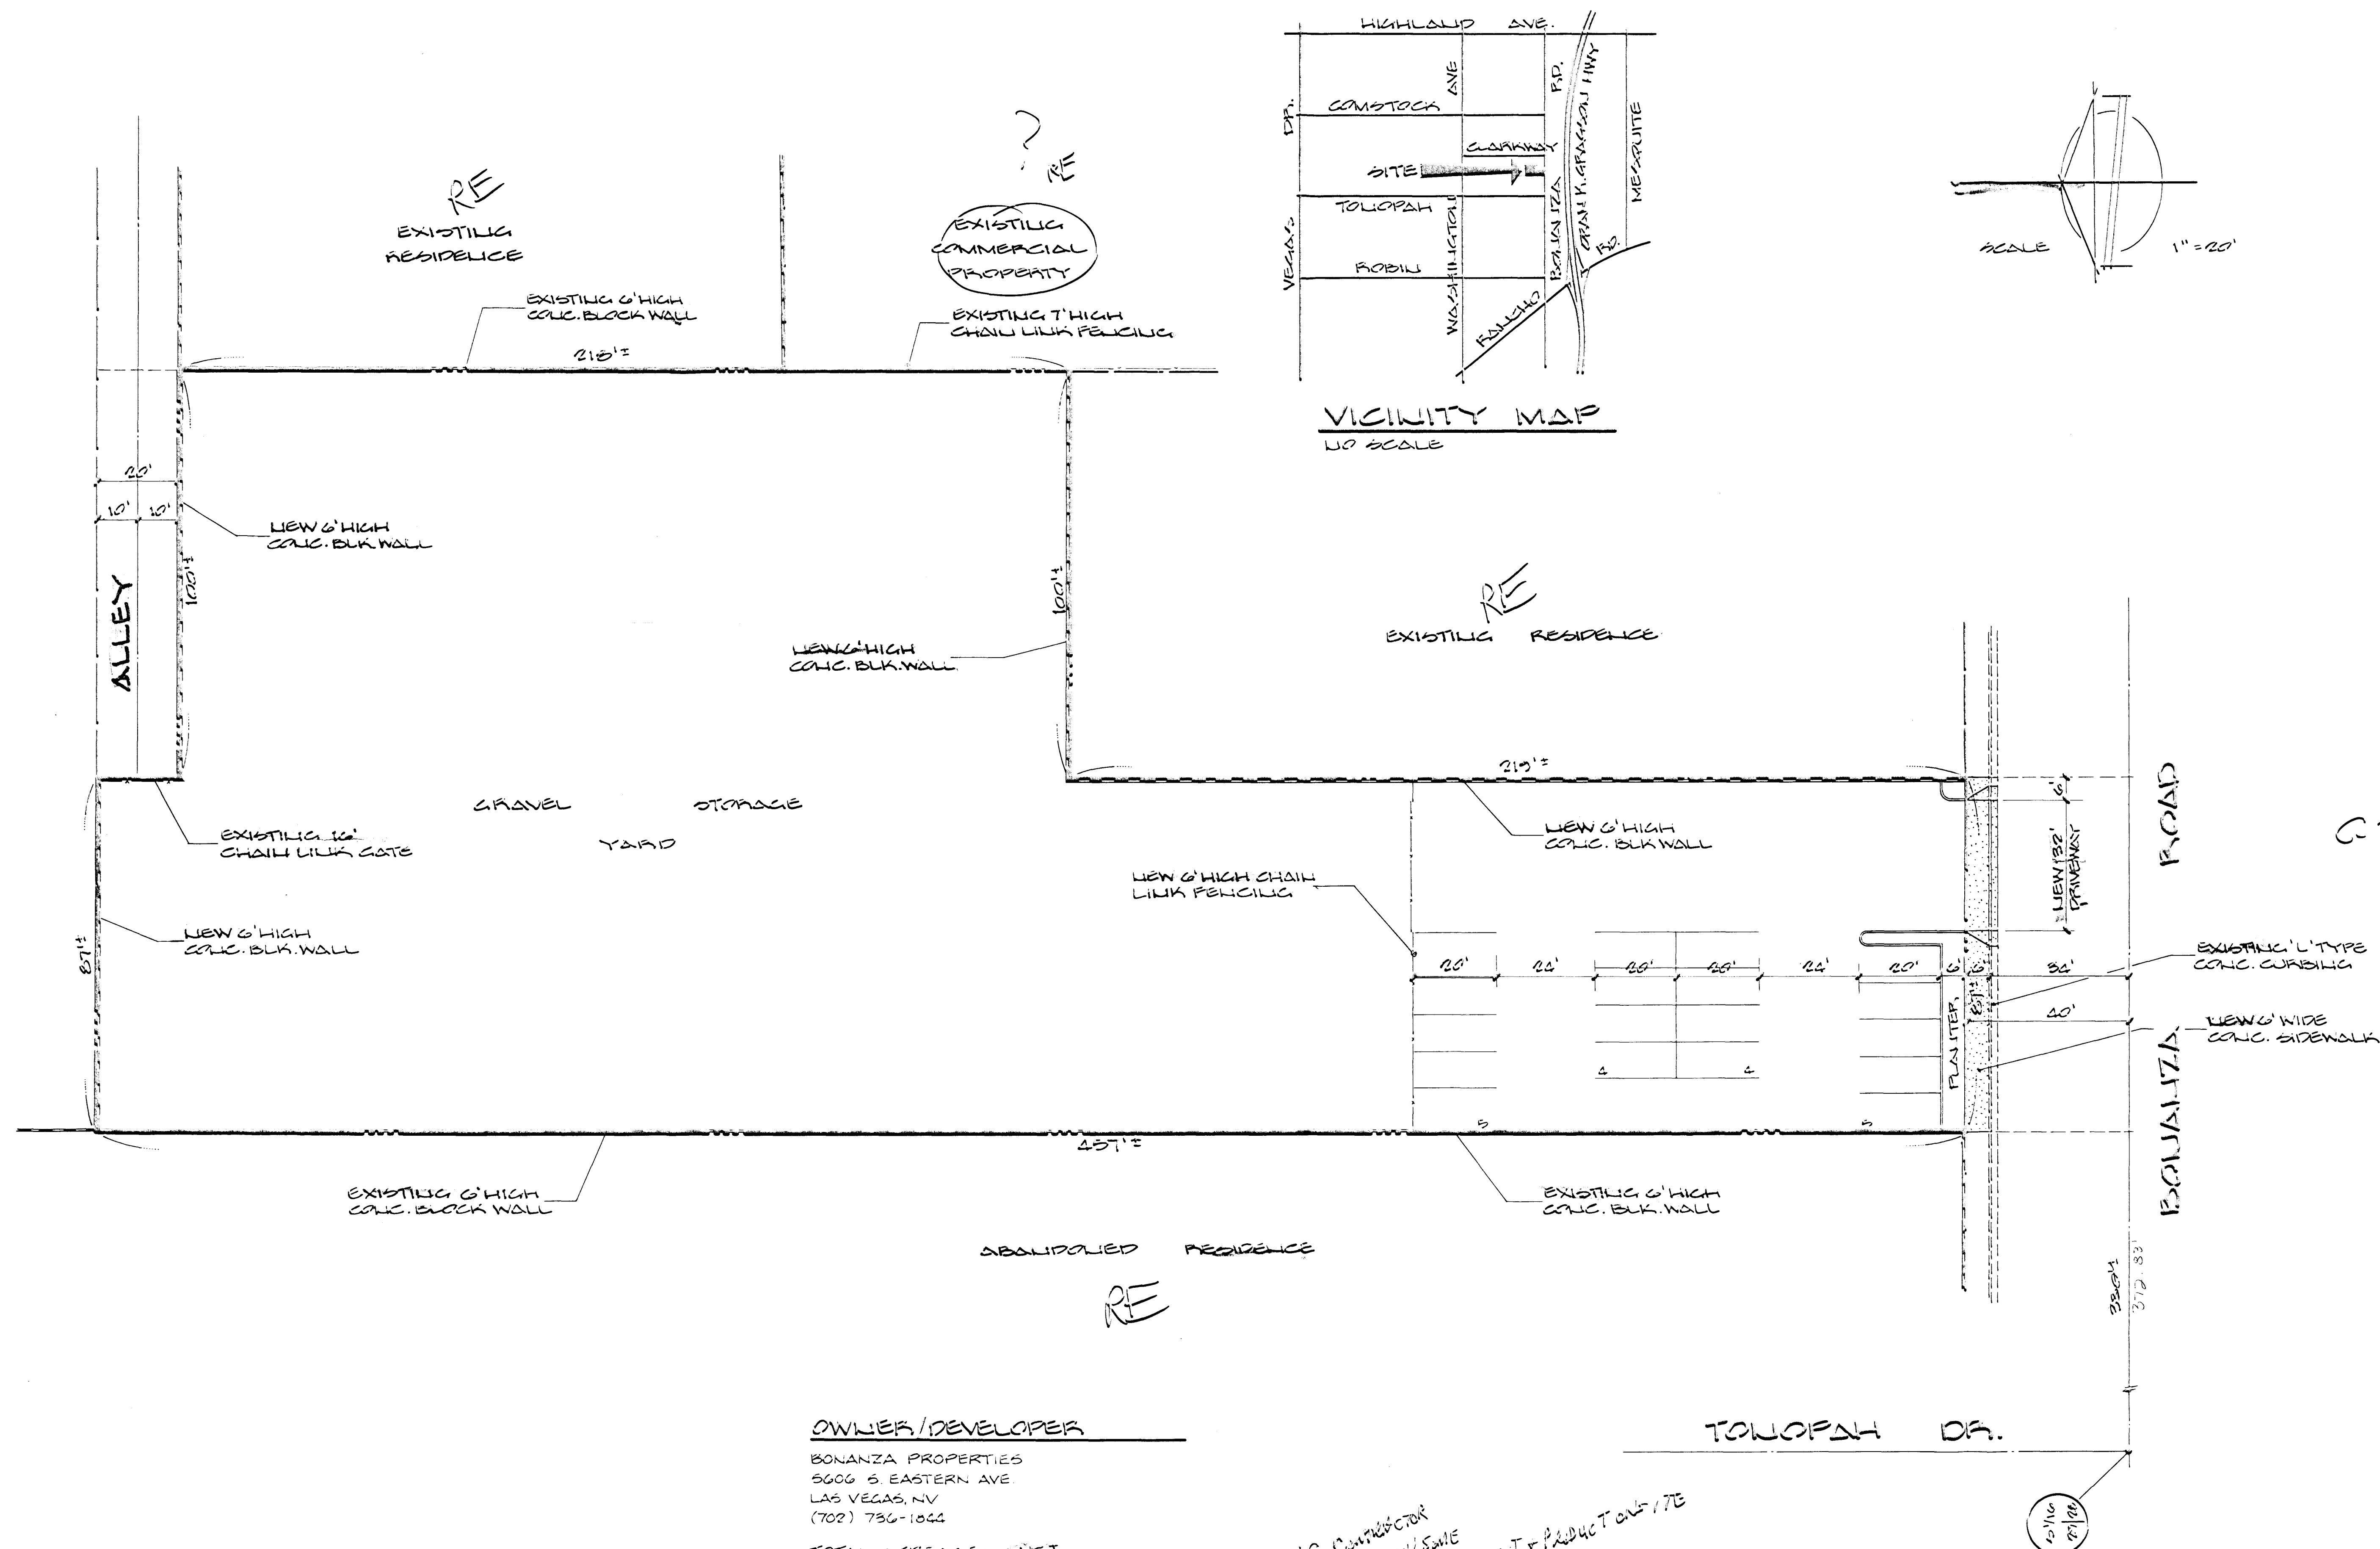

STAFF