



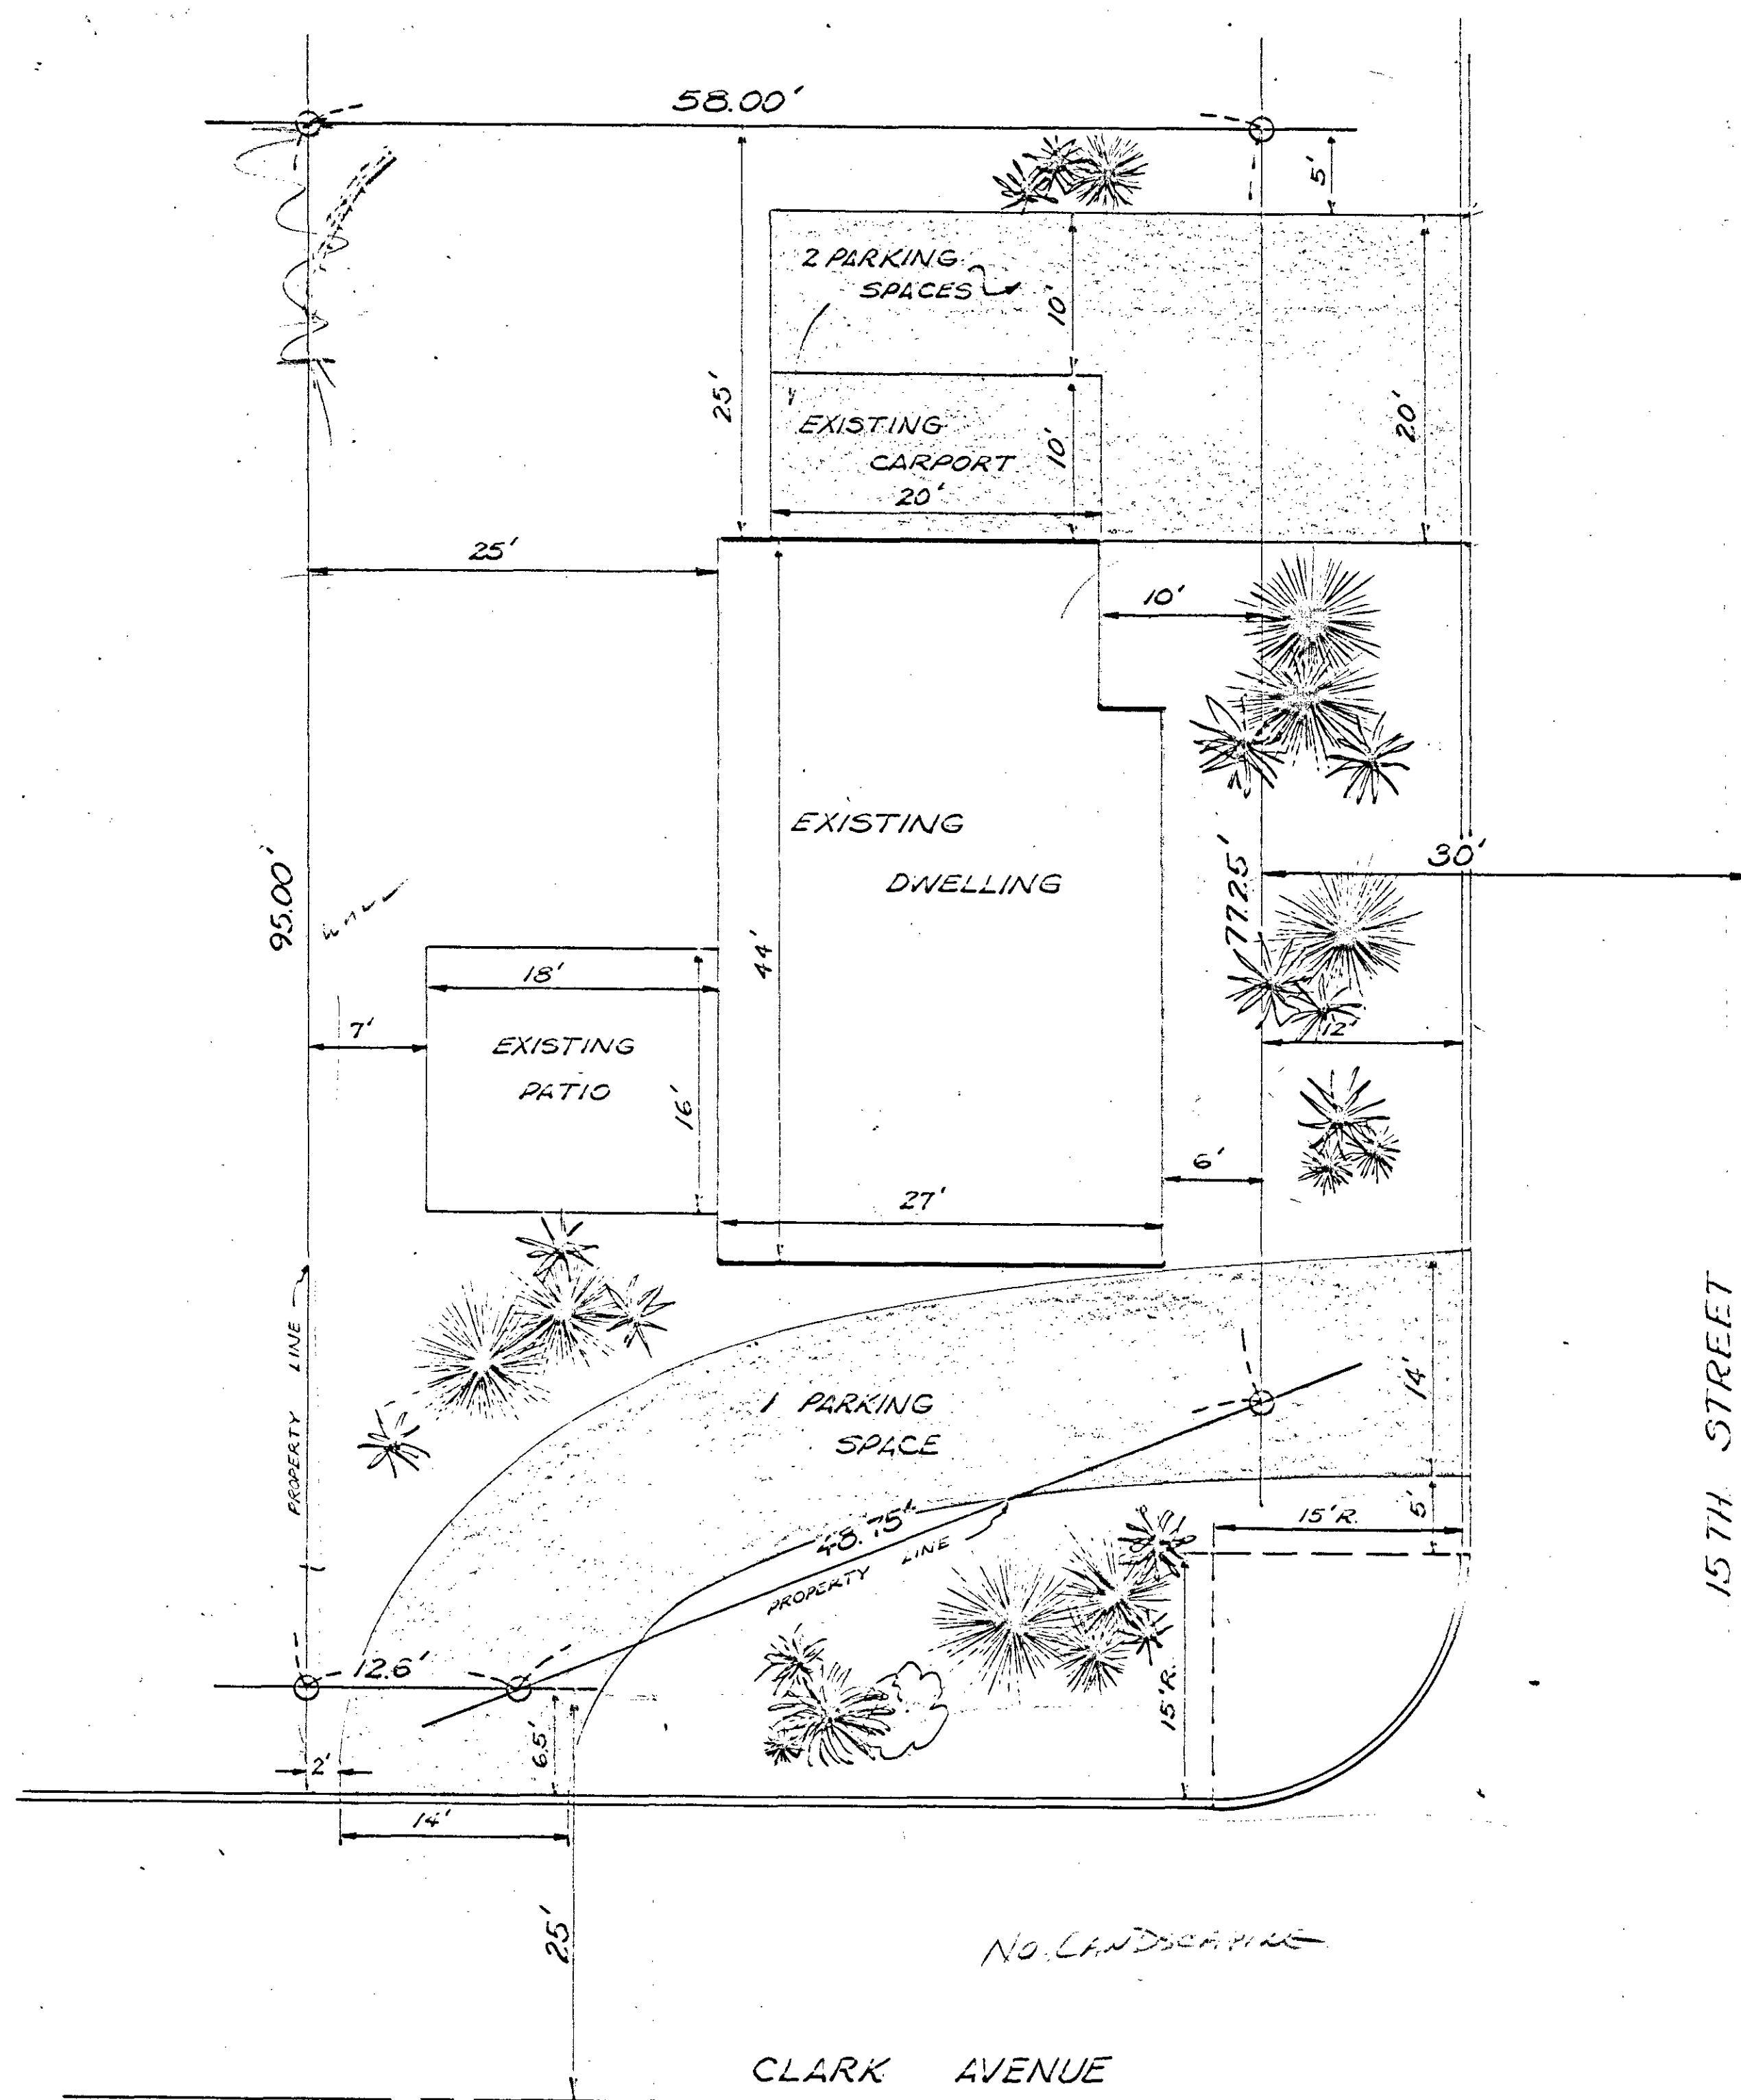

APPROXIMATE PLOT

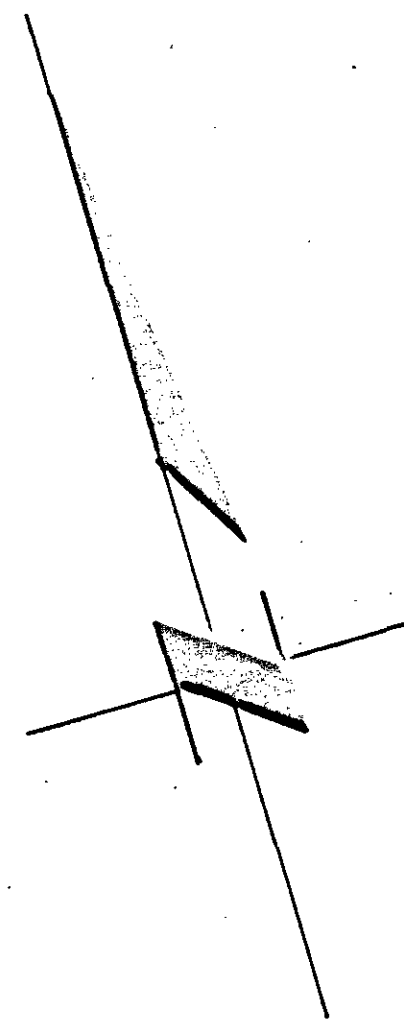

LEGAL DESCRIPTION

LOT 7 BLOCK A
LAS VEGAS DEVELOPEMENT
COMPANY ADDITION

PLOT PLAN

GEORGE L. LYNCH
430 S 15TH

DRAWN BY - J. GRIFFIN SCALE - 1/8" = 1'
DATE - 10-7-63

137