


R-4-3

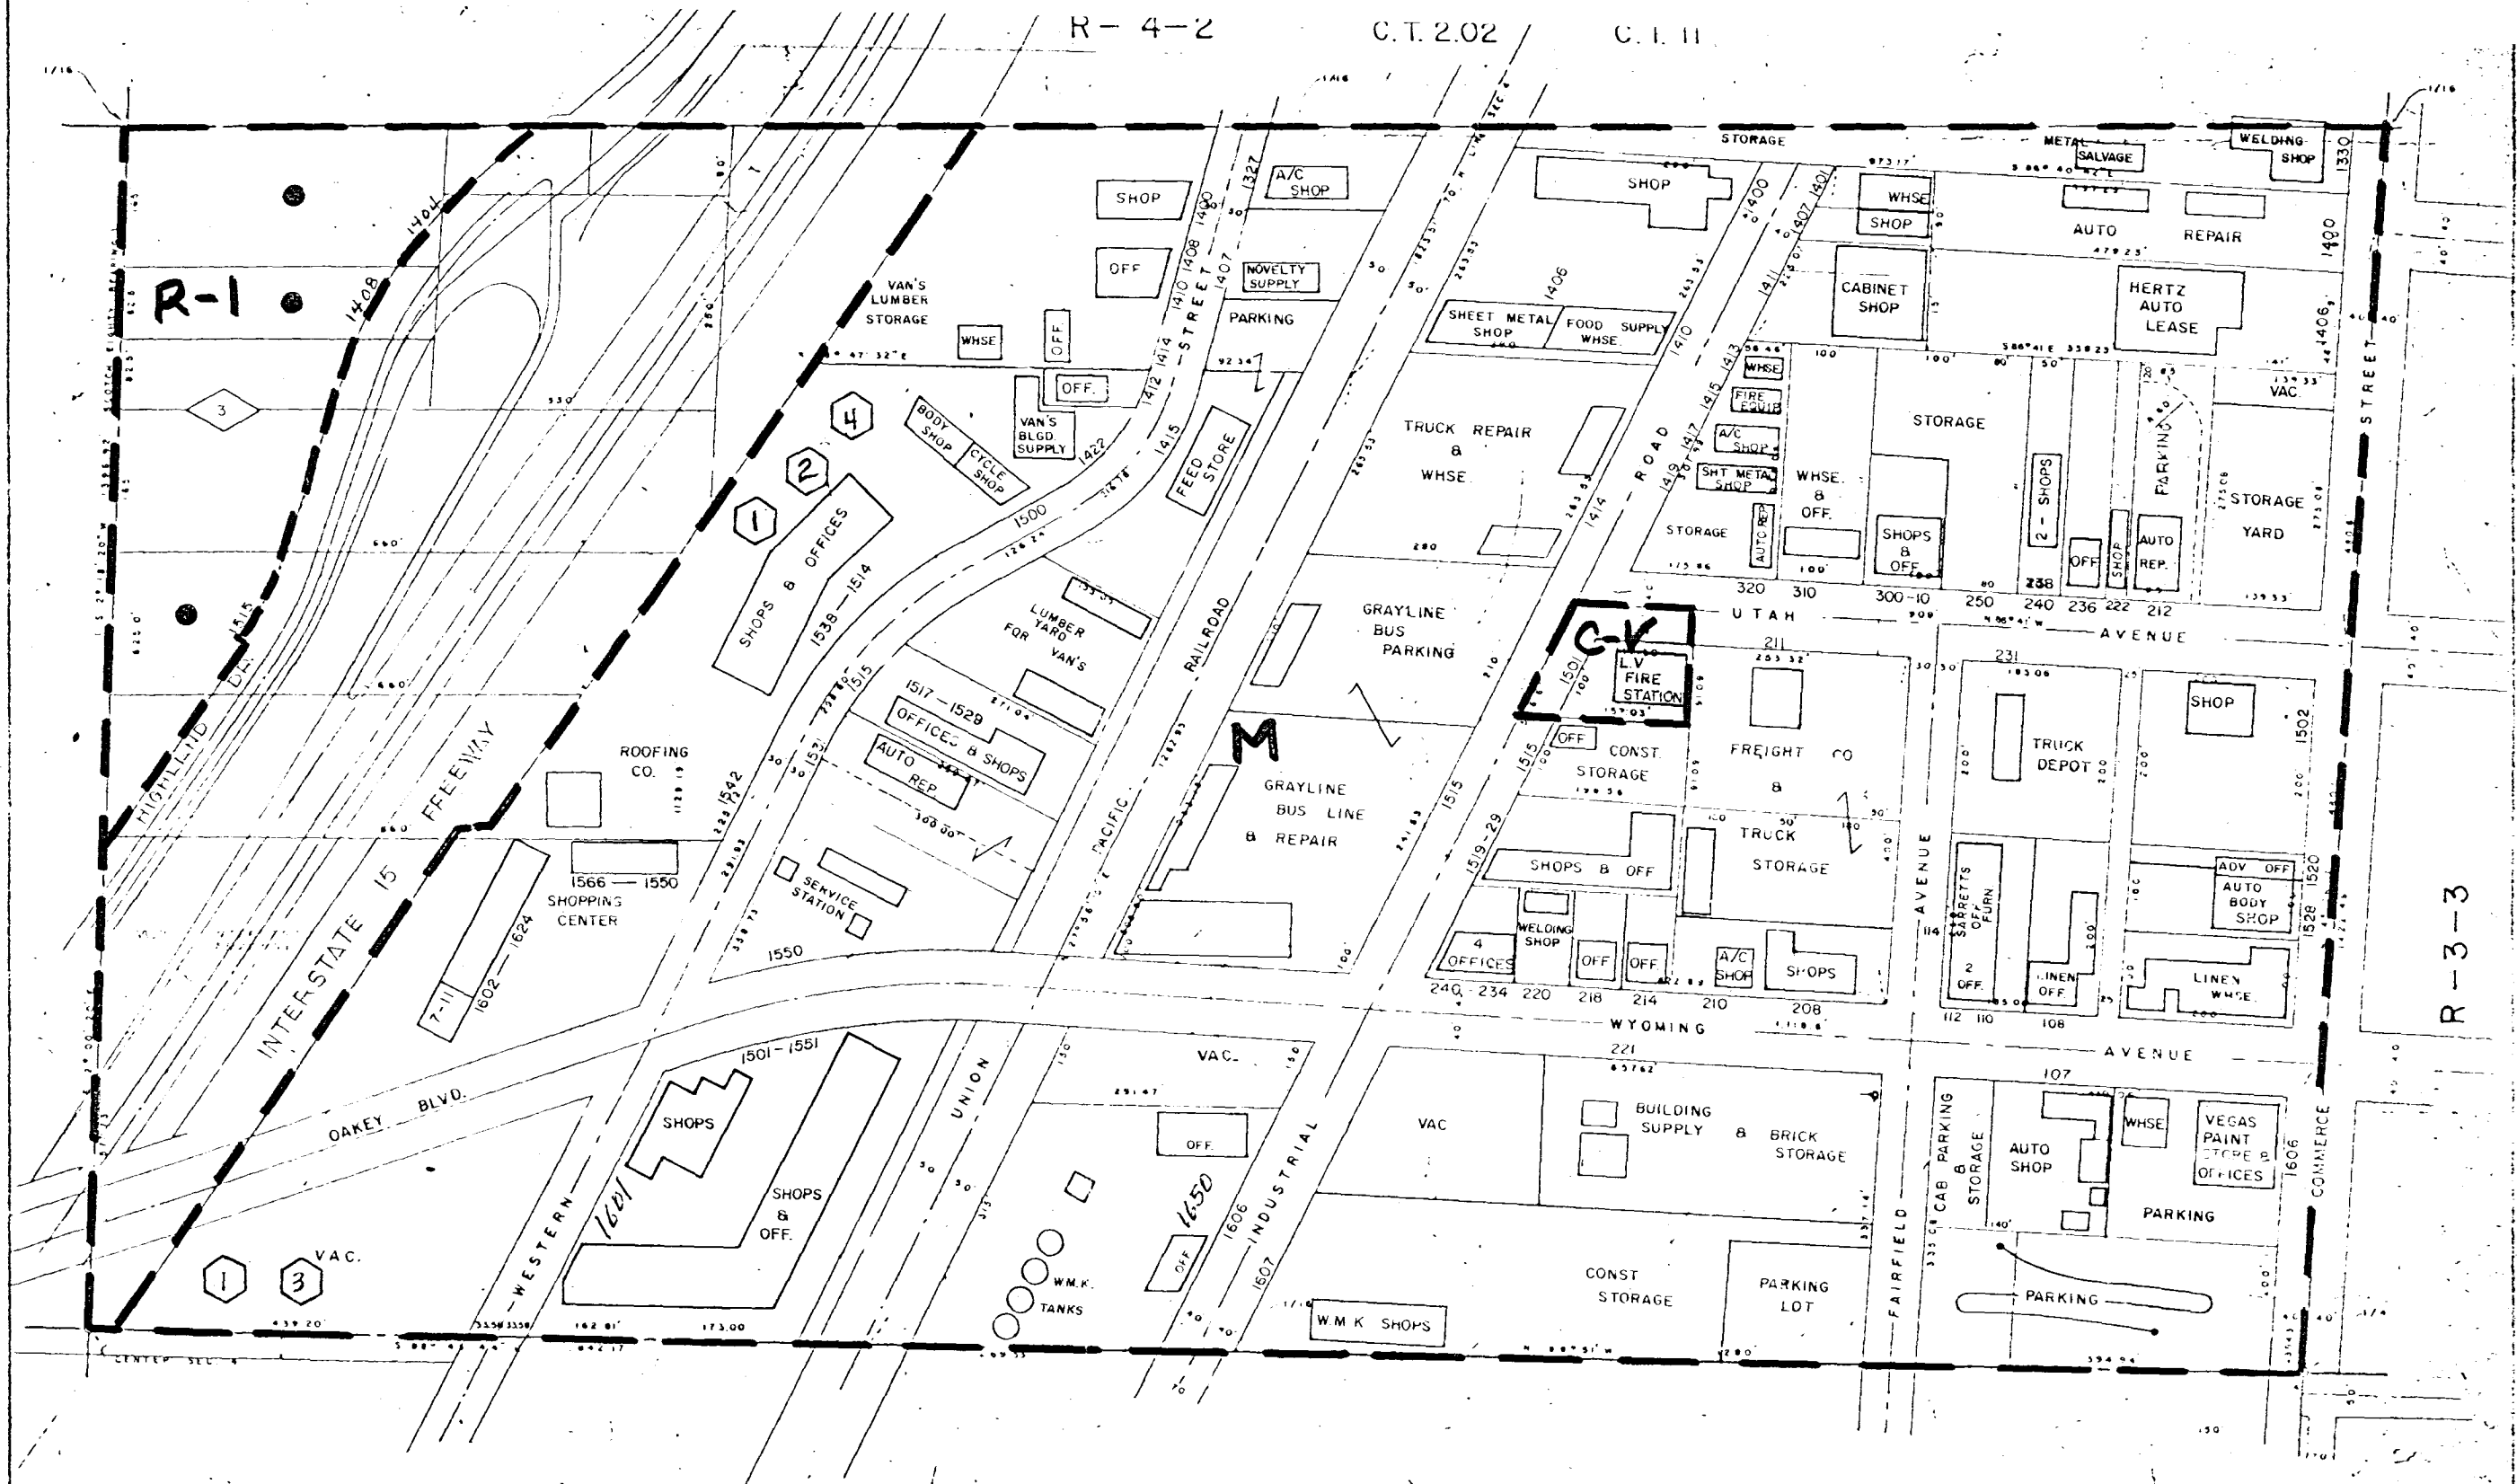

- 3 SINGLE FAMILY UNITS
 - 0 MULT -
 - 0 MOBILE HOMES PARK
 - 3 TOTAL
- 3/2

REVISED:
MAY 2 1975
11-30-75 R.H.S.

CITY OF LAS VEGAS NEVADA PLANNING DEPT.	
DISTRICT - MAP 21, 61, 4-4	
DESIGNED BY C. M. HARRIS	SCALE 1" = 200'
CHECKED BY C. M. HARRIS	DATE MAY 2 1975
APPROVED BY C. M. HARRIS	

R-4-4

R-4-6

S1/2 NE 1/4 SEC 4 T2S R6E

