


ST. LOUIS AVE.

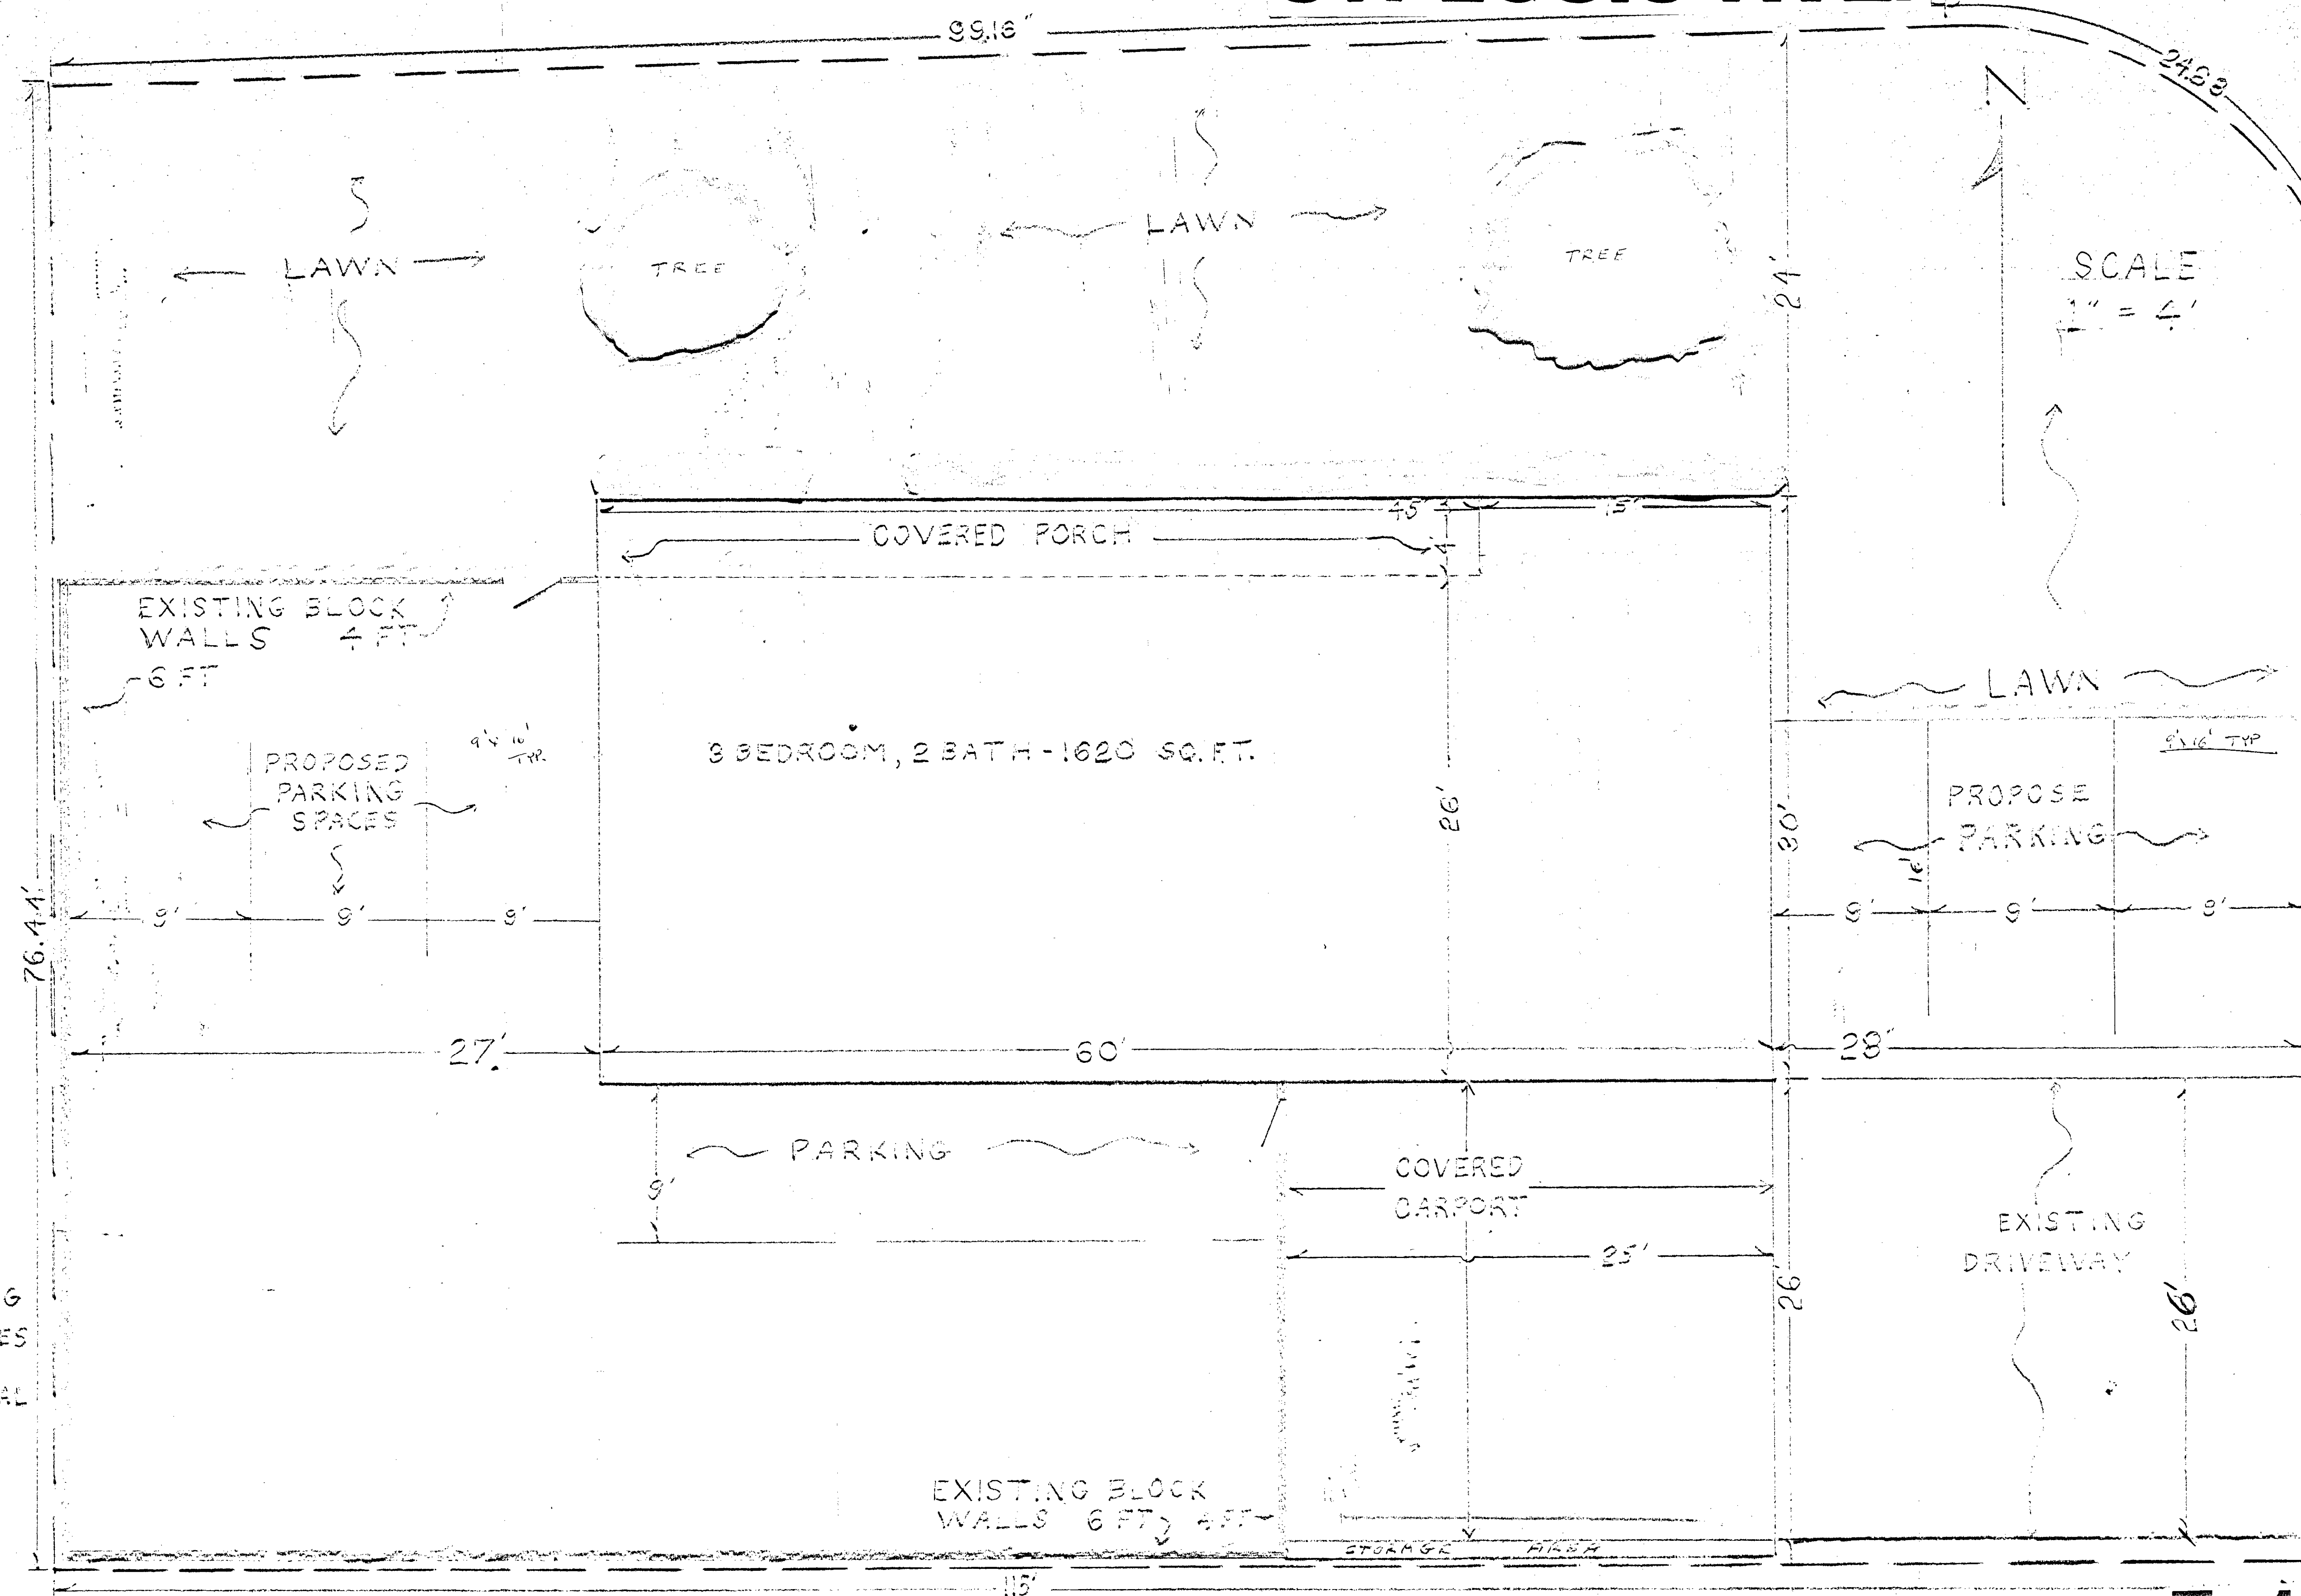

SANTA YNEZ DB-571A VINYL

OWNER
LEO F. DALEY
1000 SANTA YACZ
102-731-1131

PROPERTY INFO.

E G A L

NOT. BLACK D

PAGE 89 30023

DATA 2.32 P. 1000
DATA 2.33 P. 1000

APR 650 462 017

2000 SANTA YNEZ

OF THE

9065 54.57.

CO STAFFS: 001

CONFIDENTIAL

COMMENT: SEVER

ROOM MATERIAL

COMPOSITION

SHINGLE S

PRESENT USE

RESIDENT

~~RESIDENTIAL~~


P. A. OFFICE

DATE 2/15/2004

DATE RECEIVED

OCT. 30, 1920

736204 52 3V


ANDY TESTA

6240 W. LARK AV.
702-646-4337

102 010 102

cc: 1/16/91 approved
1/2/91 Alamo

11/29/1968

1998, 1999, 2000,26

Z-138-90

ST. LOUIS ST.

SANTA YNEZ ST.

SCALE
1" = 4'

OWNER
OLEO F. DALEY
2000 SANTA YNEZ
702-731-1151

PROPERTY INFO.


LEGAL
LOT 1, BLOCK 2
PAGE 88 80023
PARADISE PARK
SUBDIVISION
APN 040 482 017
2000 SANTA YNEZ

LOT SIZE
9085 SQ. FT.
CONSTRUCTION
CEMENT BLOCK
ROOF MATERIAL
COMPOSITION
SHINGLES


PRESIDENT USE
RESIDENTIAL
PROPOSED USE
PR OFFICE

DATE PREPARED
OCT. 30, 1980

PREPARED BY
ANDY TESTA
5220 W. CARL AV.
702-646-4387

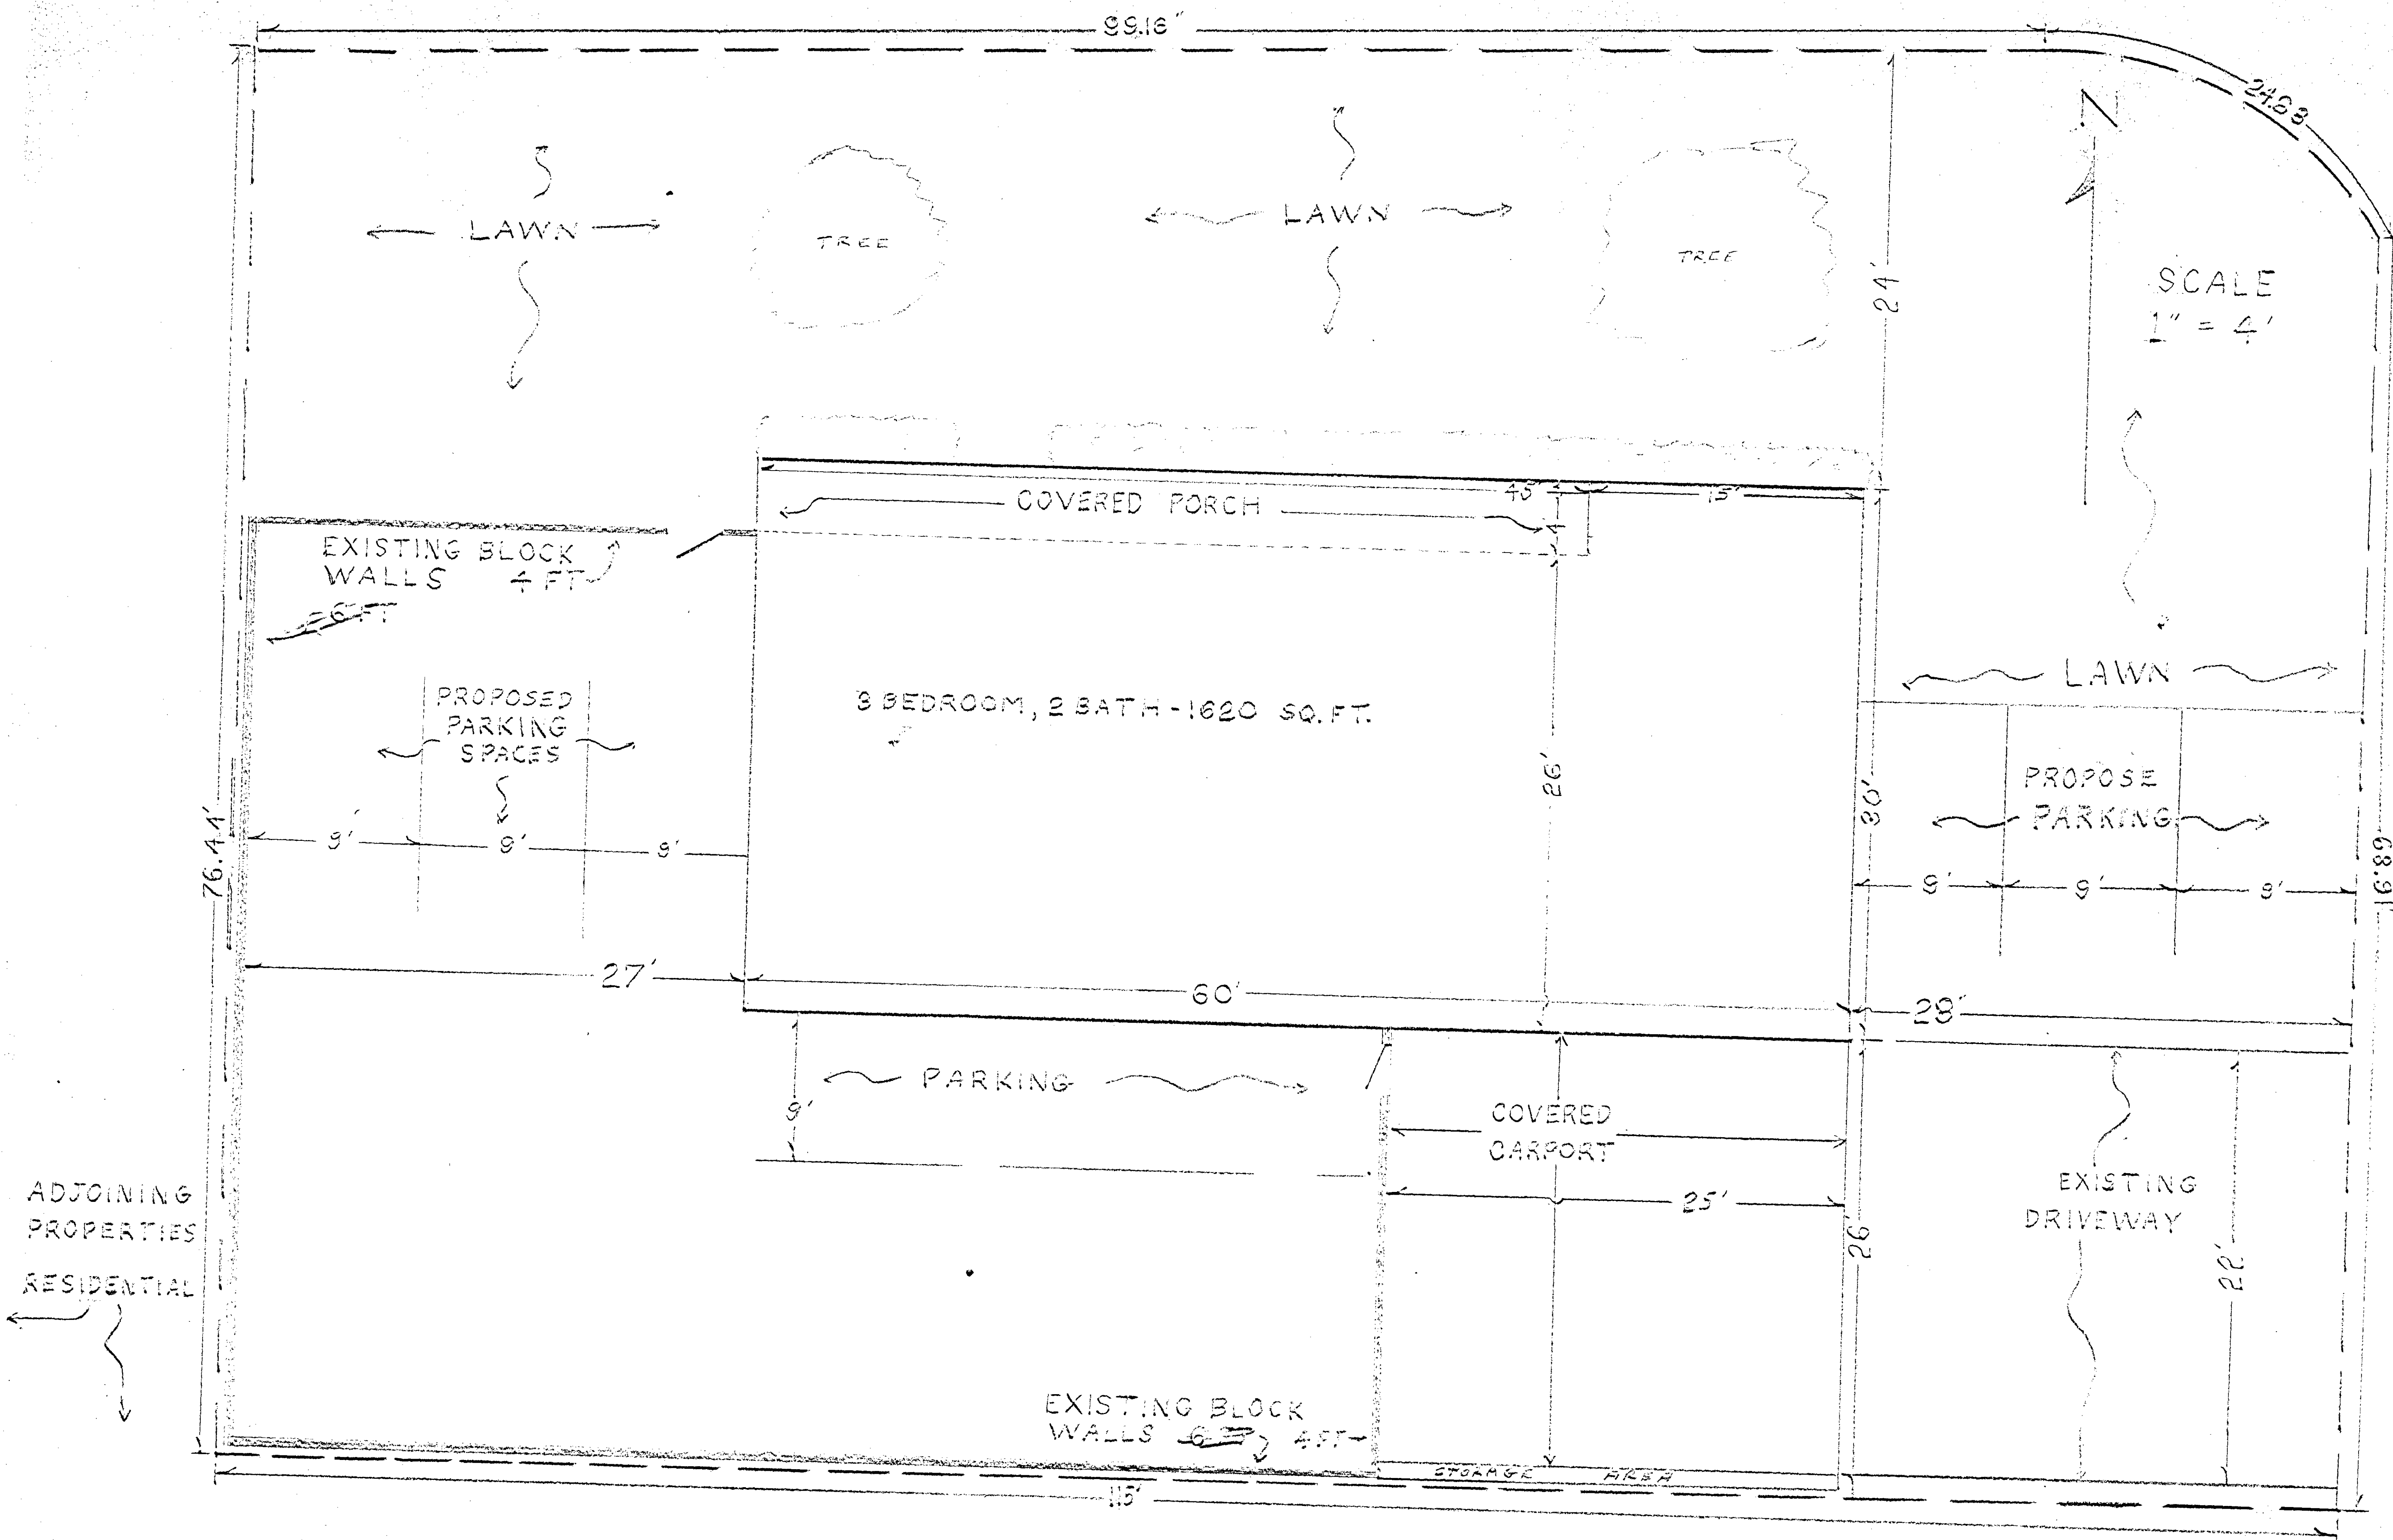

SCALE 1" = 4'

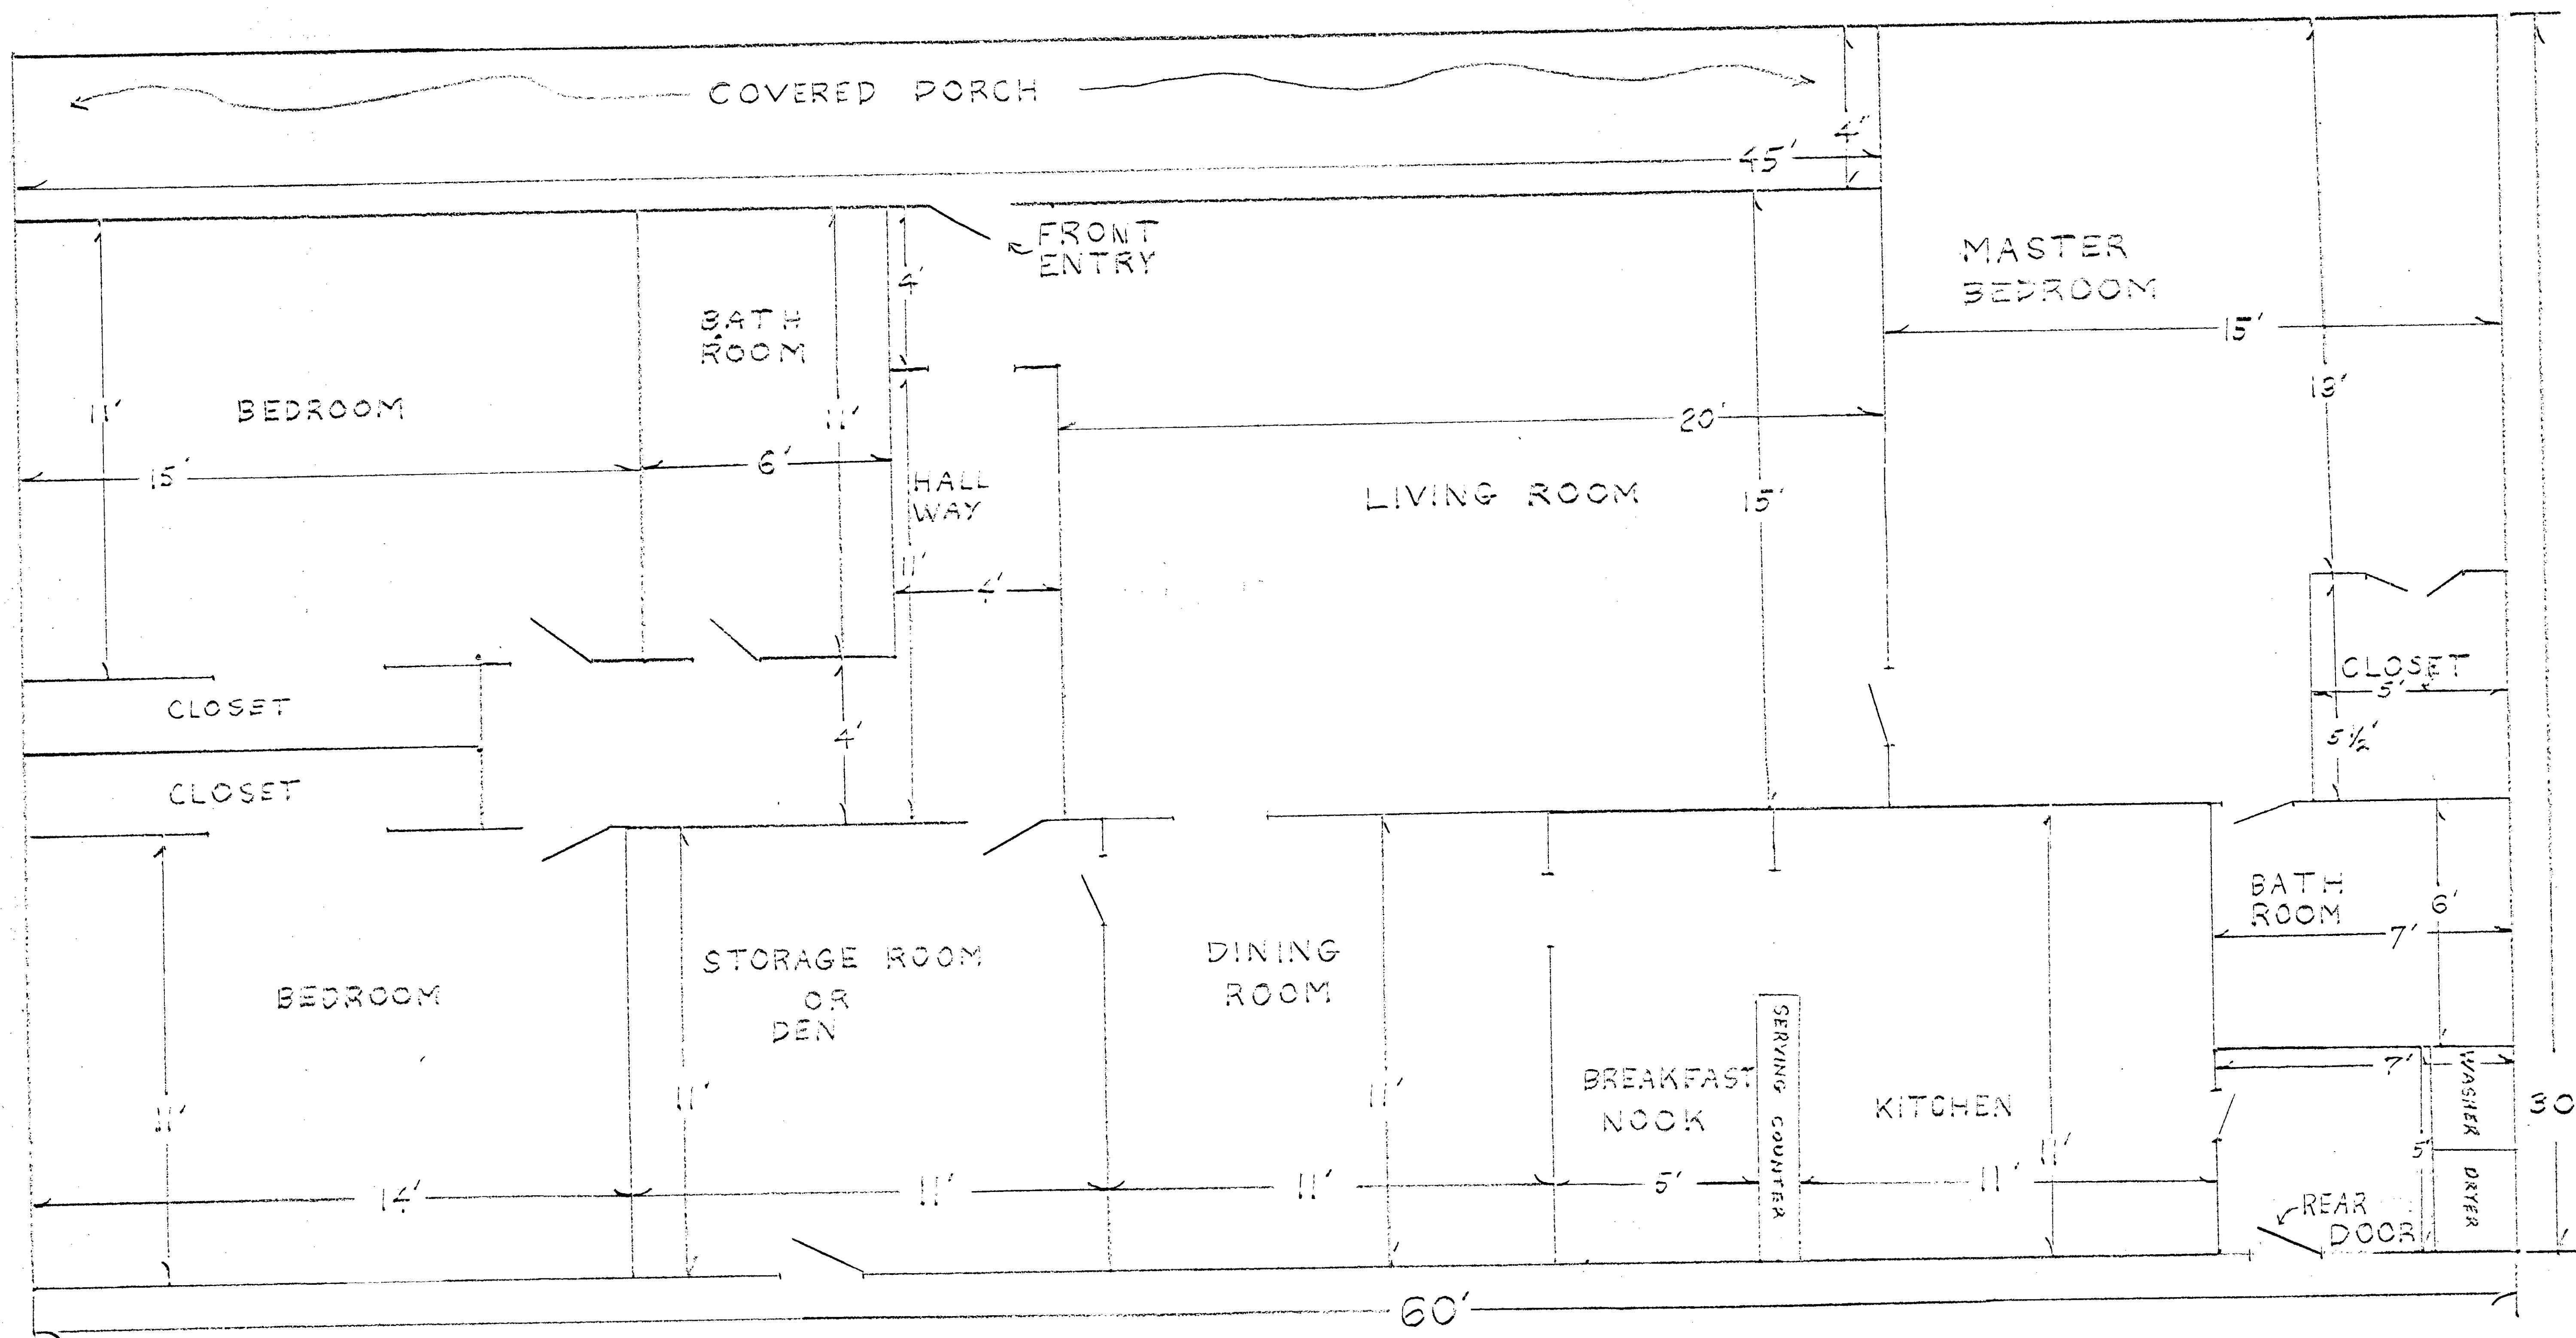

FLOOR PLAN
2000 SANTA
YNEZ

OWNER
CLEO F. DALEY
2000 SANTA
YNEZ
702-731-1131
1620 SQ. FT.

PREPARED BY
ANDY TESTA
6220 W. CARL AVE
702-646-4337