



Z-139-89

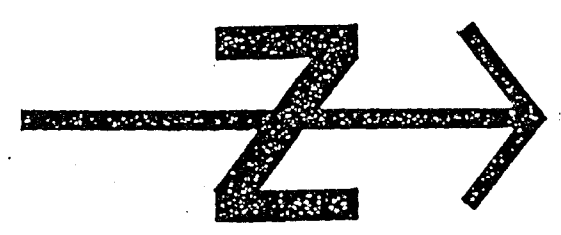

MARYLAND PARKWAY

- PLAN WITH LANDSCAPE (ALL EXISTING)


1/8" = 1'-0"

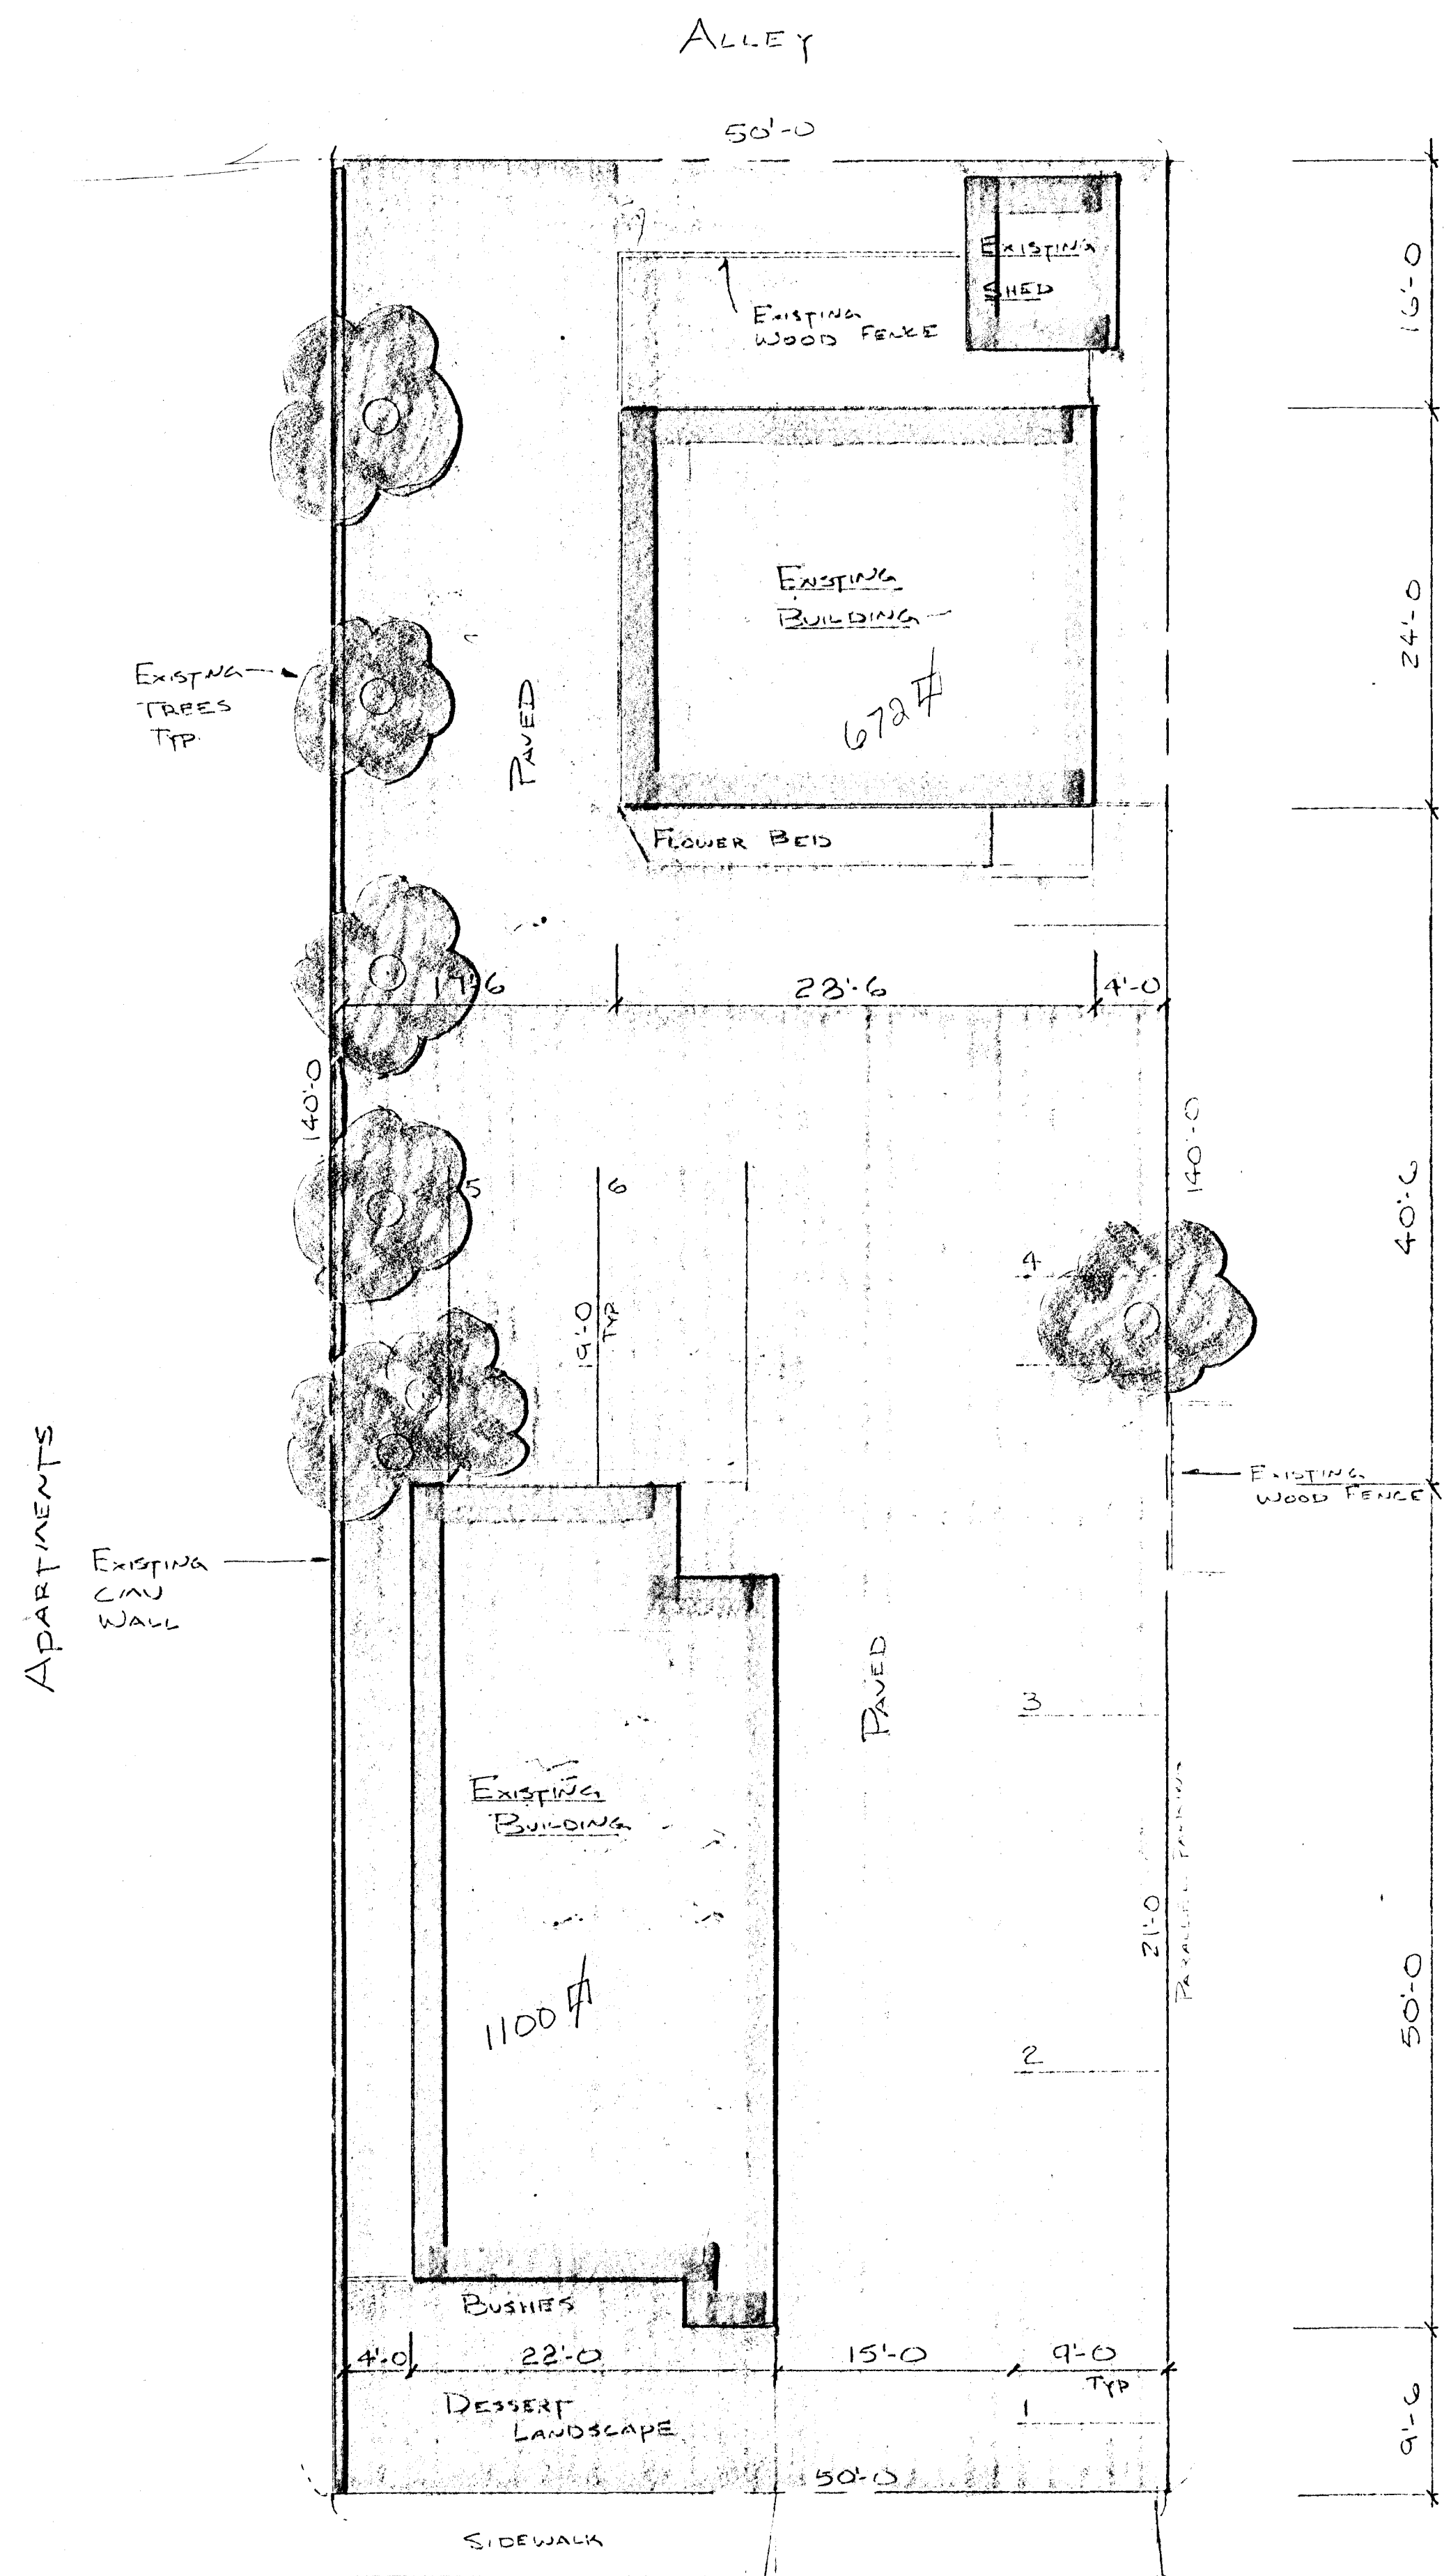

ACREAGE : 7000 SF
PARKING : 6 SPACES

DISTANCE TO NEAREST CROSS STREETS:
40' TO CENTER OF MARYLAND PARKWAY
140' TO CENTER OF CLARK AVE

NOTES:
ALL EXISTING BUILDINGS AND LANDSCAPING

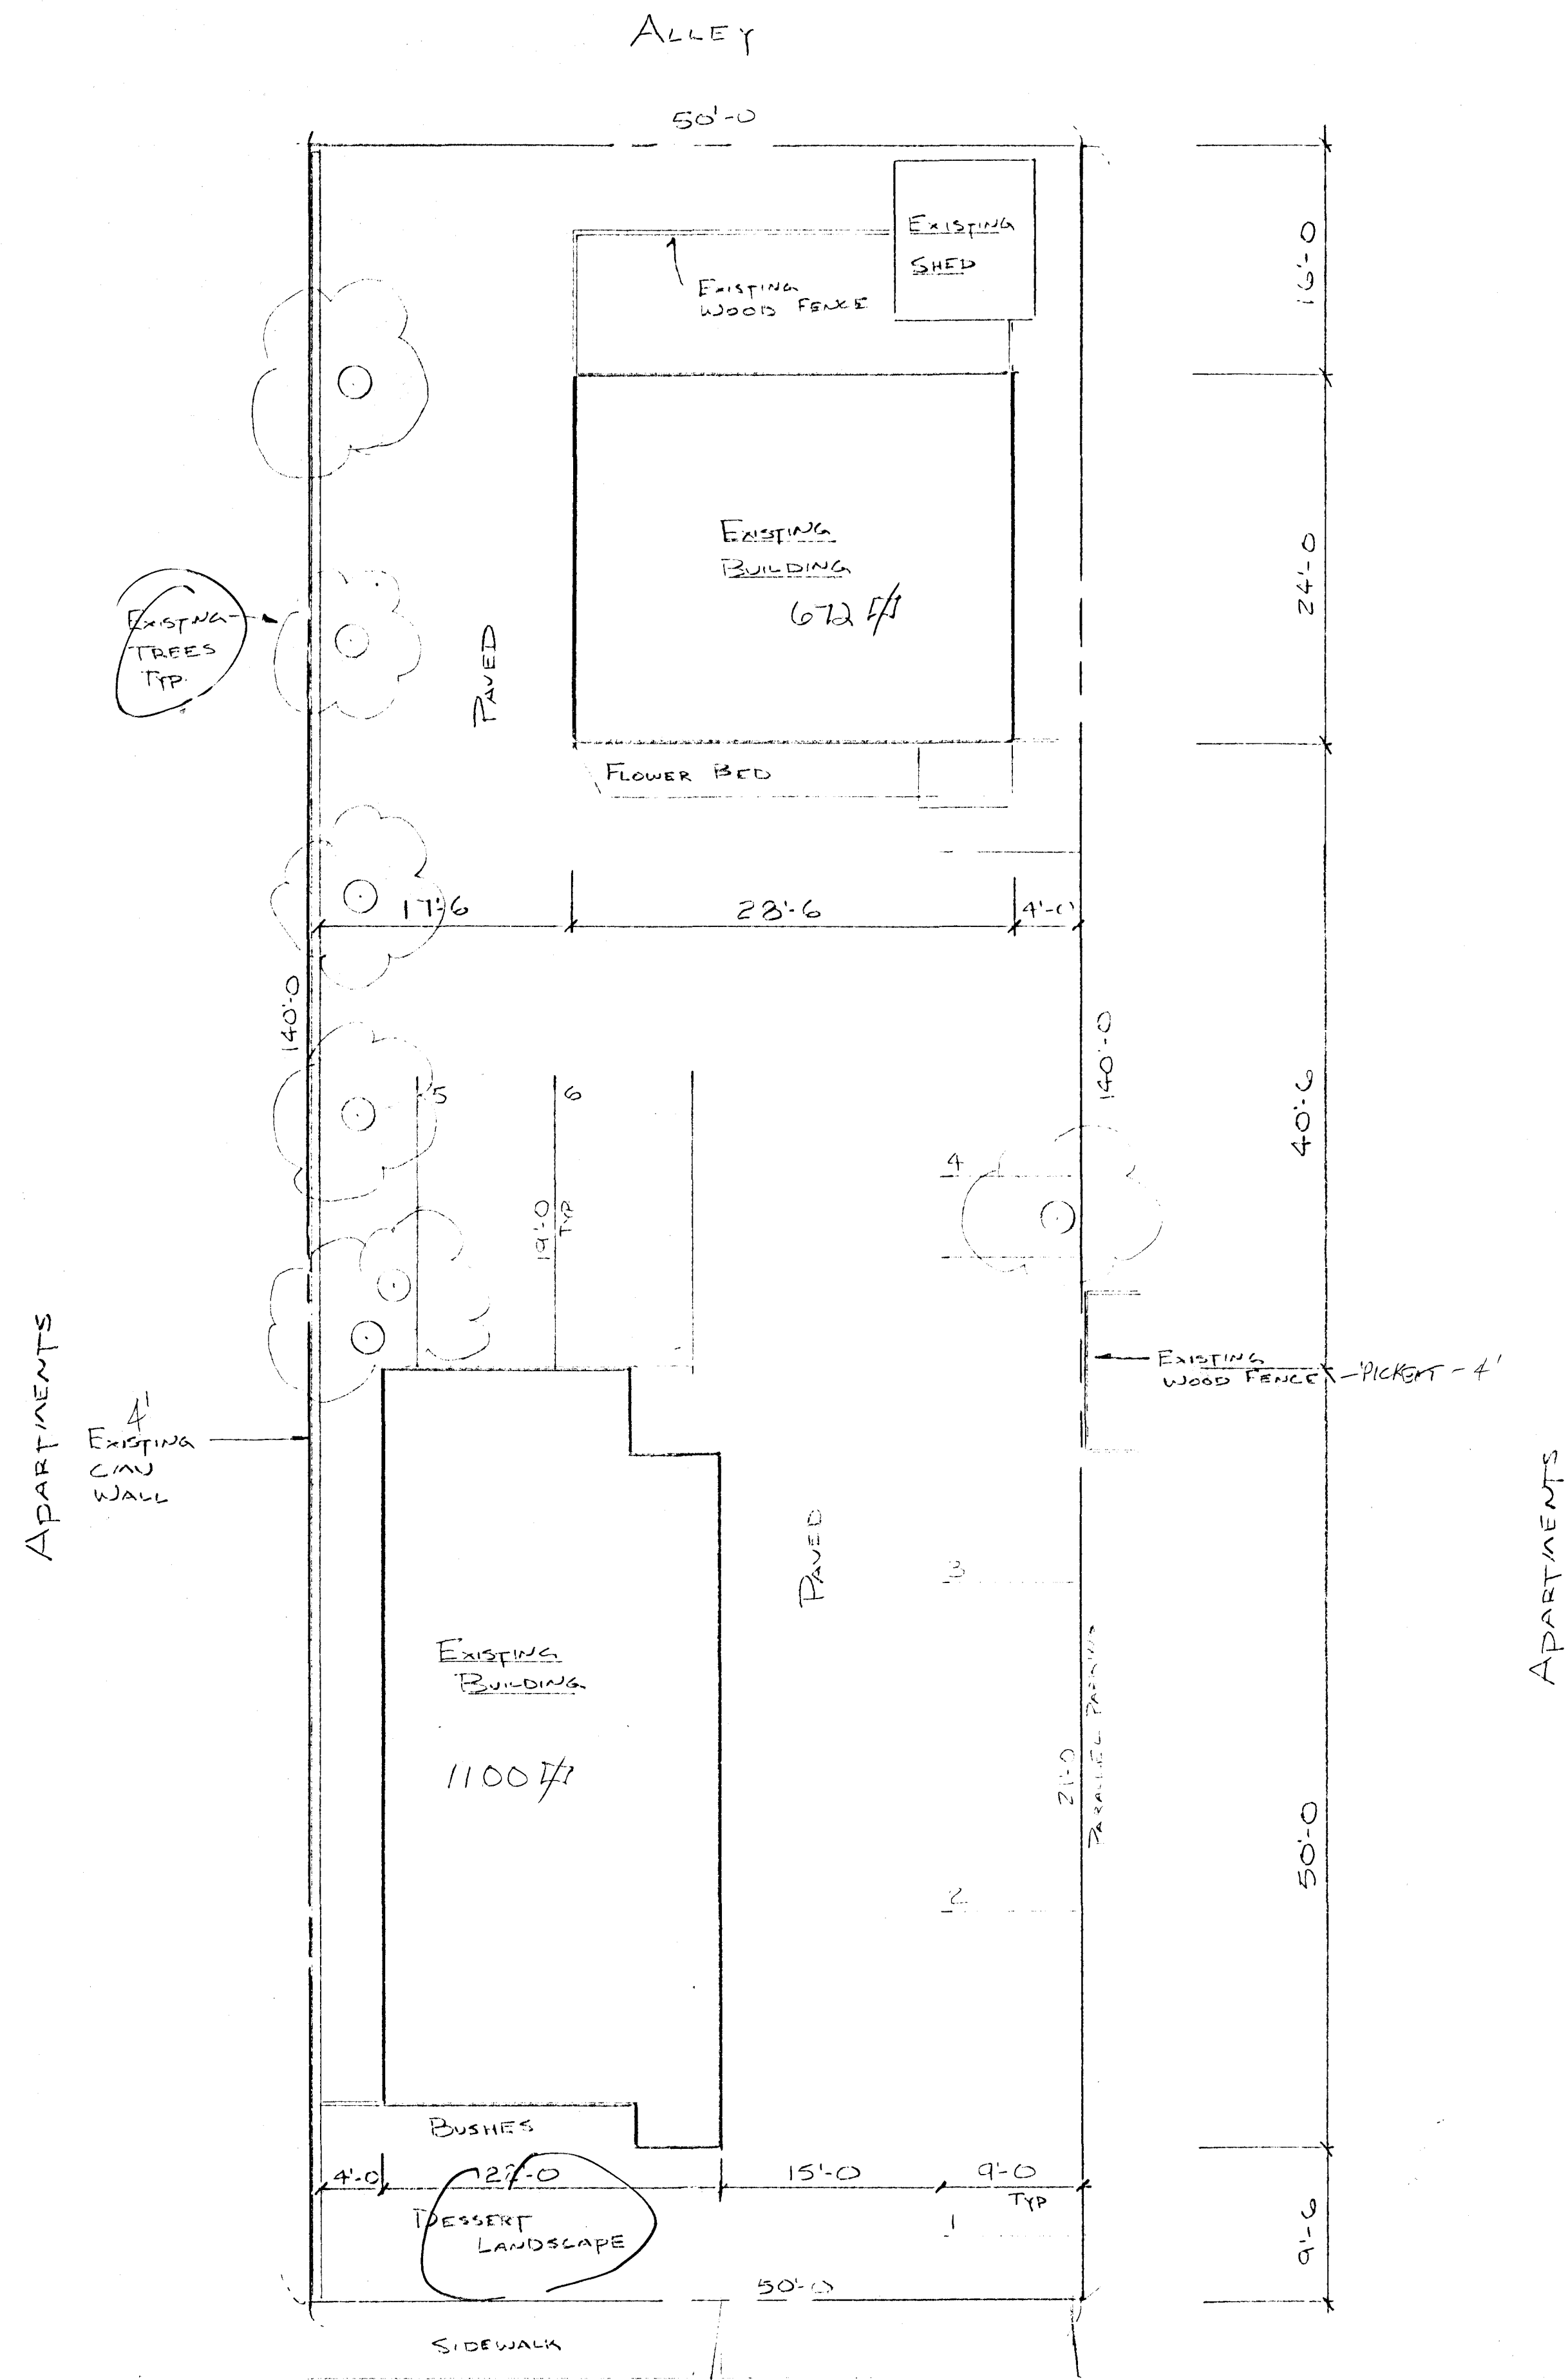

MARYLAND PARKWAY

Plot Plan with Landscape (All Existing)

SCALE: 1/8" = 1'-0"



ACREAGE : 7000 SF
PARKING : 6 SPACES

DISTANCE TO NEAREST CROSS STREETS:
40' TO CENTER OF MARYLAND PARKWAY
140' TO CENTER OF CLARK AVE

NOTES:
ALL EXISTING BUILDINGS AND LANDSCAPING

Staff Copy
Z-139-89
PC 11/11/90

Plot Plan

418 MARYLAND

DEC 7, 89