



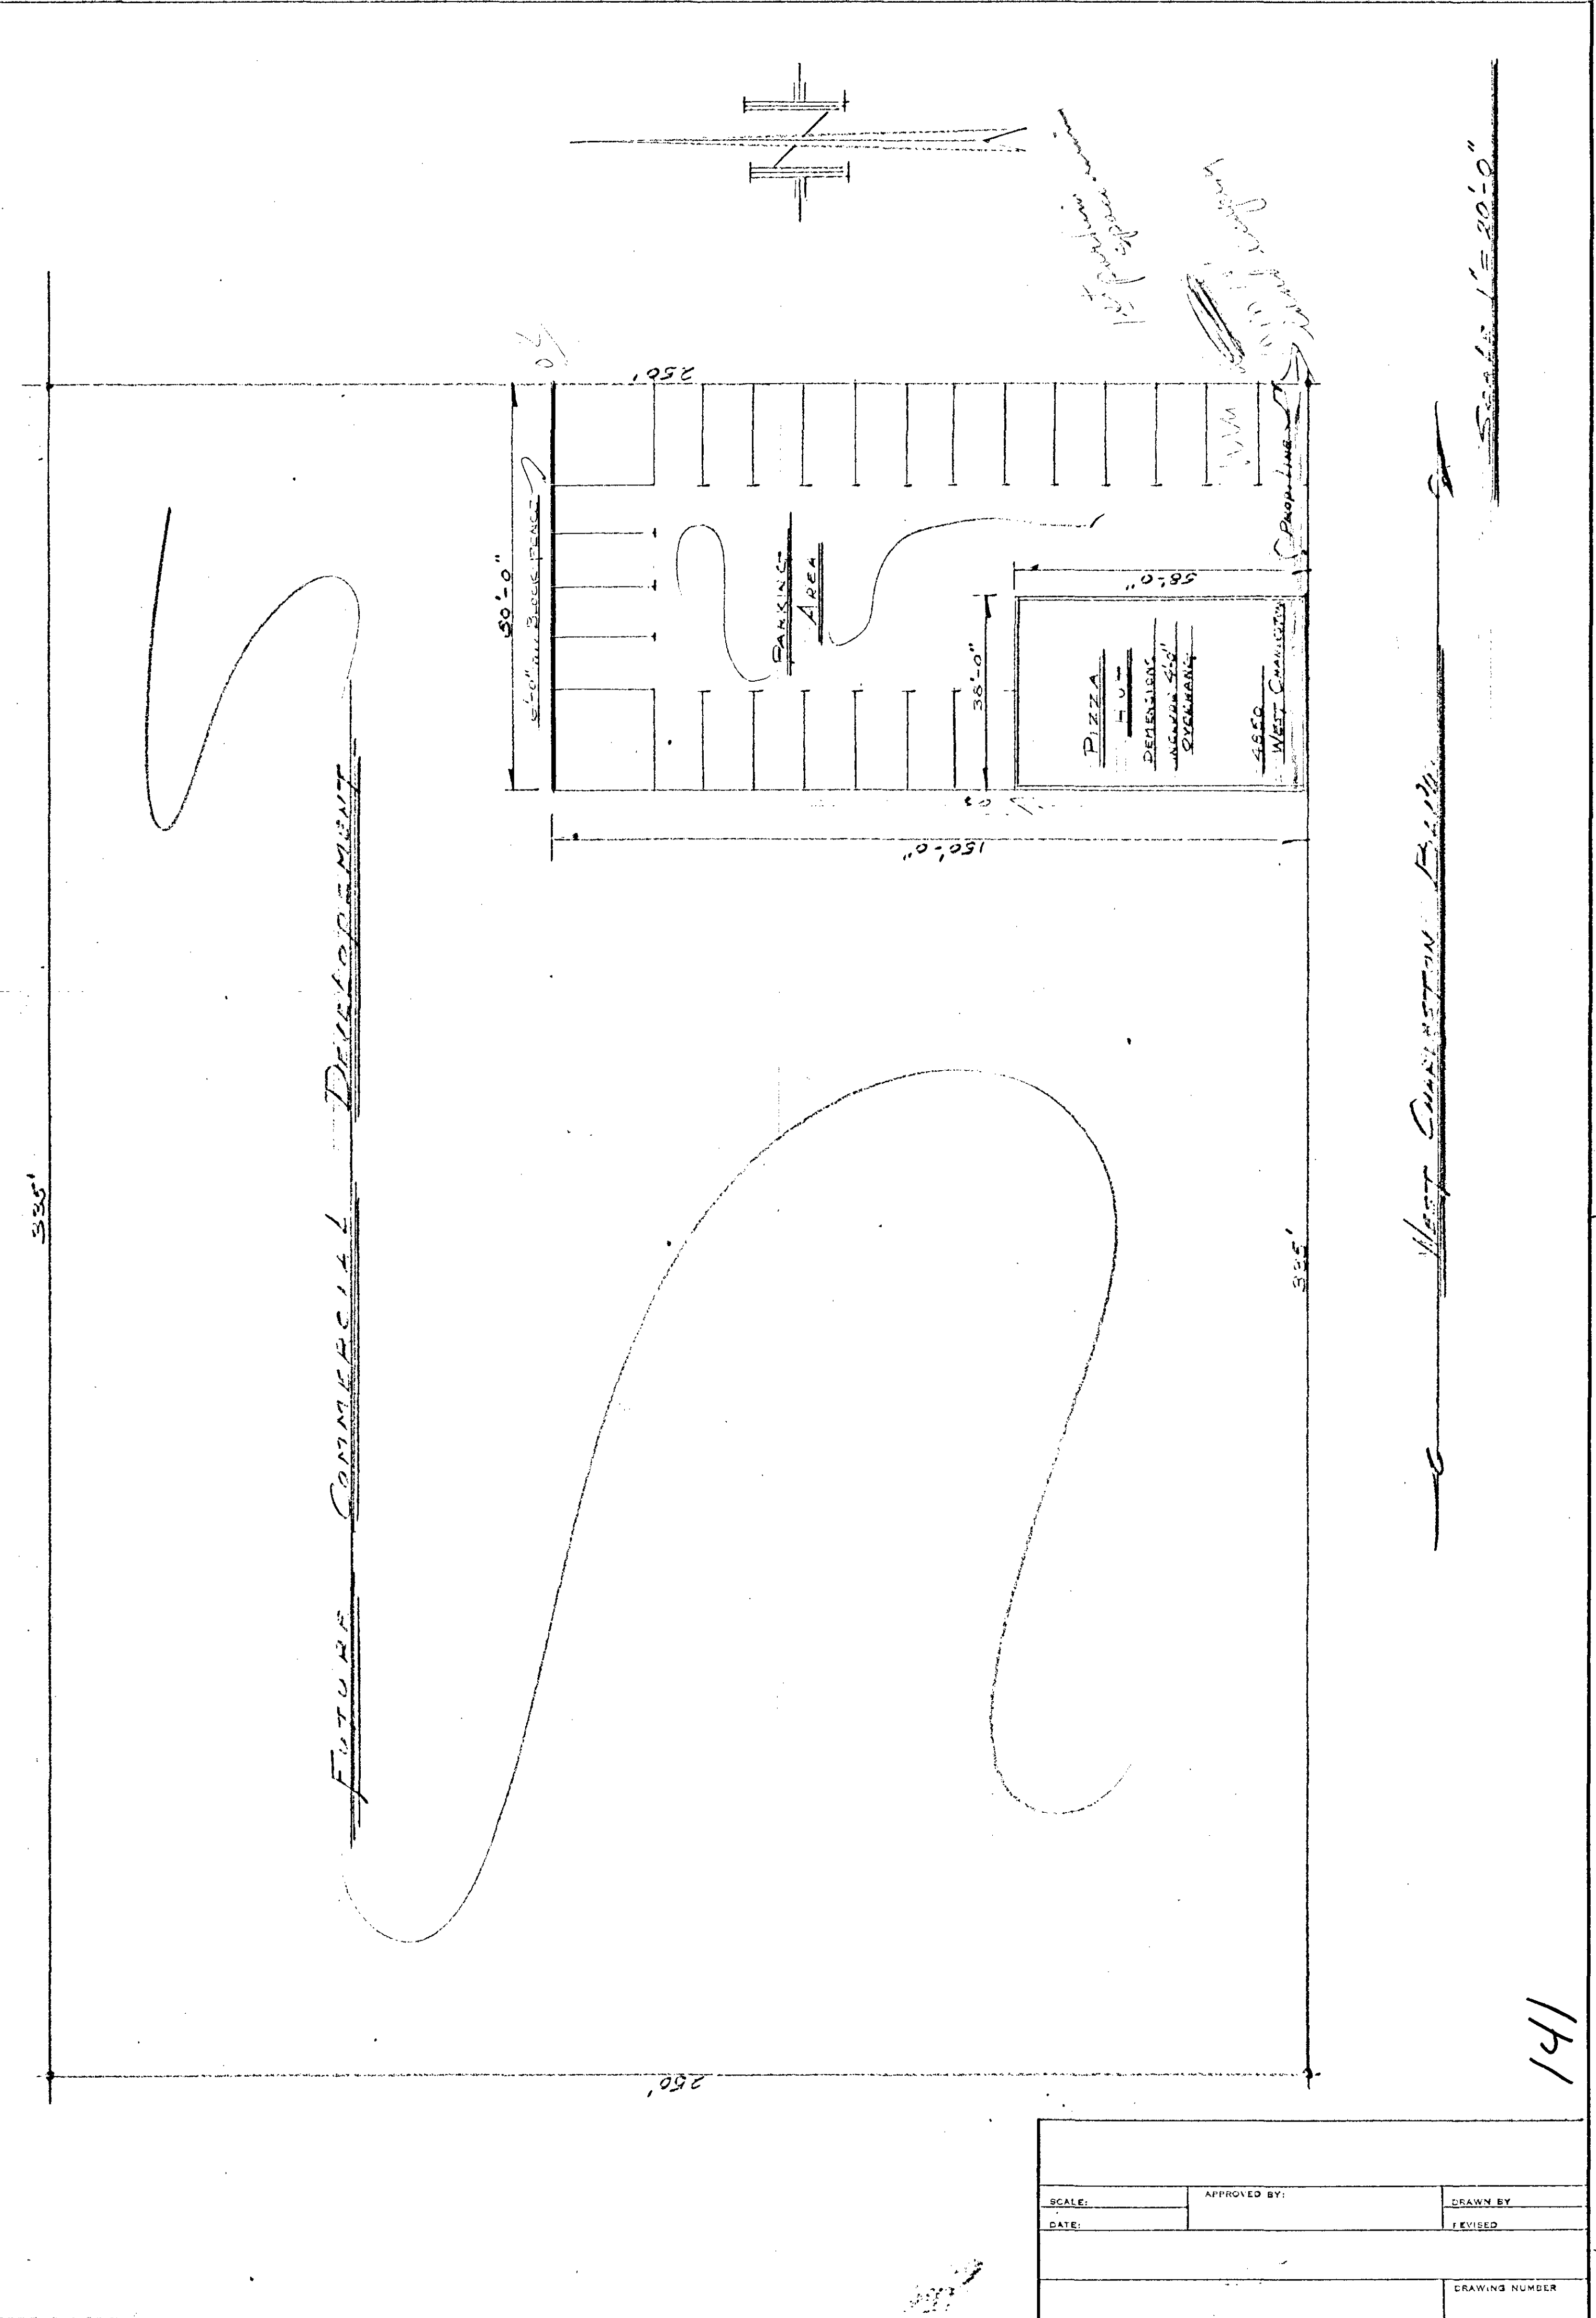

|        |  |              |                |
|--------|--|--------------|----------------|
| SCALE: |  | APPROVED BY: | DRAWN BY:      |
| DATE:  |  |              | REVISED:       |
|        |  |              | DRAWING NUMBER |

141

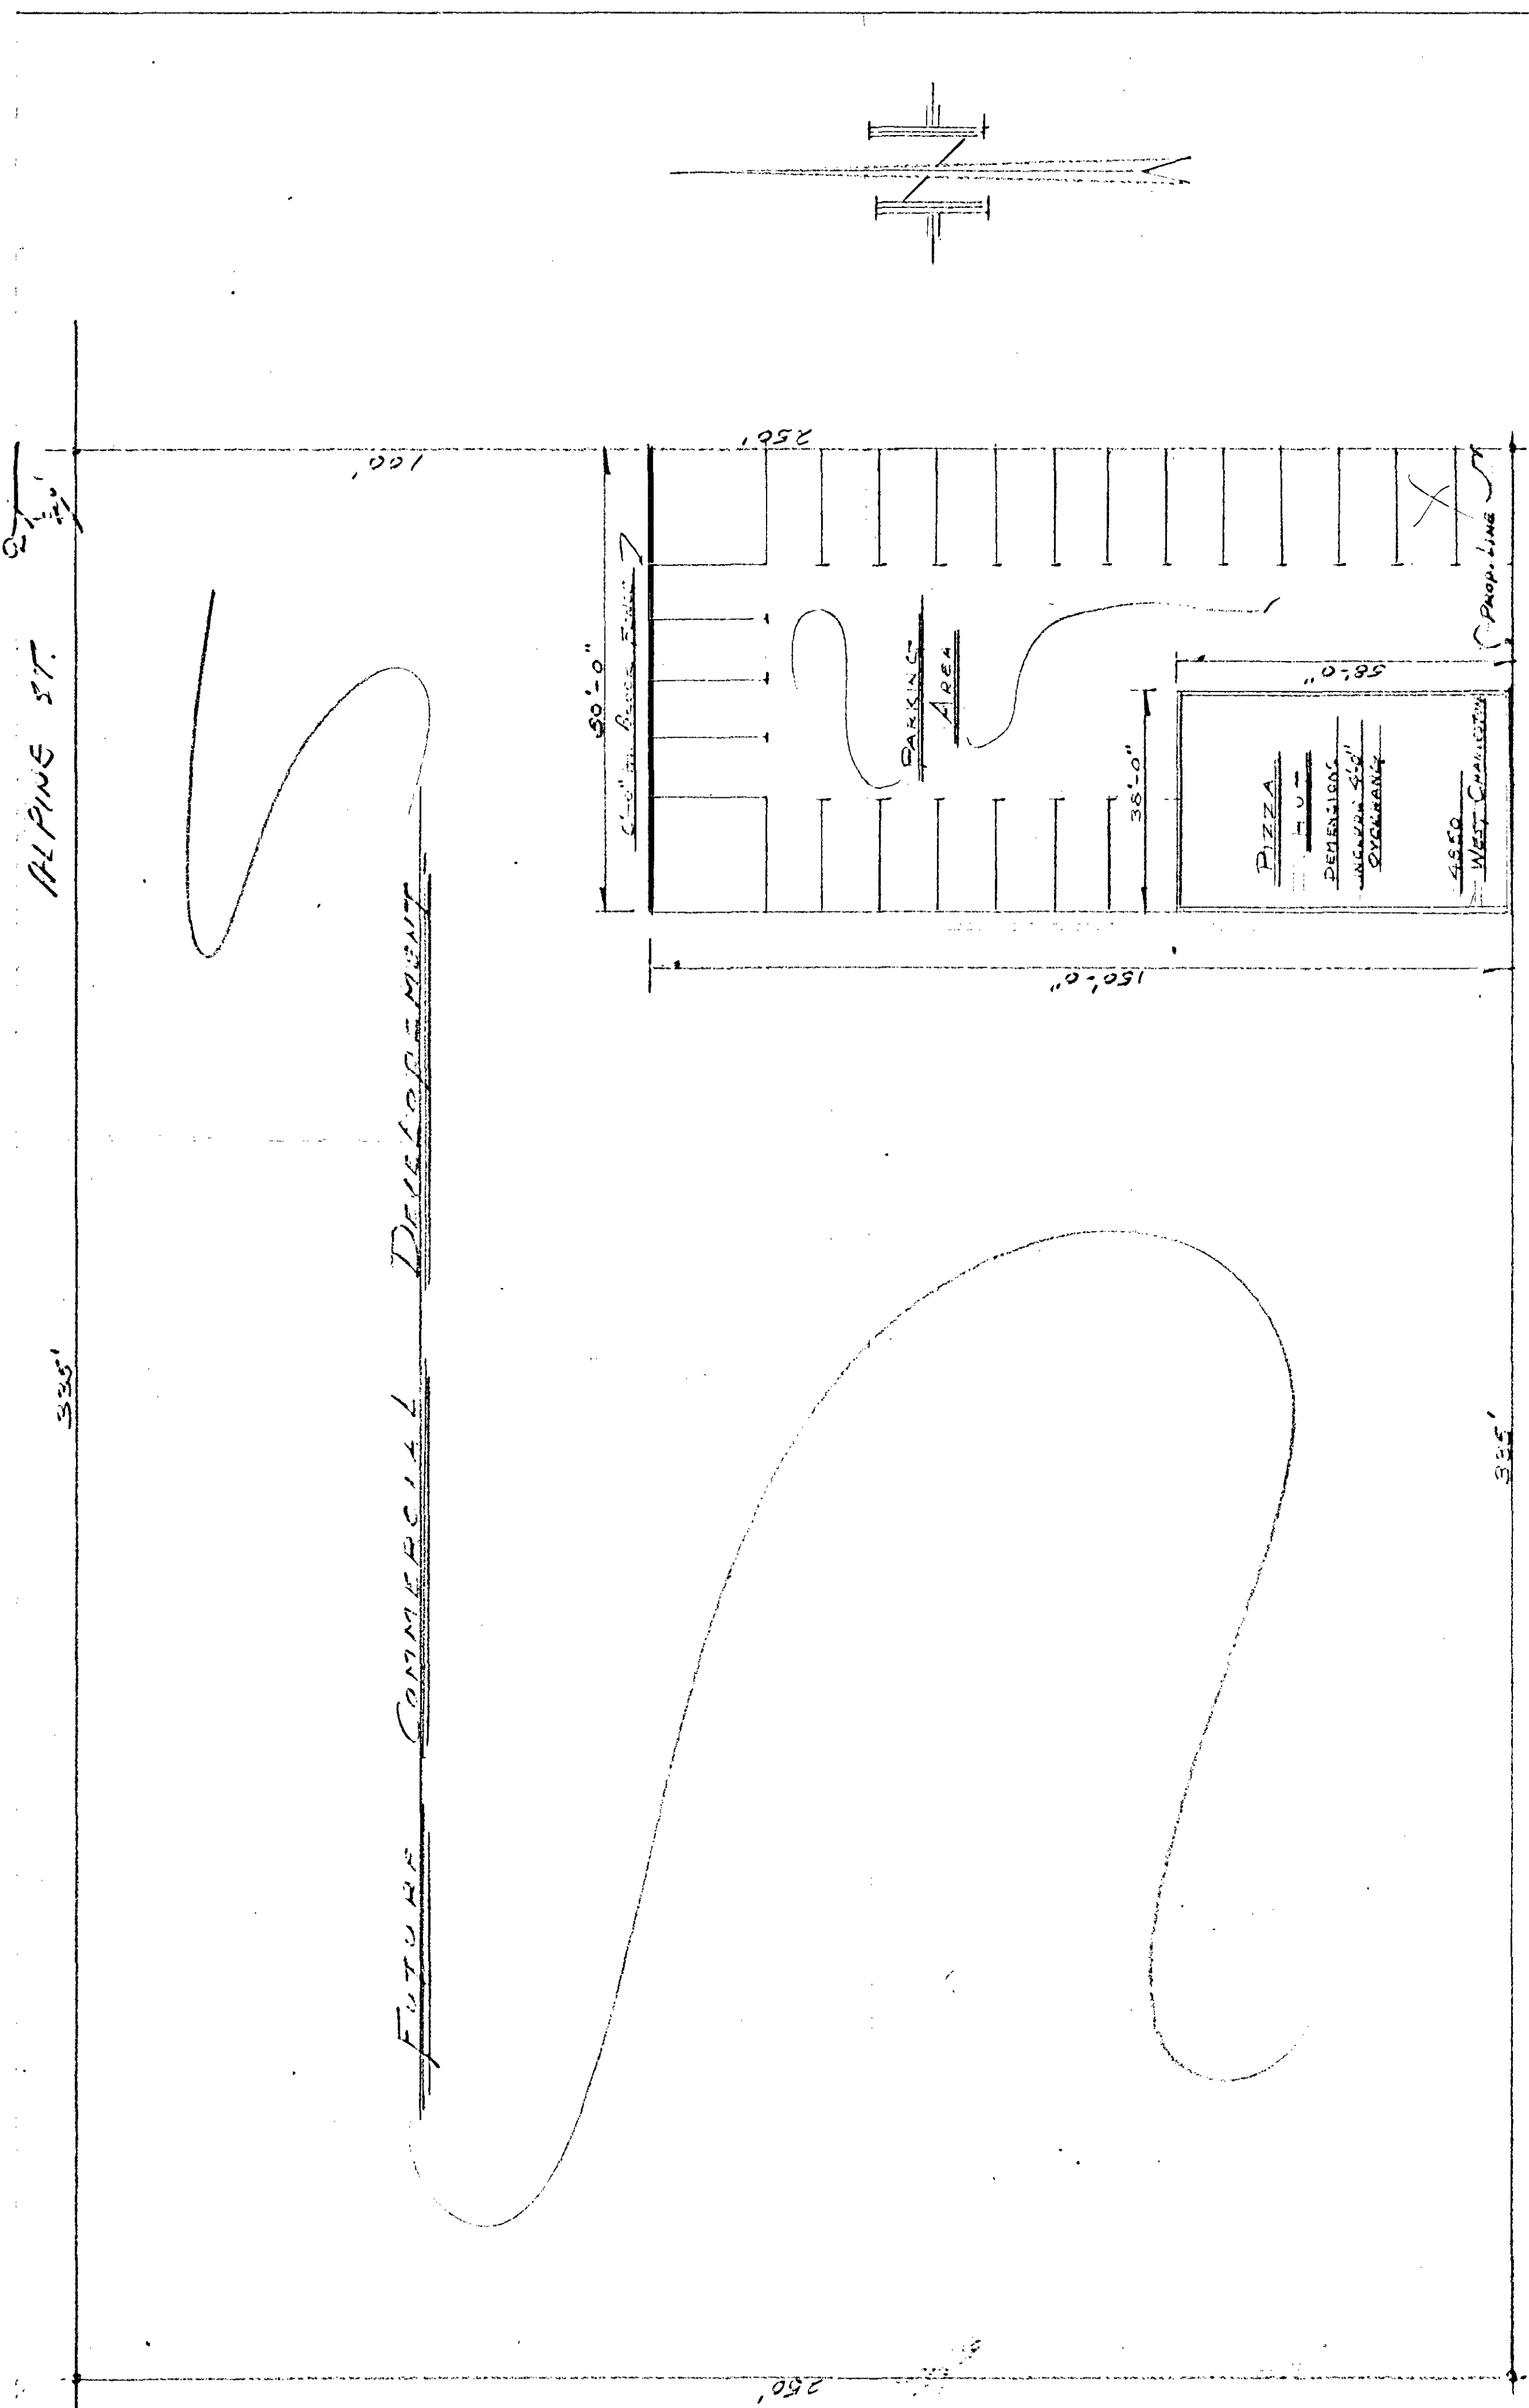

Scale 1" = 20'-0"


West Charleston Blvd

|        |              |                |
|--------|--------------|----------------|
| SCALE: | APPROVED BY: | DRAWN BY:      |
| DATE:  |              | REVISED:       |
|        |              | DRAWING NUMBER |