



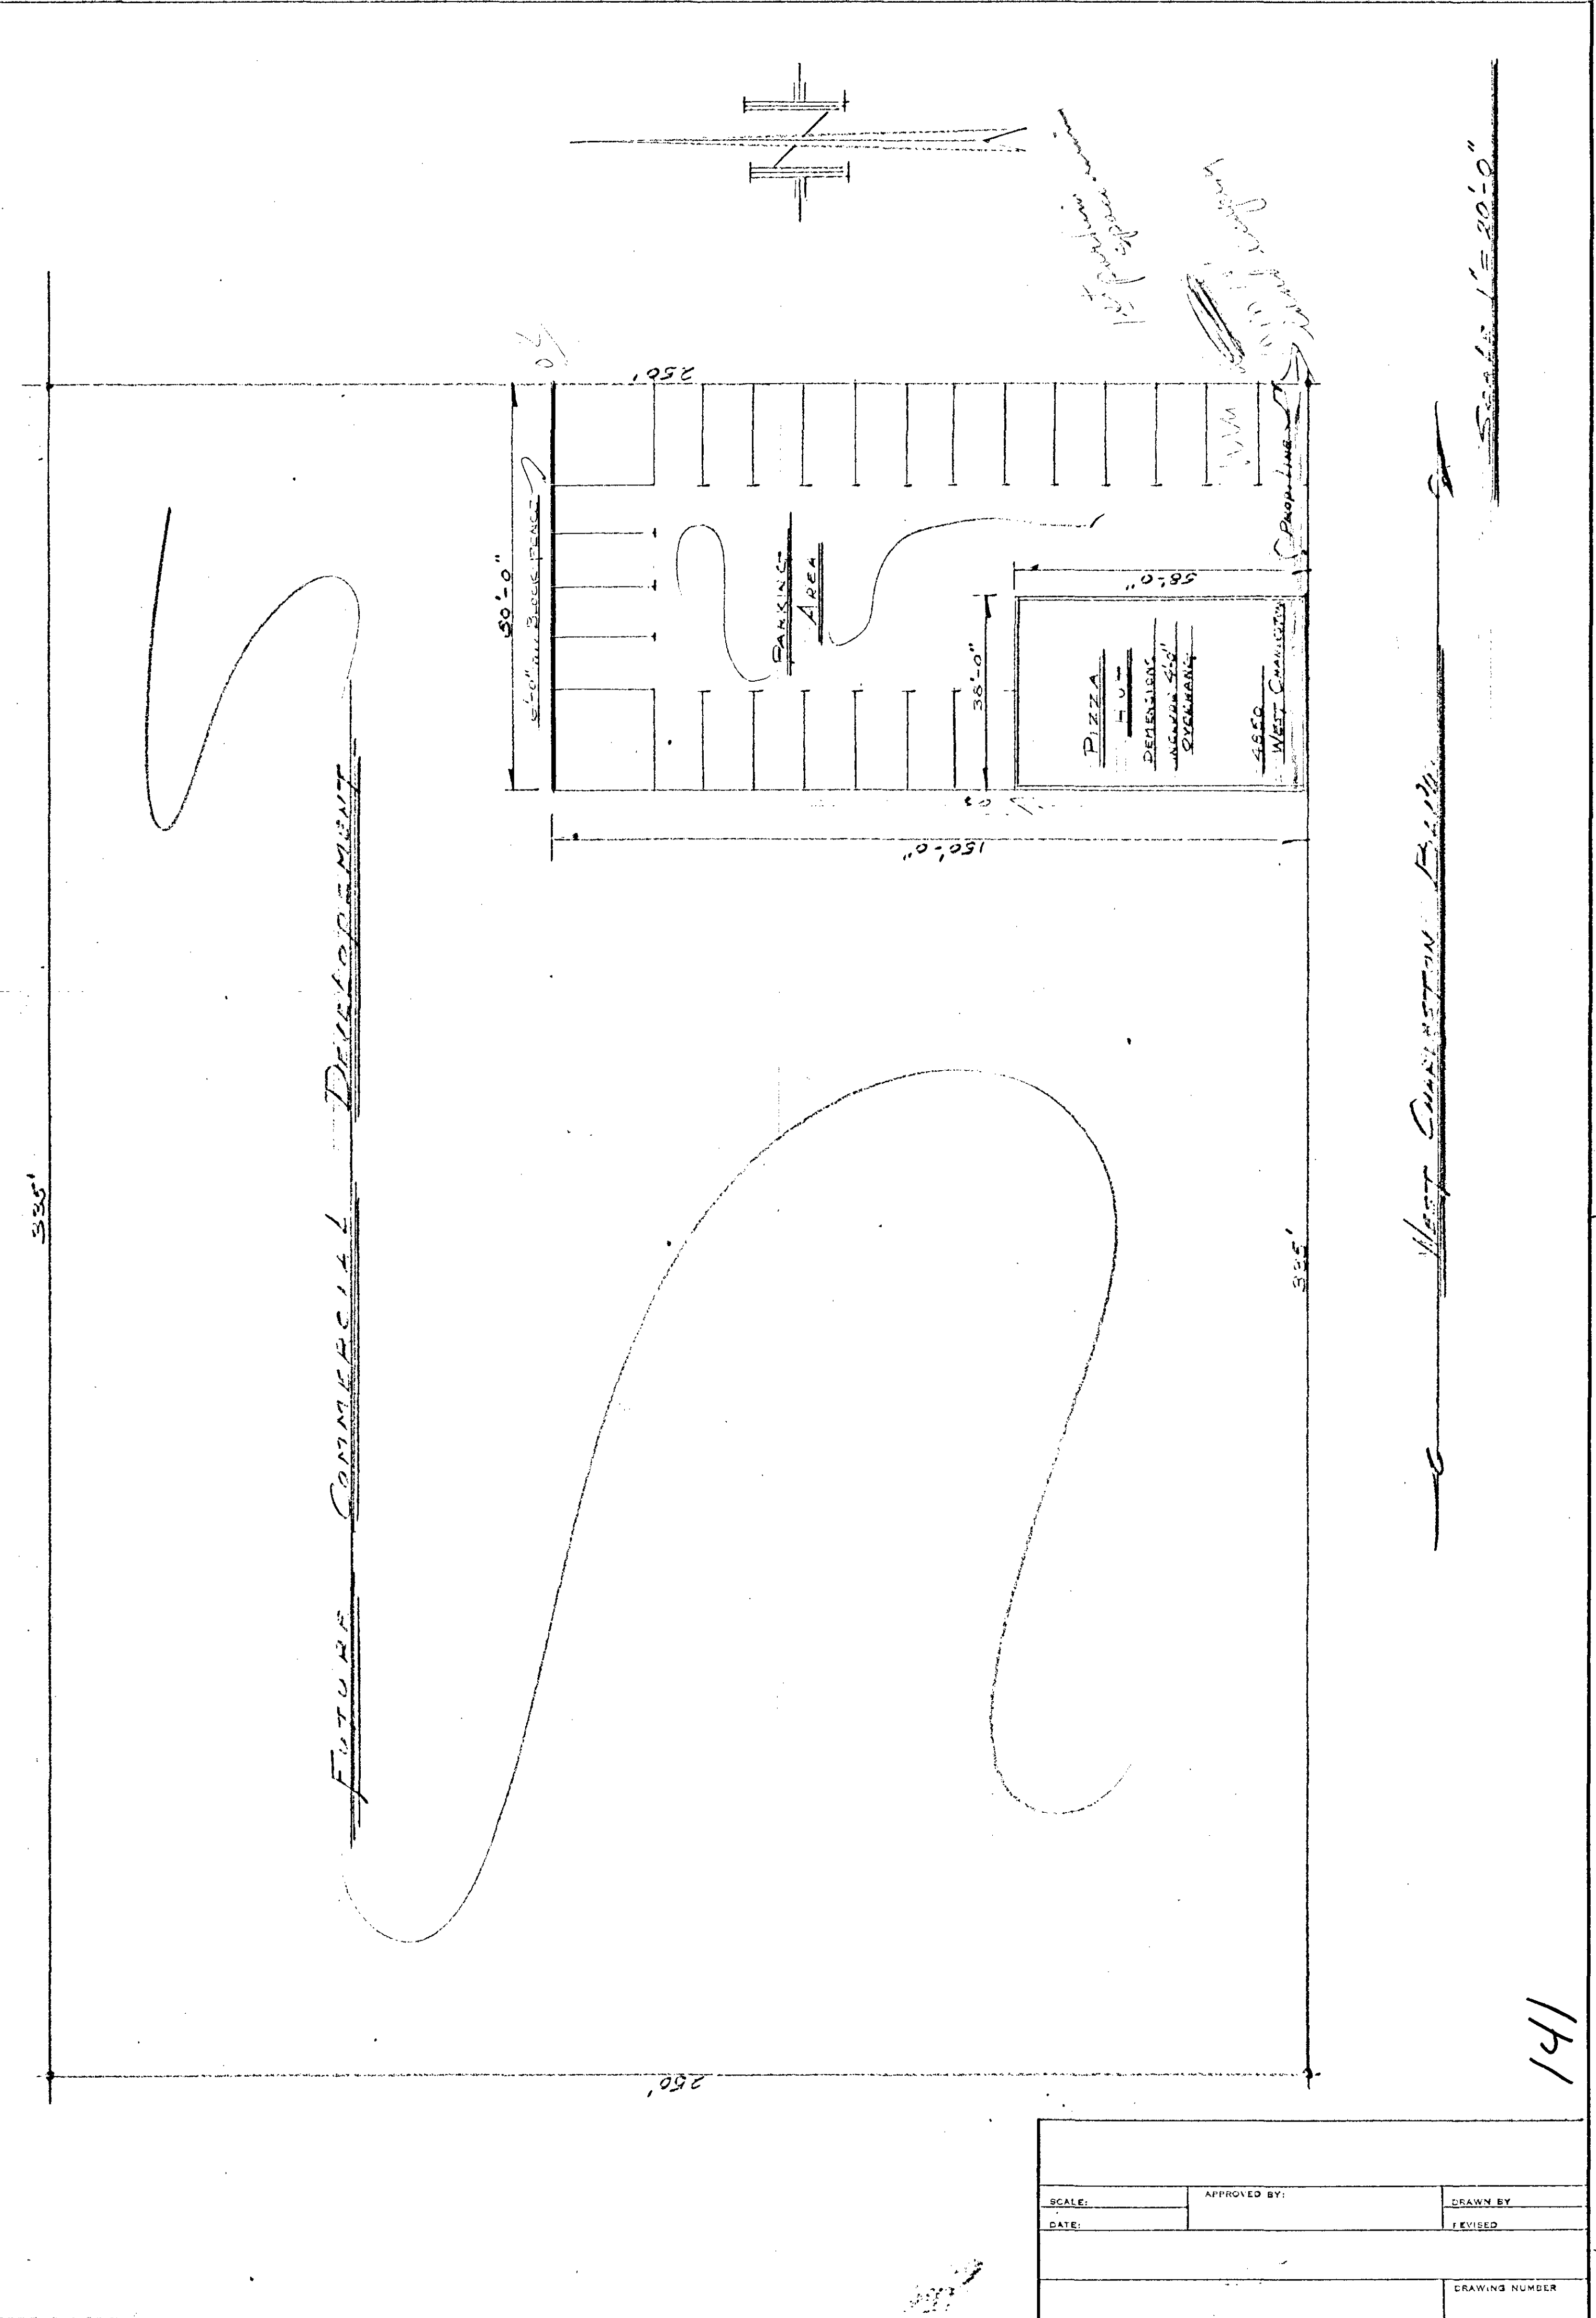


SCALE:		APPROVED BY:	DRAWN BY:
DATE:			REVISED:
			DRAWING NUMBER

141

5

FUTURE COMMERCIAL DEVELOPMENT

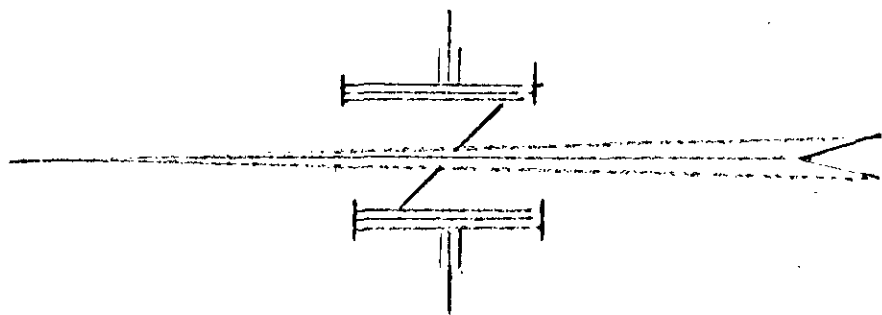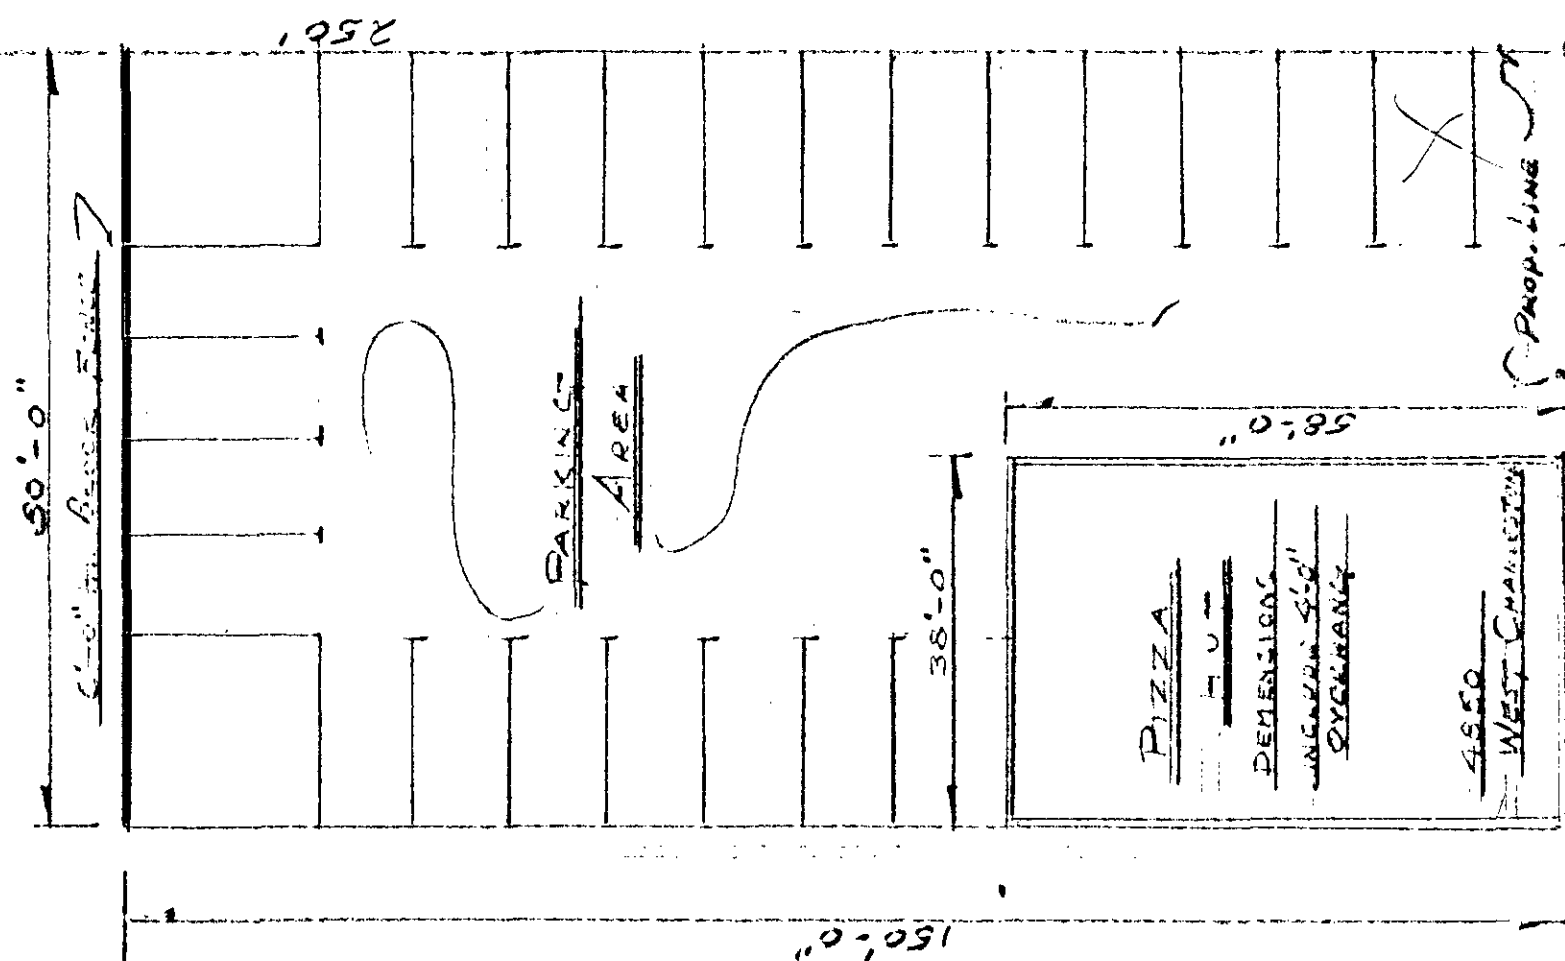

50' 2/3


"=20'-0"


141

SCALE:	APPROVED BY:	DRAWN BY
DATE:		REVISED
		DRAWING NUMBER