



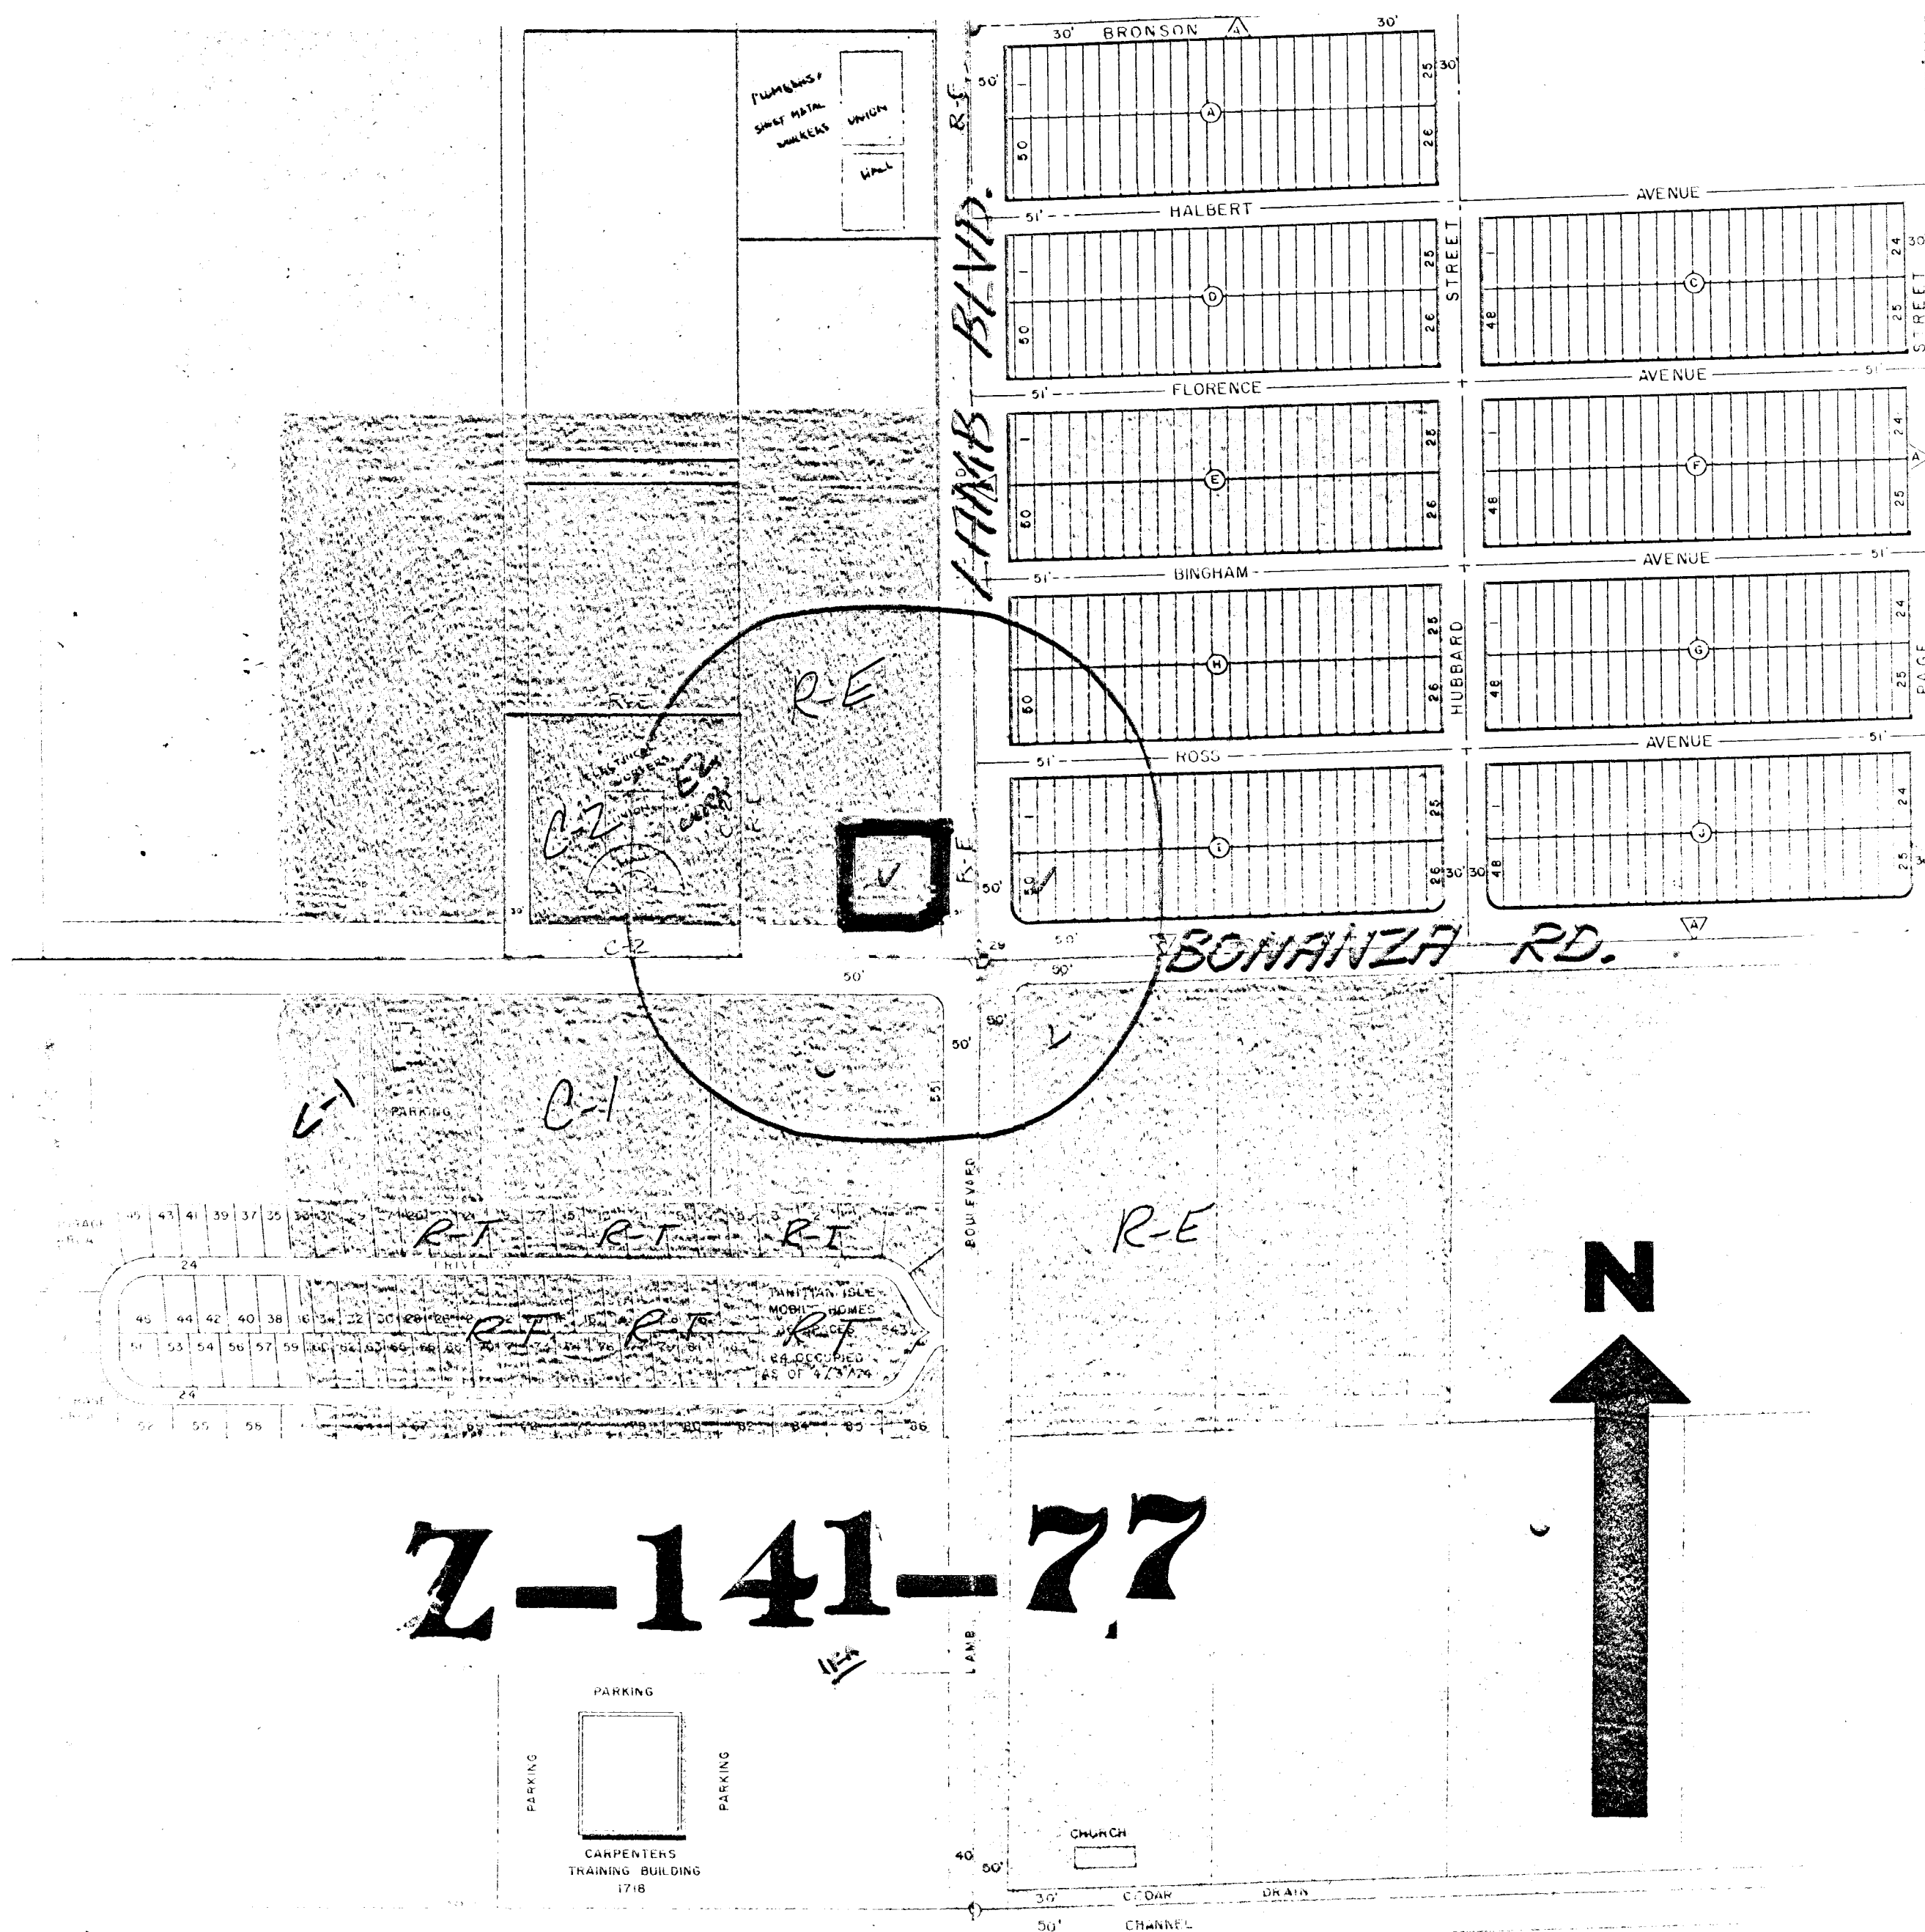

pc 1/12/73
cc 2/1/73

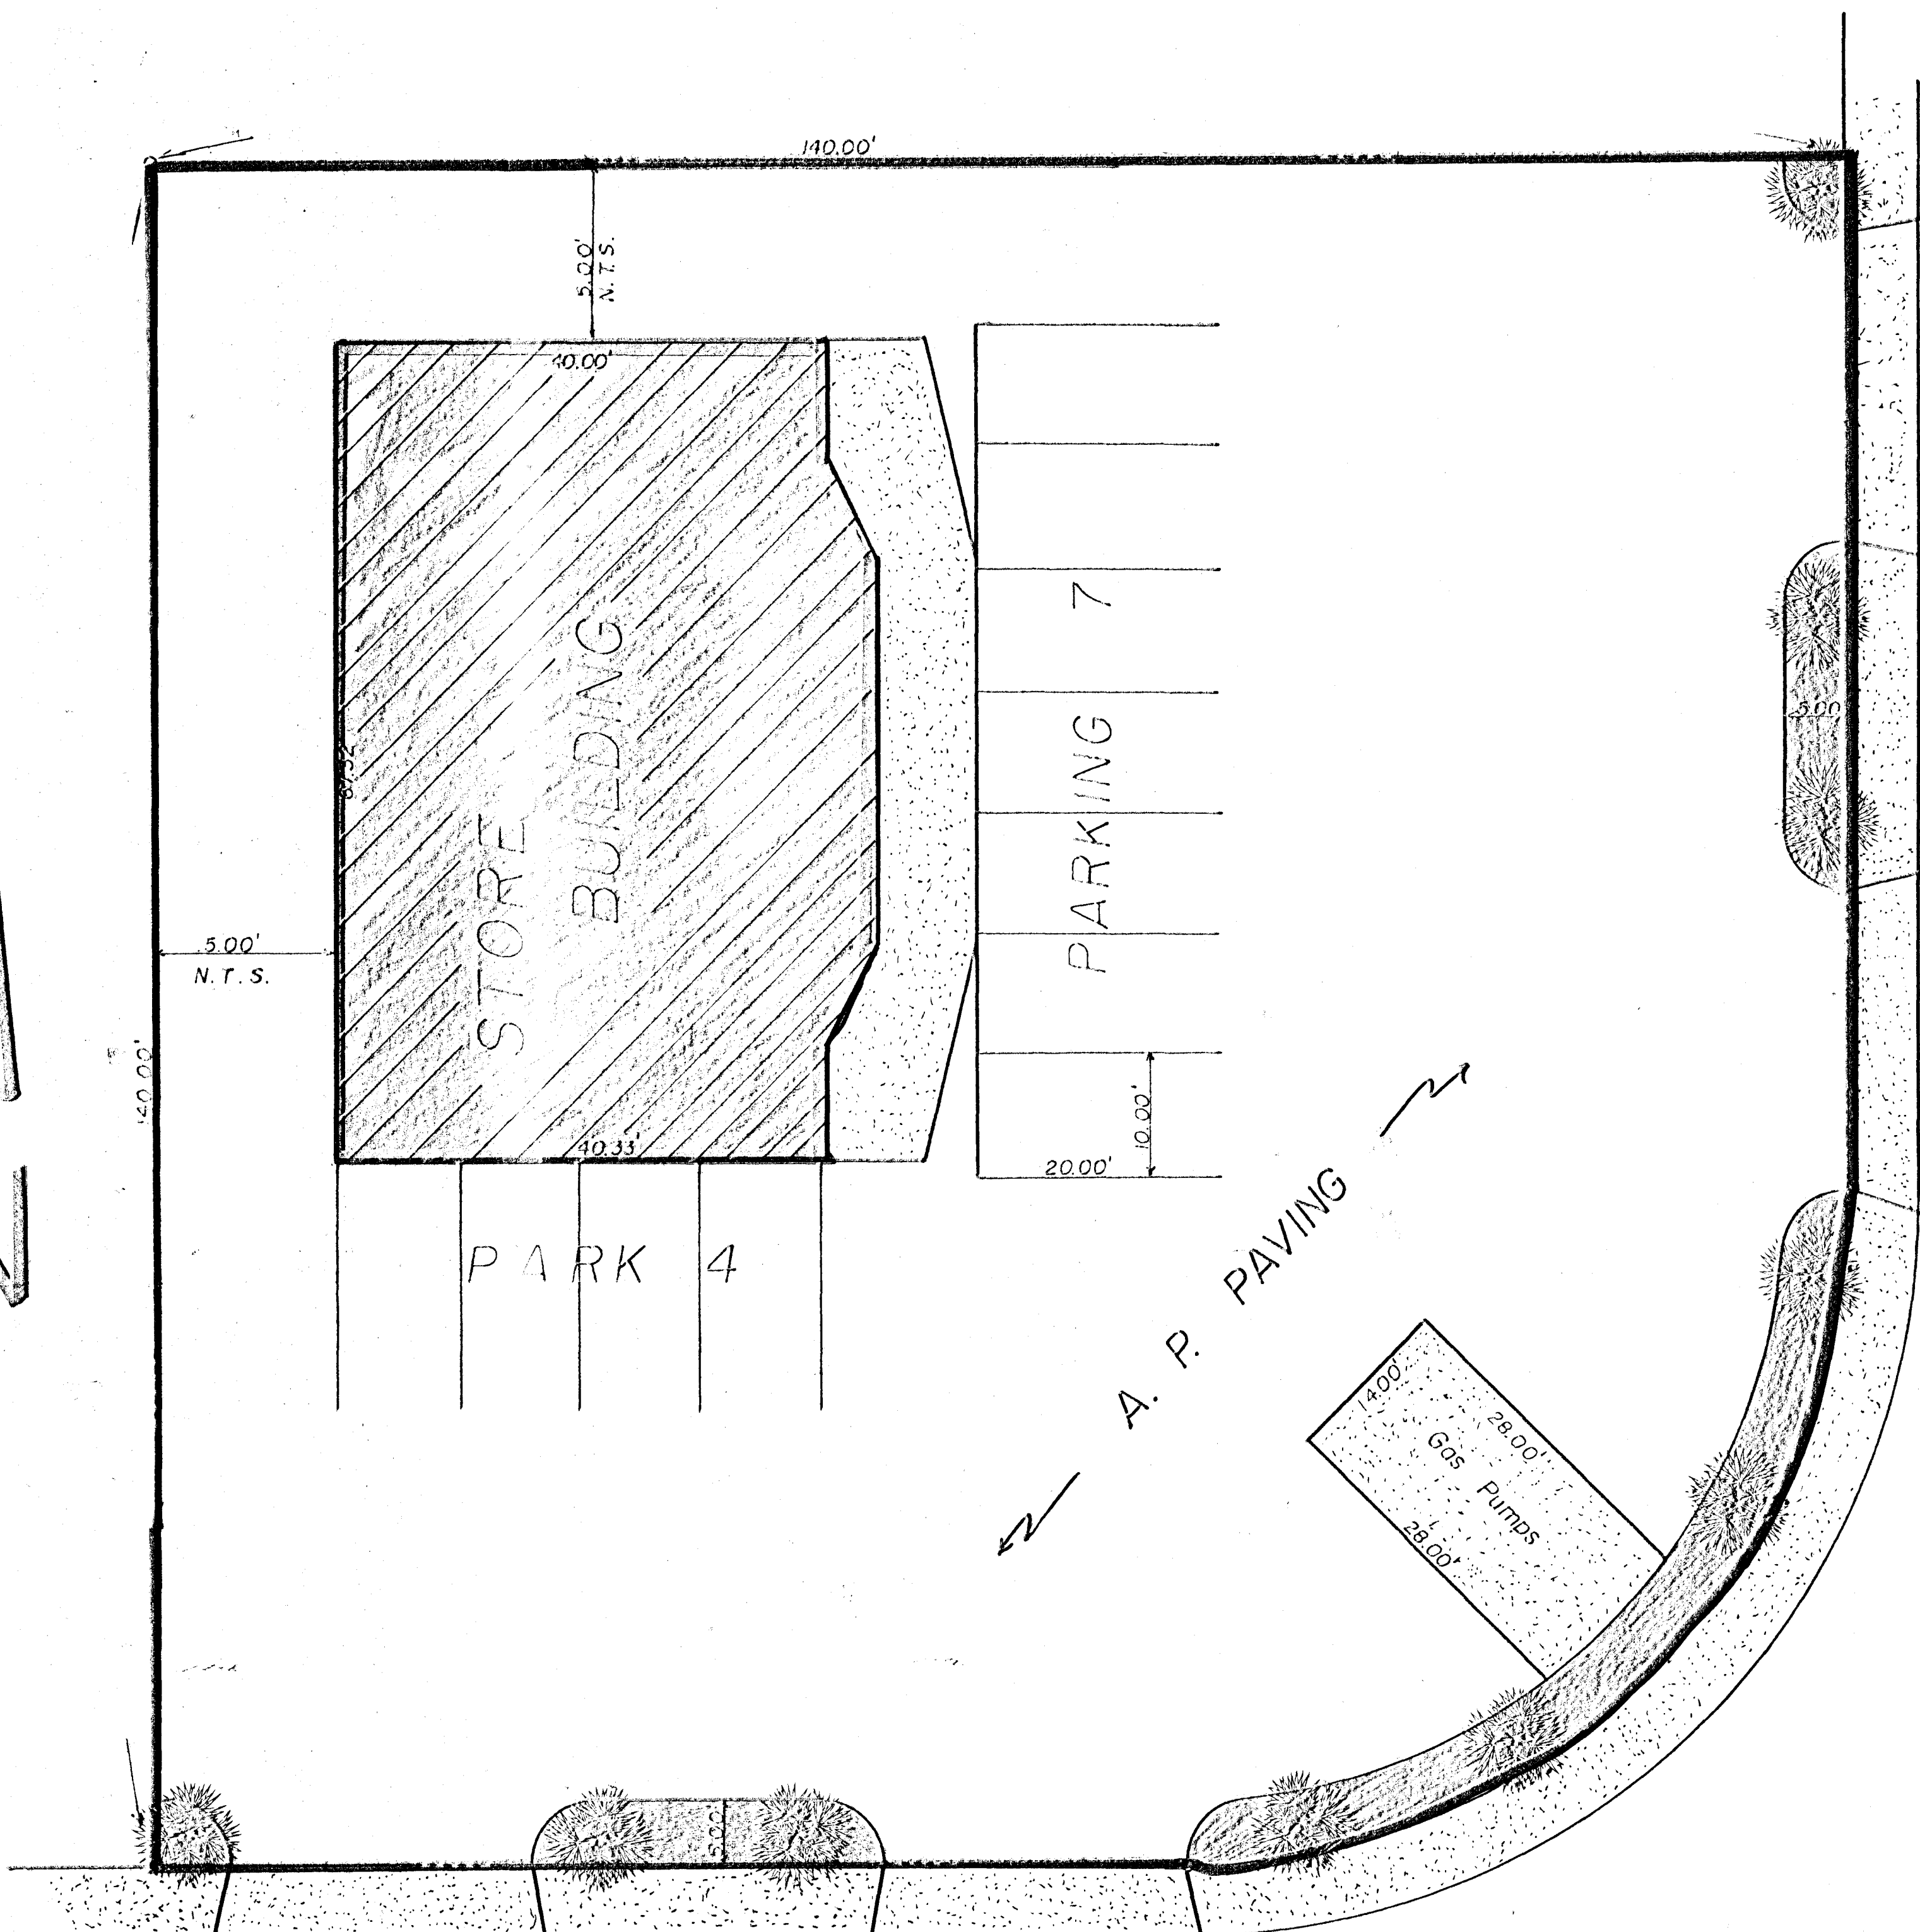

BONANZA ROAD
BONANZA RD

Z-141-77

LAMB BLVD.
LAMB BLVD.