


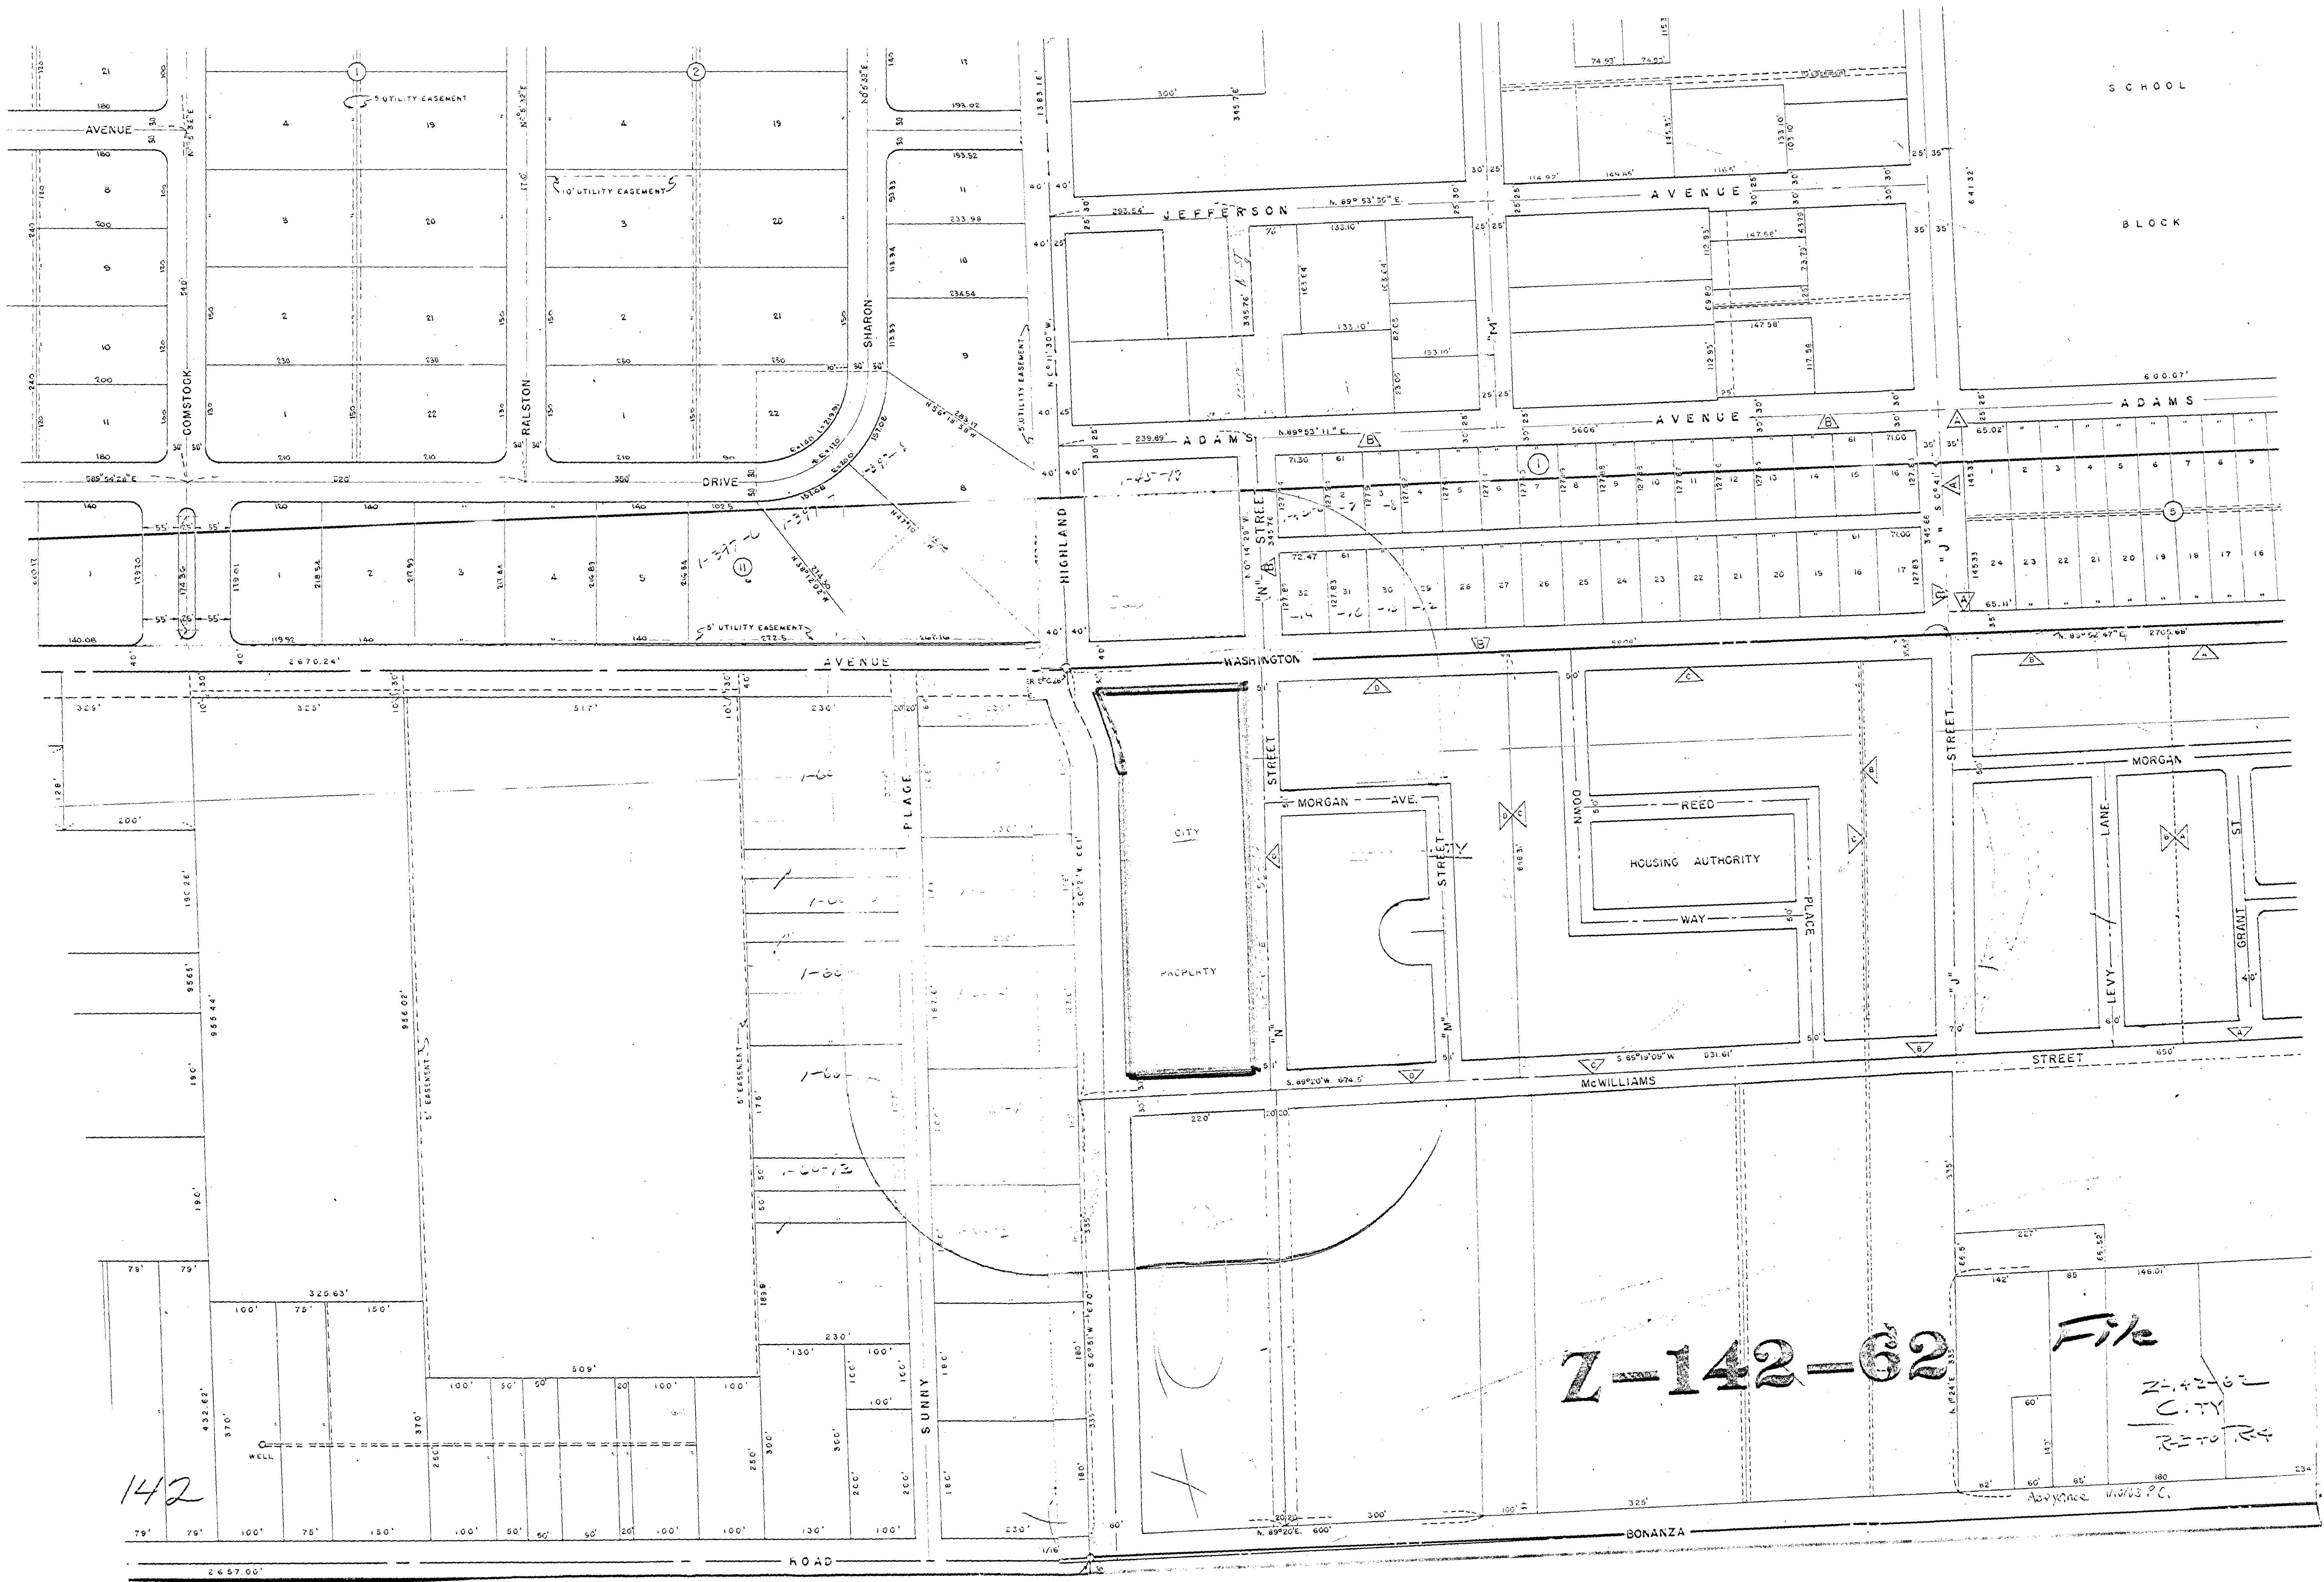

Z-142-62

File

*Z-142-62
CITY
RETURN*


142





