


Z-143

NO. 81

SHEET NO. 70

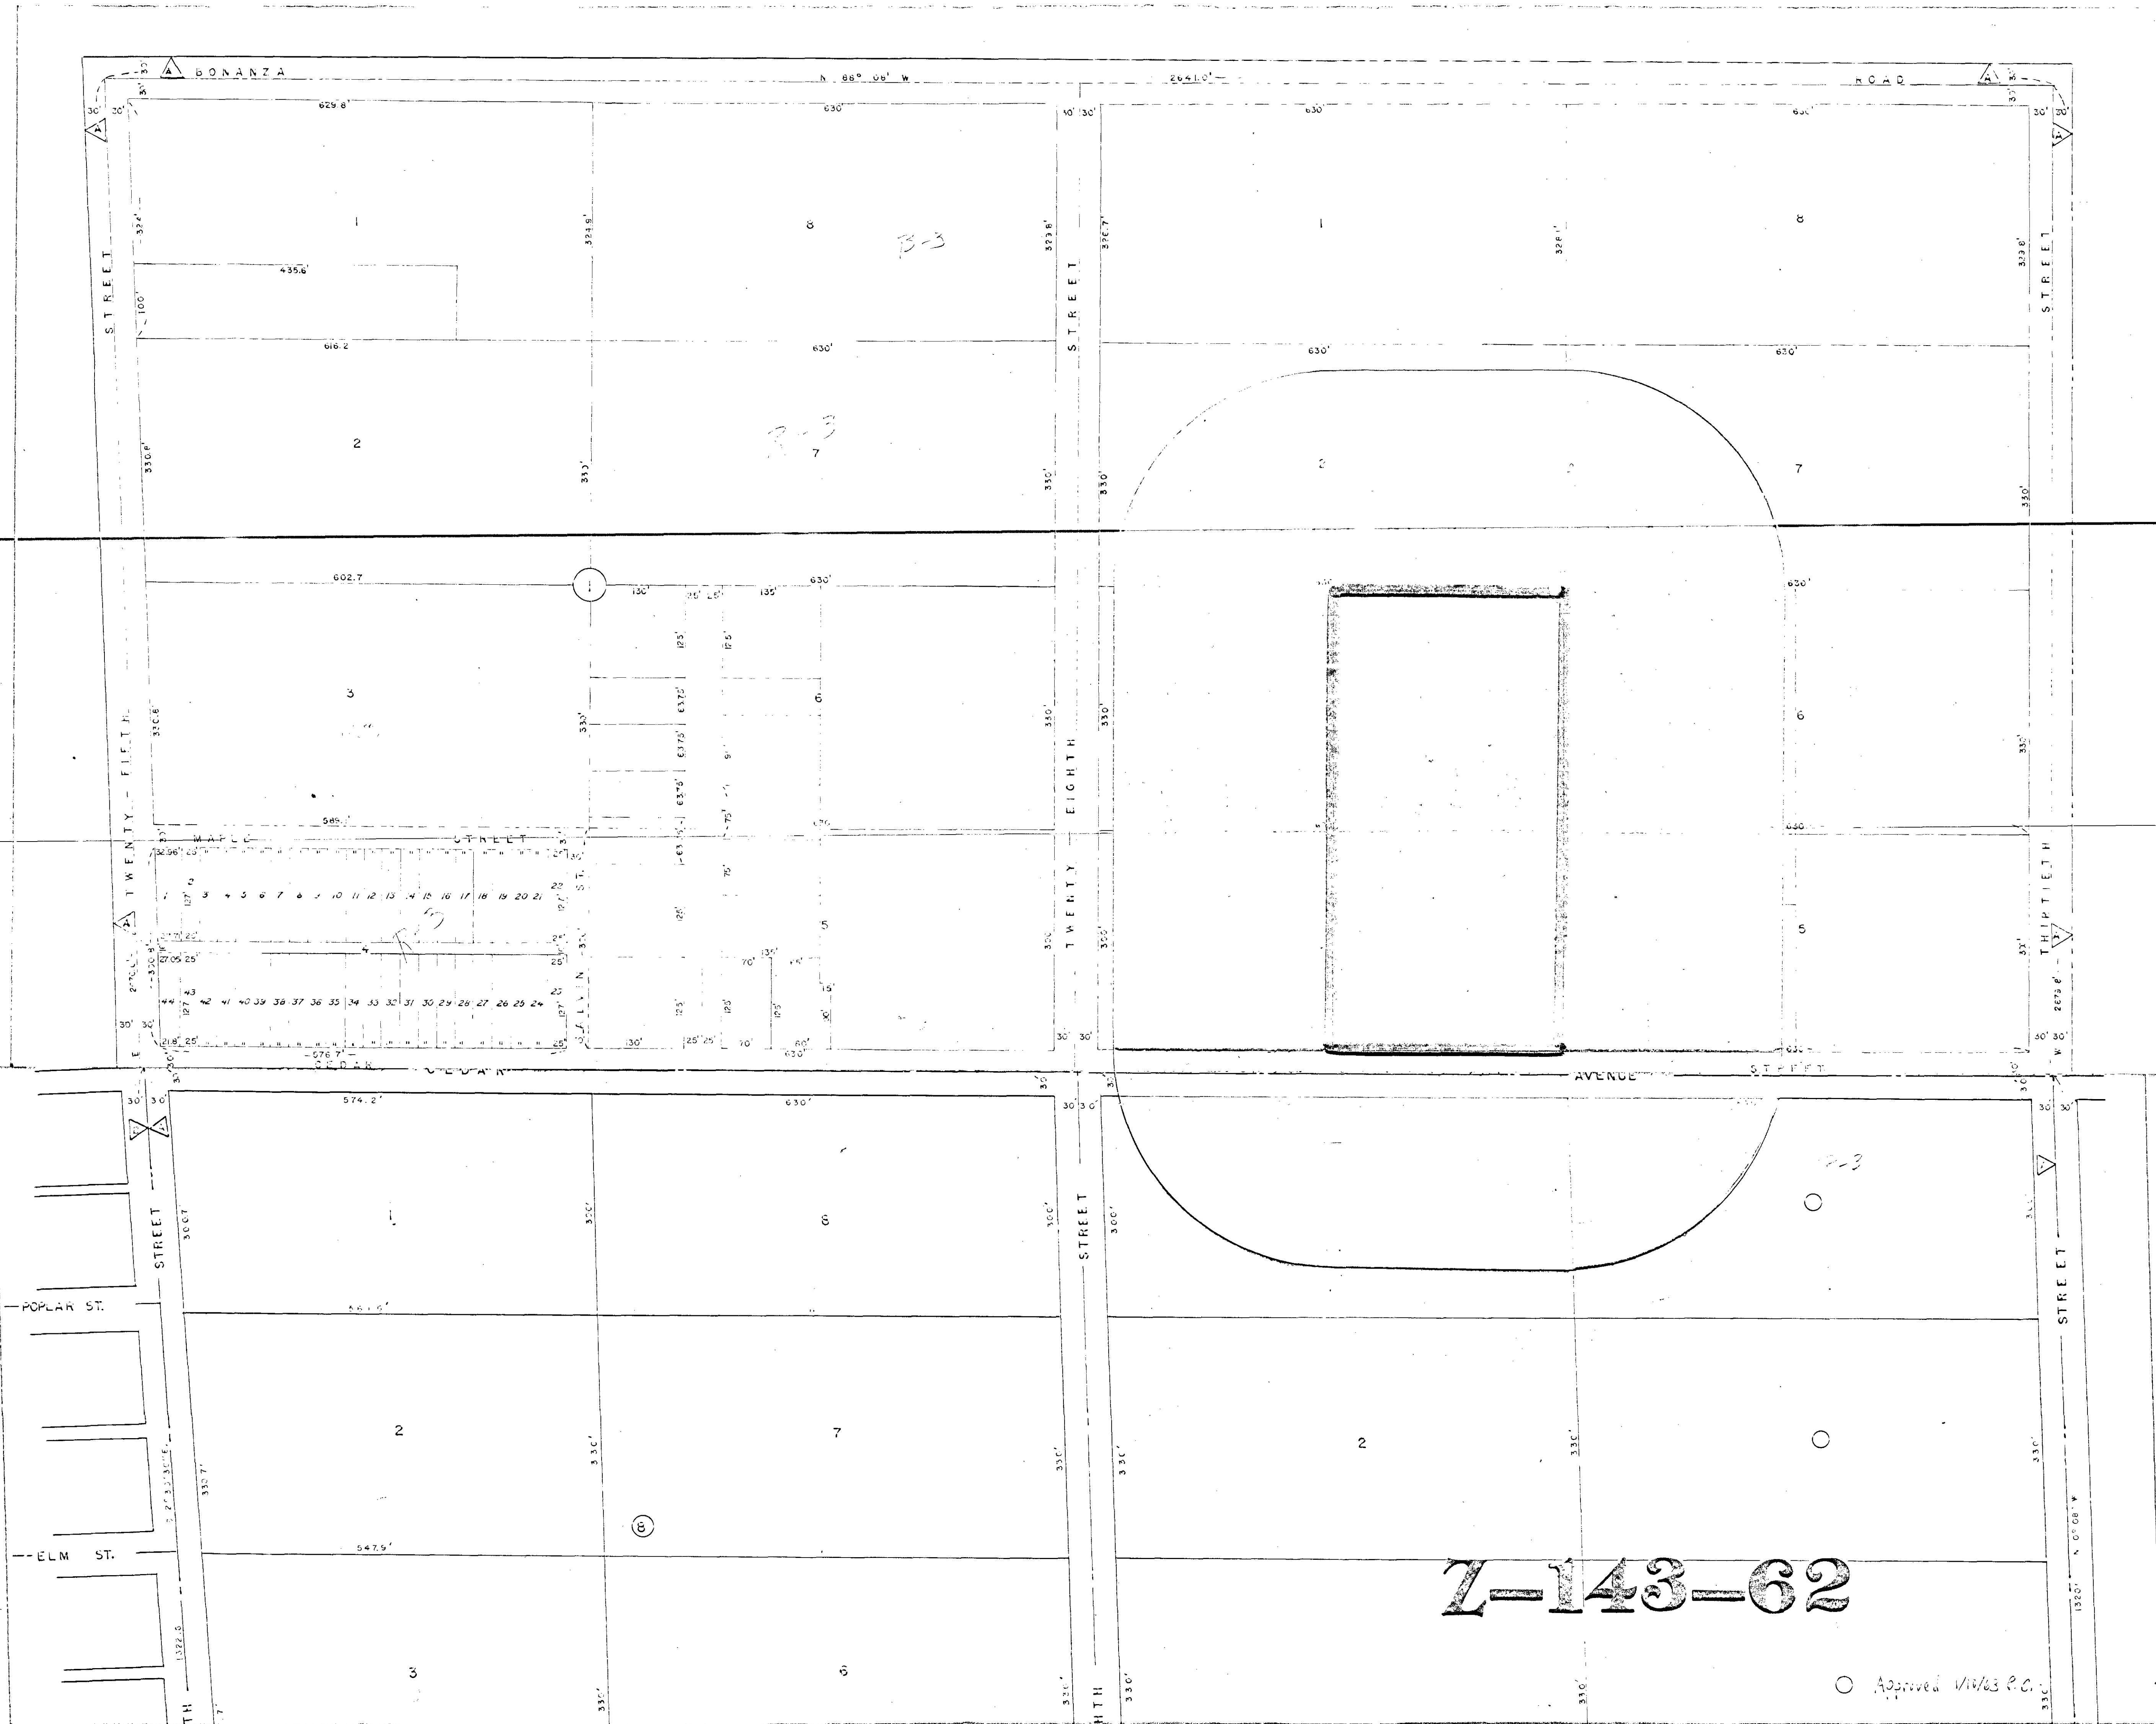

SHEET NO. 72

Z-143-62


SHEET NO. 83

Z-143-62
SANDBERG
R. to R-3