


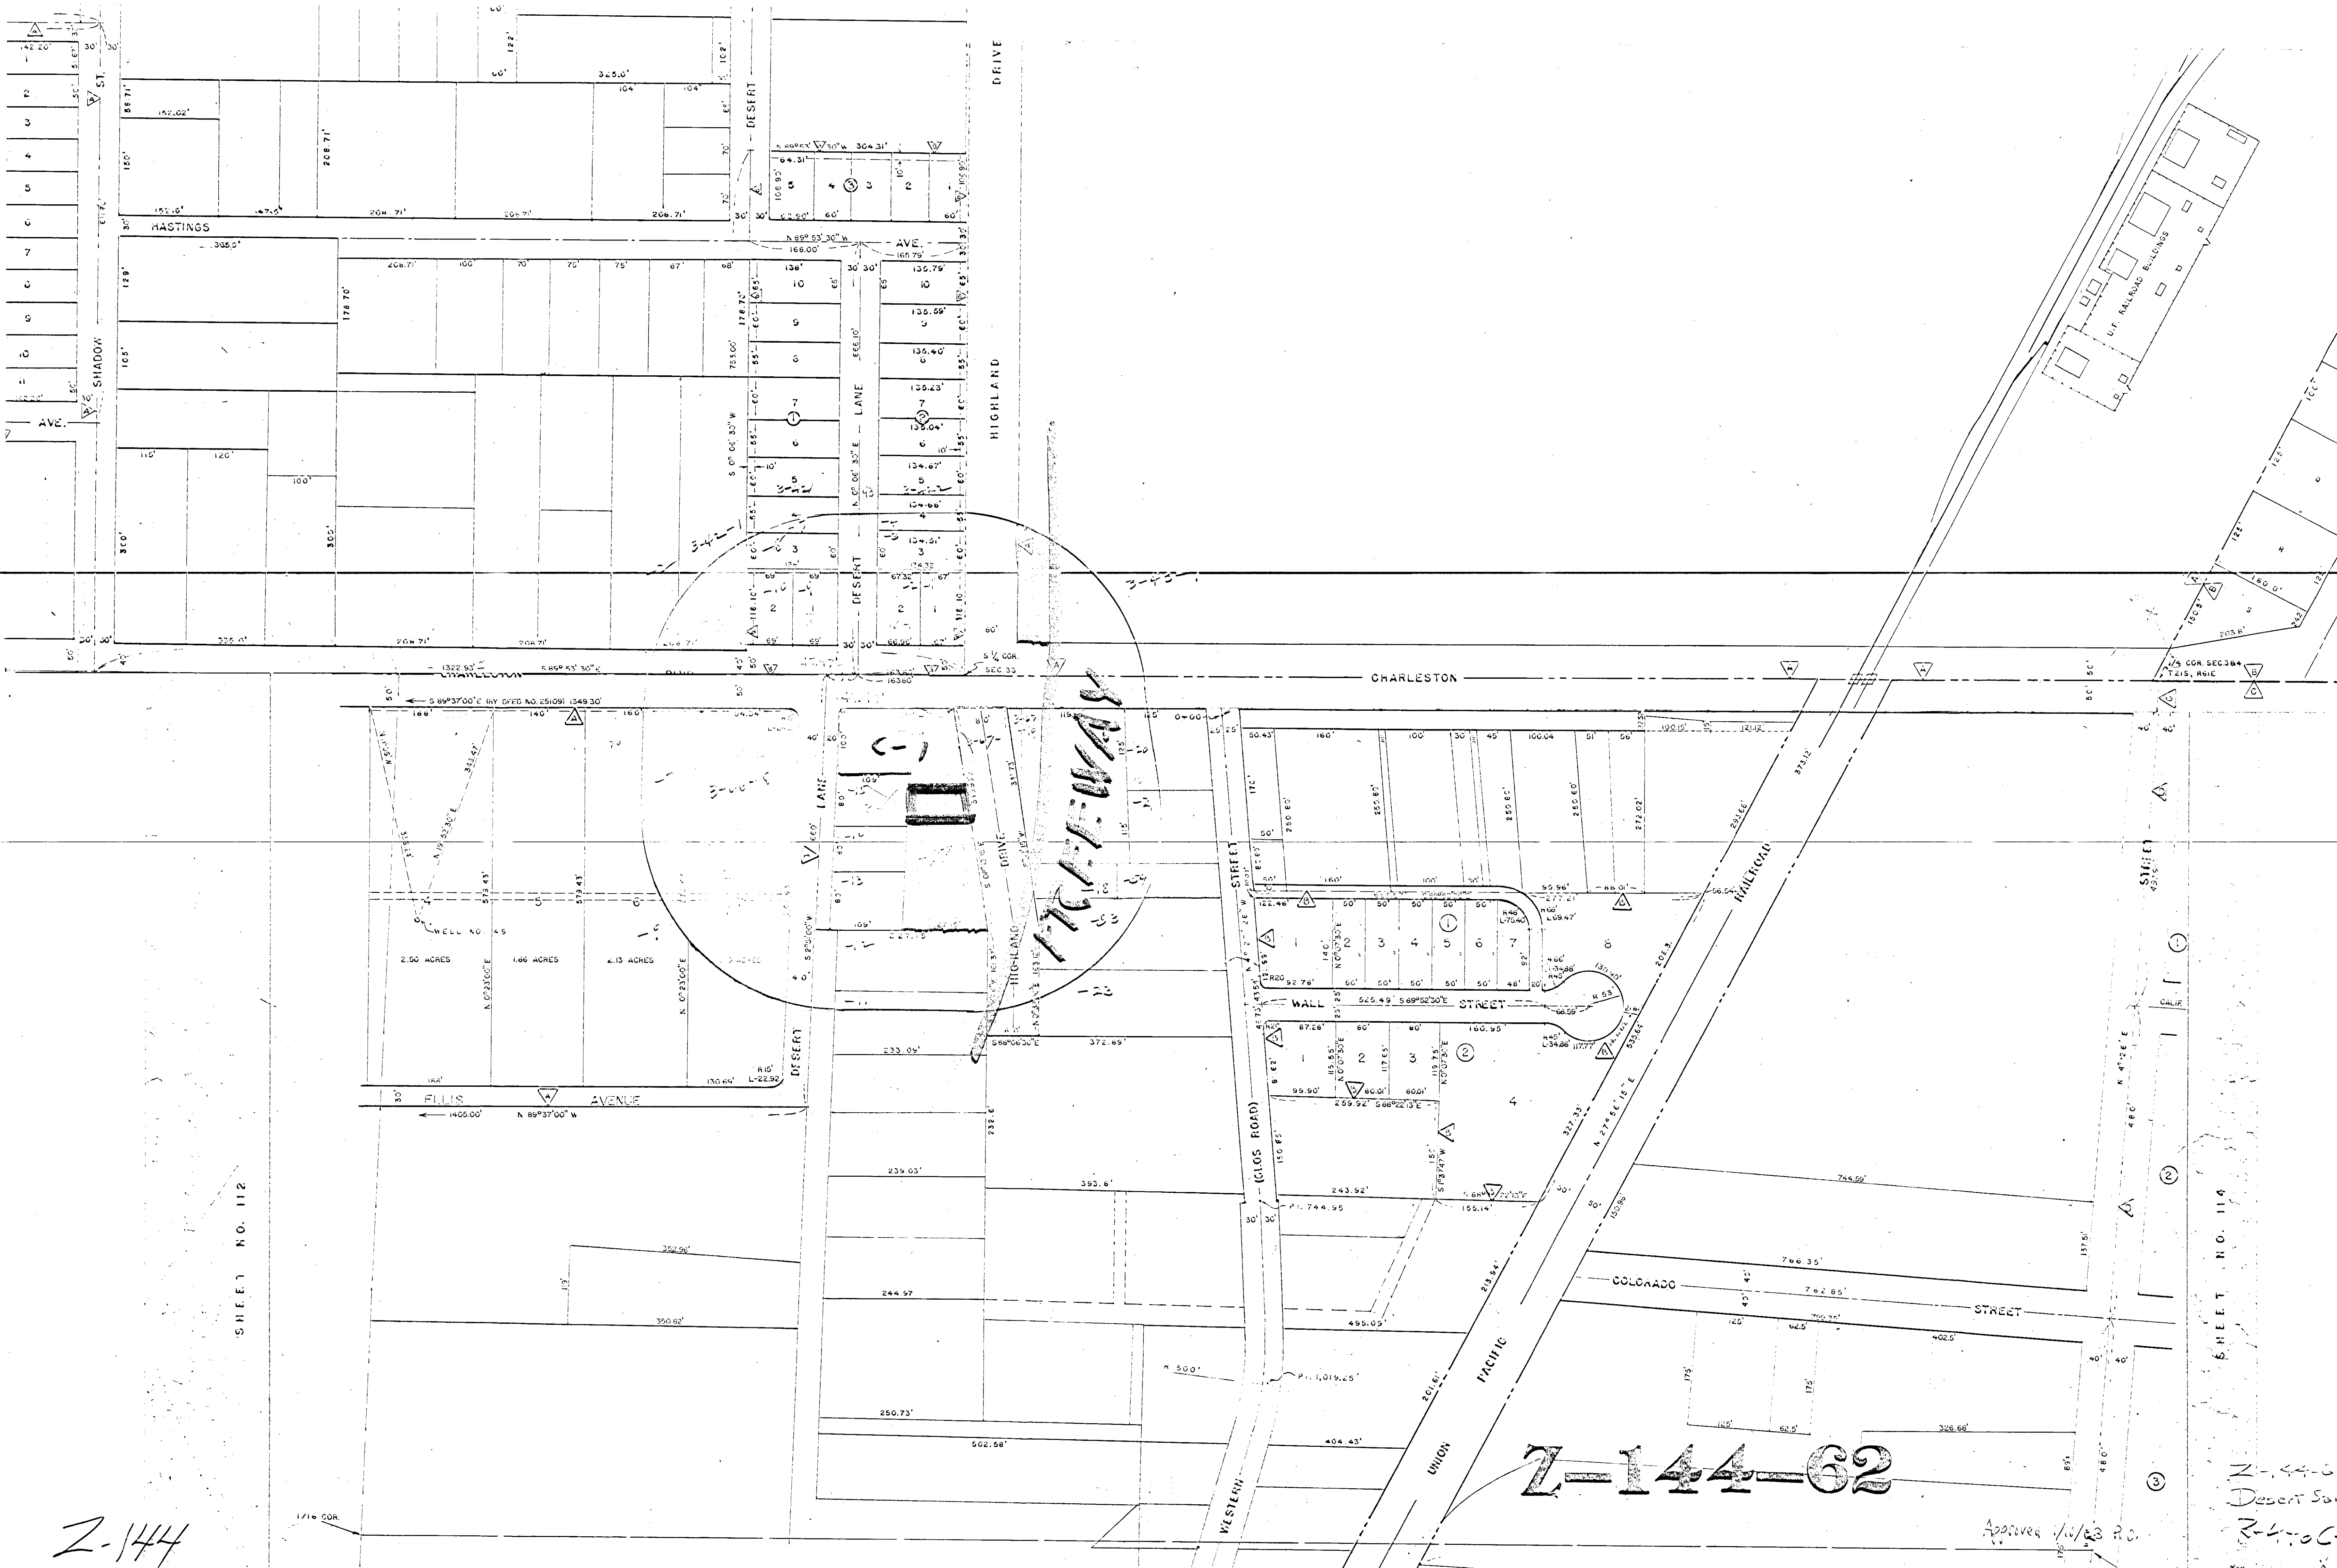

Z-144

SHEET NO. 112

Z-144-62

Approved 1/10/63 R.C.

Z-144-62
Desert Sales
R-4-10-C
Number X